


07 FEB 2017

20
 19
 18
This is a C.A.D. drawing and may only be modified by hand in accordance with QA Procedures

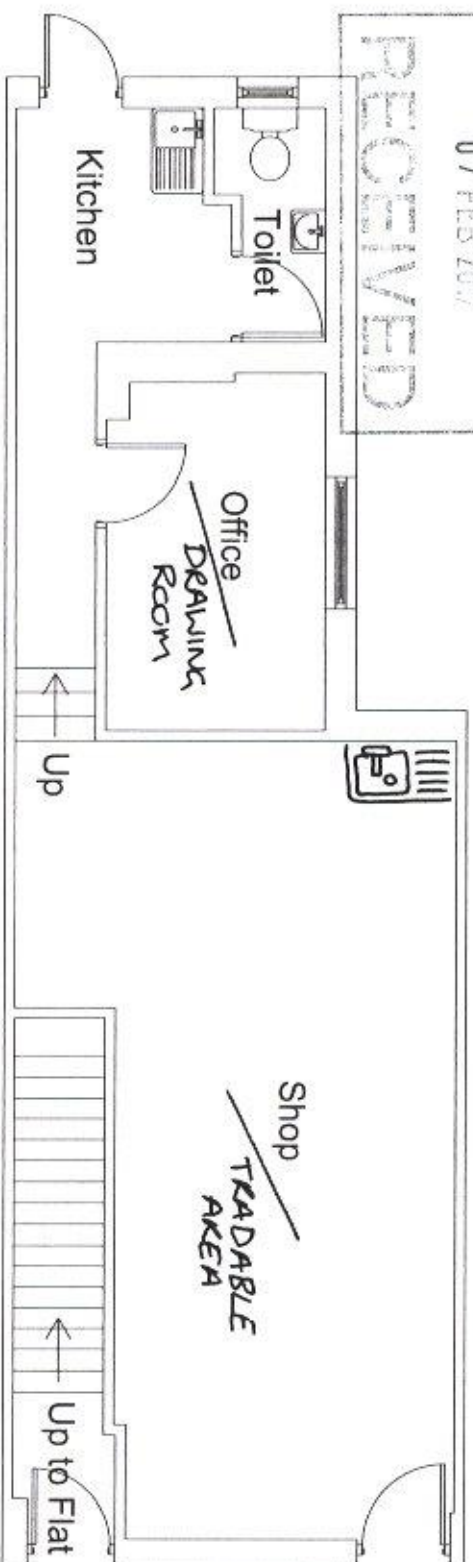

Shop Existing Layout - Scale 1:50




Front Elevation



Rear Elevation



Location Plan - Scale 1:1250

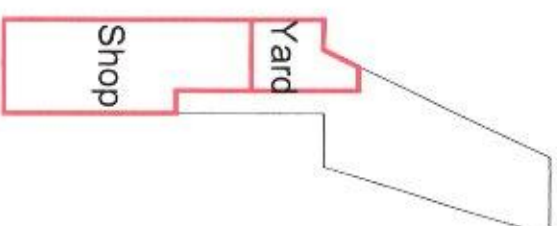

Scale 1:250

All dimensions to be checked on site prior to commencement of any work.

Notify C.A. of any discrepancies before ordering materials

Shop Premises
26 North Street
Emsworth
PO10 7DG

Existing Layout

Date	July 2014	Scan	As Stated
------	-----------	------	-----------

Designed by:	Drawn by:
	P.J. Robertson

PR / 2014 / 01a

SURVEY	DESIGN	WORKING DRAWING
FEASIBILITY	FINAL	AS-BUILT
INSTALLATION	CONTRACT	A.I.