



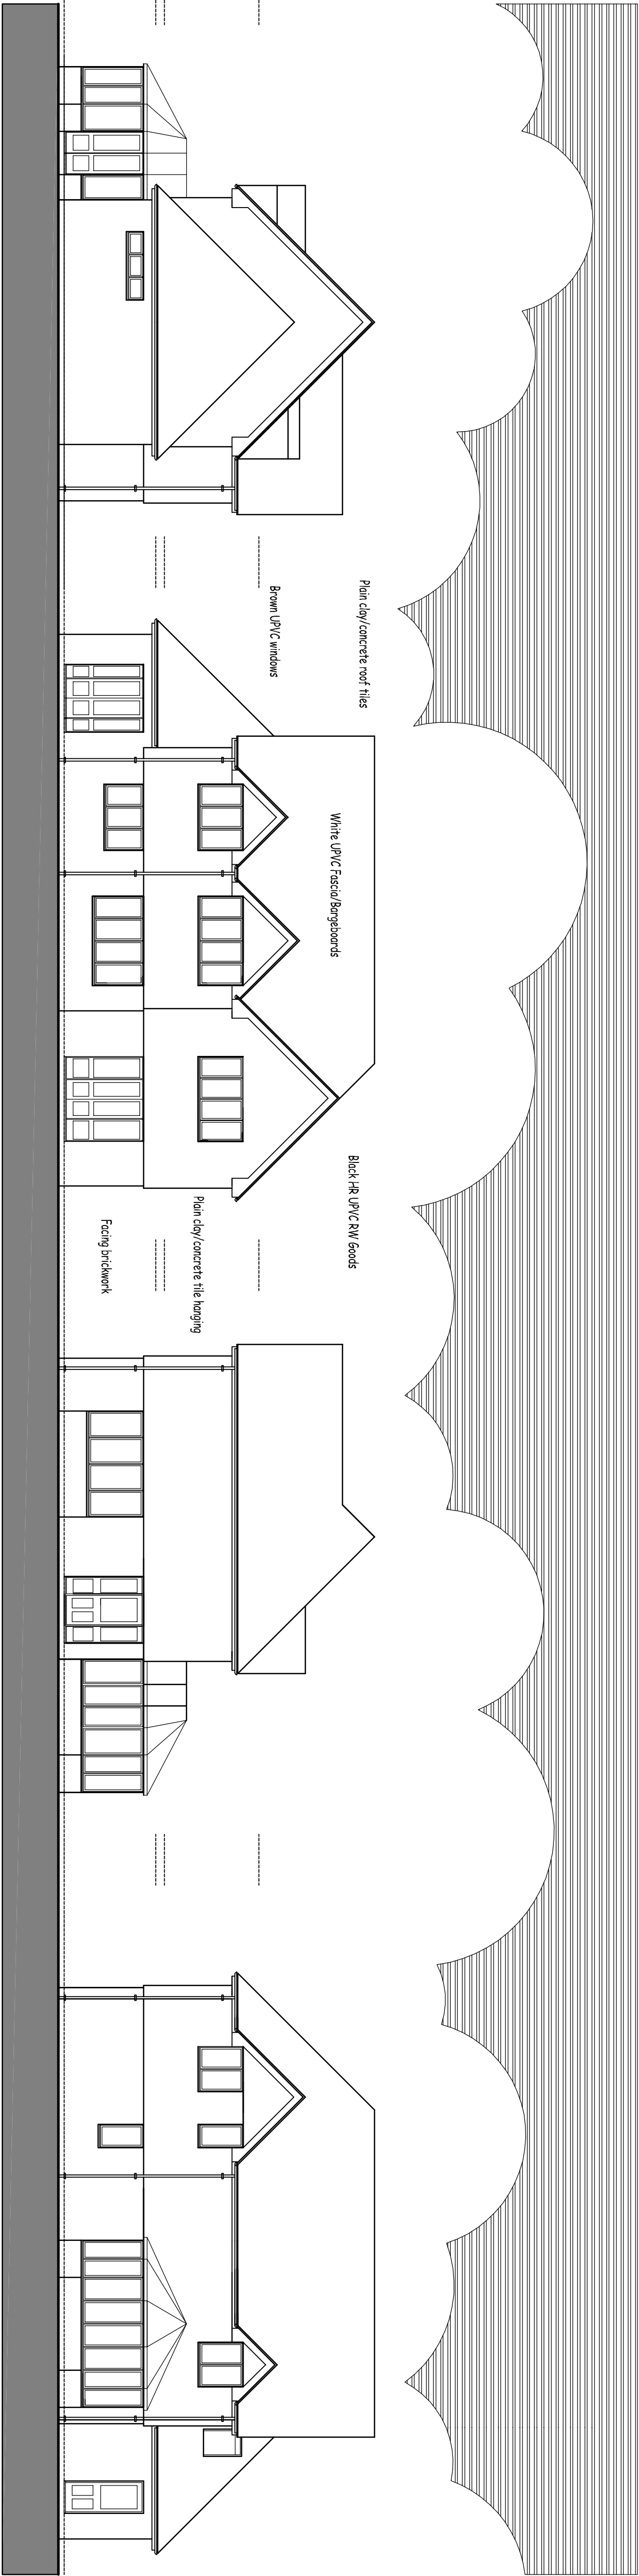

Wallis Road

Waterlooville, Havant, Hampshire.

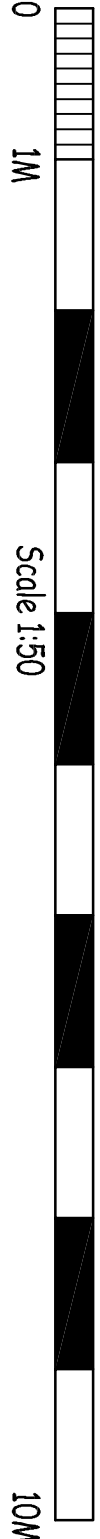

Ceiling 260
Head 2550
Cill 0

Ceiling 330
Head 1540
Cill 710

Ceiling 340
Head 1000
Cill 1030

Ceiling 380
Head 1210
Cill 870

Ceiling 410
Head 1180
Cill 970

Ceiling 410
Head 1190
Cill 860

Ceiling 340
Head 1490
Cill 540

Lounge
Ceiling Height 2350

Dining Room
Ceiling Height 2350

Kitchen
Ceiling Height 2350

Study

Hall
Ceiling Height 2340

Rise 190mm
Going 240mm

Ceiling 220
Head 370
Cill

Ceiling 390
Head 1190
Cill 880

Ceiling 340
Head 1490
Cill 540

Ceiling 380
Head 1200
Cill 880

Ceiling 390
Head 1190
Cill 880

Ceiling 400
Head 1180
Cill 880

GROUND FLOOR PLAN

Ceiling 450 max
Head 1770
Cill 450

Conservatory

FIRST FLOOR PLAN

BED 1
Ceiling Height 2460

BED 2
Ceiling Height 2460


BED 3
Ceiling Height 2460

BED 4
Ceiling Height 2460

Landing
Ceiling Height 2460

Bath
Ceiling Height 2460

Attic
Gr 23.00 max
750mm high ptn

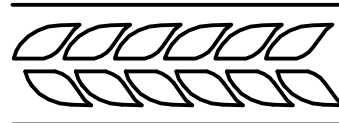

ARCHITECTURAL TECHNOLOGISTS
4 FLOORS
RESIDENTIAL
HAMPSHIRE DESIGN
TELEPHONE: 01203 204000
FACSIMILE: 01203 204002

PROJECT
AS BUILT PLAN
32 Wallis Road
Waterlooville
Havant, Hampshire
CLIENT
Mr & Mrs M. Davidson

SCALE
1:50 1:100
DRAWN
P.T.E. MCJAT
CHECKED
-
PROJECT NO.
17/13/01
RETURN
O O O O O O O O O O

Town & Country ARCHITECTURE

This drawing is protected by copyright and may not be copied or released to third parties without the expressed permission of Town & Country Architects.
Drawings should be given to others by our firm following our usual arrangements.
Dissemination of any part must be reported to Town & Country Architects.