




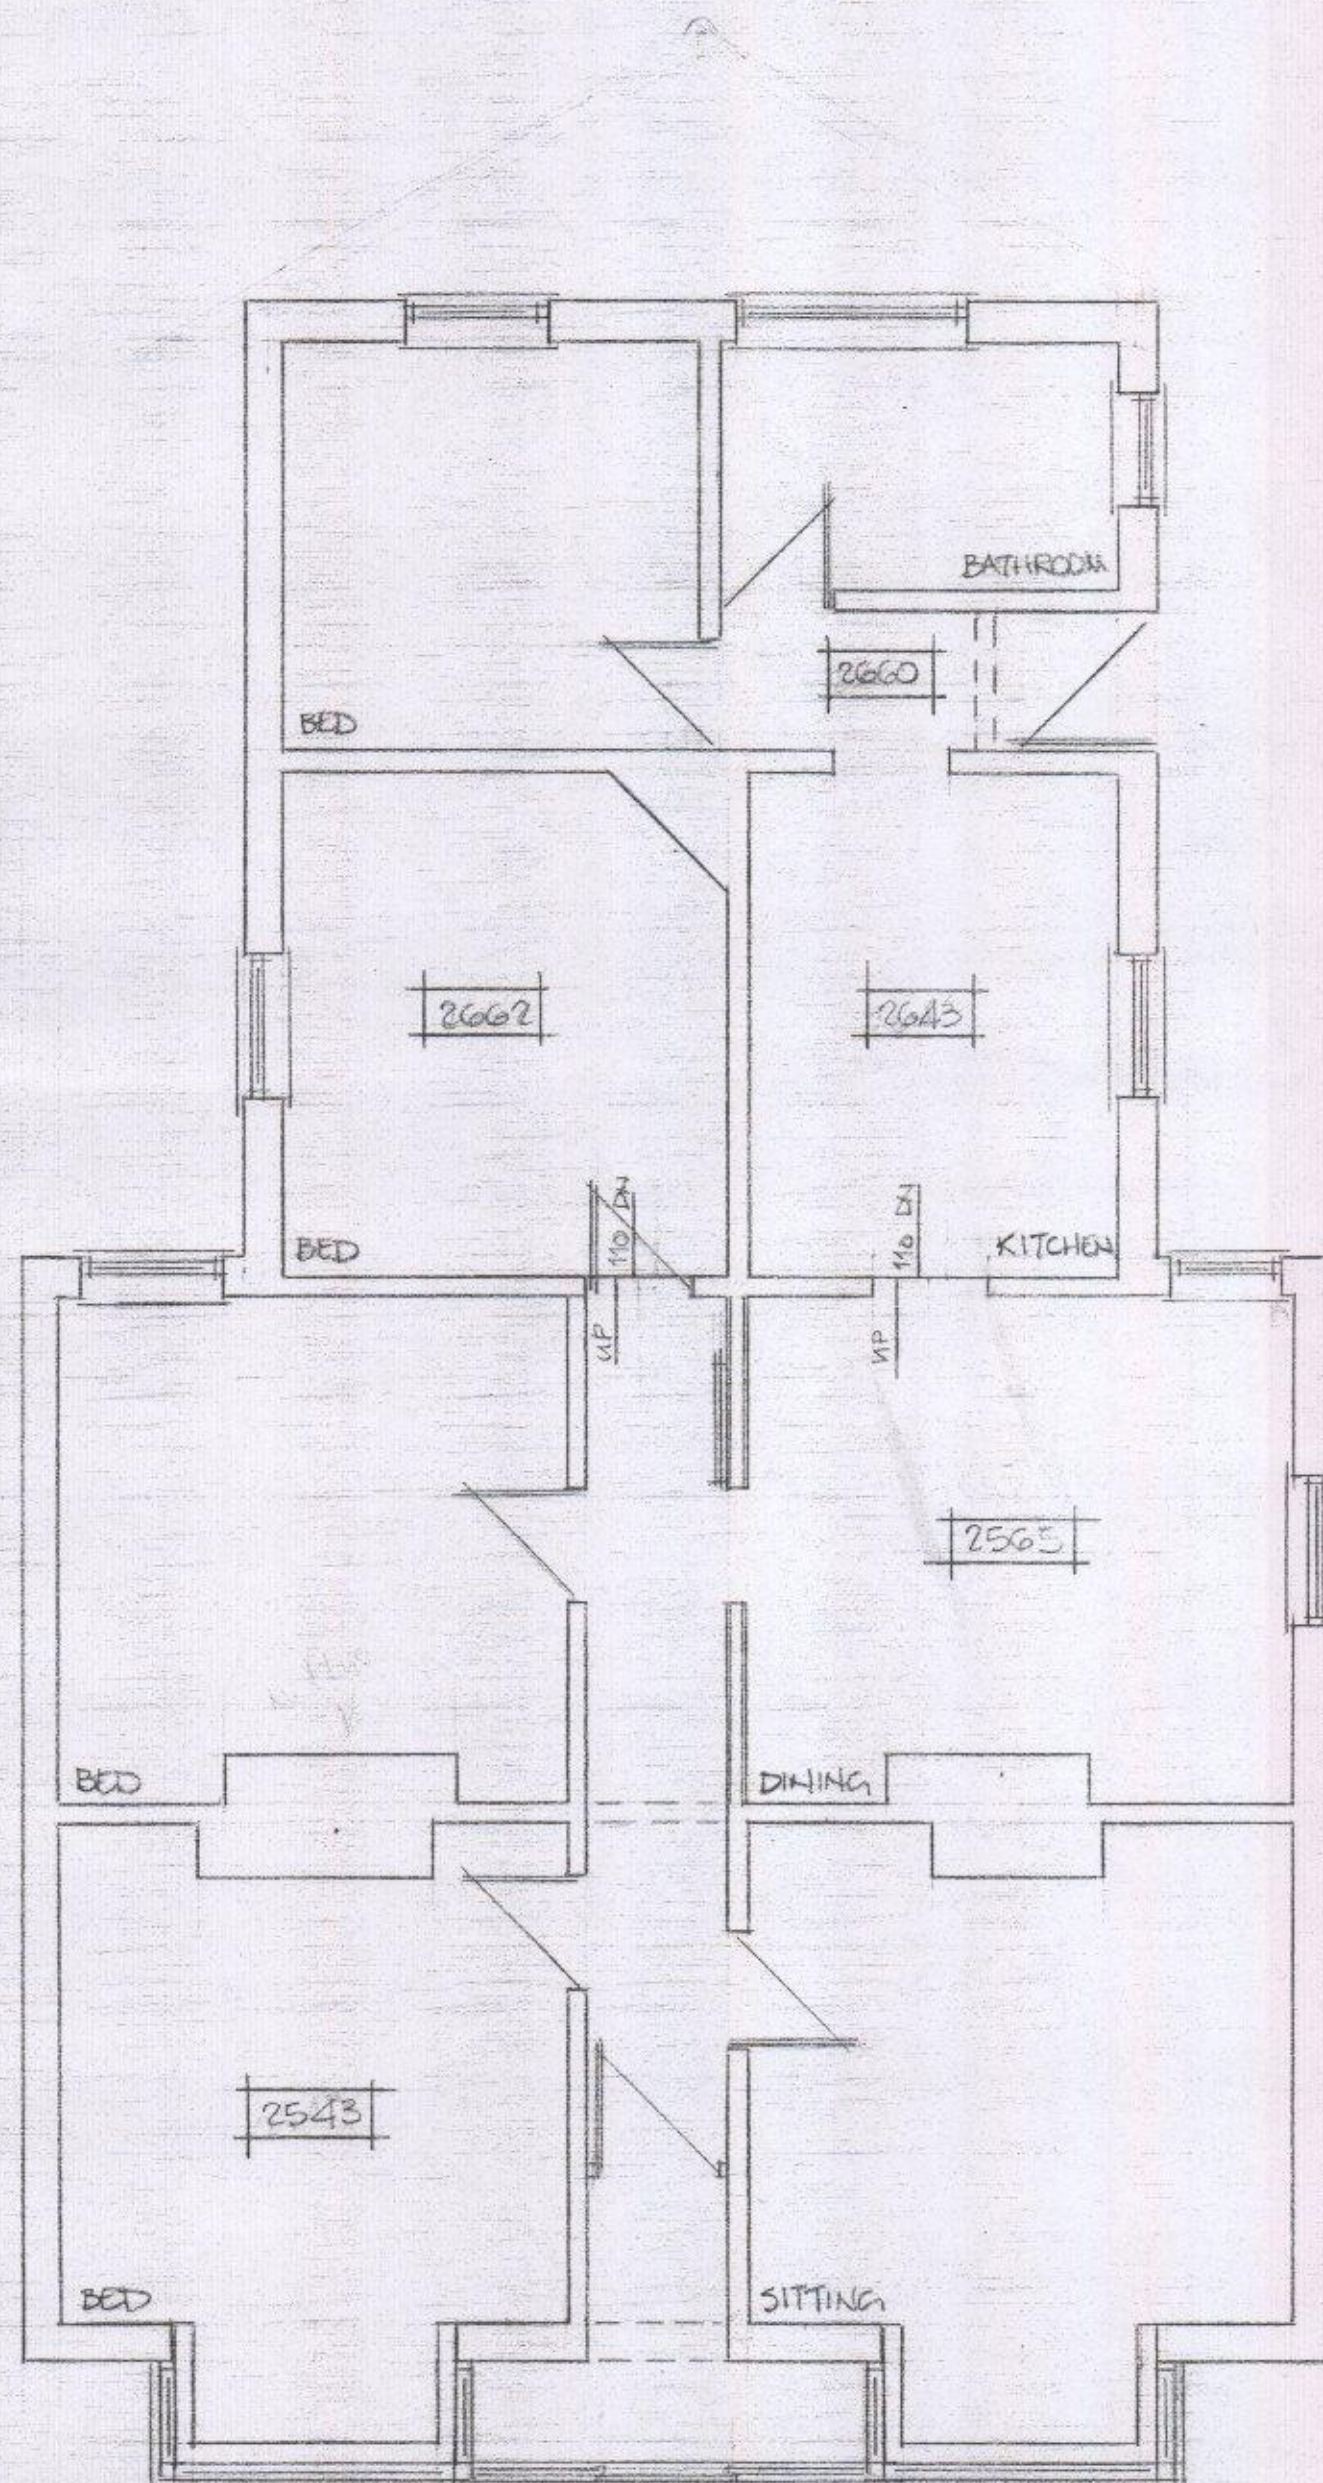

GROUND PLAN

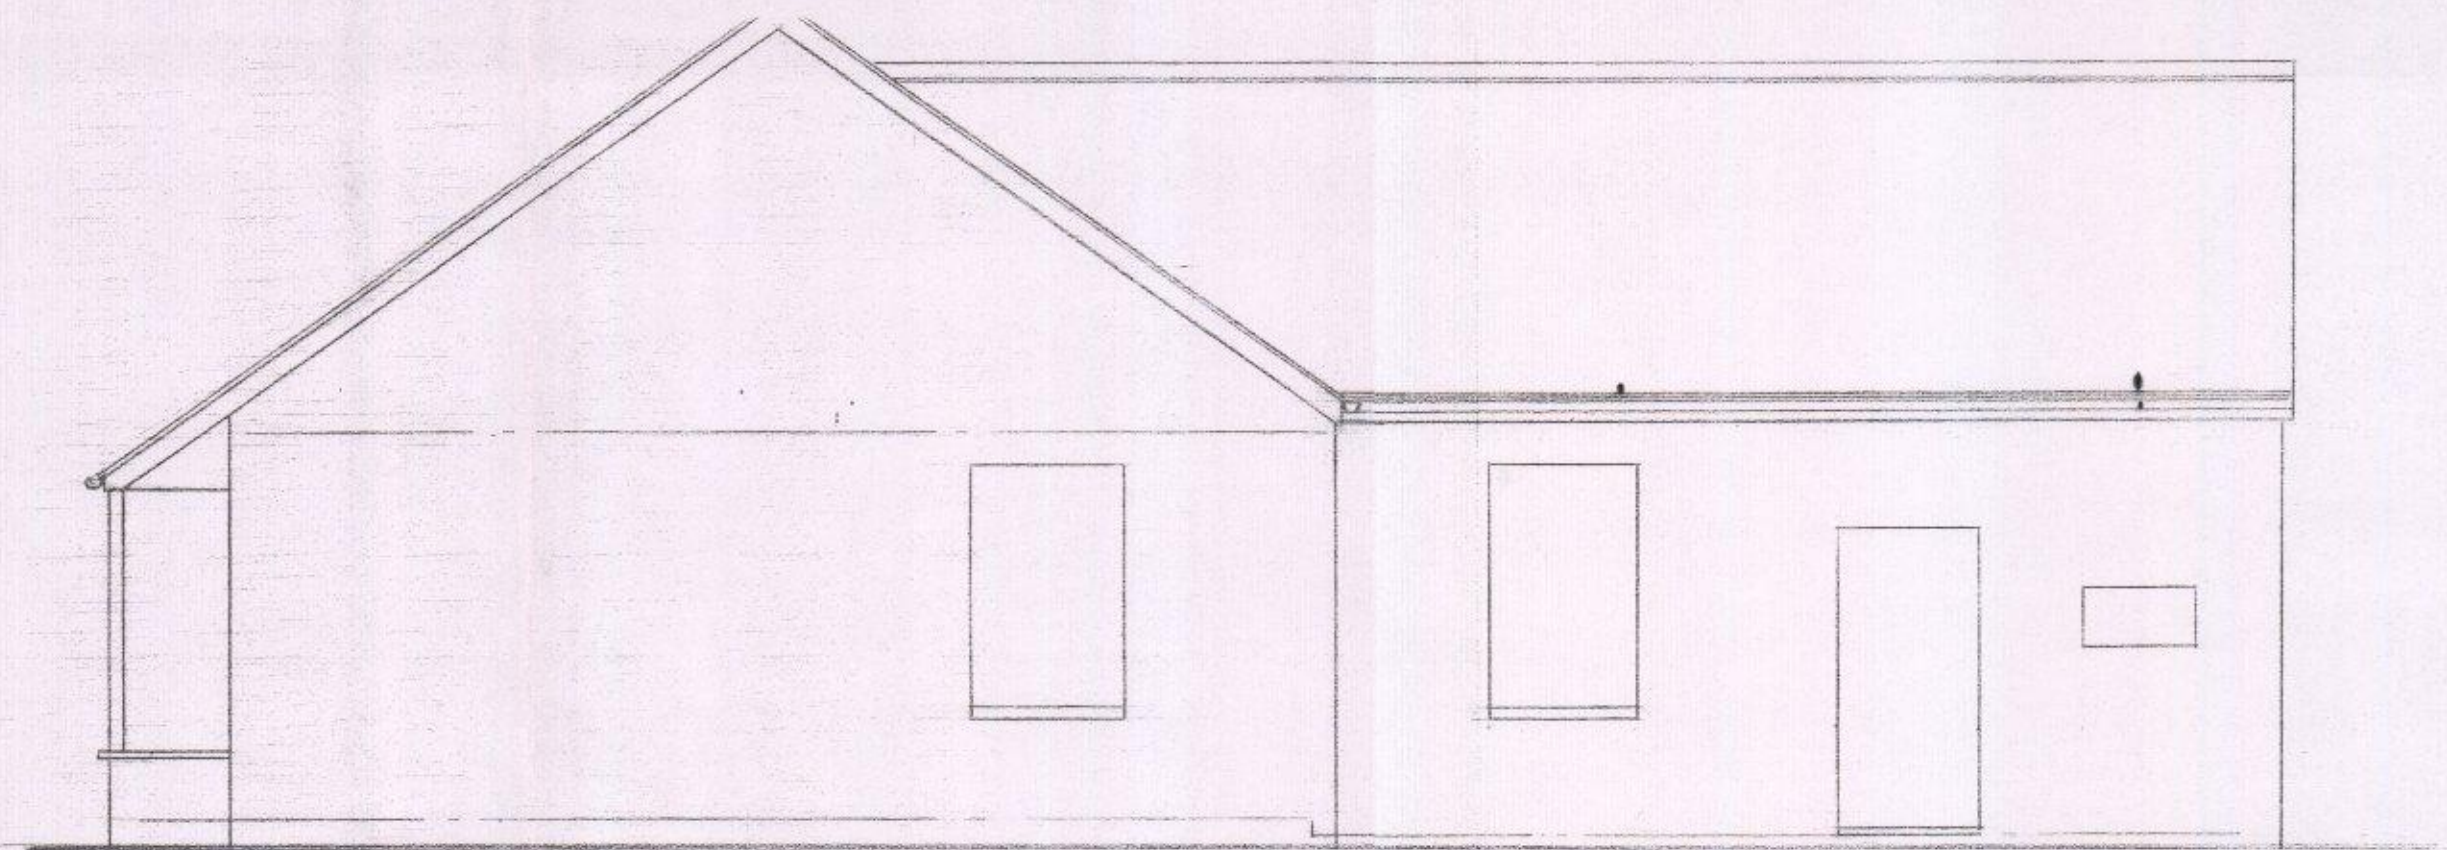

WEST ELEVATION

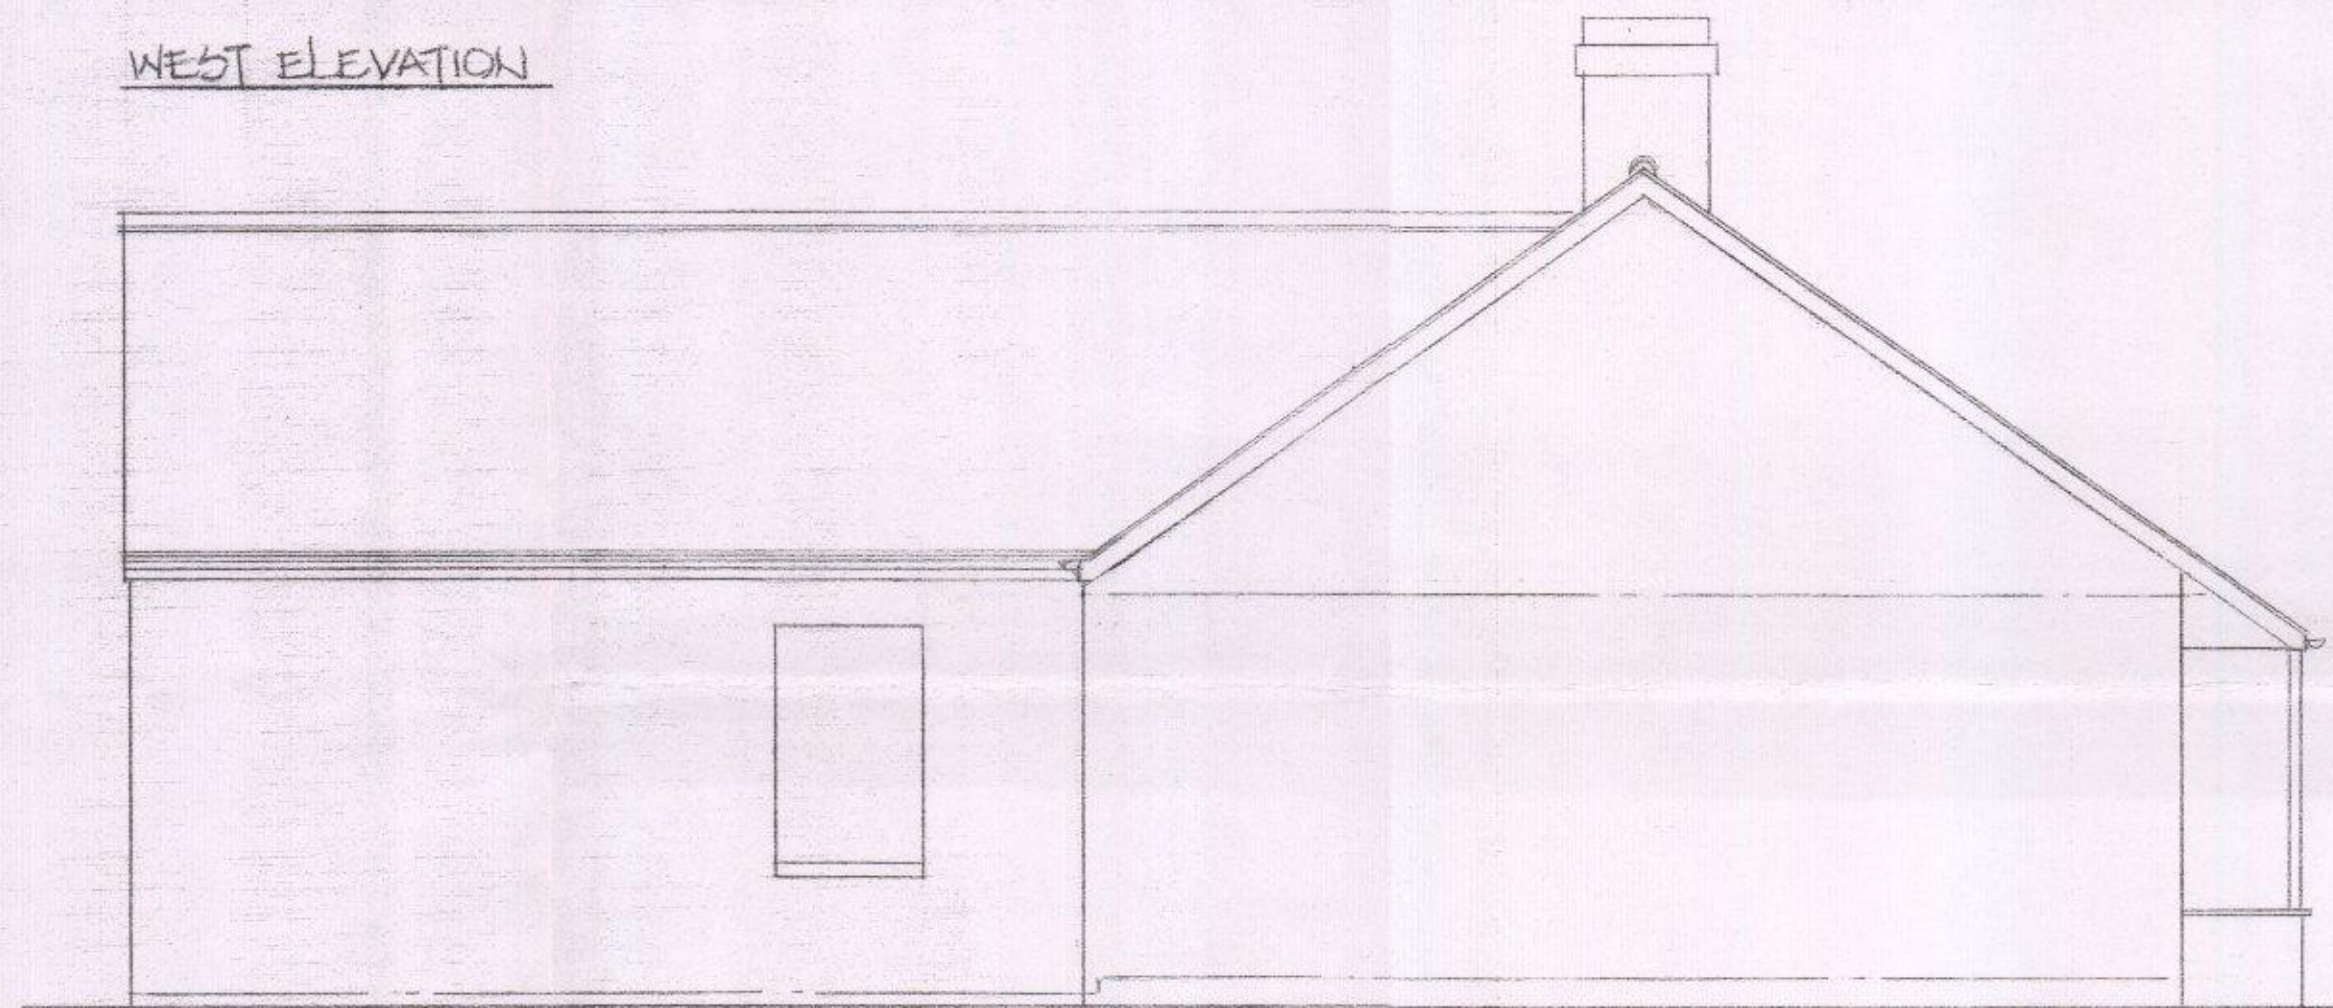

EAST ELEVATION



SOUTH ELEVATION

HAVANT BOROUGH
COUNCIL
25 MAY 2016
RECEIVED

MAISIE RUDKIN

606 SOUTHEIGH RD
EASTON NORTH
HANTS PO10 7

AS BUILT

David Niven Design Ltd

davidniven.design@gmail.com
07873 342 807 01243 330070
74 Westbourne Avenue,
Emsworth, Hampshire PO10 7QU



Architectural Design & Planning

1:50 AUG '15 15/1095/1