




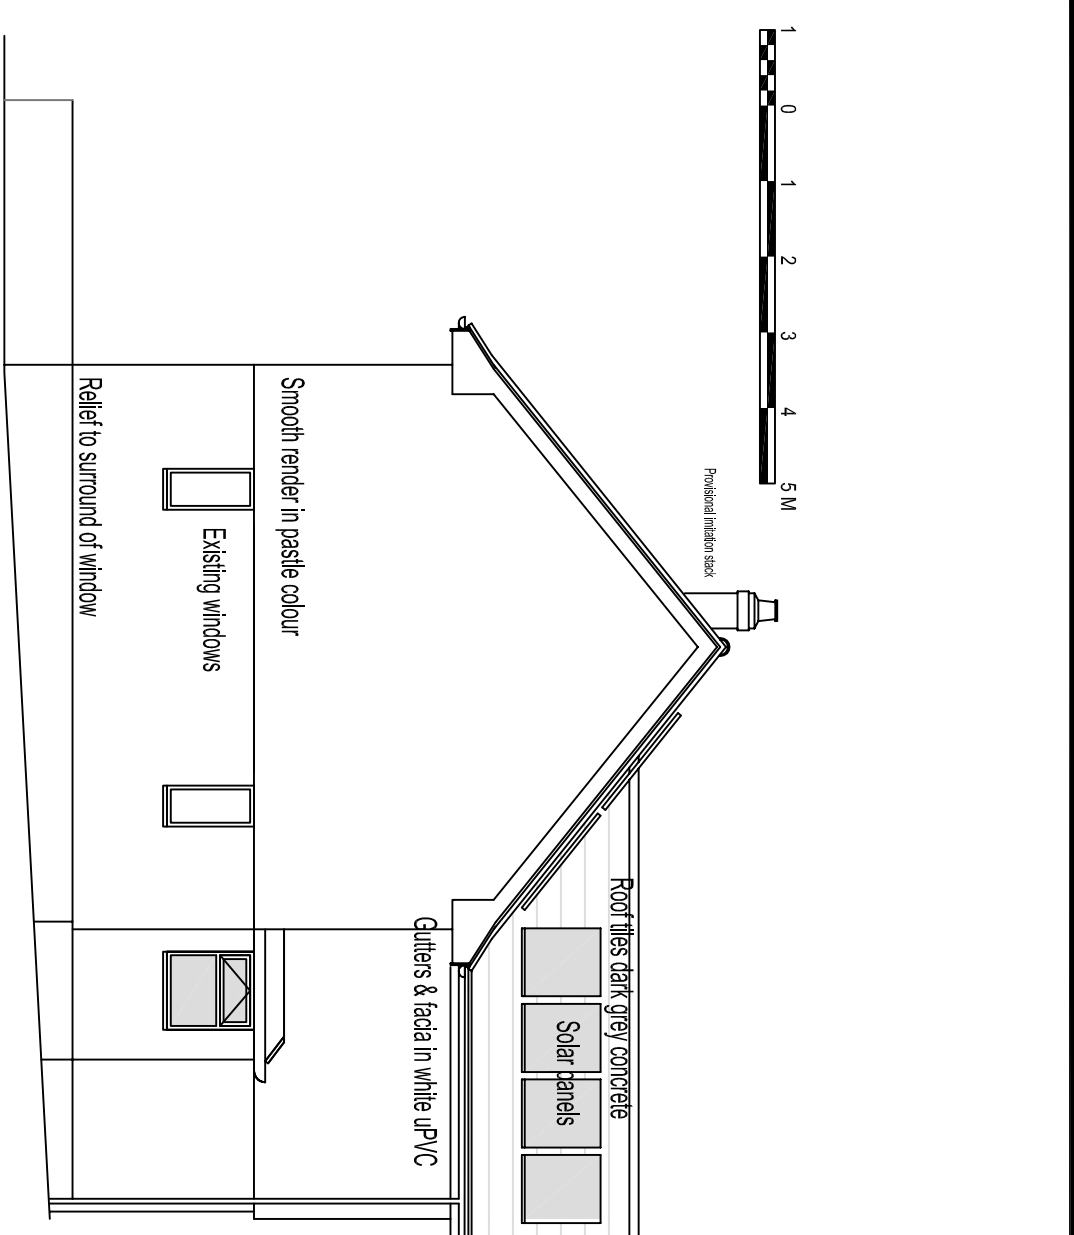


PROPOSED SIDE VIEW FROM 241

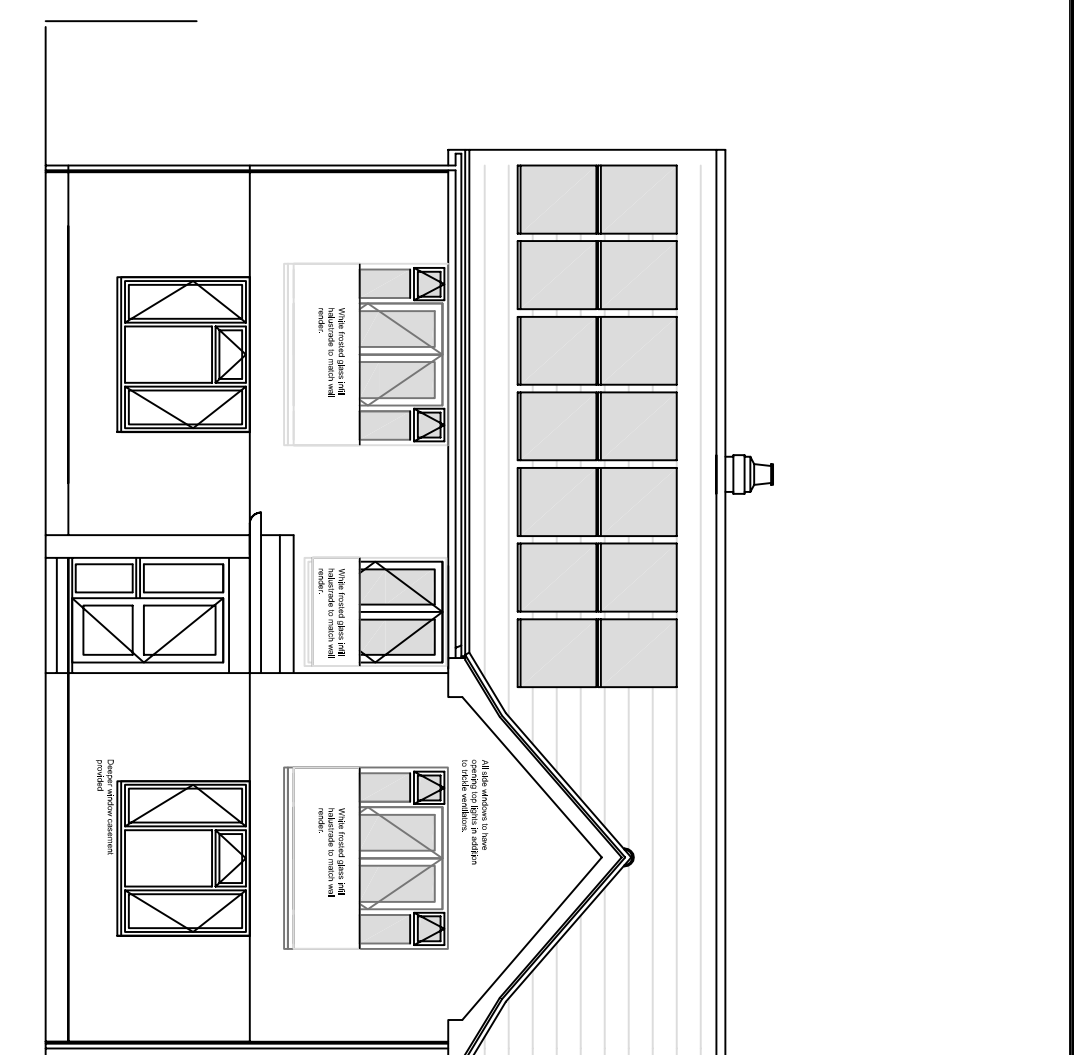



FRONT VIEW

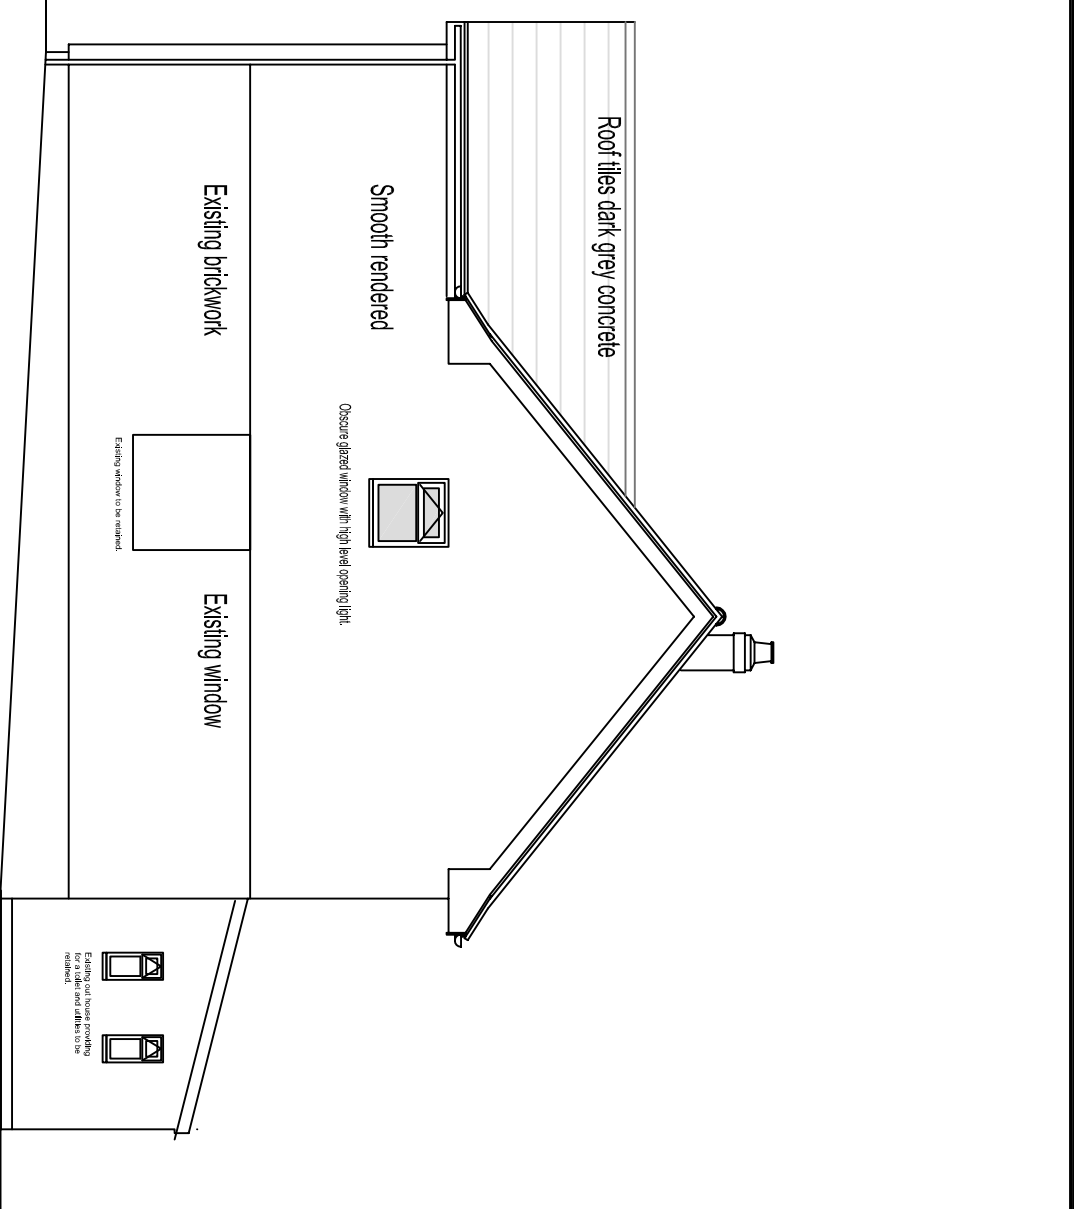


## PROPOSED SIDE HART PLAIN

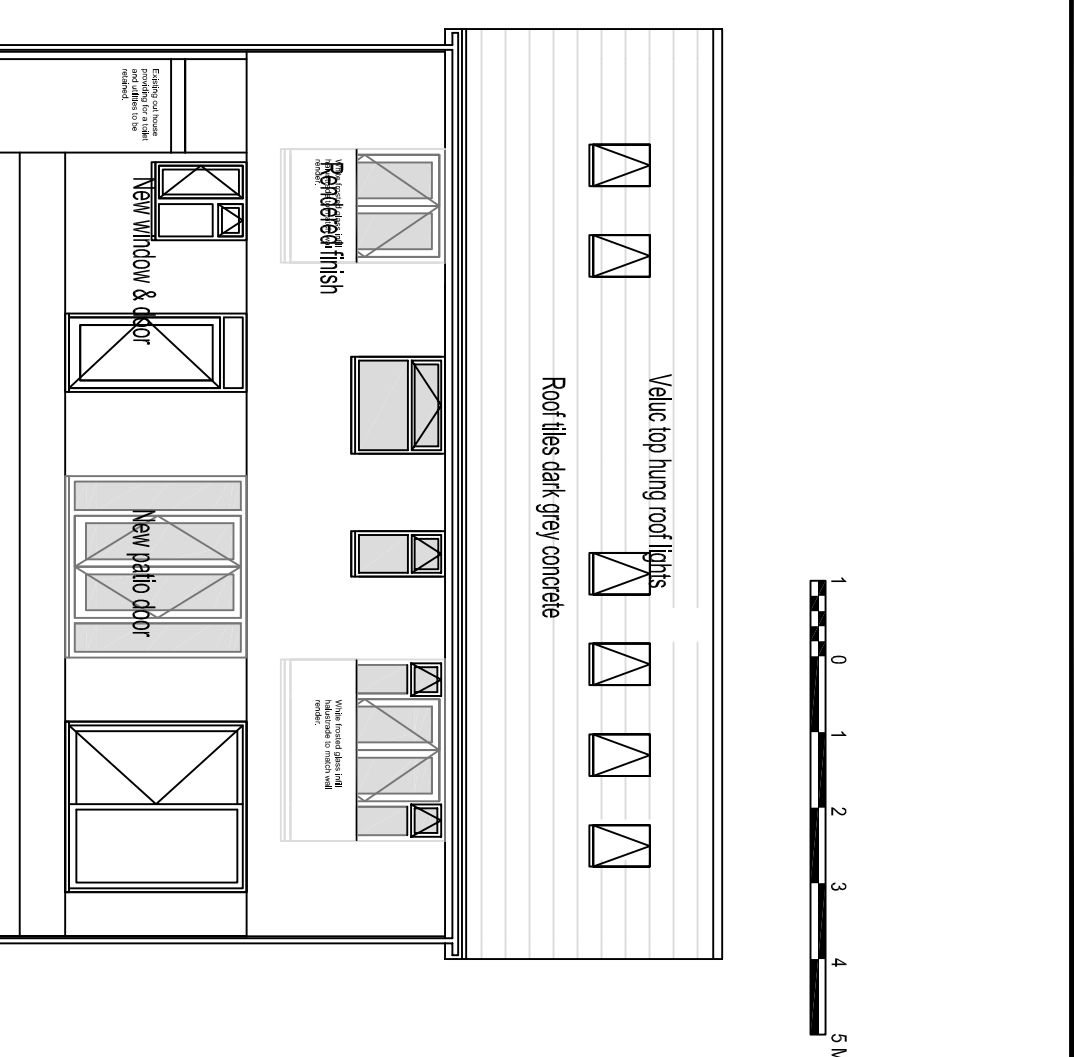


REAR VIEW

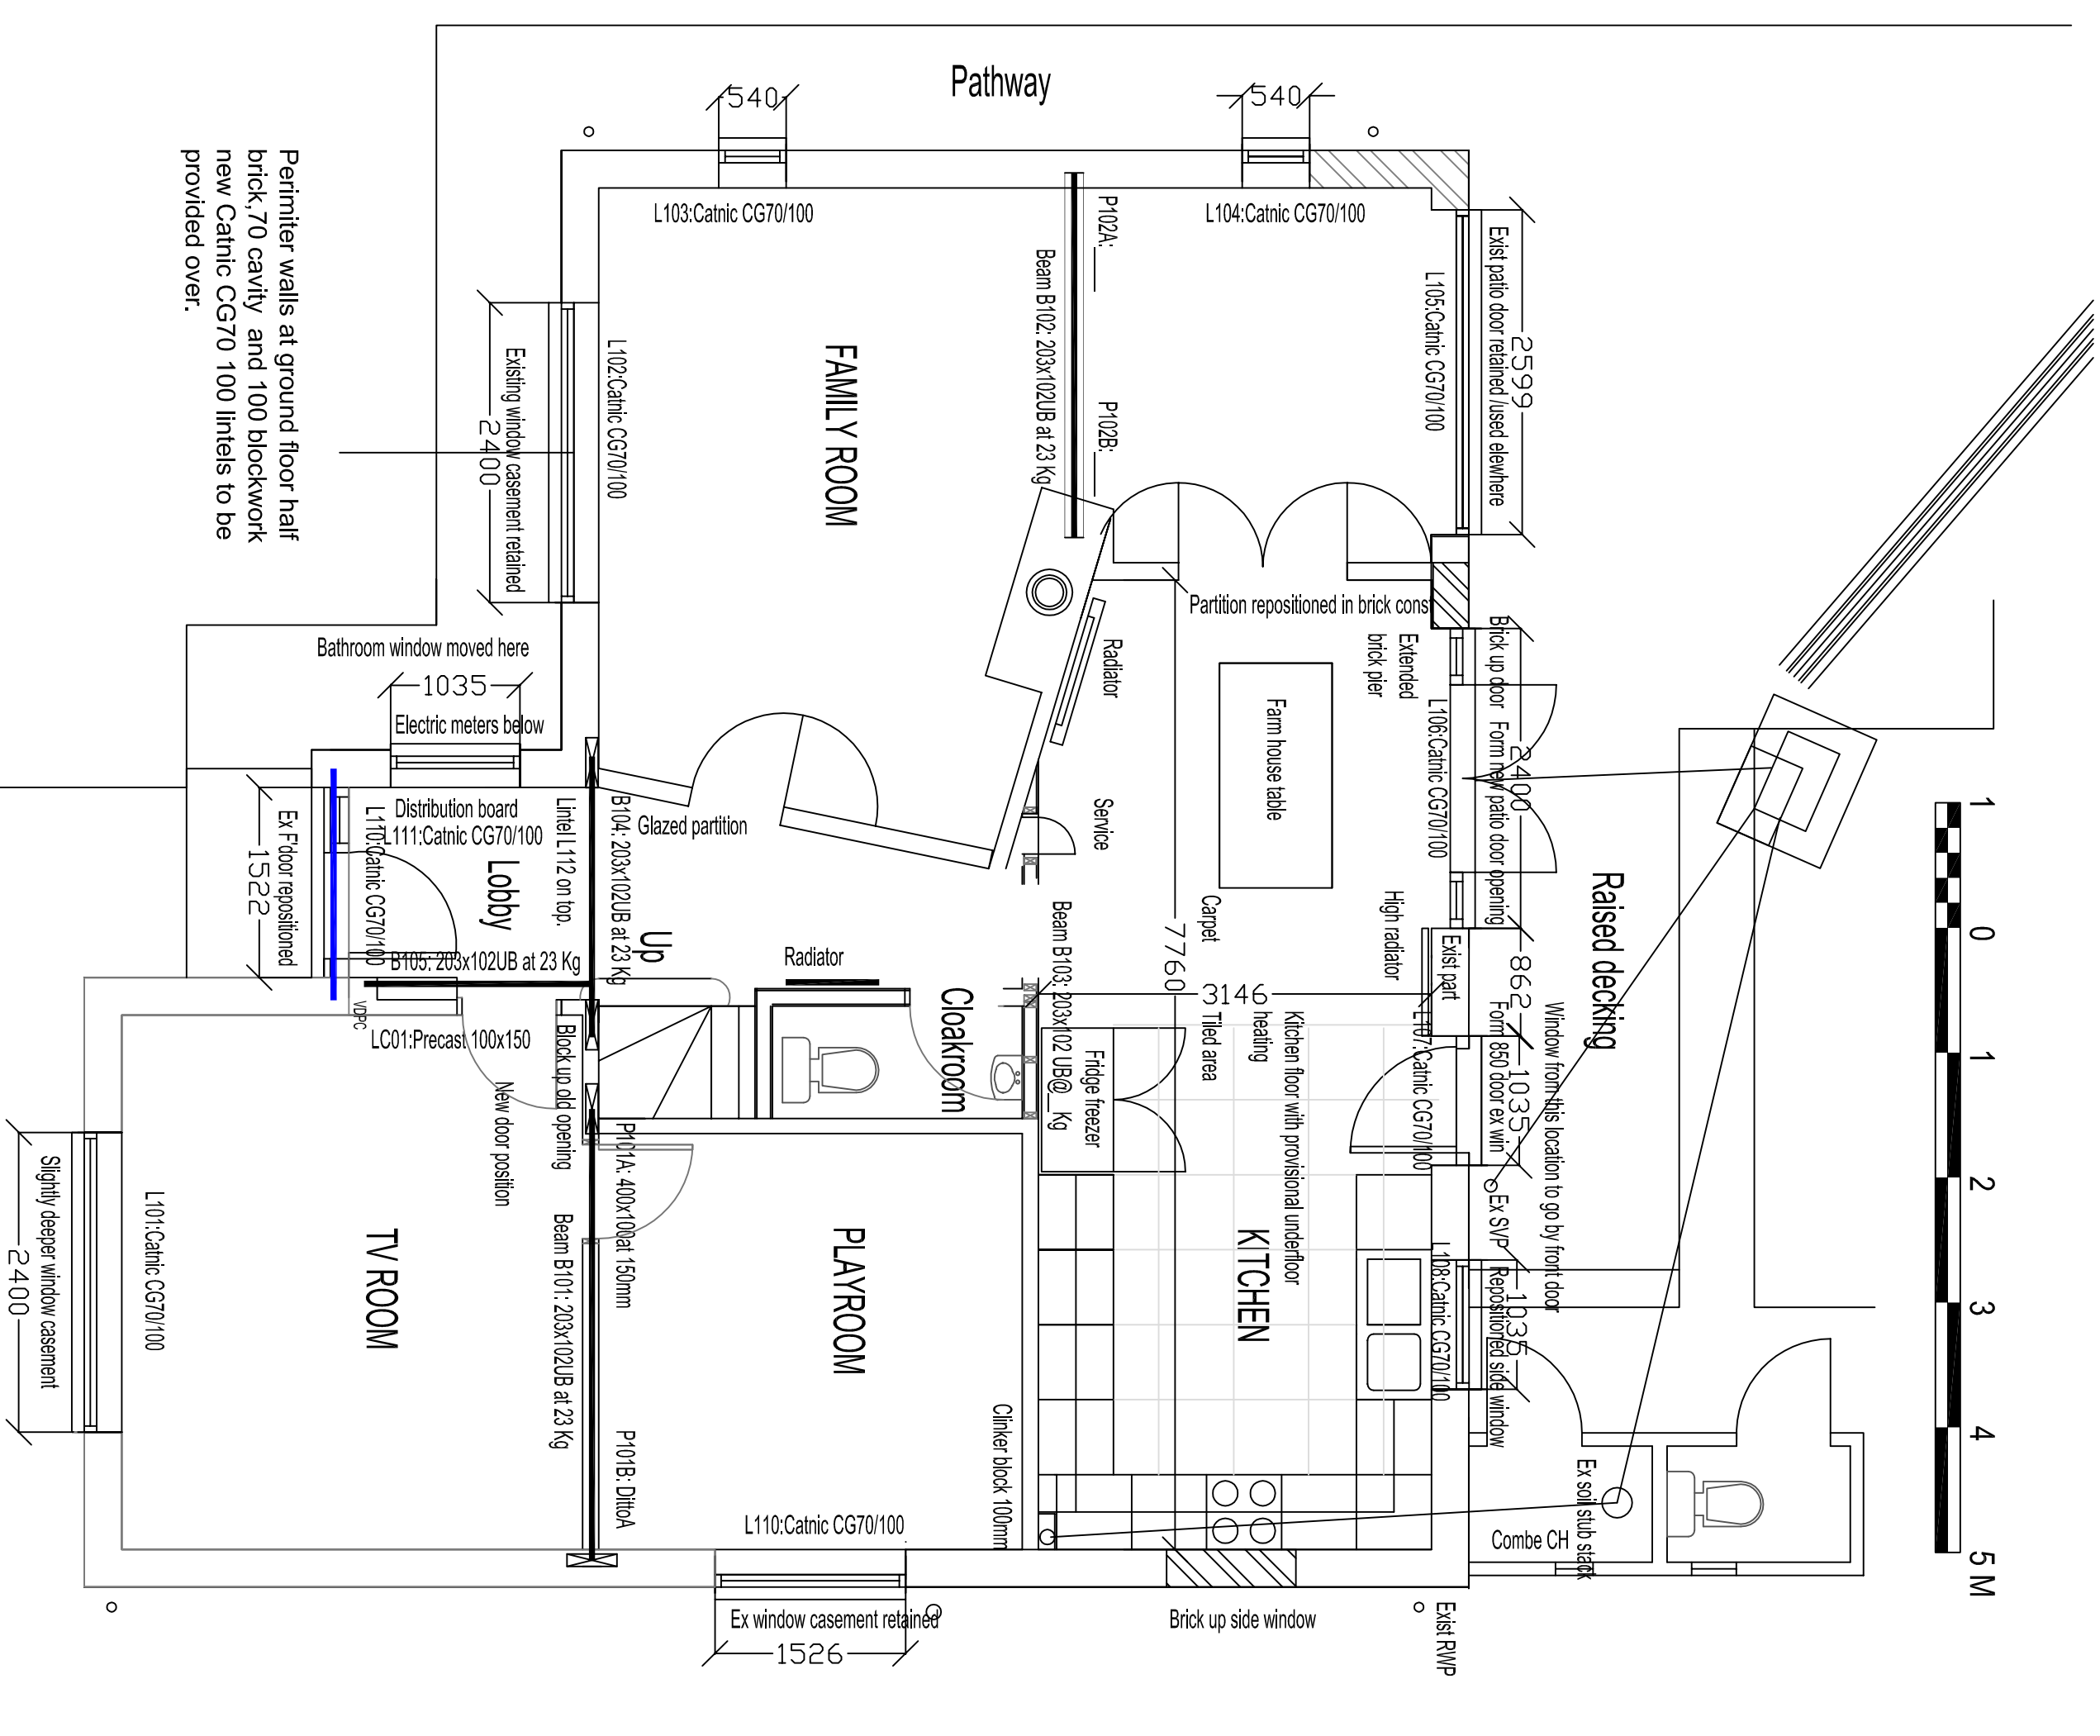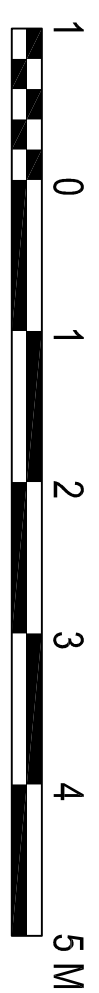

GROUND FLOOR - 1/50

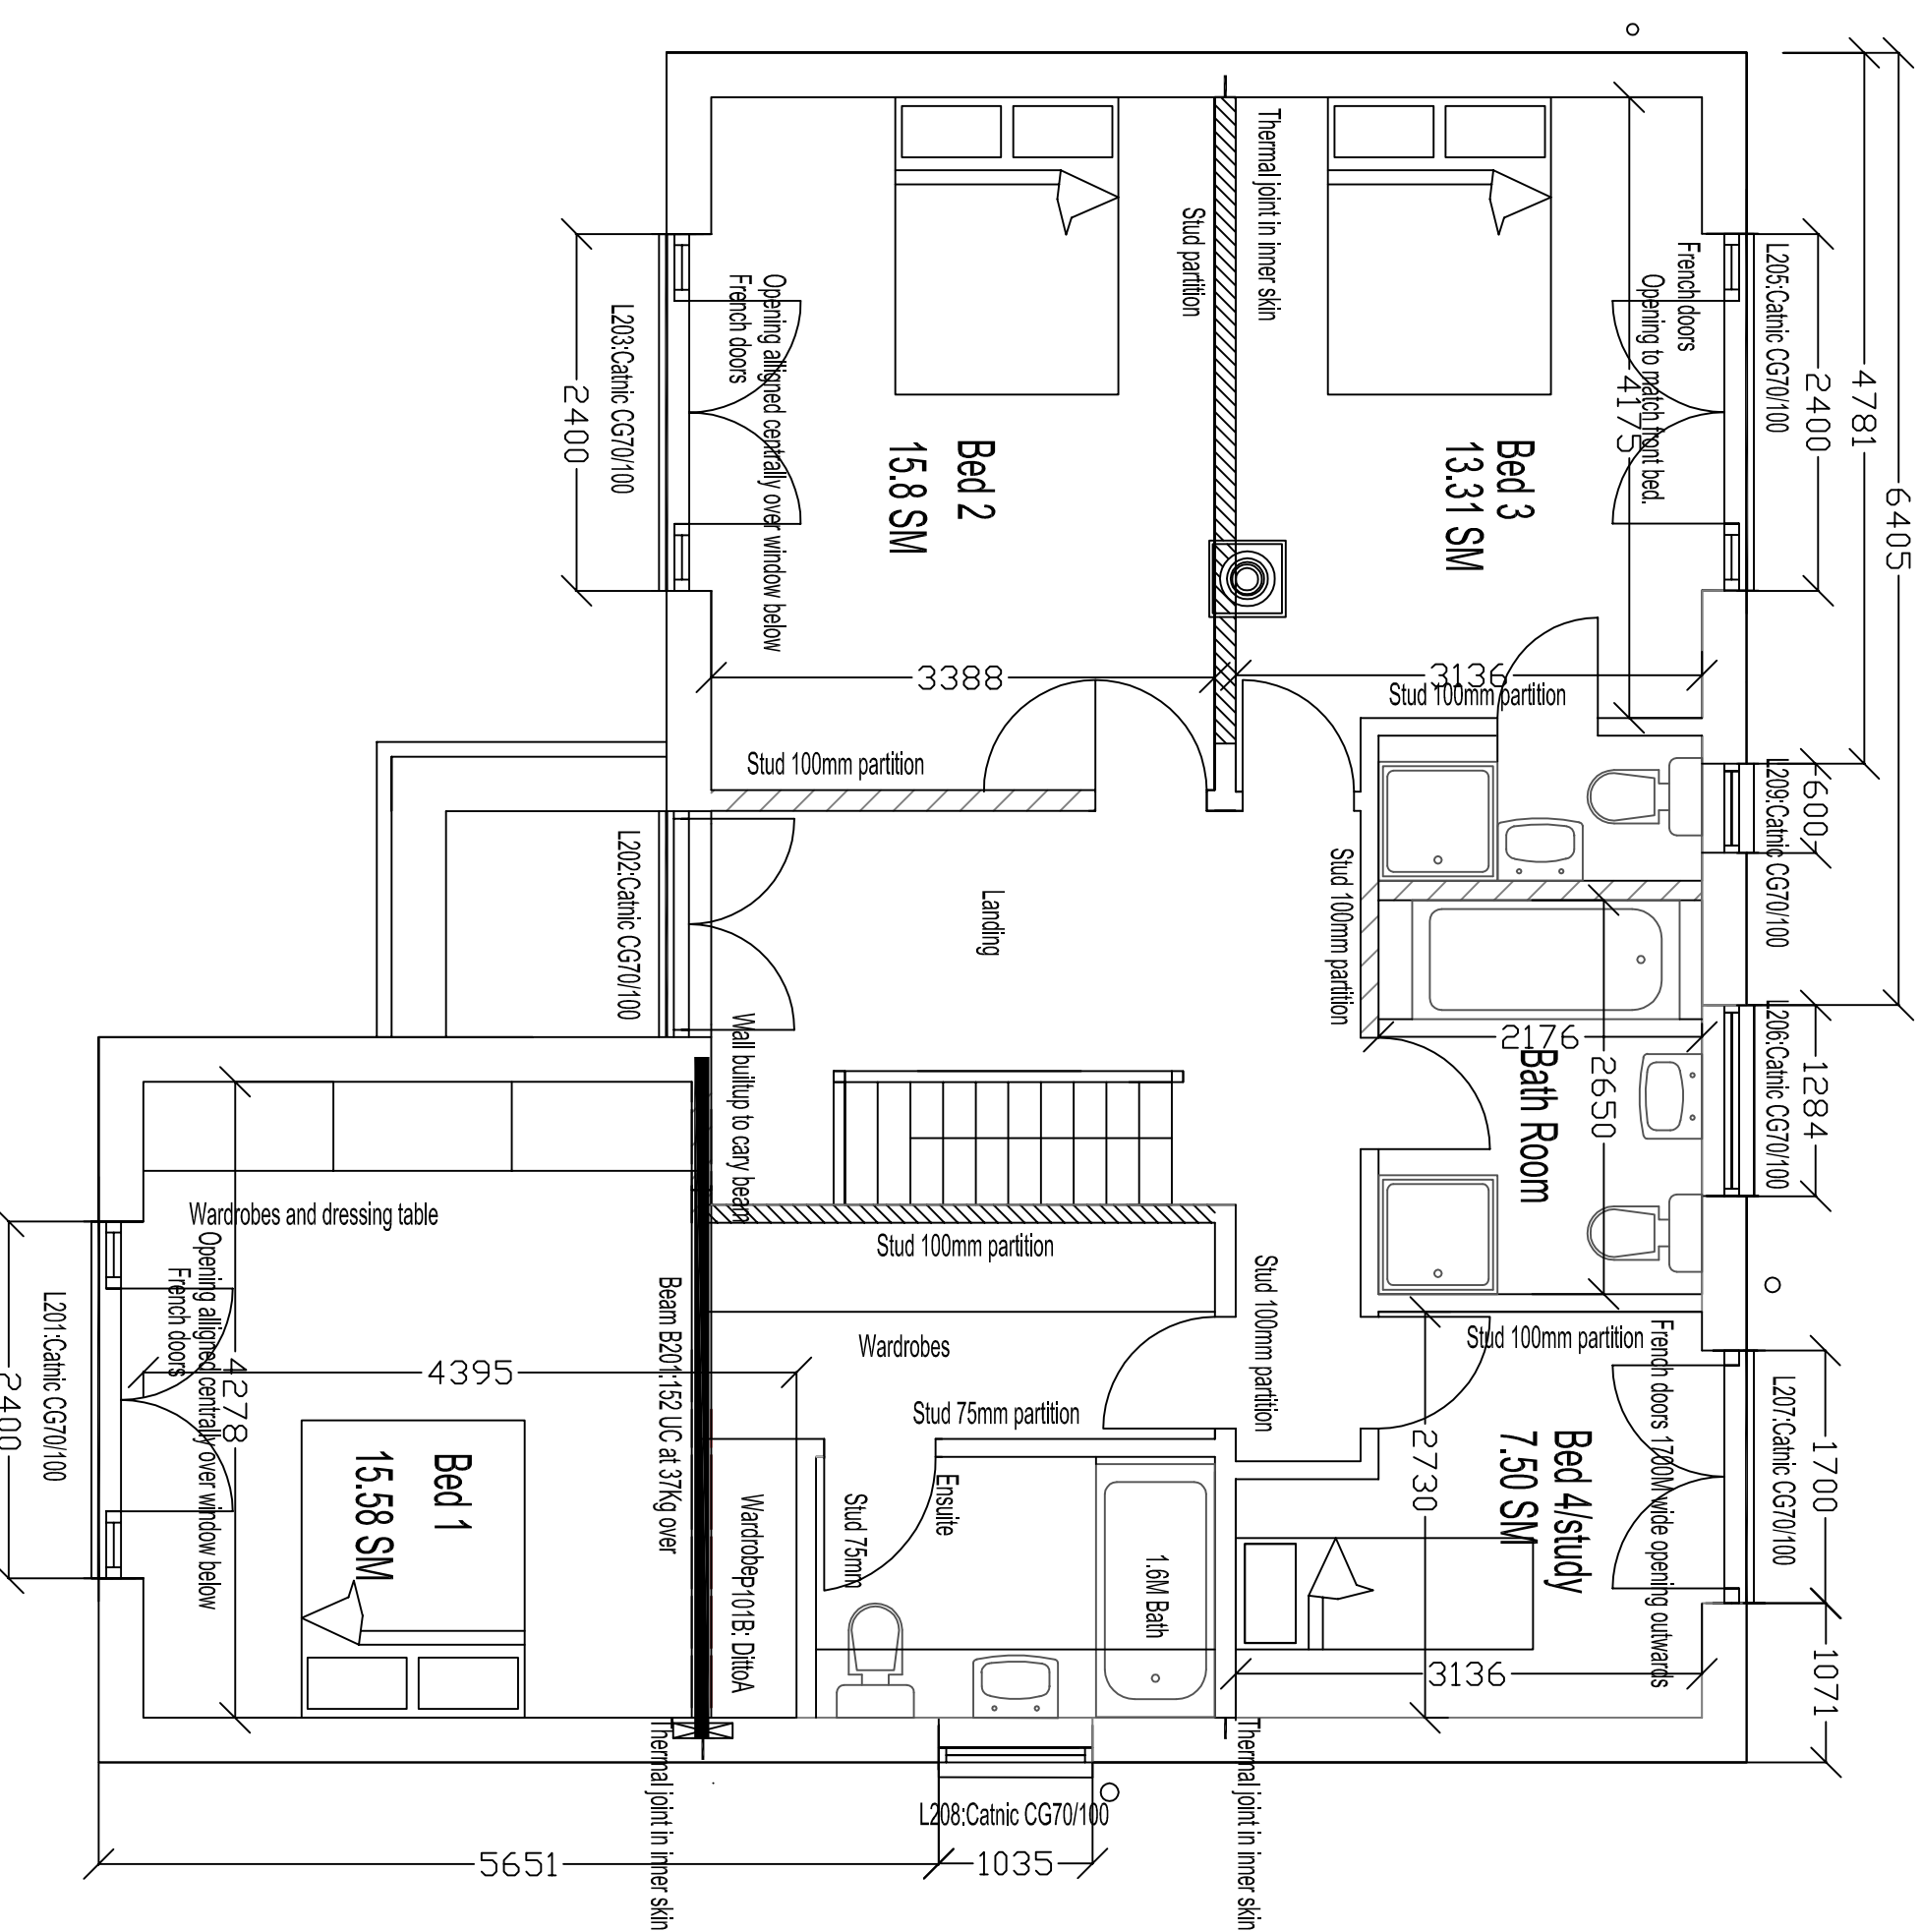

# PROPOSED FIRST FLOOR

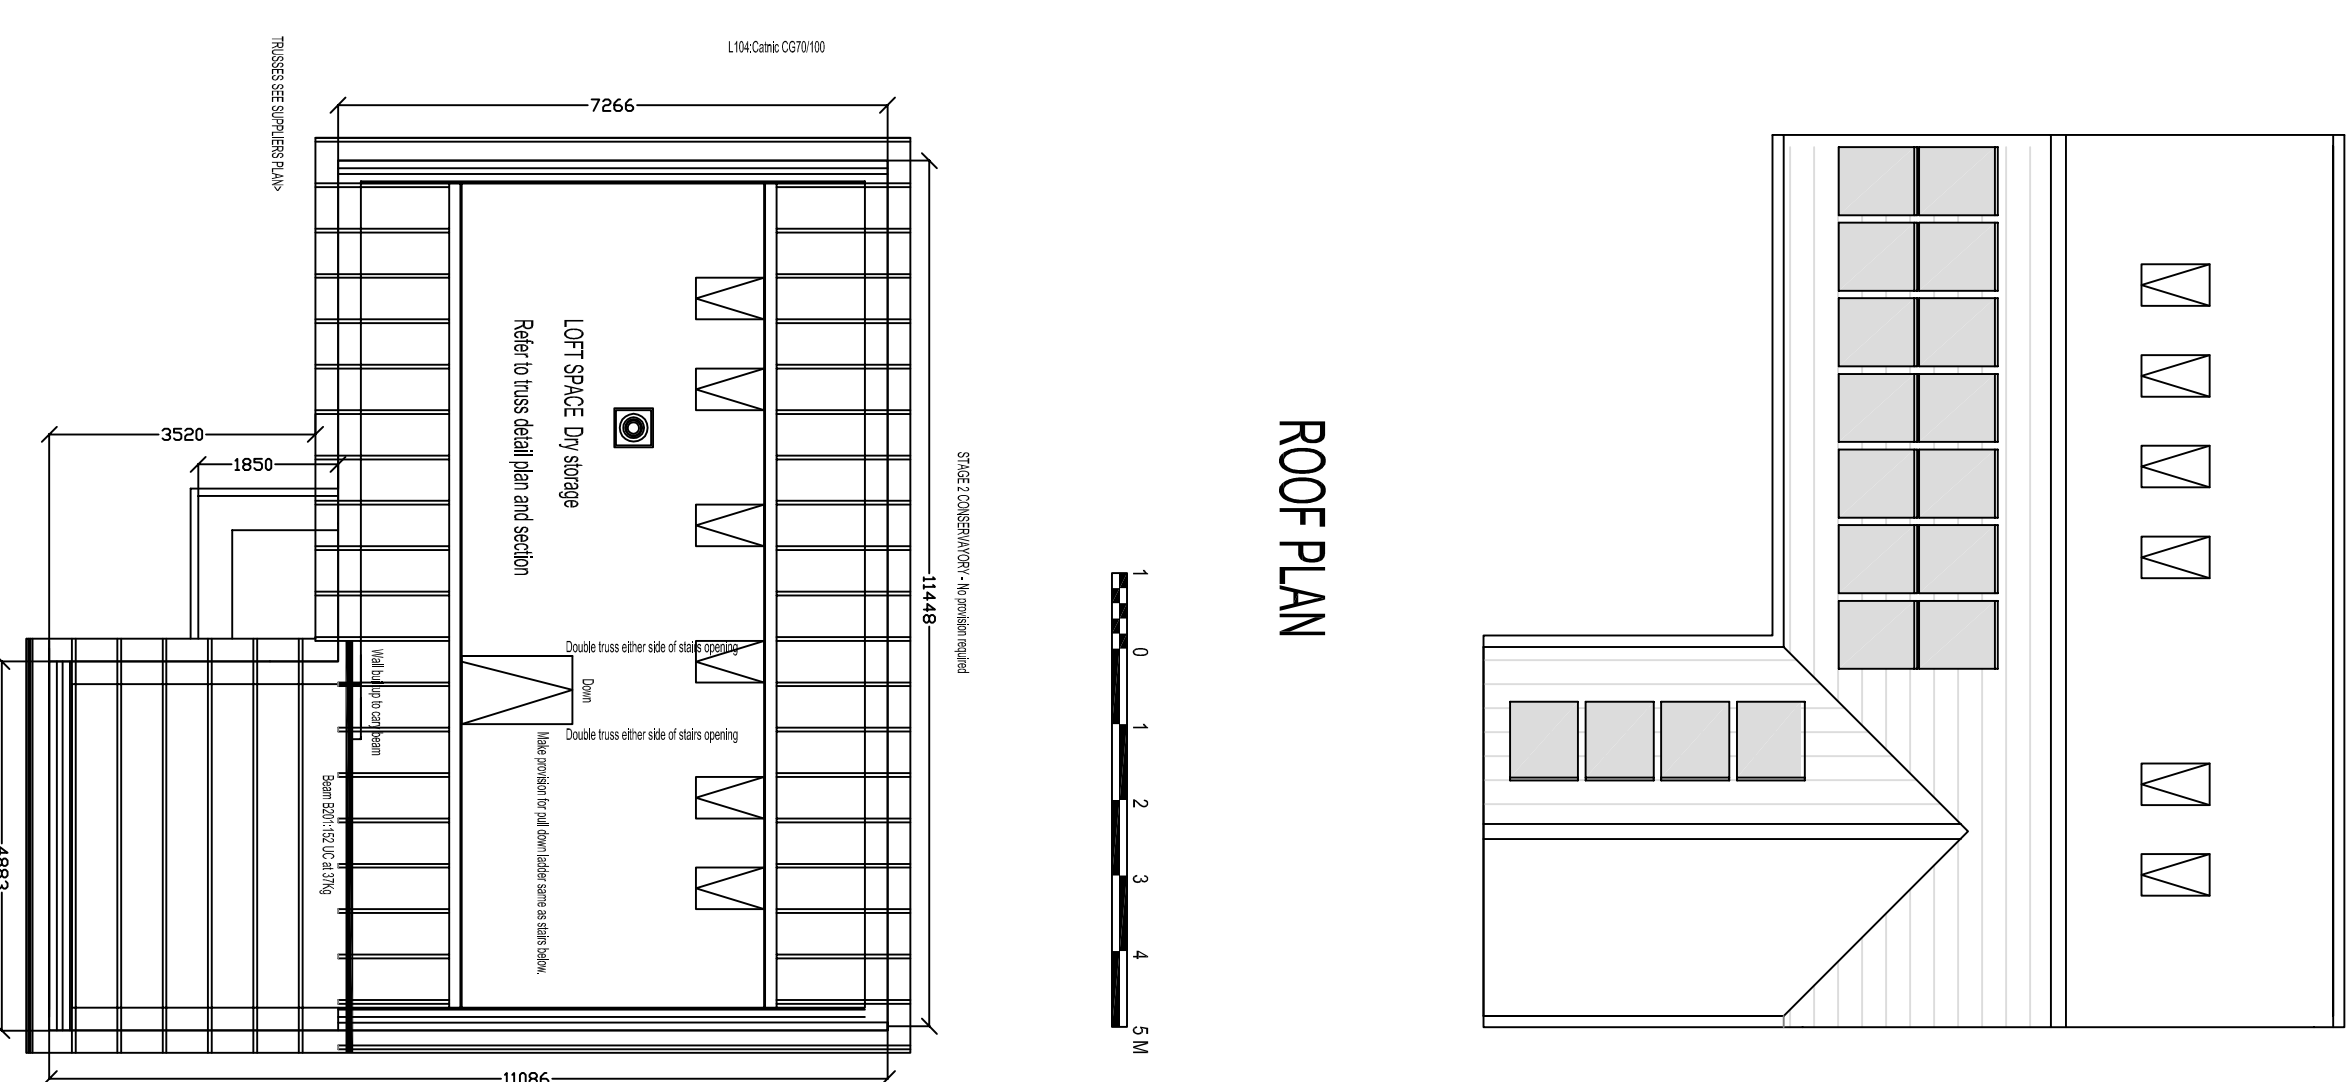

LOFT PLAN - 1/100

|      |  |           |
|------|--|-----------|
|      |  |           |
|      |  |           |
|      |  |           |
|      |  |           |
| Date |  | Revisions |
|      |  |           |

**Materials of construction to match existing**

|           |                                                                                   |
|-----------|-----------------------------------------------------------------------------------|
| Client    |                                                                                   |
| Job Title | <p>243 LONDON ROAD<br/>         Waterboville, PO8 8DD</p> <p>ADDITIONAL FLOOR</p> |

Drawing Title  
AS BUILT

T&amp;CP Ac Post LDC:Proposed

Scale  
1/200, 1/100 & 1/50

|      |                 |
|------|-----------------|
| Date | Drawn by<br>CTL |
|------|-----------------|

|           |     |
|-----------|-----|
| Drq No.   | Rev |
| 11/01-176 | J   |