


PROPOSED ADDITION AND CONSERVATORY.
67, SOUTHWOOD ROAD, HAYLING ISLAND, HANTS.
FOR MR & MRS B. HAMMOND.

HAVANT BOROUGH
COUNCIL
21 NOV 2016
RECEIVED

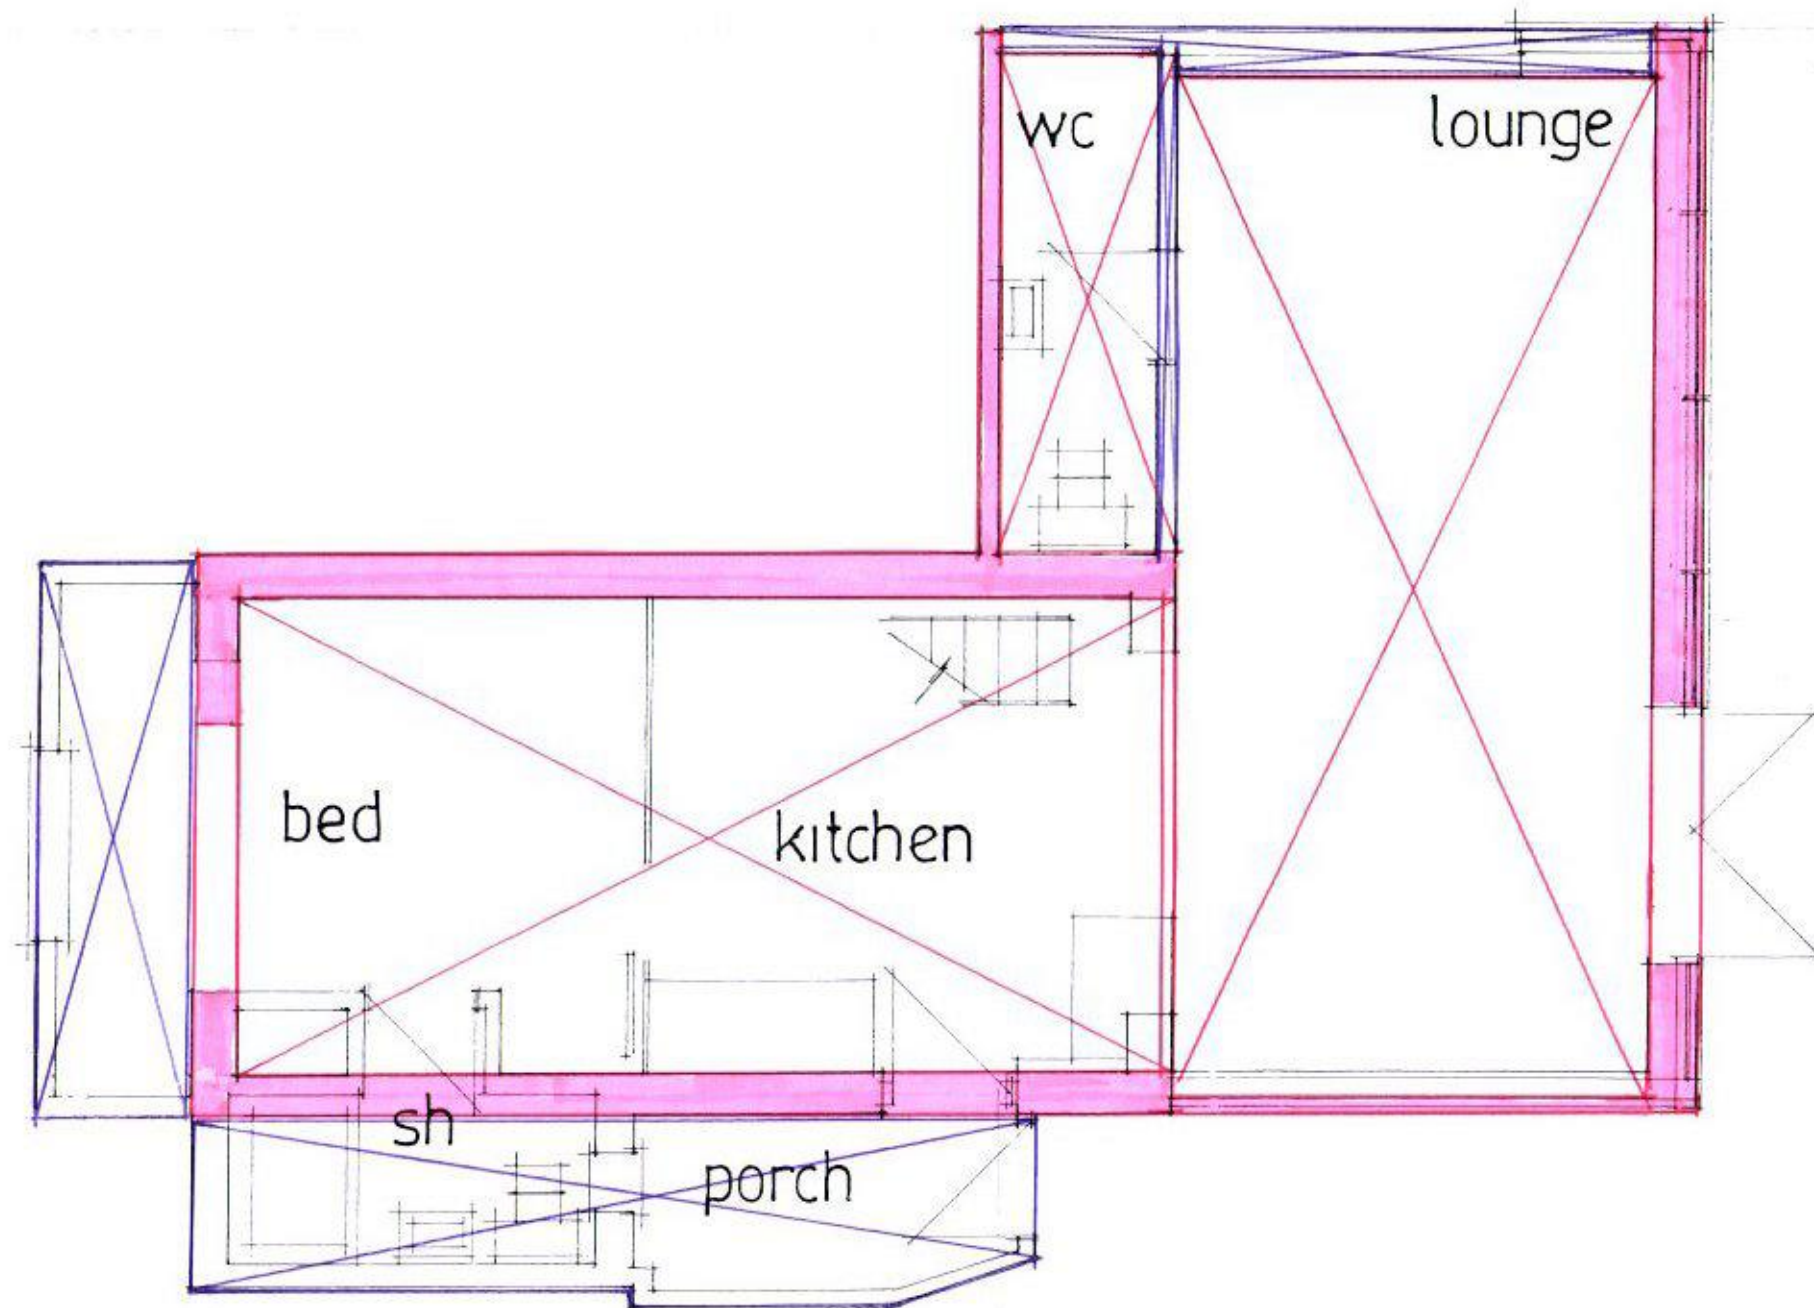

WALLS REMAINING SHOWN IN RED 
FLOORS REMAINING SHOWN AS RED CROSS 
WALLS AND FLOORS REMOVE IN BLUE CROSS 
ALL EXISTING ROOFS REMOVED
OUTLINED IN GREEN (DRAWING 07) 

date NOV. 2016
scale 1:50 DRAWING NO: PJ/PER.06

EXISTING LAYOUT