



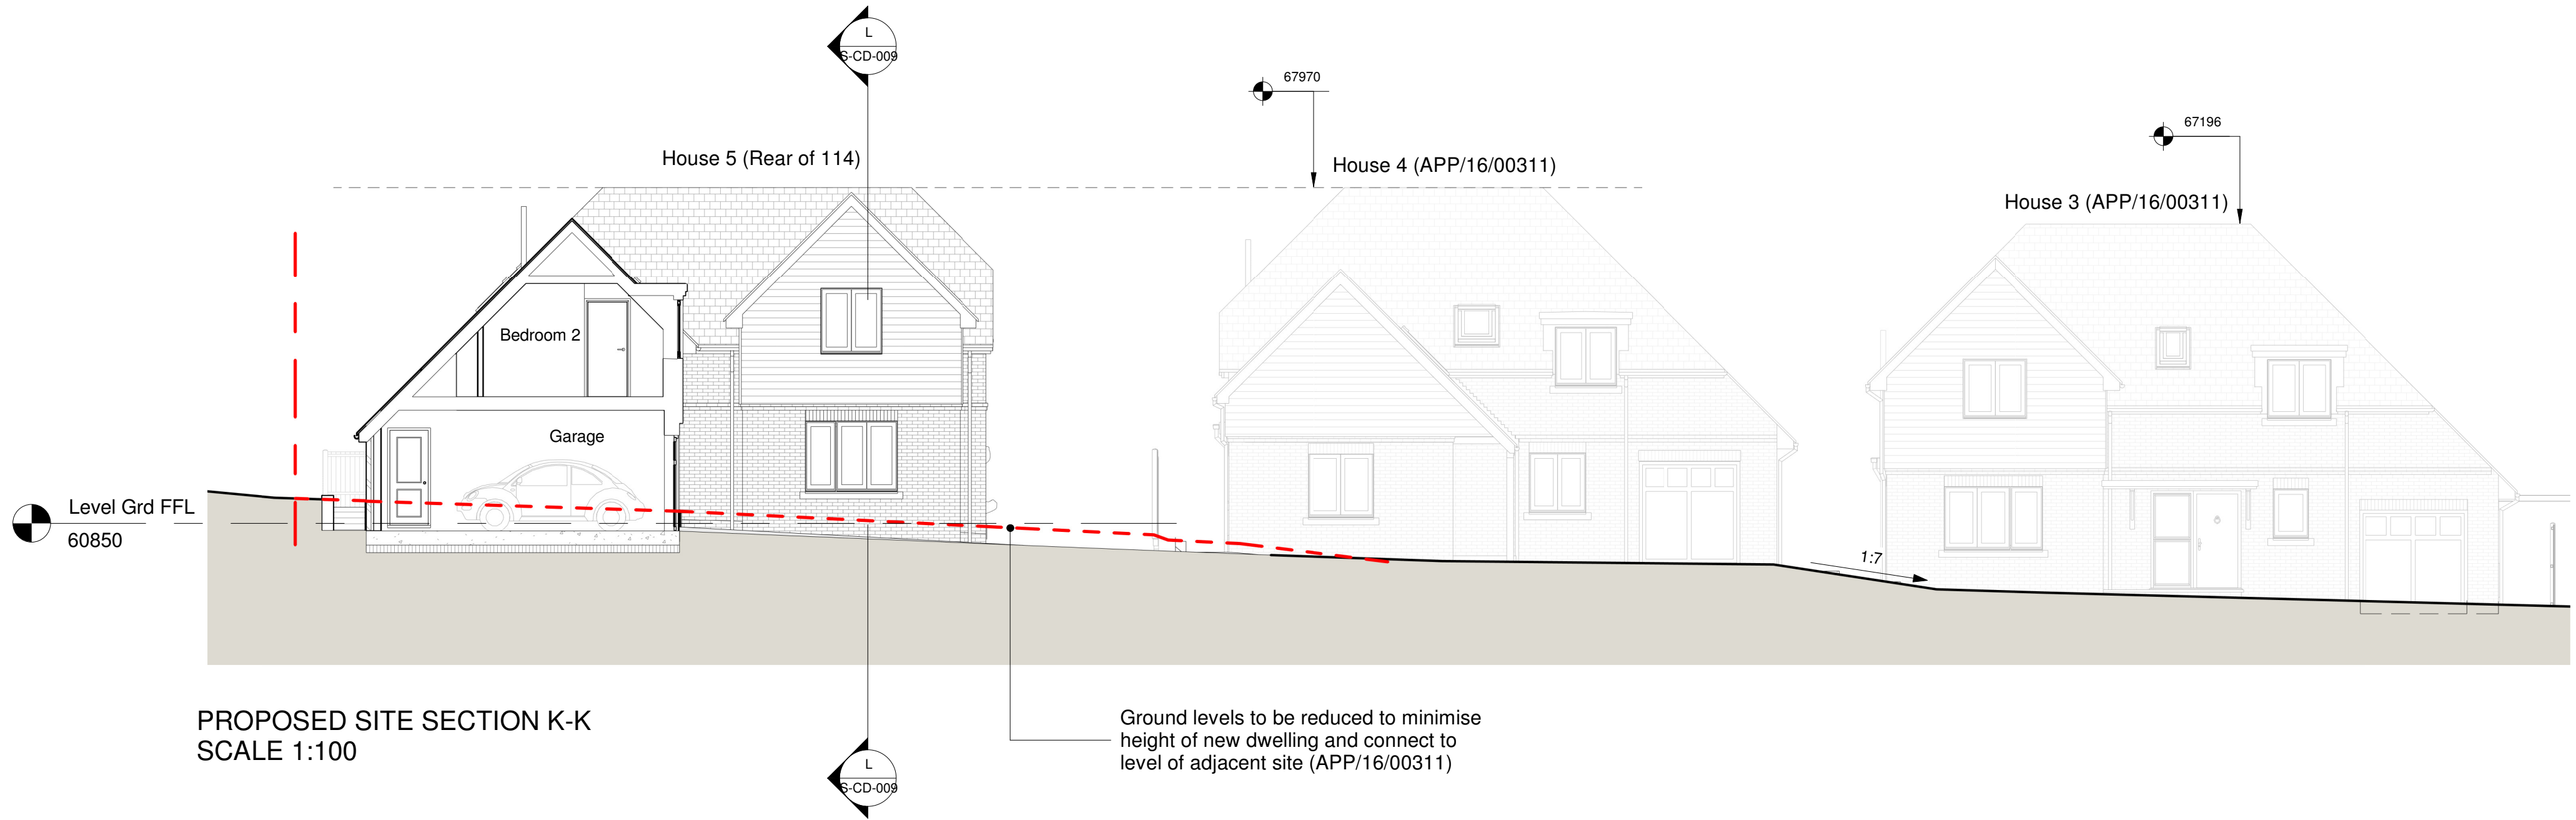

PROPOSED SITE SECTION K-K
SCALE 1:100

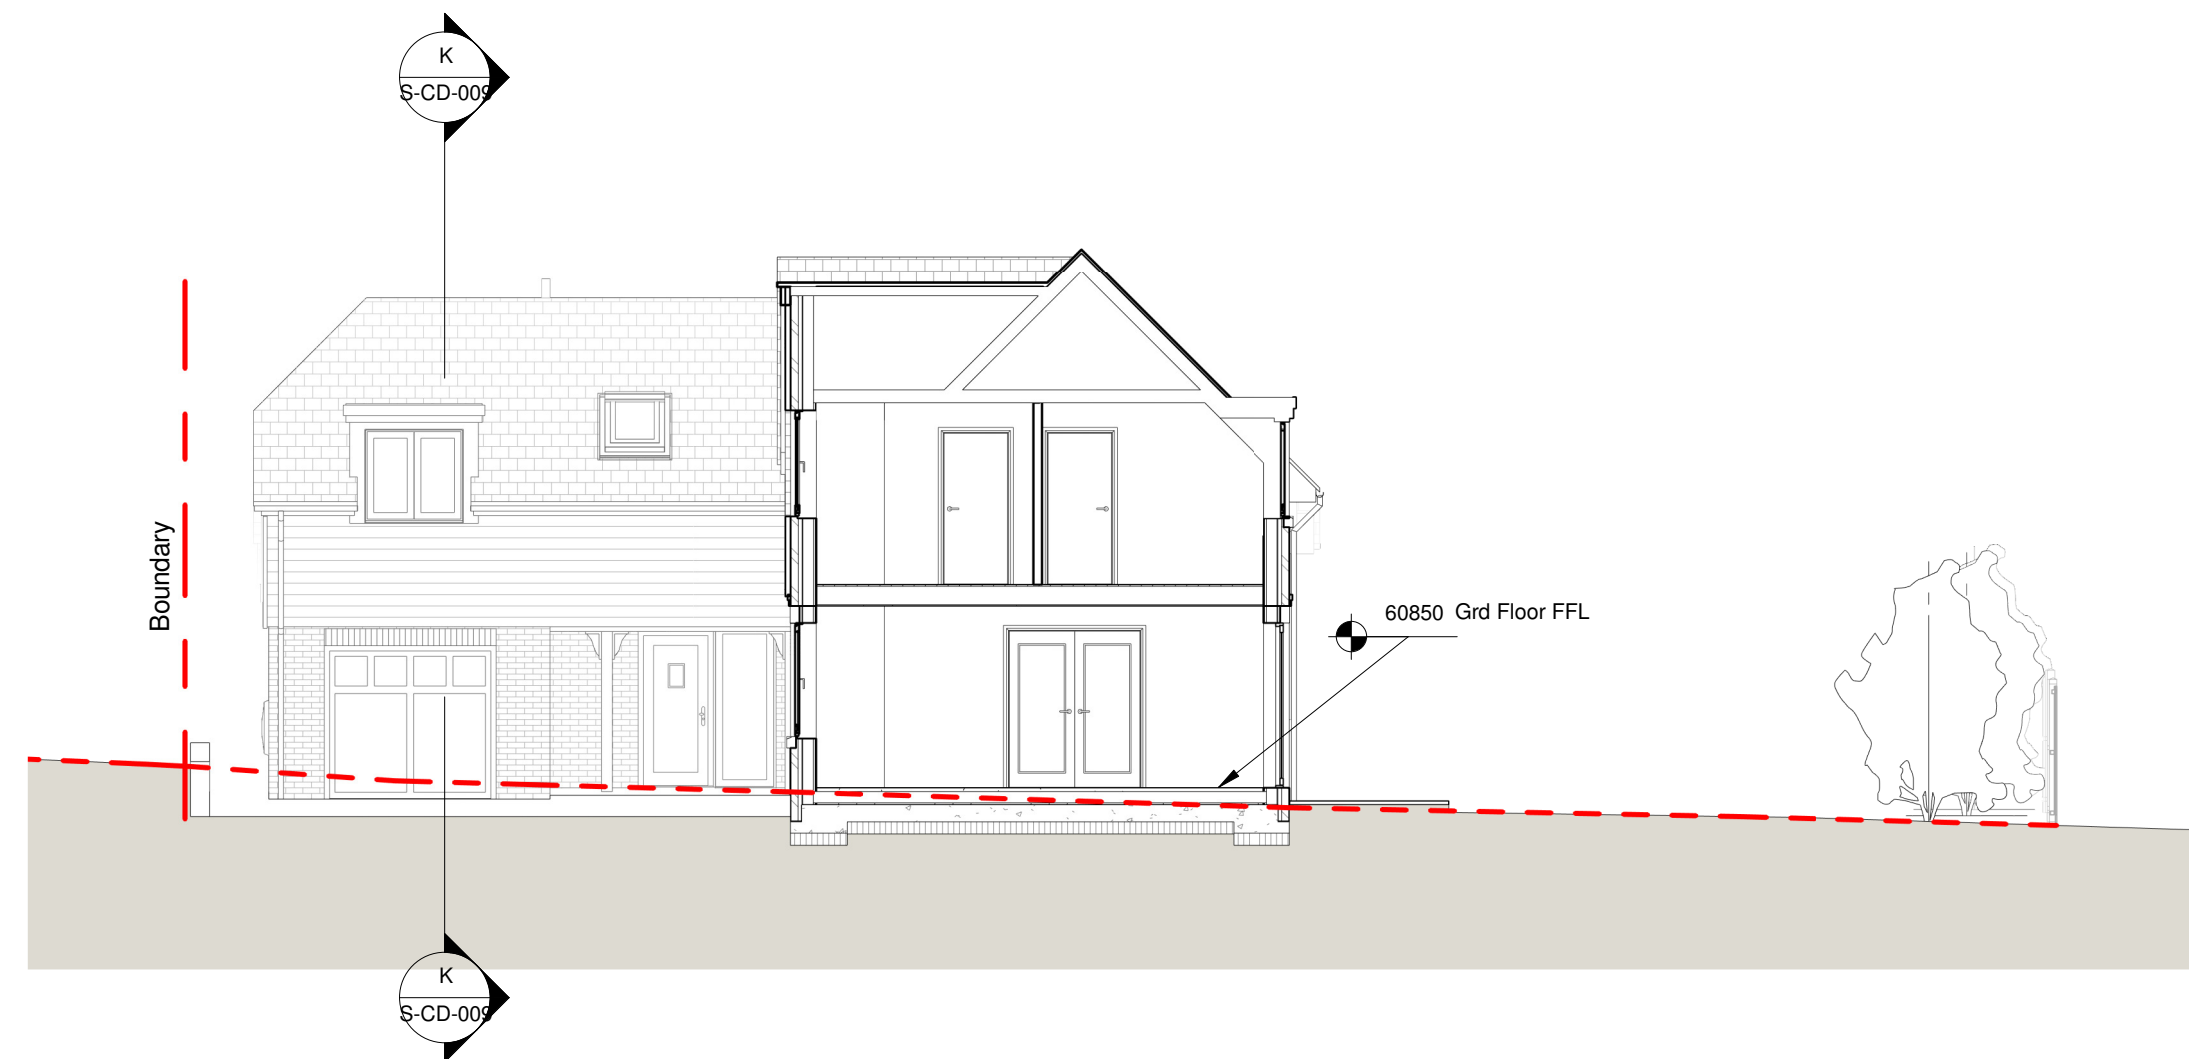

PROPOSED SITE SECTION L-L
SCALE 1:100

LEGEND

Red Line shows existing topography as per measured survey drawing ST-EX-02

No.	Description	Date

DO NOT SCALE FROM THIS DRAWING REFER TO ANNOTATED DIMENSIONS ONLY

All Dimensions to be confirmed on site. Designer to be notified by the contractor if any discrepancies occur before construction begins.

Style Front London Ltd
Chester House, Fulham Green
81-83 Fulham High Street
Fulham, London
SW6 3JA
Tel: +44 (0)293 7139301
Email: info@stylefront.co.uk

© 2016 - The contents of this drawing and the designs depicted are and remain the exclusive property under copyright of Style Front London Ltd.


Client: Style Front Holdings Ltd

Project: 112-114 London Road, Cowplain, PO8 8HB

Drawing Title: House 5 - Proposed Ground FFL

Drawing No: S-CD-009

Rev:

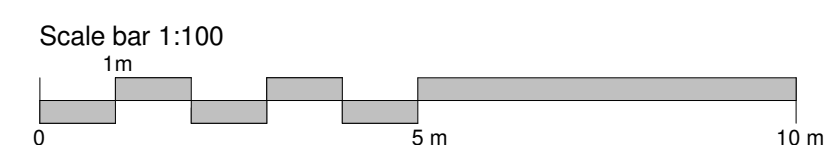

Project No: 112LR Date: 15-03-2017 Scale: 1 : 100 @ A2