




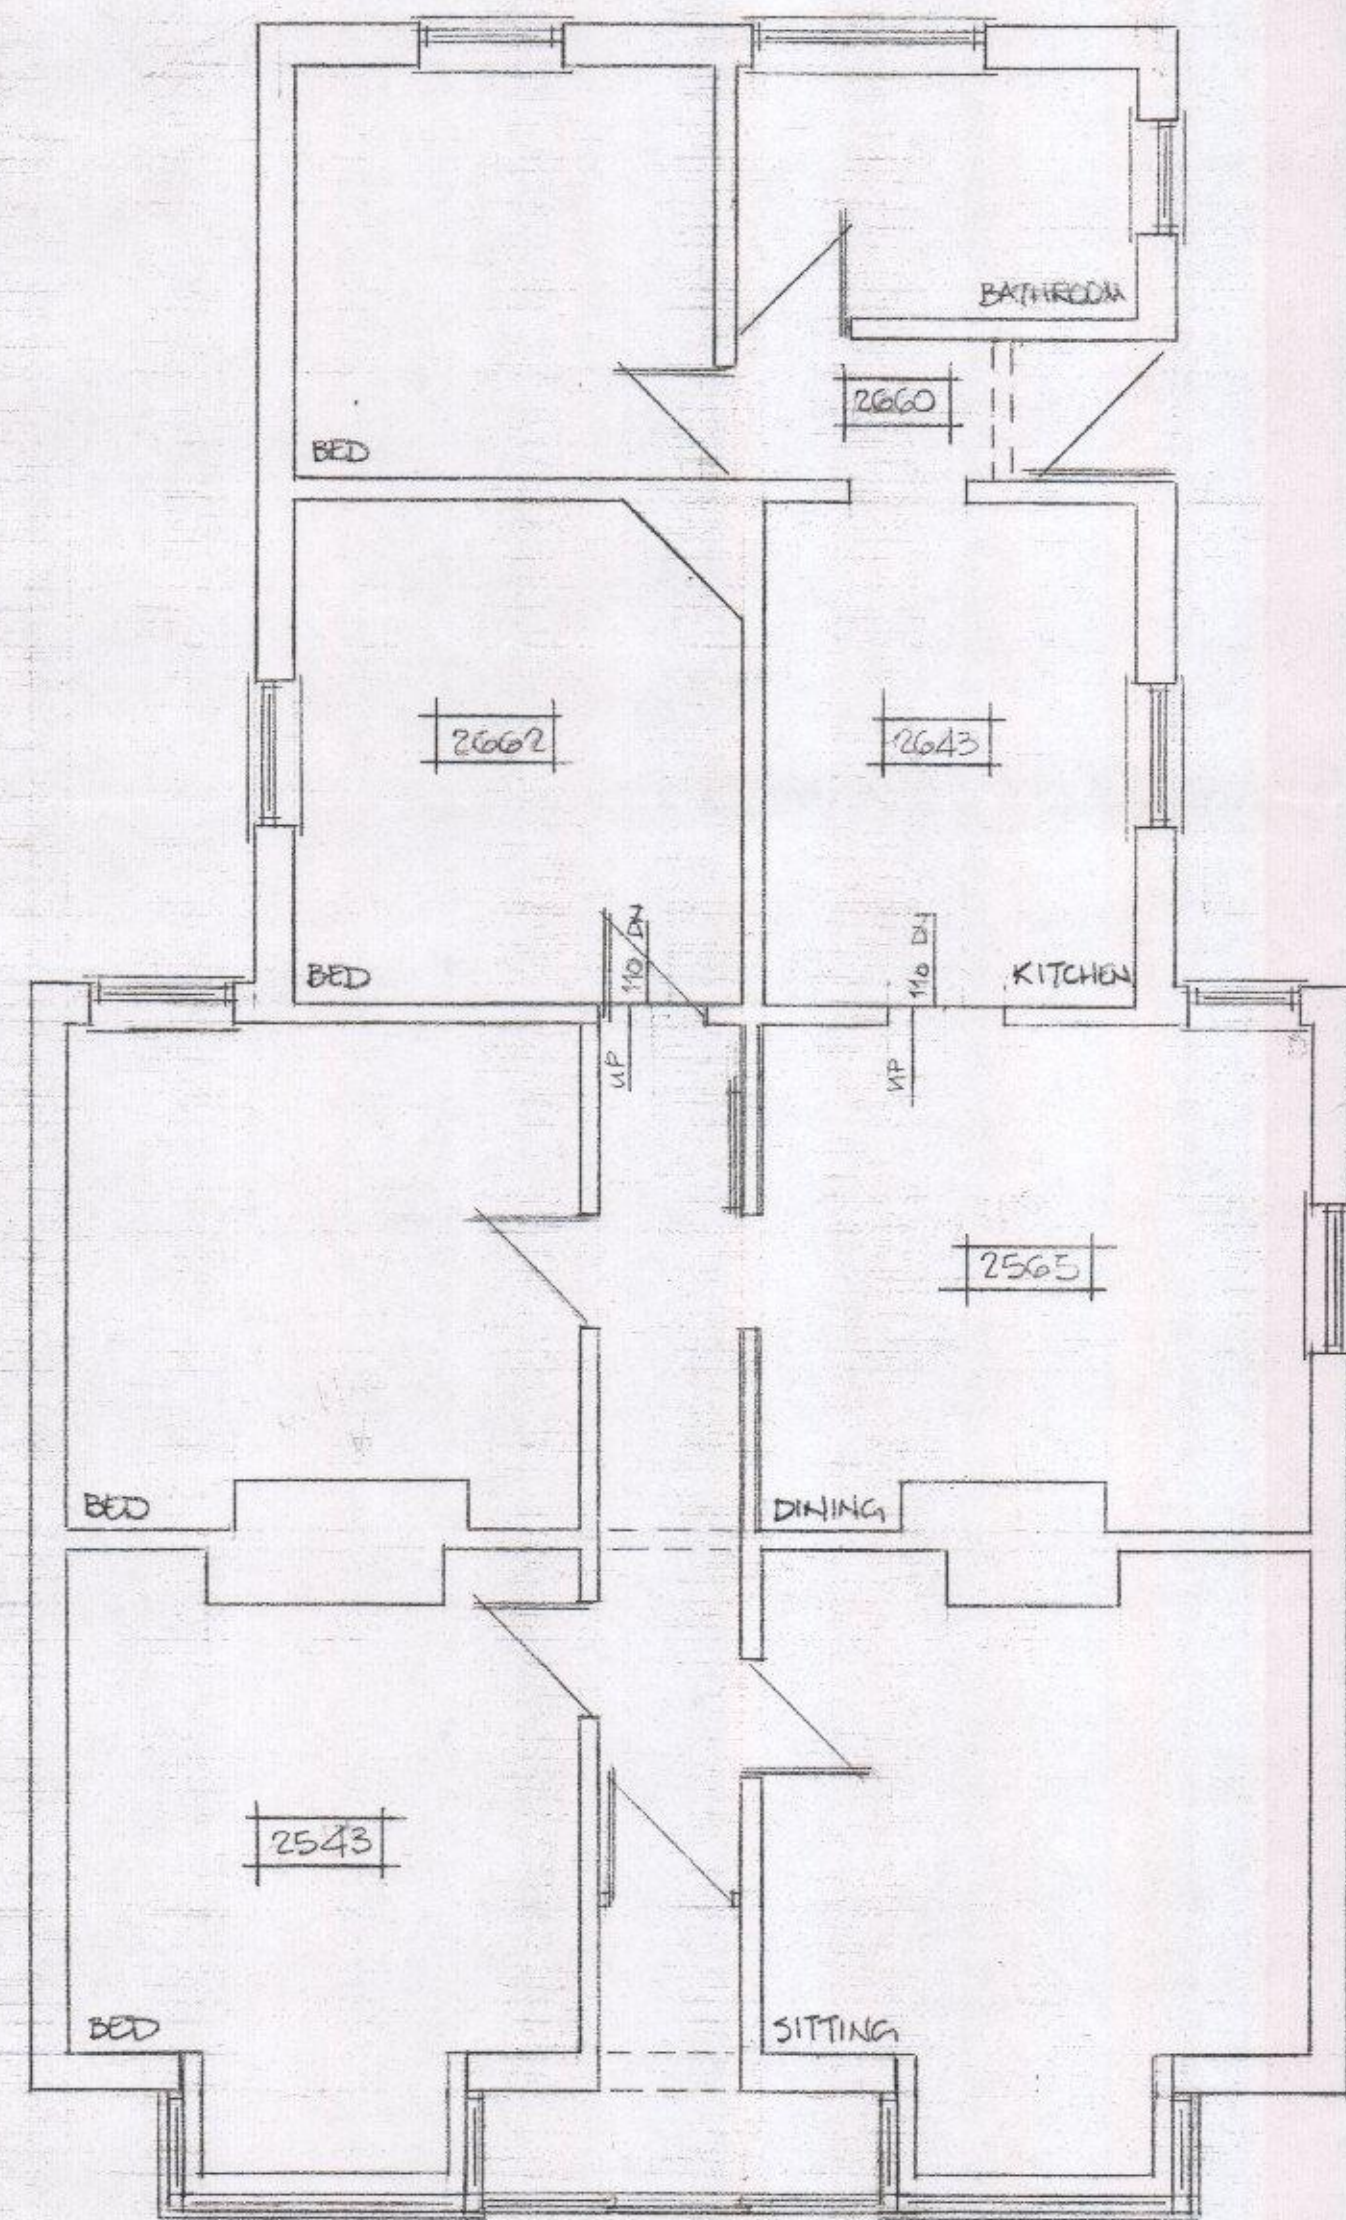


GROUND PLAN

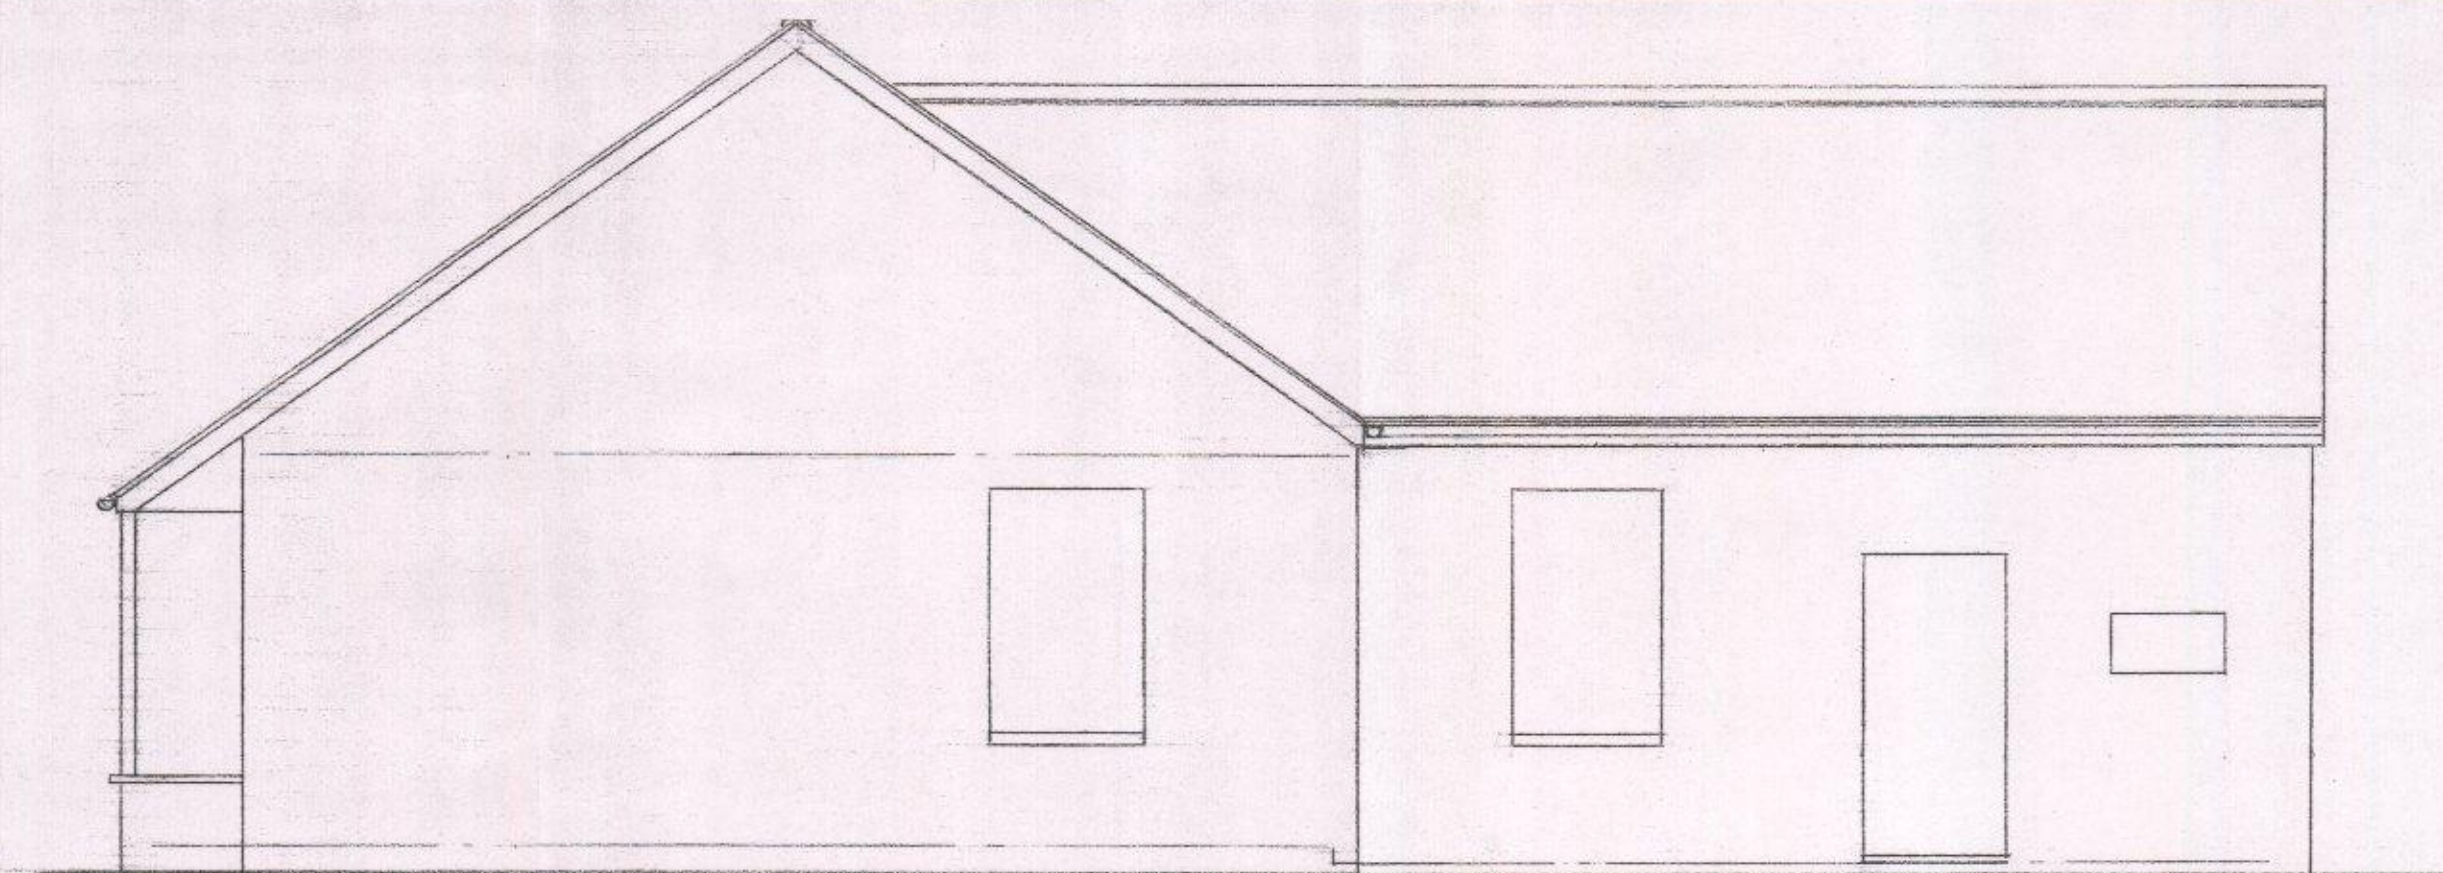

WEST ELEVATION

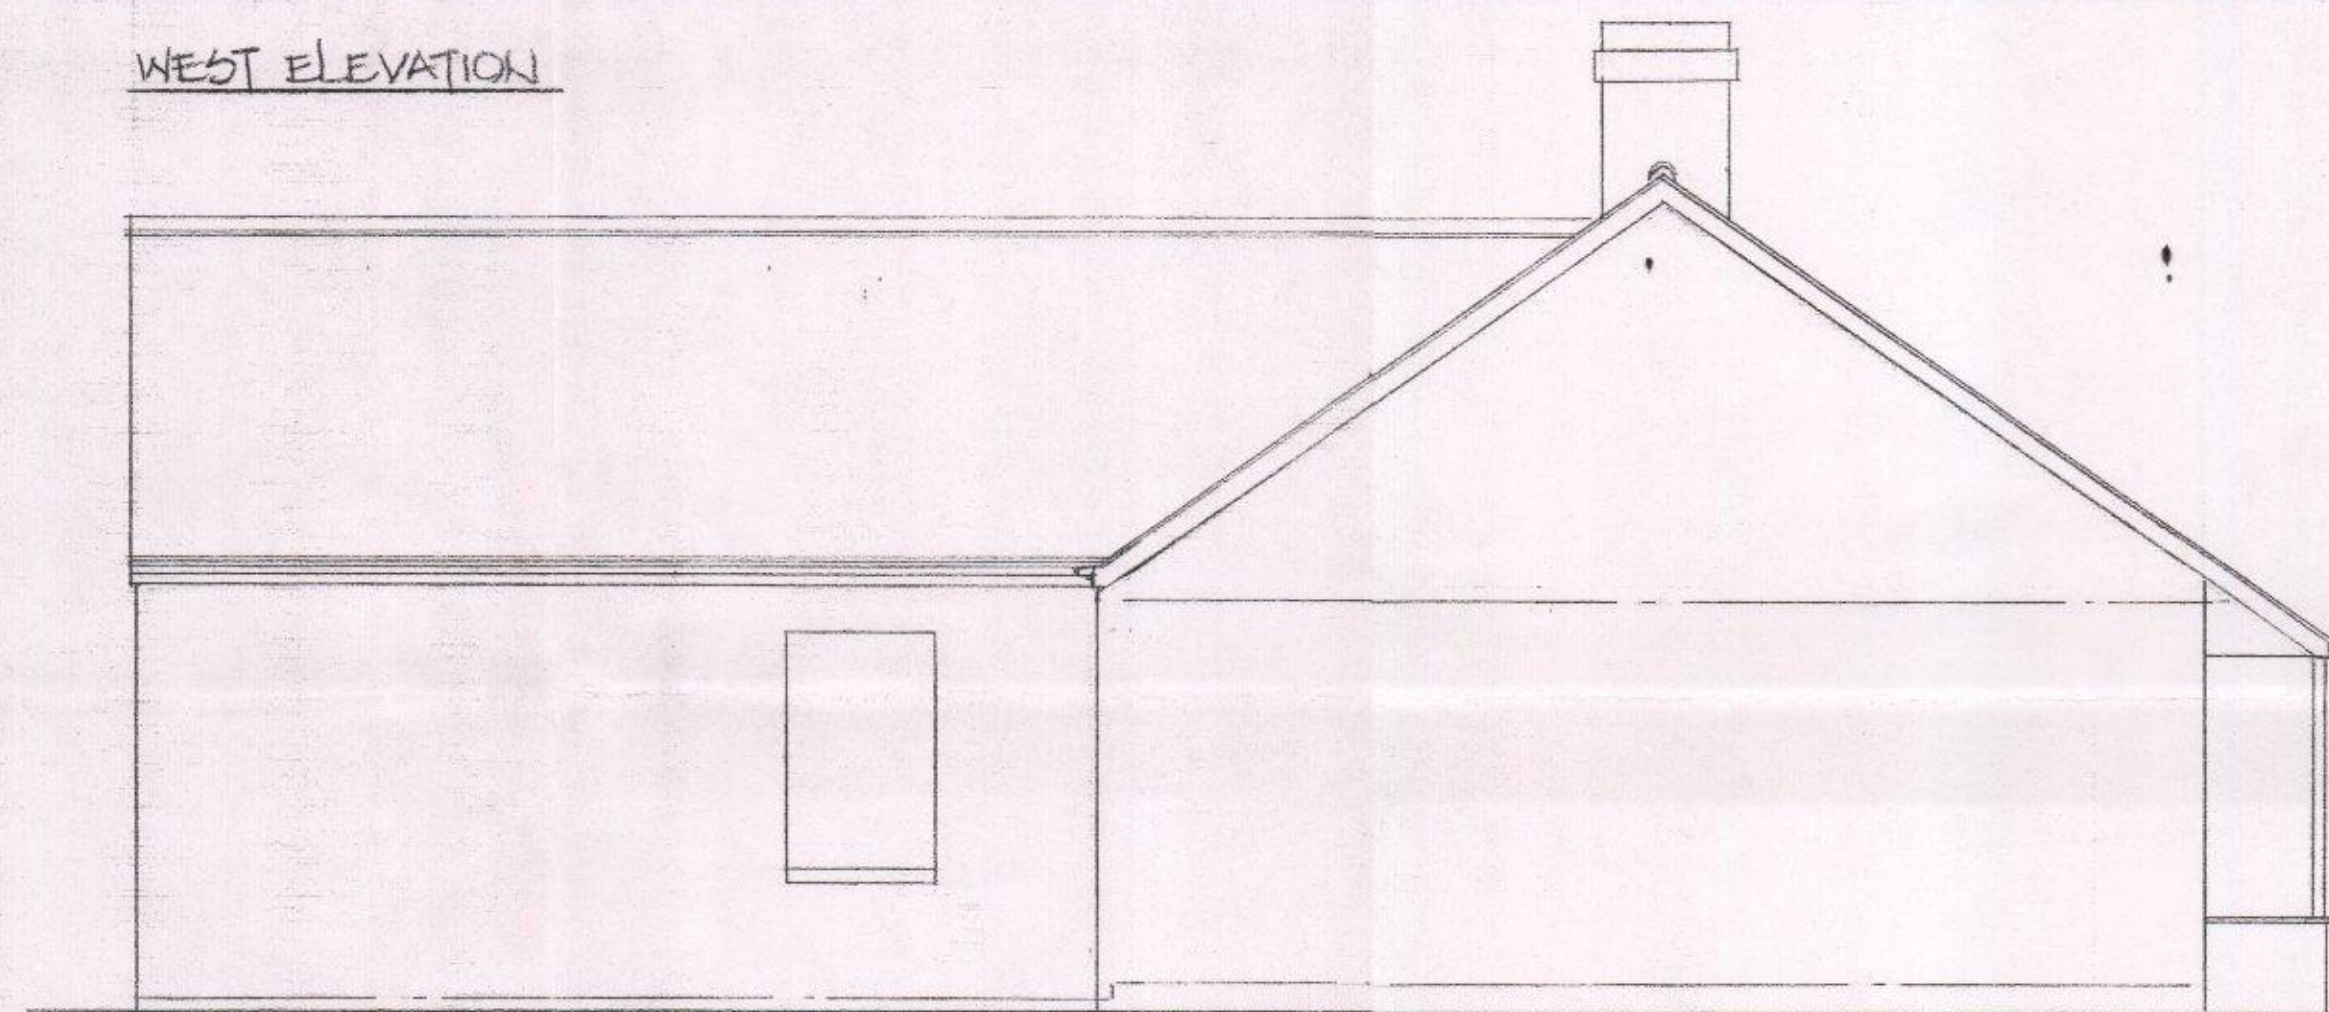

EAST ELEVATION

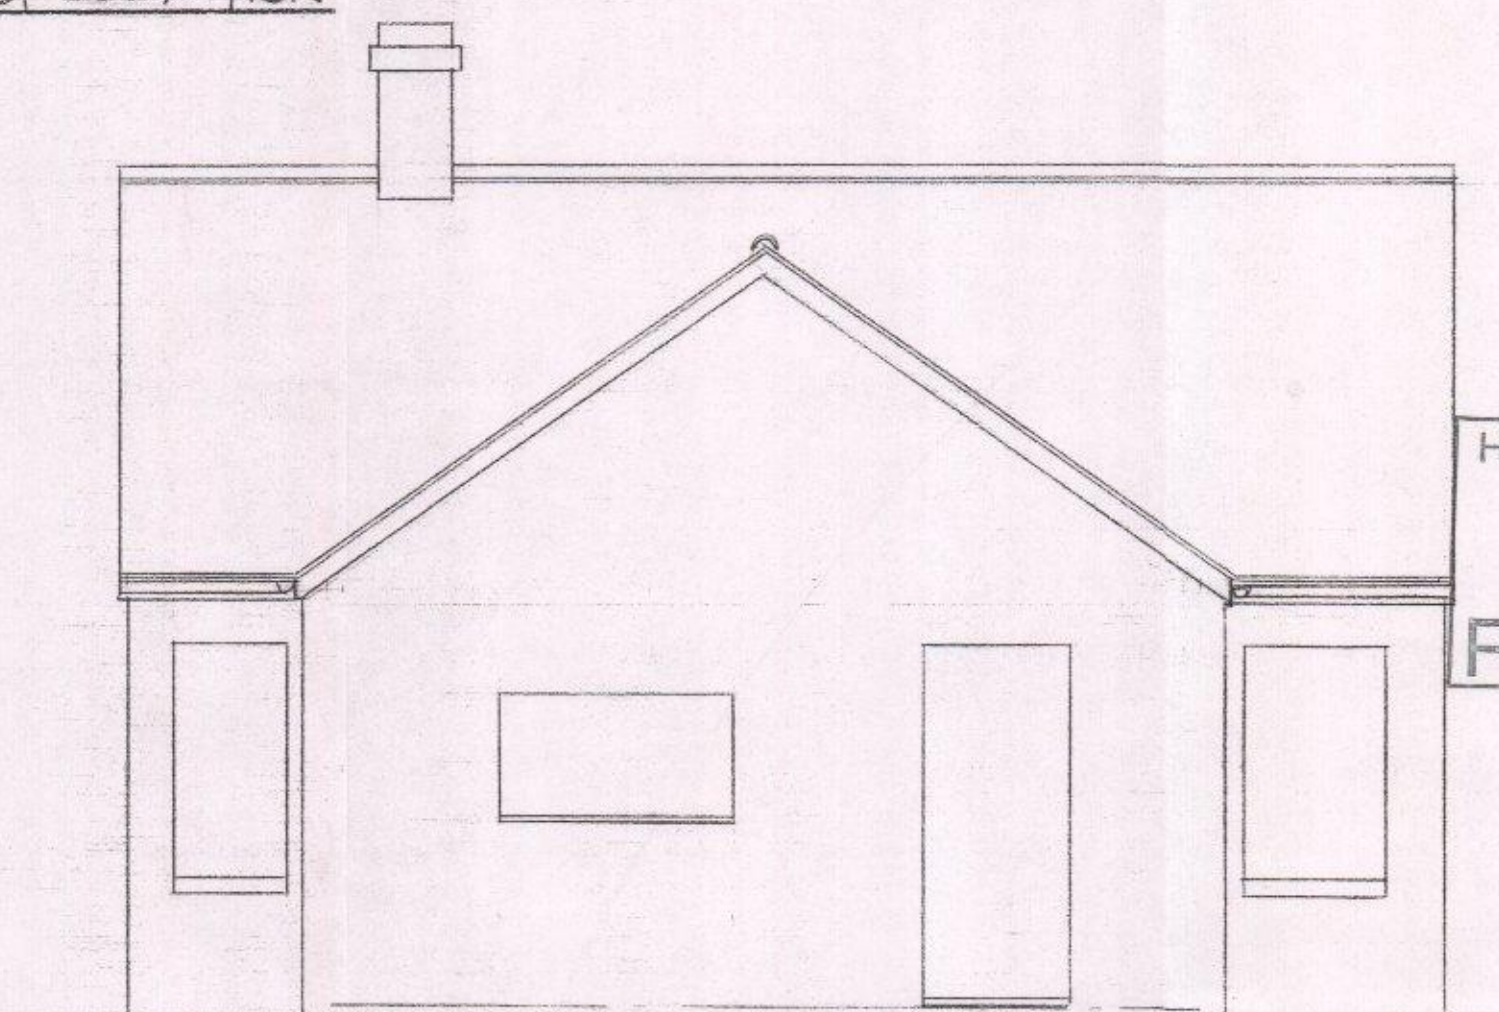

SOUTH ELEVATION

HAVANT BOROUGH
COUNCIL
21 DEC 2015
RECEIVED

MAISE RUDKIN

606 SOUTHLEIGH RD
EASTWORTH
HANTS PO10 7

AS BUILTS

David Niven Design Ltd

davidniven.design@gmail.com
07673 342 007 01243 330070
74 Westbourne Avenue,
Emsworth, Hampshire PO10 7QU



Architectural Design & Planning

1:50

AVG 15 15/10/15/1