




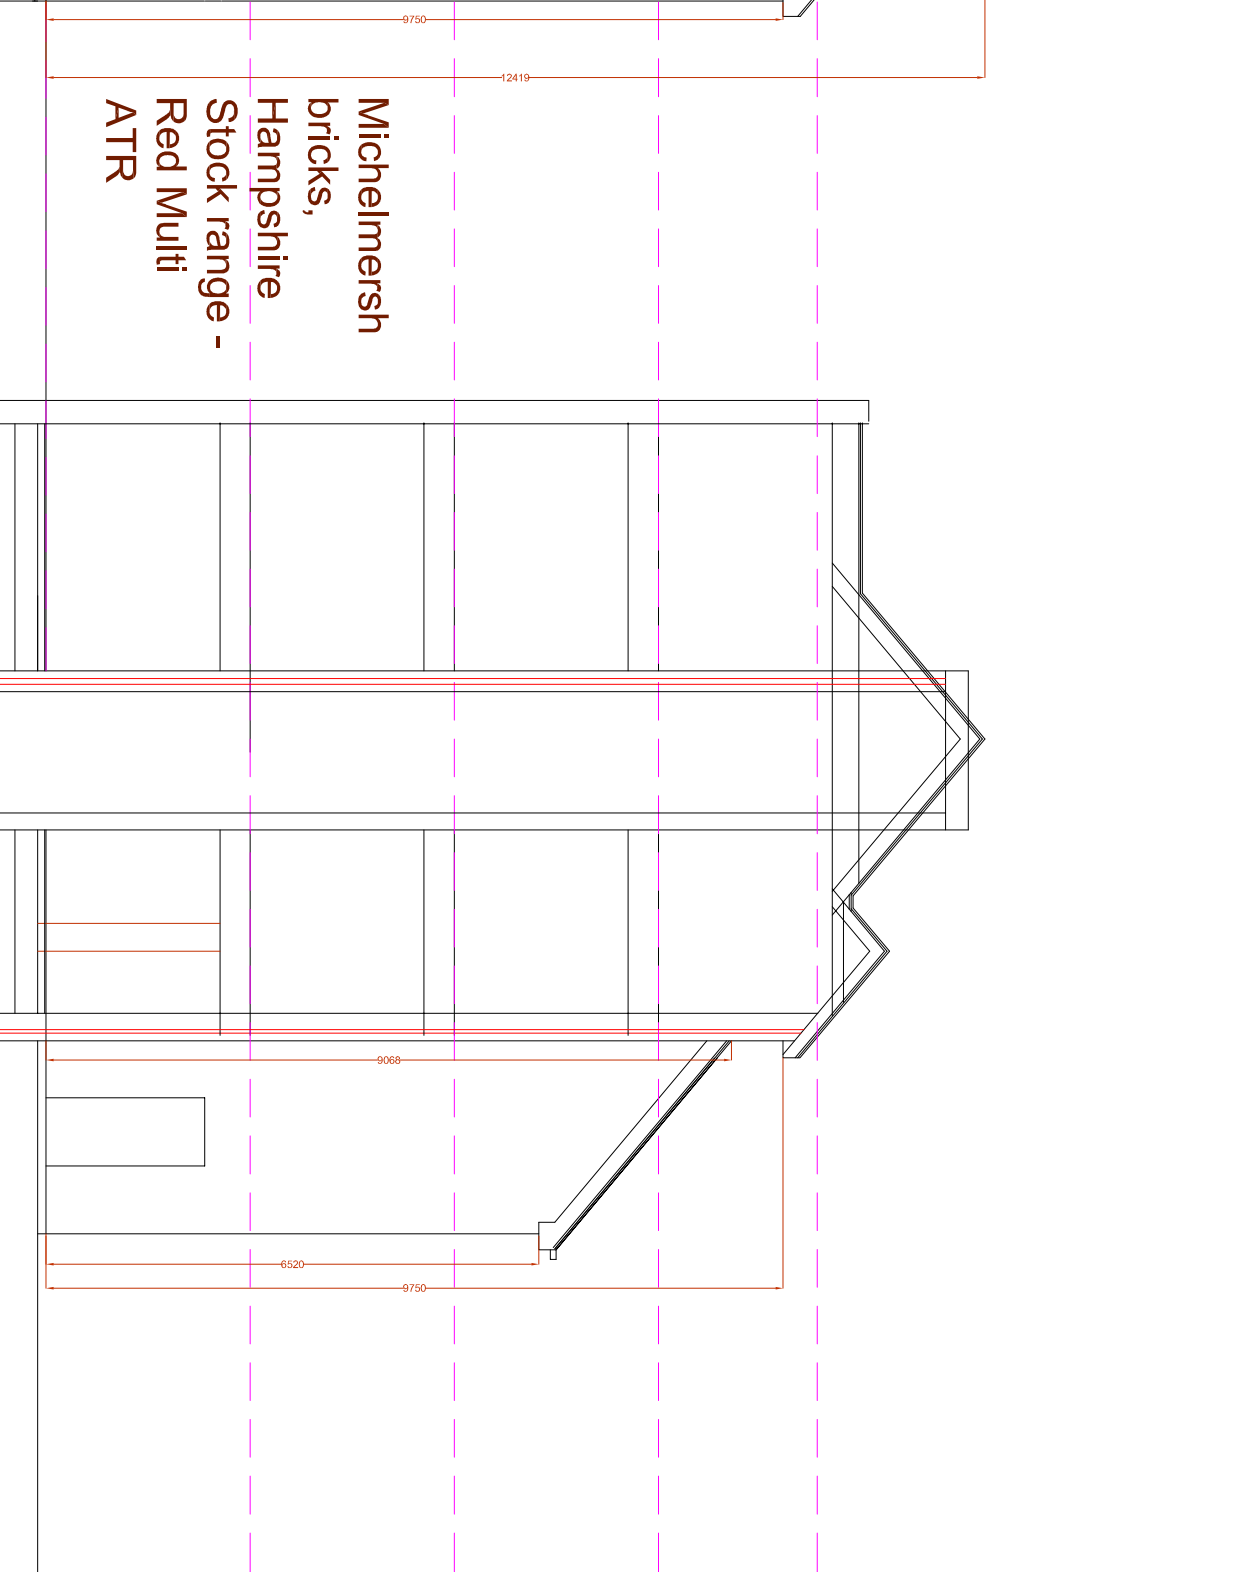

East Elevation

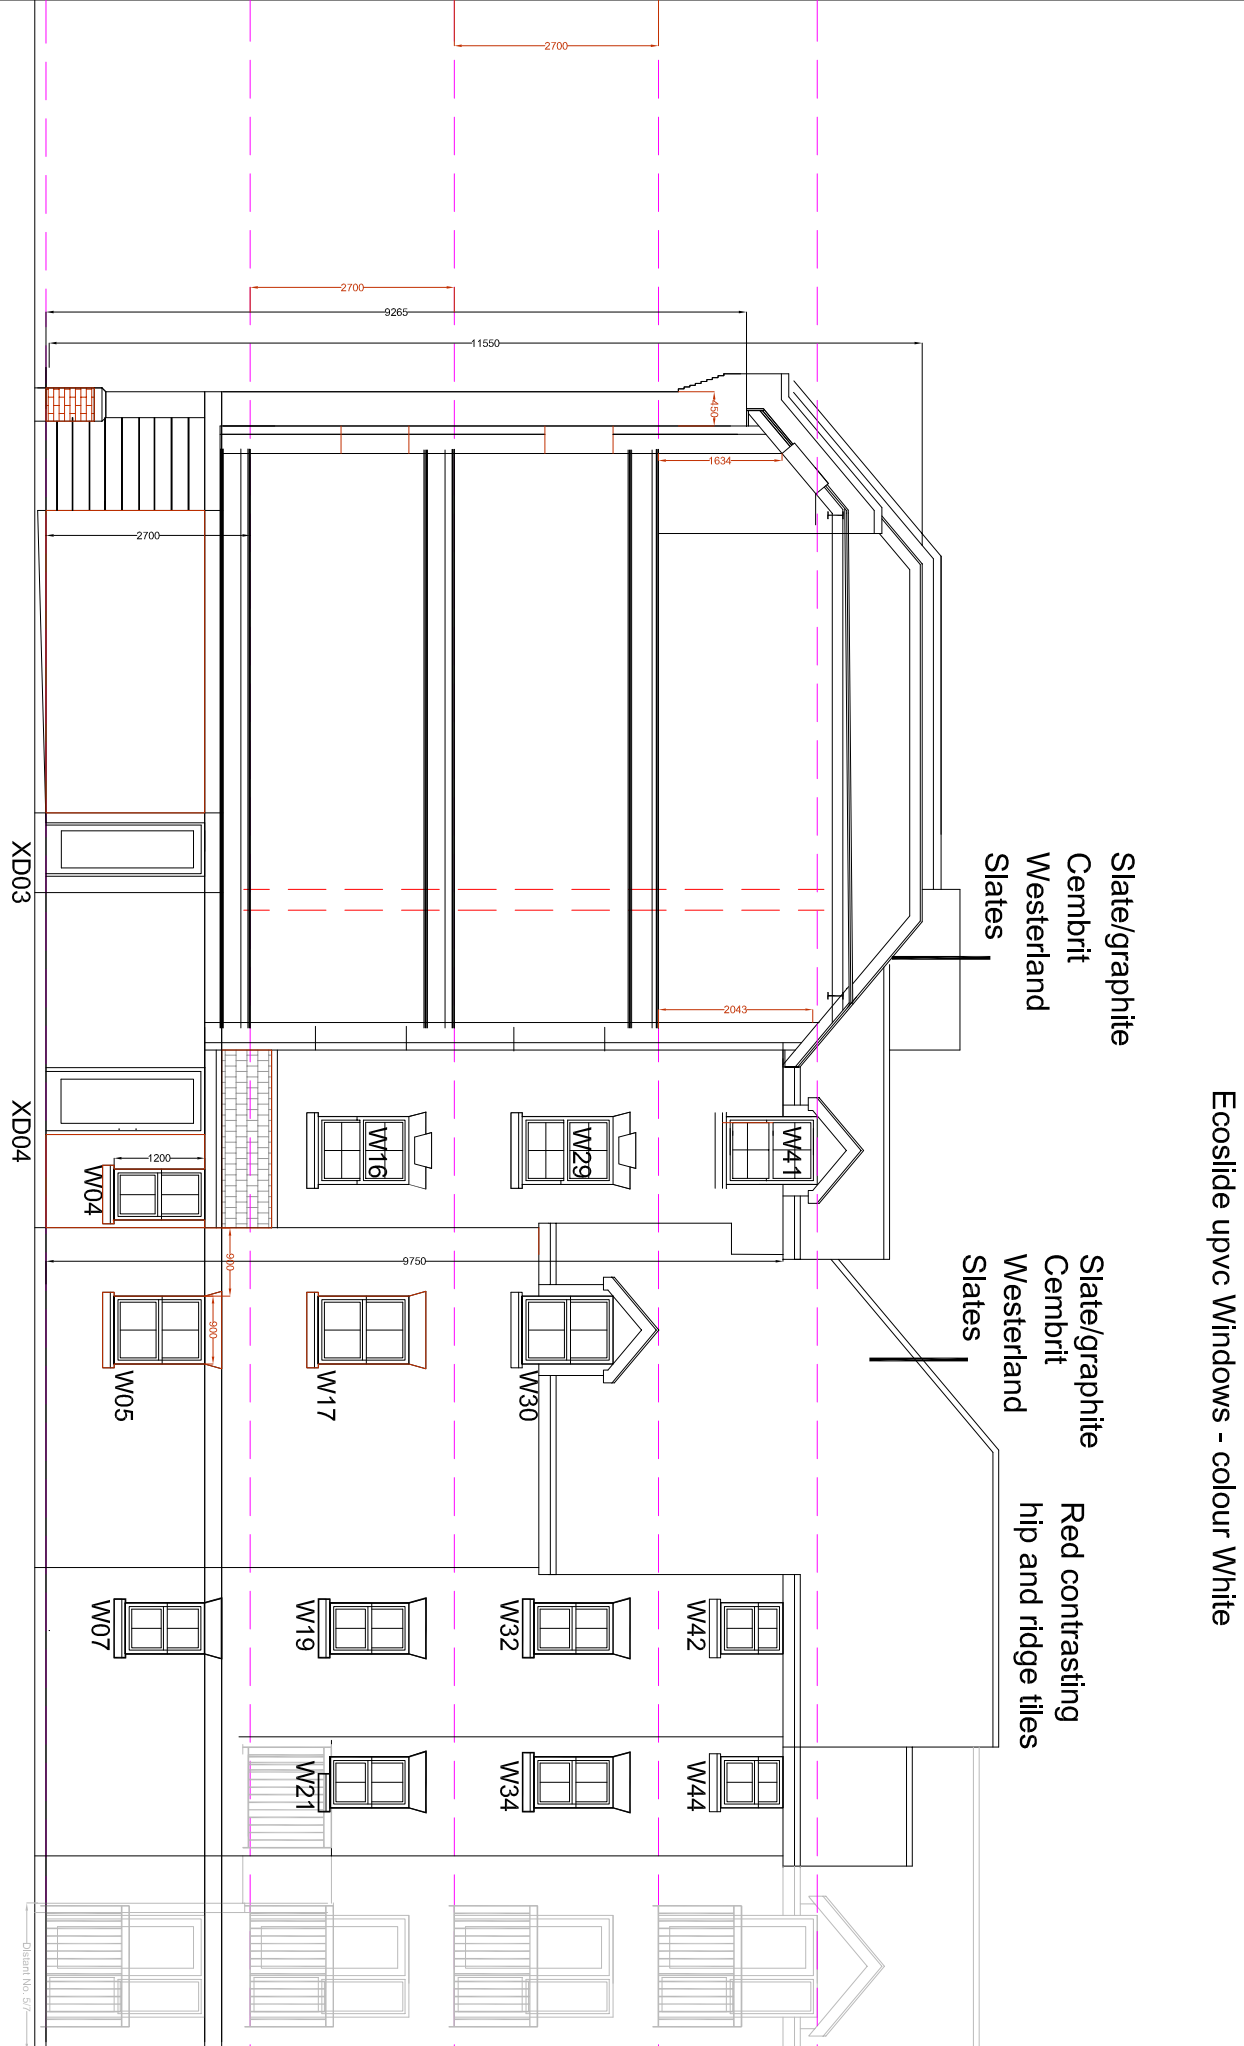

No.5&7 No. 9 South Elevations

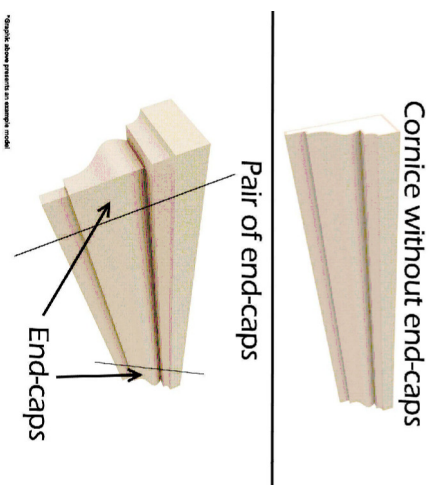

Planning Amendment (as built)

No.5&7 No. 9
South Elevations

Planning Approval

	REVISION D: No. 9 H & P 2nd FLOOR WINDOWS UPDATED - 17/10/22 - PG
	REVISION C: MATERIALS & WINDOWS CONFIRMED - 31/08/22 - PG
	REVISION B: SOUTH ELEVATION OF RENDER ADDED TO BRICKWORK - 07/06/22 - PG
	REVISION A: WINDOW SCHEDULES TO INTERIOR DOORS & ARCHWAYS COMPLETED - 12/01/22 - PG
SCALE	TITLE
1/100	5&789, East Street Apartments
DATE	DEC. 21
	DRAWN BY General Arrangement - Elevs (as built)
CHECKED BY ARCHITECTS	DRAWINGS NO. 21/100/B/R03
APPROVED BY ARCHITECTS	A B C D E F G H J K L M N O P Q R S T U V W X Y Z
ALPHACRIP	TEL 0208 462035 FAX 0208 462036 WWW.ALPHACRIP.CO.UK
PG	MOB 07959 462030