




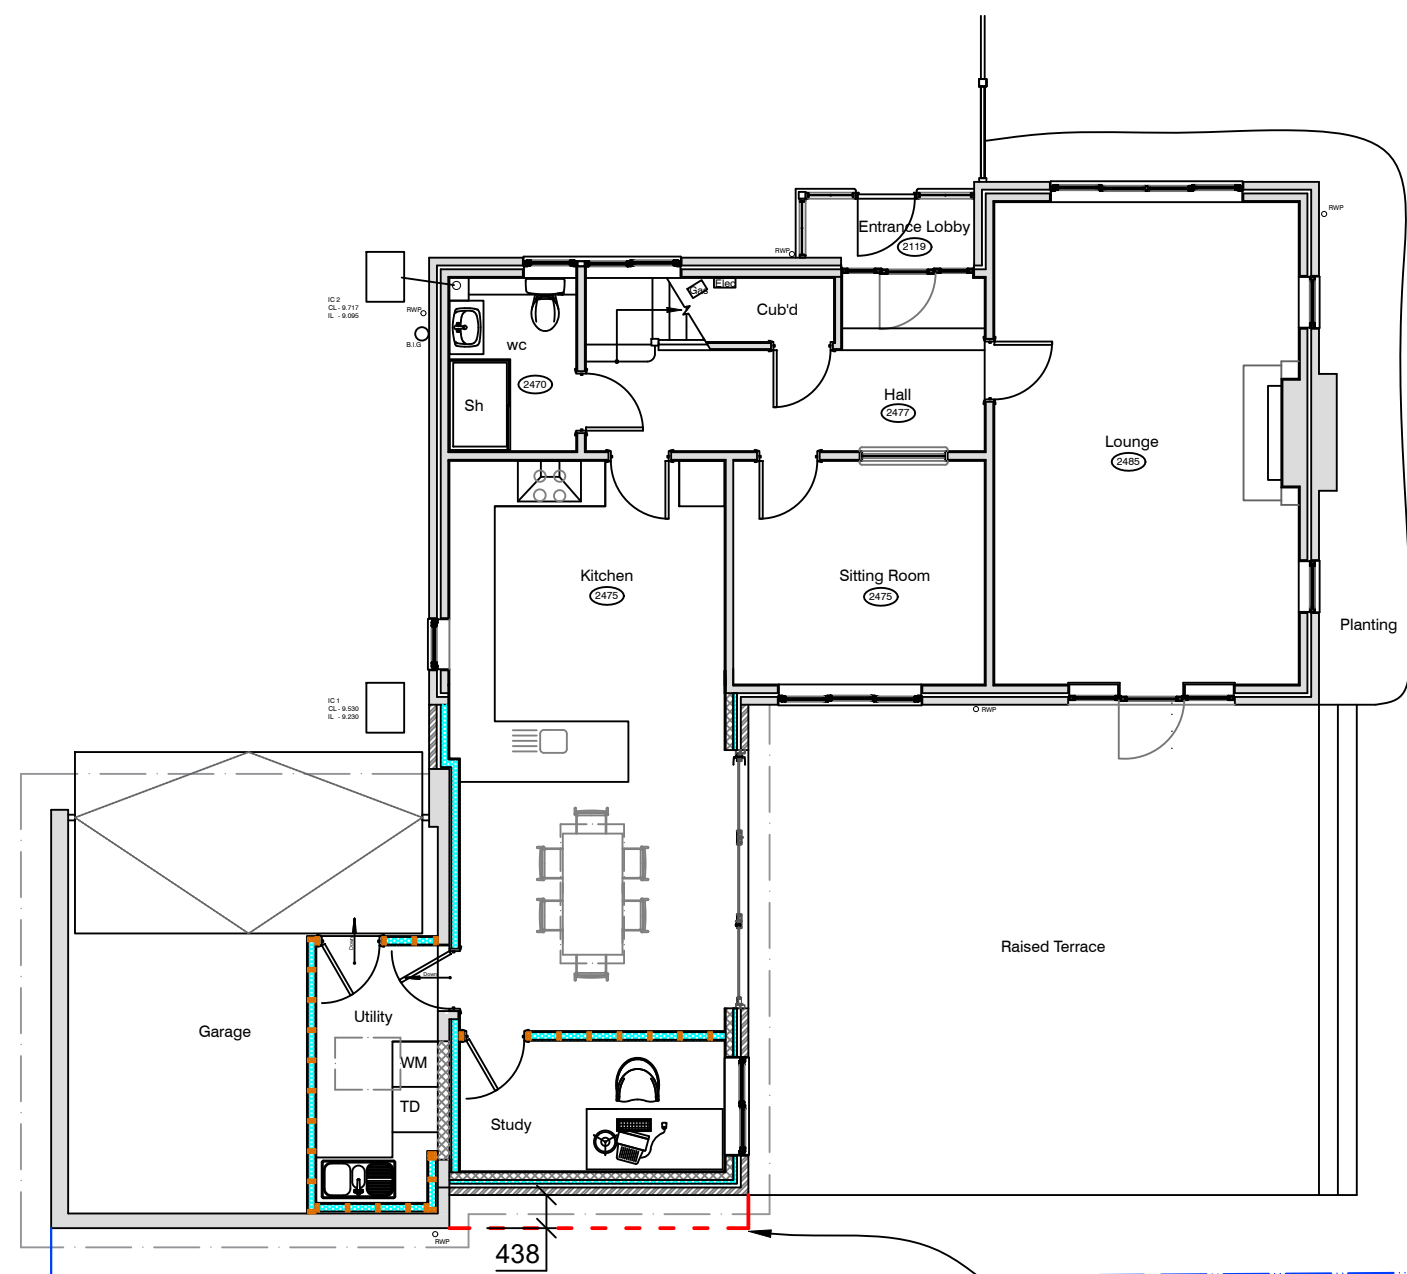


GROUND FLOOR PLAN AS APPROVED

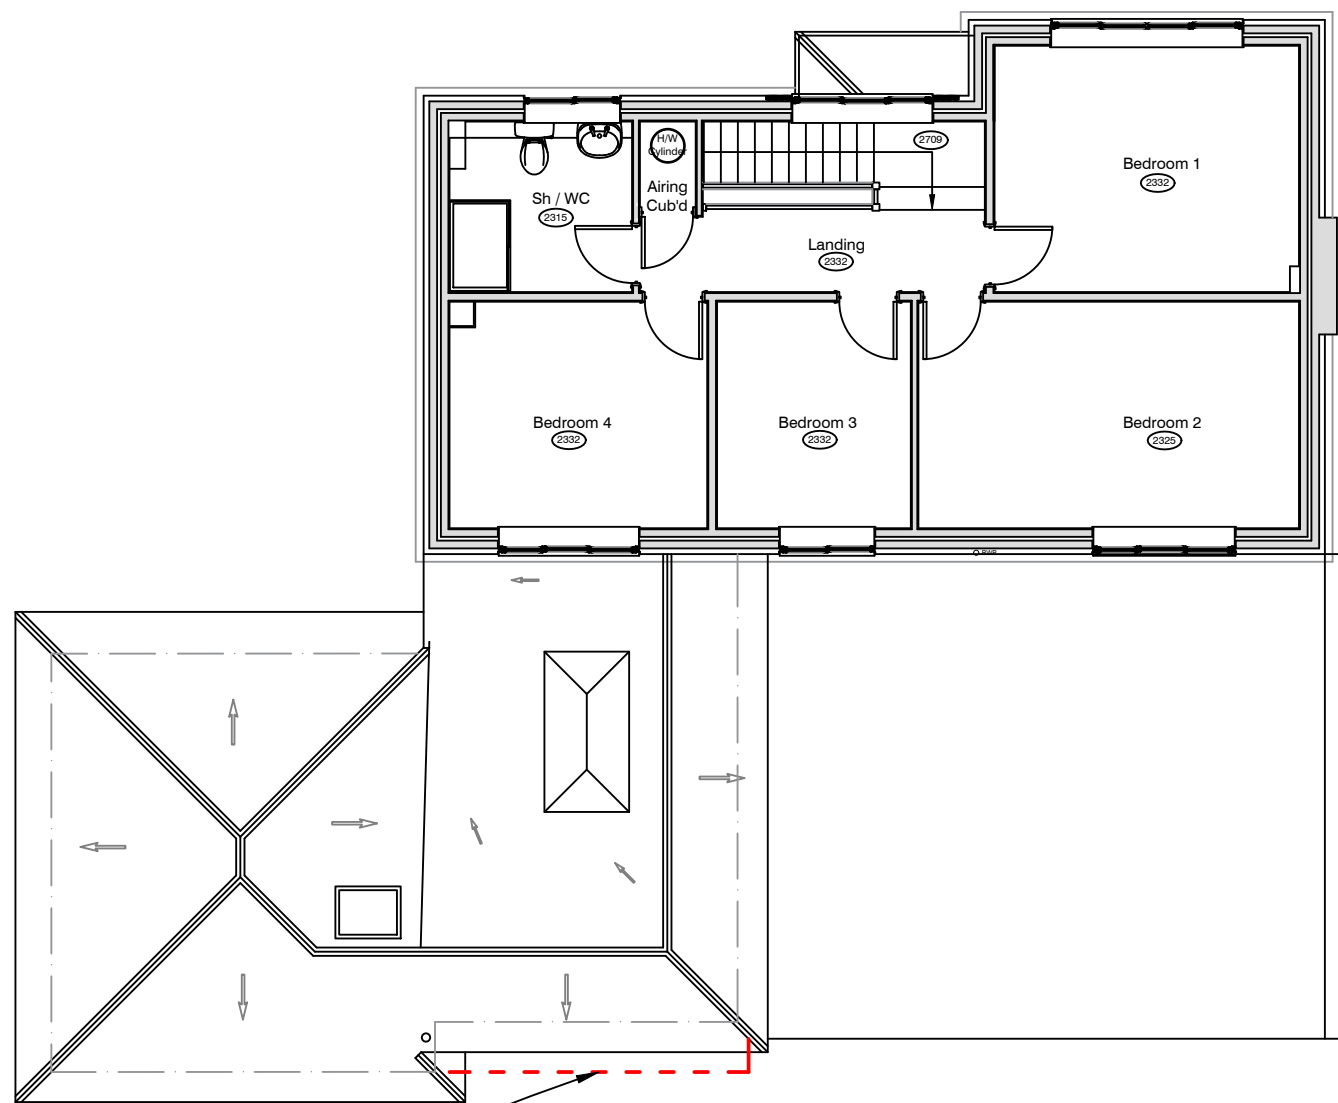


FIRST FLOOR PLAN AS APPROVED

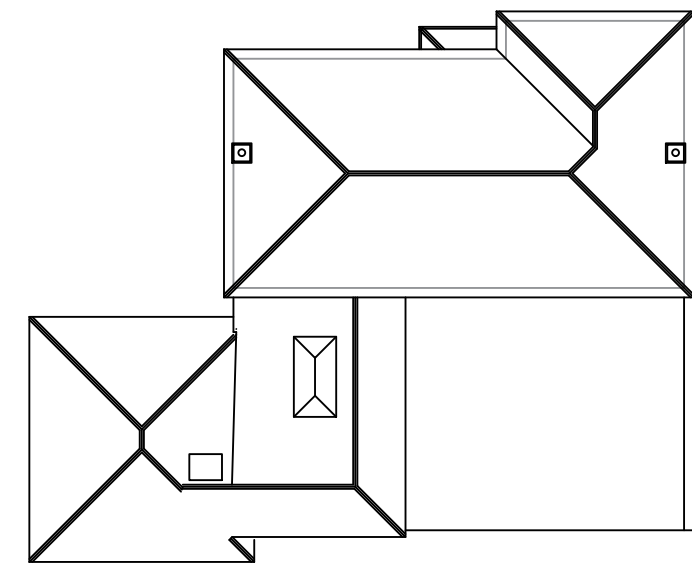


ROOF PLAN AS APPROVED

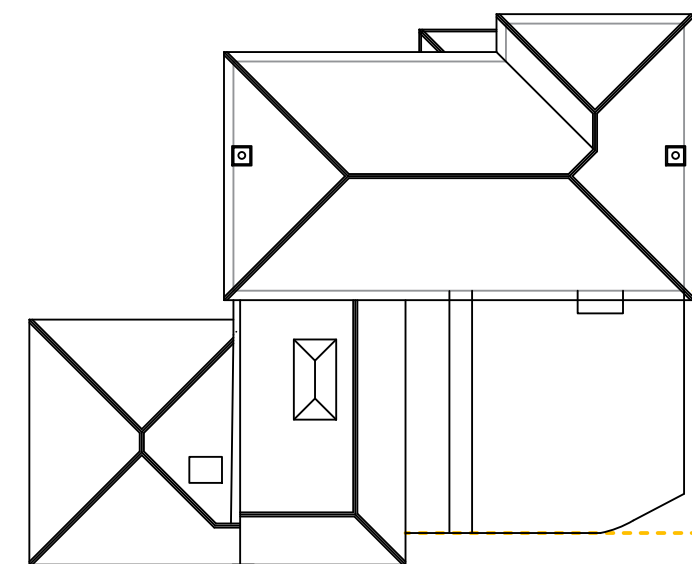

ROOF PLAN AS-BUILT

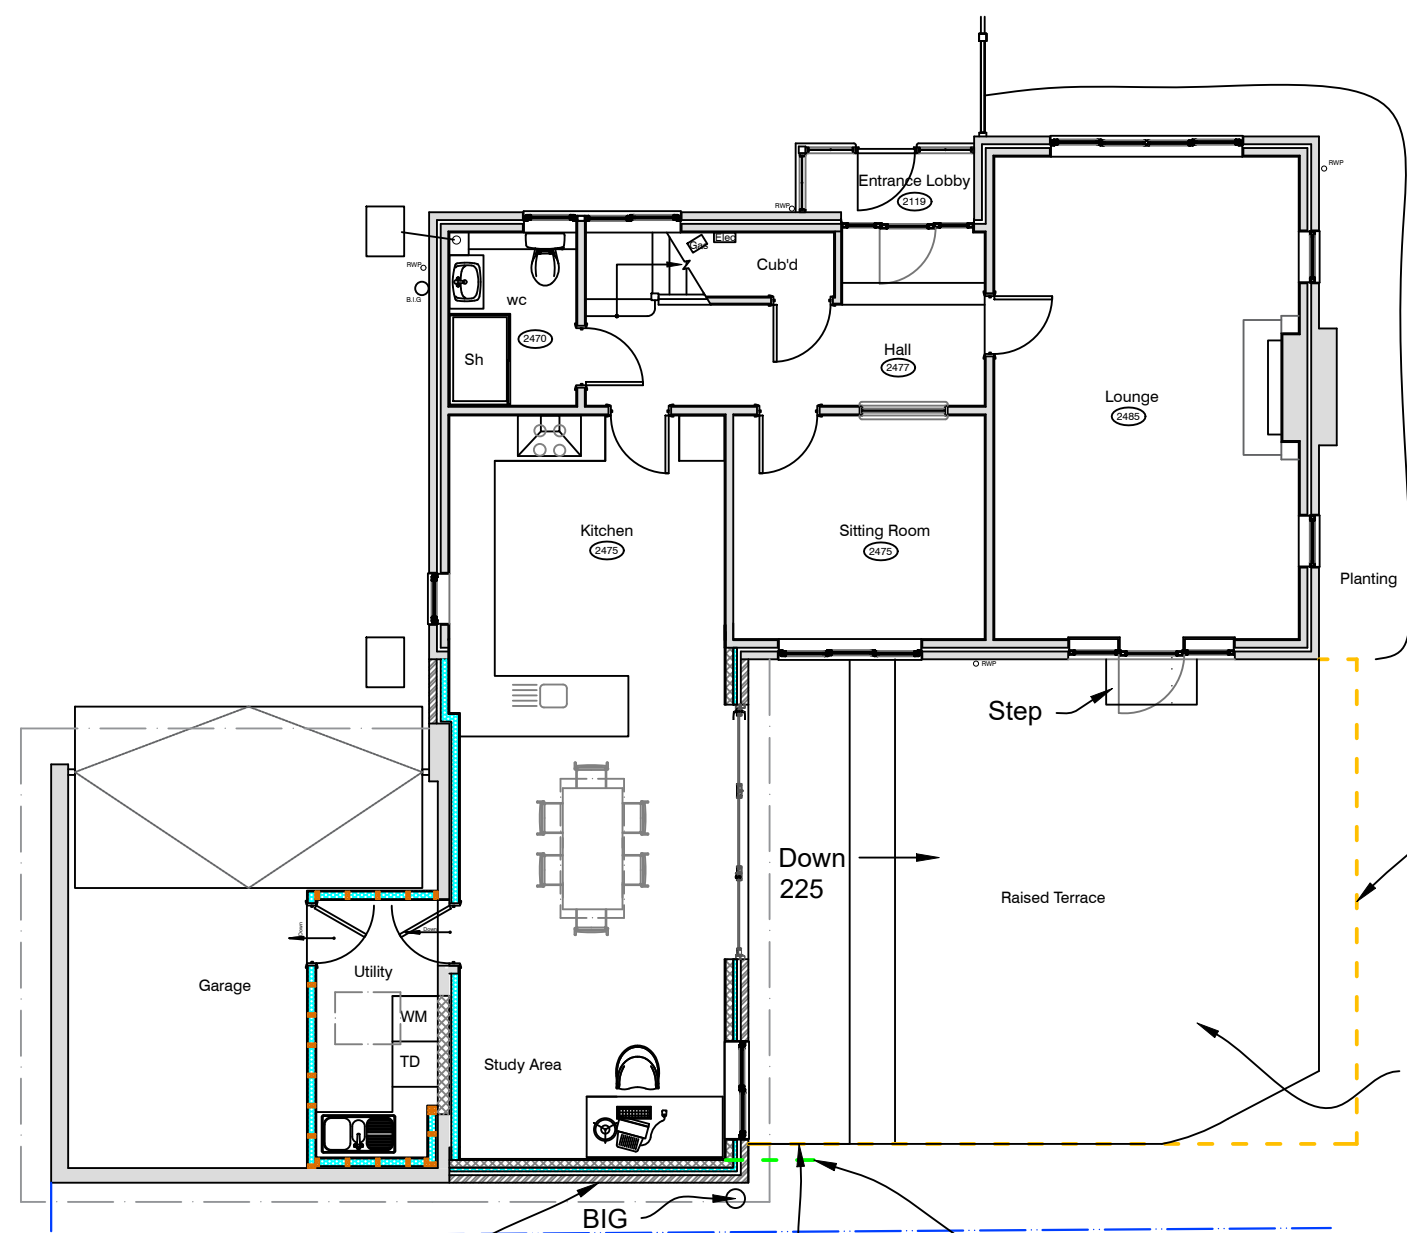

GROUND FLOOR PLAN AS-BUILT

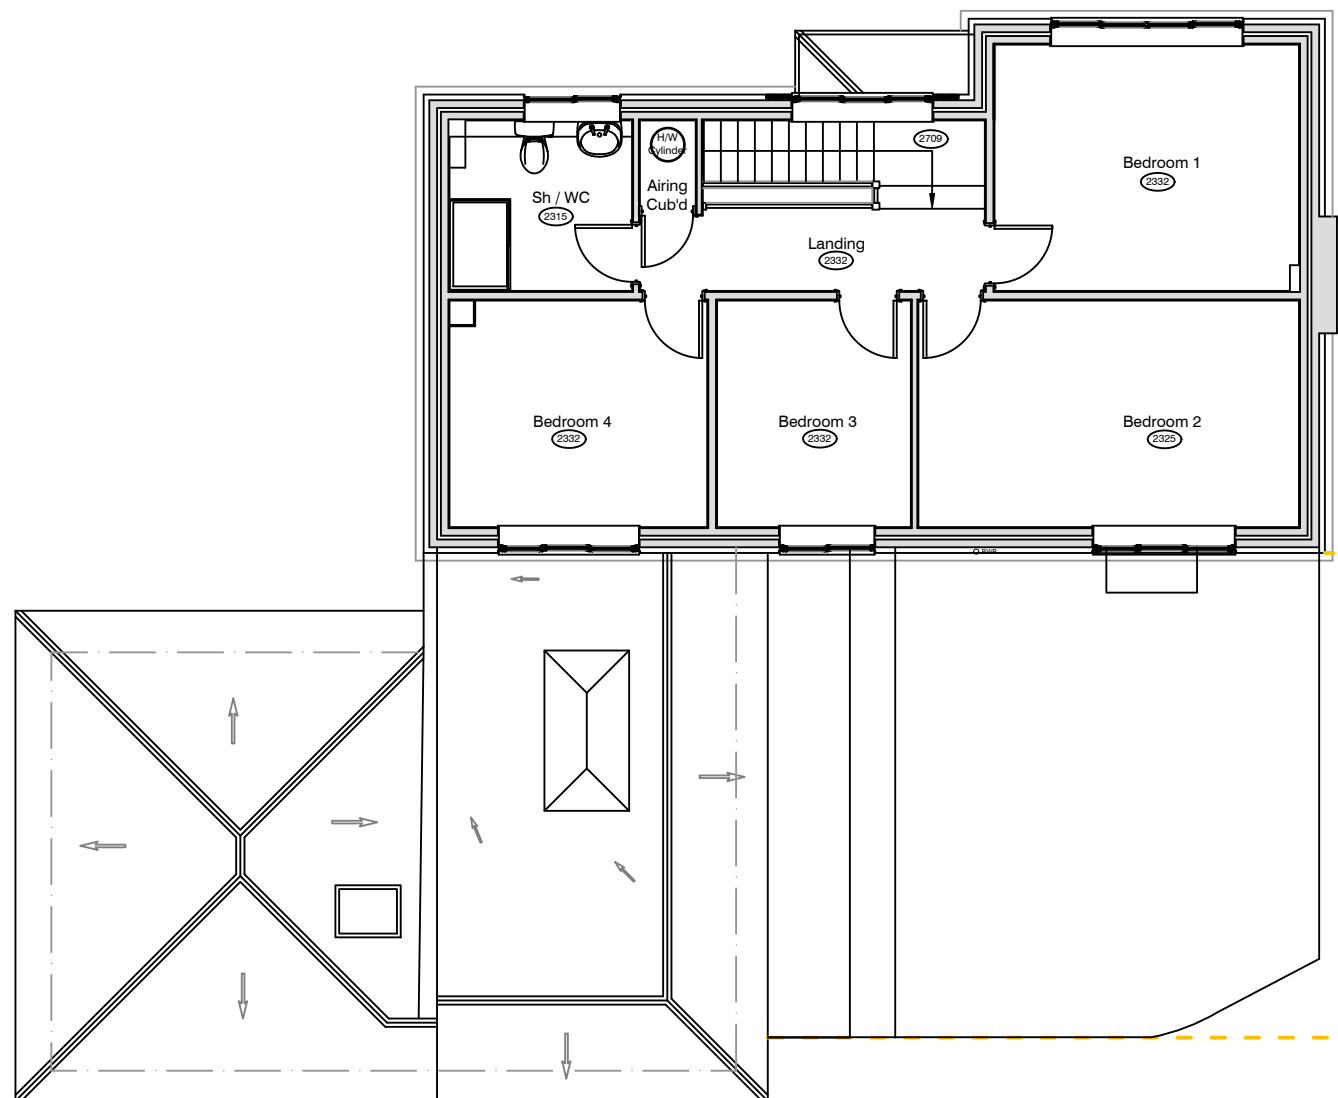

FIRST FLOOR PLAN AS-BUILT



Replacement extension follows rear line of original extension wall and line of rear wall of garage.

Reduce the extent of the terrace to the line originally approved

Down 225

Outline of full-height terrace as approved (Including steps)

Terrace as-built has main level at 225 below that approved and is of a smaller area overall

Furthest extent of windows in original structure

C: Terrace amendment
B: Terrace amendment
A: Amendments

REVISIONS

Ordinance Survey Licence number 100062725
(c) Crown copyright 2022. All rights reserved.

Notes

- These are computerised drawings for the purposes of obtaining planning & building regulations approvals & are based on certain overall measurements. They do not constitute working drawings.
- Distortion and uneven walls etc. have been ignored with some average measurements.
- Dimensions shown must not be relied upon and must be checked on site and verified prior to commencement of work.
- Where applicable this drawing is to be read in conjunction with other consultants' drawings & calculations.
- Do not scale from these drawings, except for planning purposes.
- Any Work undertaken prior to Planning and Building Regulations Approval is done so entirely at the Client/Contractors own risk.
- The client is reminded of their obligations under the Party Wall etc. Act 1997 where appropriate.

(c) 2022 - A.H.Sutcliff

SUTCLIFF CONSULTANTS Ltd
Chartered Building Engineers,
Surveyors & Architectural Consultants
11 Crossbush Road
Felpham, Bognor Regis
West Sussex, PO22 7LS
Tel: 01243 586004
Fax: 08708 793194
Mob: 07799 393250
Email: mail@sutcliffconsultants.co.uk

PROJECT DETAIL

5 Willow Close
Havant
PO9 2SX

Rear Extension and internal alterations

FOR: Pearce

DRAWING SCALE: 1:100, 1:200 @A2

Approved and as-built floor and roof plans

DATE: Feb 2024

DRAWN: A. H. Sutcliff C Build.E FCABE

DRAWING: 2136-MMA/02 REVISION: C