



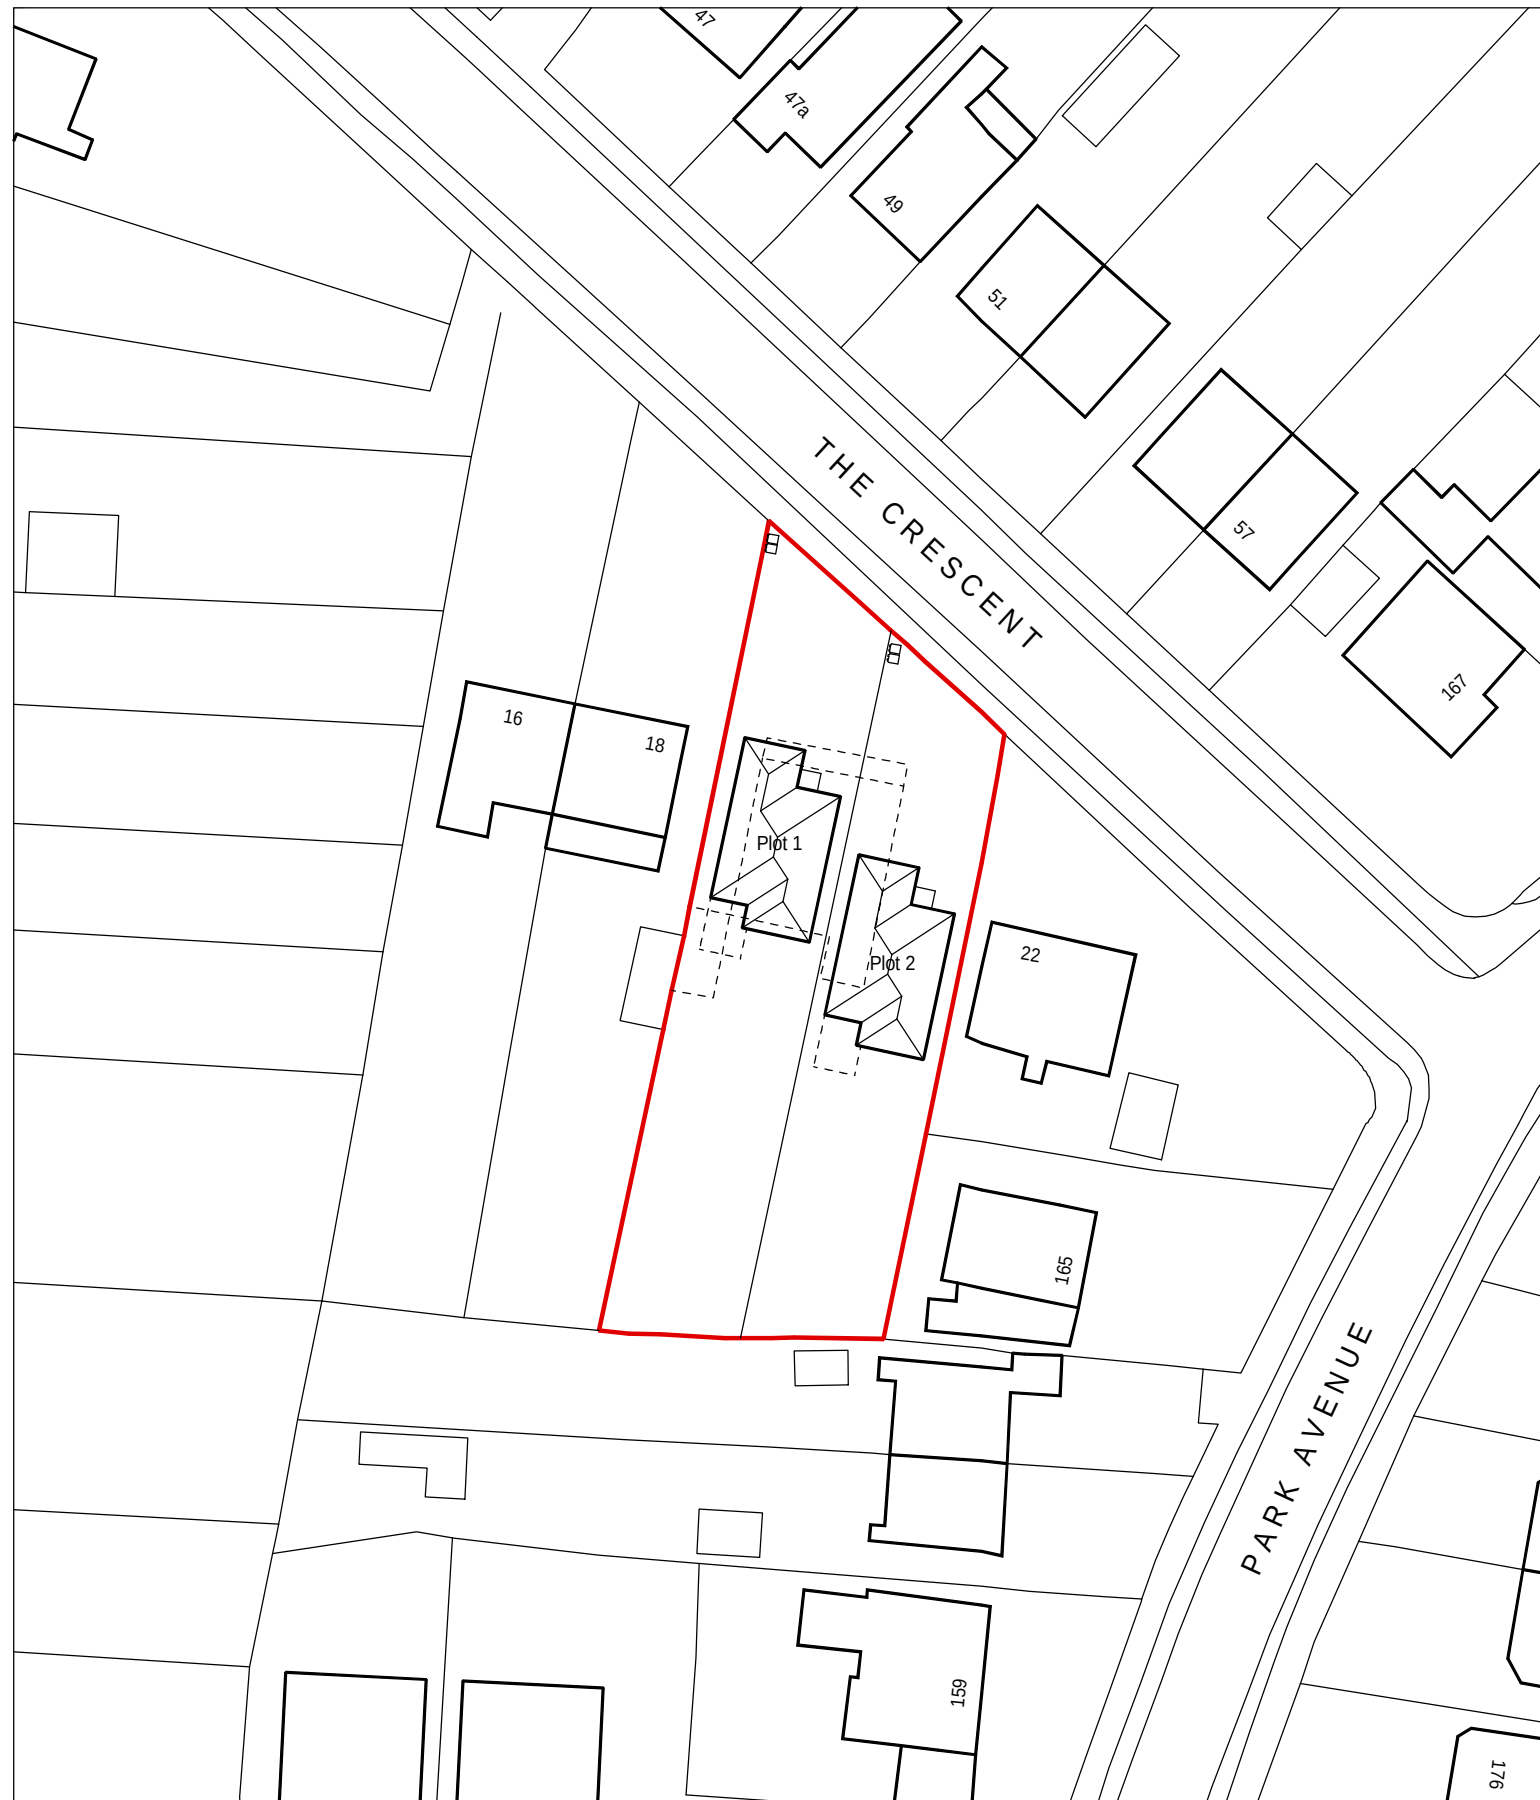


Ordnance Survey (c) Crown Copyright 2015. All rights reserved. Licence number 100020449

Proposed Block Plan 1:500

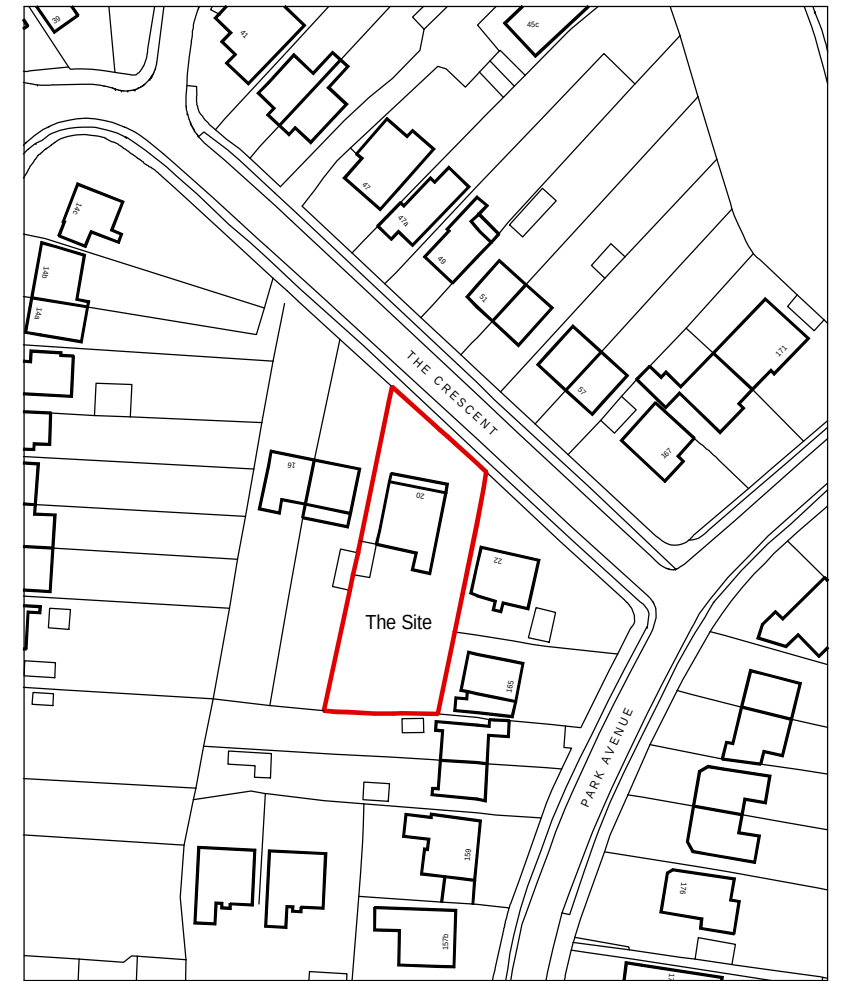

Ordnance Survey (c) Crown Copyright 2015. All rights reserved. Licence number 100020449

Existing Location Plan 1:1250

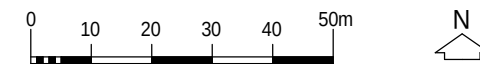

A - Updated to show as-built project.				09-07-2015	
revisions			date		
drawing no.	rev.	date	scale(s)	sheet size	
21303/01	A	JUL 2013	1:500, 1:1250	A3	
client					
MEADOWLANDS NEW HOMES LTD.					
					
■ Jeffrey Douglas Chartered Architect					
■ 60a Sinah Lane		■ Hayling Island		■ Hampshire ■ PO11 0EH ■	
■ Tel: (023) 9246 8889		■ E-mail: jdo@jeffreydouglas.co.uk		■	

This drawing is the copyright of the Architect and must not be reproduced without permission, except by the Local Planning Authority for planning purposes.

Figured dimensions to be taken in preference to scaled.
Dimensions to be checked on site before work commences.
No deviation from this drawing will be permitted without the prior written consent of the Architect.
Ground floor slabs, foundations, structure, etc., and all work below ground is shown provisionally and inspection of ground conditions is essential prior to work commencing.
Reassessment is essential when the ground conditions are apparent and redesign may be necessary in the light of soil conditions found.
The responsibility for establishing the soil and subsoil conditions rests with the Contractor.

drawing

PROPOSED BLOCK PLAN
& EXISTING LOCATION PLAN

project

2 NO. DETACHED 4 BED REPLACEMENT DWELLINGS AT 20 THE CRESCENT WATERLOOVILLE, HAMPSHIRE PO7 5EU

drawing no.	rev.	date	scale(s)	sheet size
21303/01	A	JUL 2013	1:500, 1:1250	A3

client

MEADOWLANDS NEW HOMES LTD.



 ■ Jeffrey Douglas Chartered Architect

 ■ 60a Sinah Lane ■ Hayling Island ■ Hampshire ■ PO11 0HH ■

 ■ Tel: (023) 9246 8889 ■ E-mail: jd@jeffreydouglas.co.uk ■