


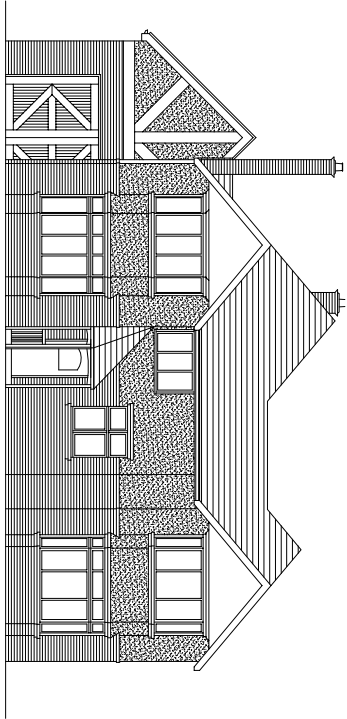


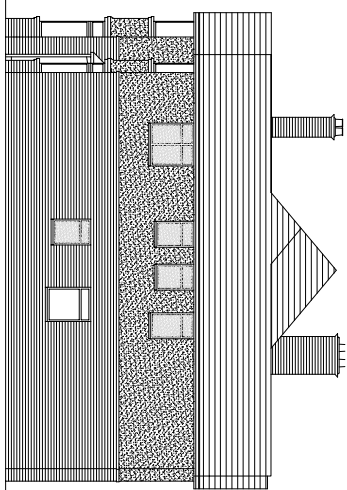


West Elevation (Front)
1:100@A1

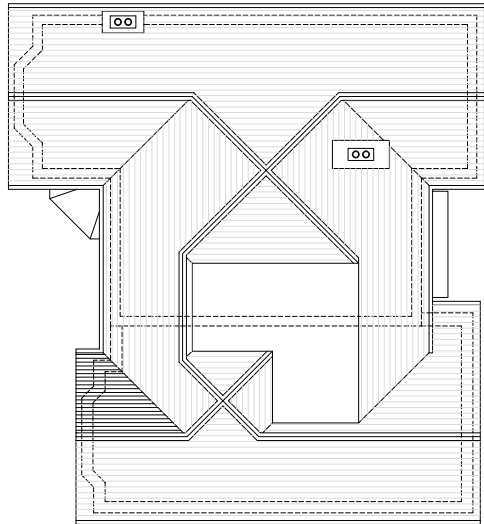


South Elevation (Side)
1:100@A1

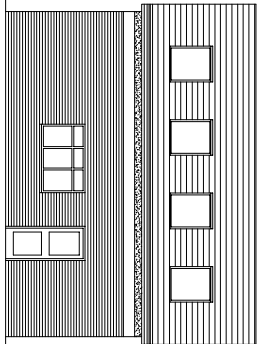


Roof Plan
1:100 @A1

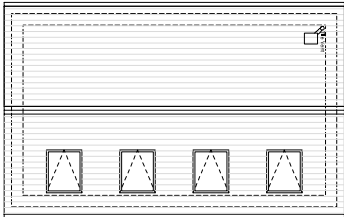


First Floor Plan
1:100@A1

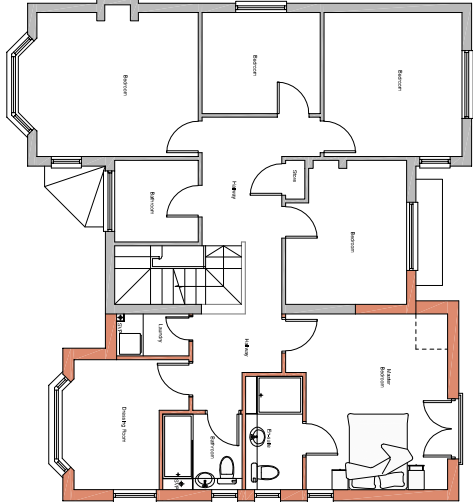


Ground Floor Plan
1:100@A1

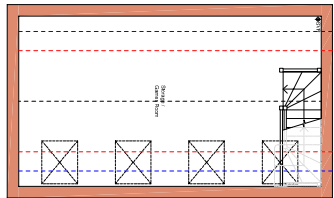


Proposed Site Layout
& Block Plan
1:200@A1

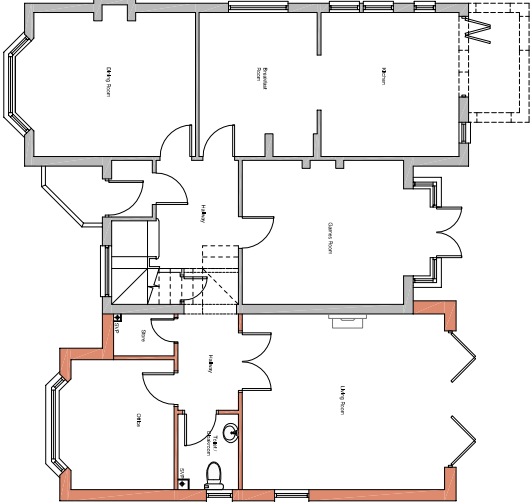


First Floor Plan
1:100@A1

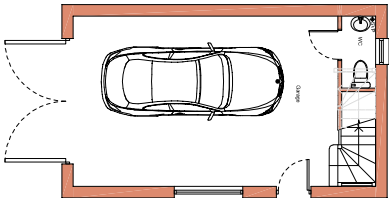



Ground Floor Plan
1:100@A1

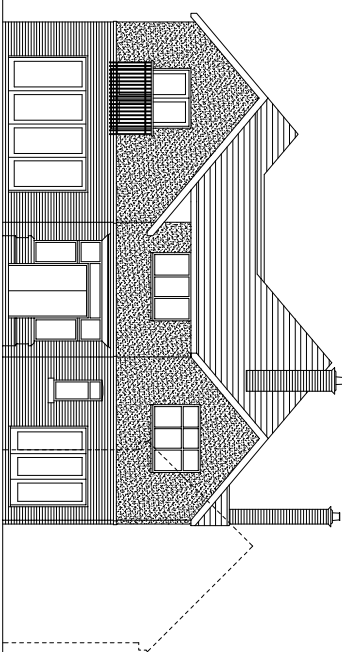


East Elevation (Rear)
1:100@A1

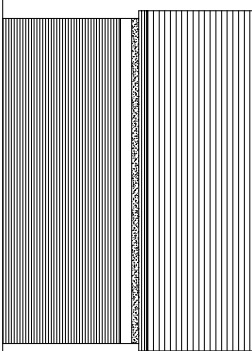


North Elevation (Side)
1:100@A1

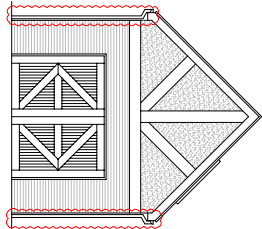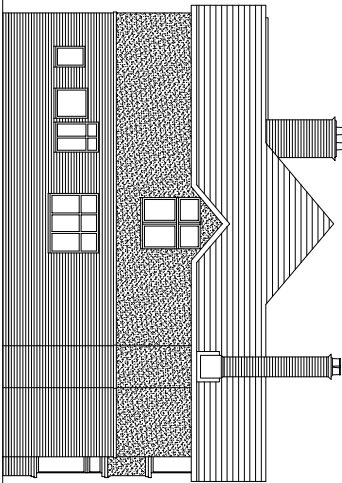


West Elevation (Front)
1:100@A1

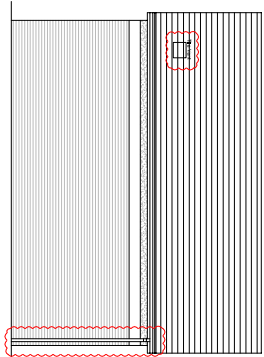

North Elevation (Side)
1:100@A1

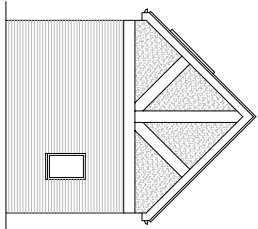

East Elevation (Rear)
1:100@A1

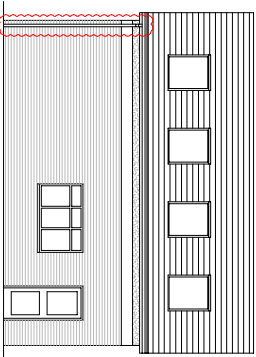

South Elevation (Side)
1:100@A1


E Coach house tile vent and RWPs shown 06.10.22

D Proposed coach house position revised to planning officer 19.07.22

C Foundation position adjusted to suit planners comments 19.04.22

B Building positions corrected, dims taken to foundations in place on site 03.04.22

A Additional elevations and dims added to planning officer 15.03.22

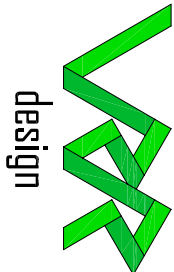

PLANNING

project	13 Langstone Road Havant PO9 1RA		
detail	As Built Plans & Elevations		
date	Nov 2018	status	Planning
a1 scale	a3 scale	job no.	1005-PD103
As indicated			E