

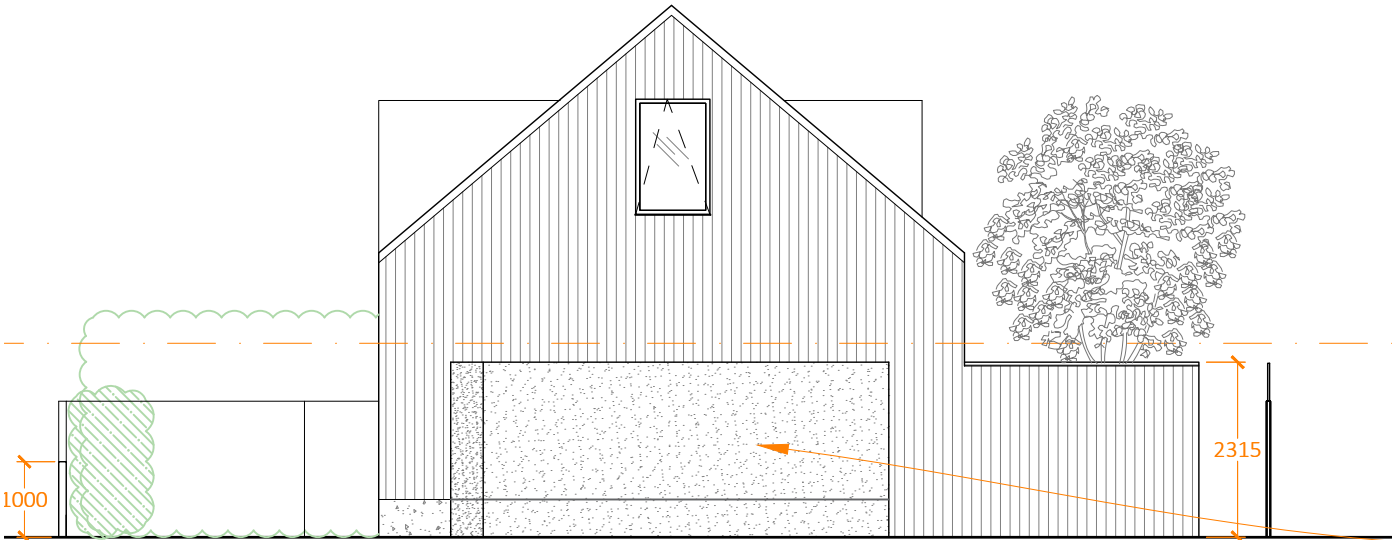
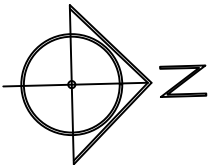
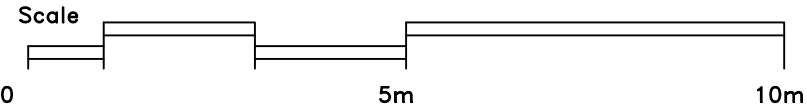


Proposed North and East Elevations

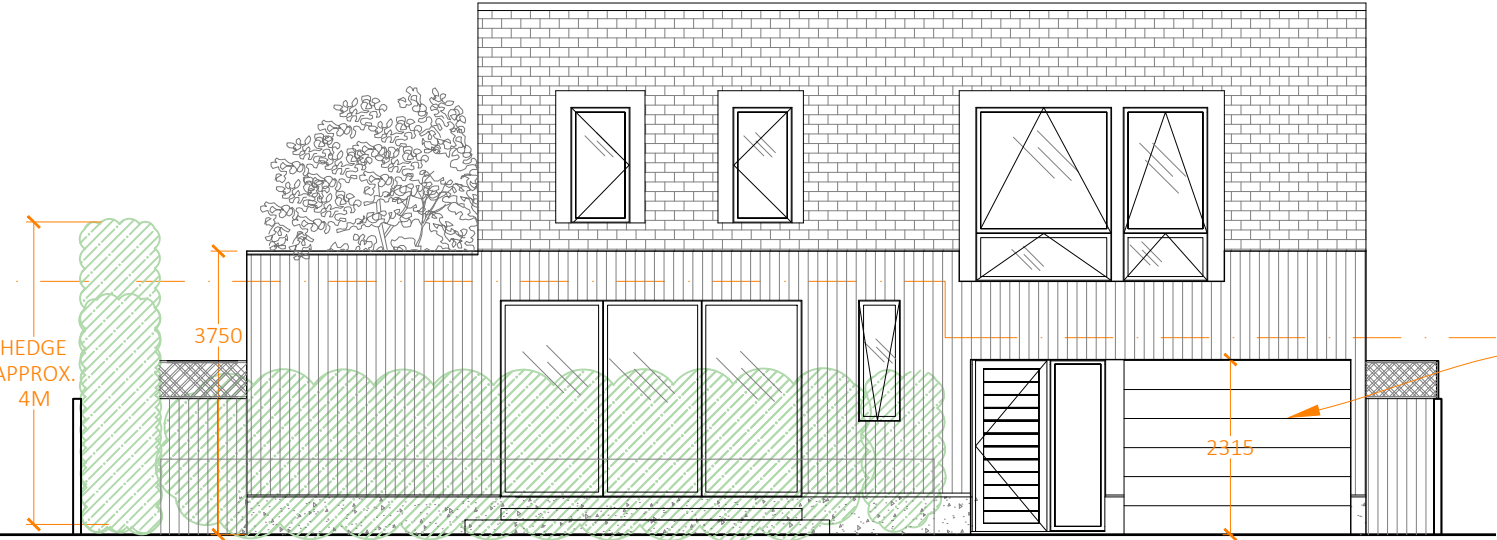

North Elevation

Anthracite render
to match existing
on new wall

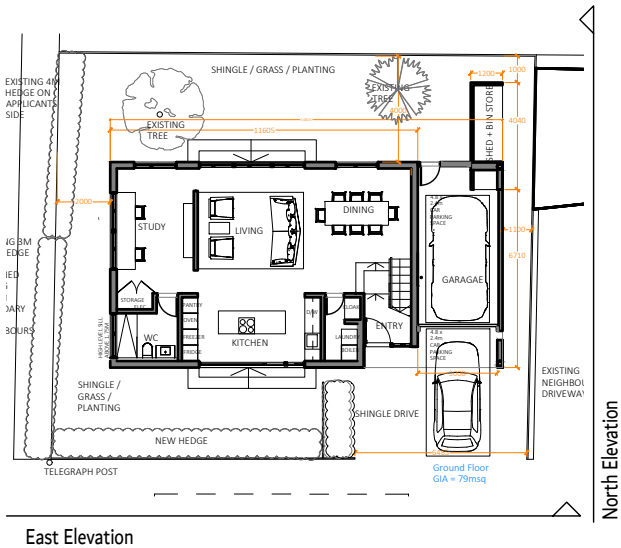

East Elevation

New up and over
garage door

REV: A 04/02/2021 Reduced height by 200mm
and bulk of rear first floor extension, original
proposal shown in dotted red line
REV: B 09/02/2021 Revised proposal added
REV: C 31/03/2022 Additional application

PLANNING

RS
ARCHITECTURE

CLIENT:

PROJECT:
3 Nutbourne

TITLE:
Proposed North + East Elevations

DRAWING NUMBER : 007.C

Scale : 1:100 @ A3

DATE: 31/03/2022
DRAWN BY: AS APPROVED BY: RS

194 Southwood Road, Hayling Island,
Hampshire, PO11 9QL
07887933281
rob@rs-architecture.co.uk
www.rs-architecture.co.uk