

Front

6940mm

6572mm

104 BARNCROFT WAY
HAVANT
PO9 3AH
EXISTING HOUSE FOOTPRINT

3700mm

PROPOSED EXTENSION
FOOTPRINT

6840mm

Rear

SUPERSEDED


REFER TO THE NEXT PAGE

Drawing title: 104 Barncroft way
Havant PO9 3AH
- **Block Diagram**

Drawing set: Ground Floor Extension

Drawn: Jacek Kochmanski
Date: 31.07.2020 **Scale:** 1:50

Drawing format: A3 **Drawing No:** 1 of 9

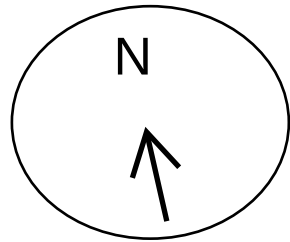

Front

6940mm

6572mm

104 BARNCROFT WAY
HAVANT
PO9 3AH
EXISTING HOUSE FOOTPRINT

3700mm

Rear

6680mm

EXTENSION
FOOTPRINT - AS BUILT

Drawing title: 104 Barncroft way
Havant PO9 3AH
- Block Diagram

Drawing set: Ground Floor Extension

Drawn: Jacek Kochmanski
Date: **14.03.2022** Scale: 1:50

Drawing format: A3 Drawing No: 1 of **9**



Existing Front Elevation
View looking North - East

Drawing title: 104 Barncroft way
Havant PO9 3AH
- **Front Elevation**

Drawing set: Ground Floor Extension

Drawn: Jacek Kochmanski

Date: 24.05.2022

Scale: 1:50

Drawing format: A3

Drawing No: 2 of 9




Existing Back Elevation
View looking North - East

Drawing title: 104 Barncroft way
Havant PO9 3AH
- Existing Back Elevation

Drawing set: Ground Floor Extension

Drawn: Jacek Kochmanski
Date: 31.07.2020 **Scale:** 1:50

Drawing format: A3 **Drawing No:** 3 of 9

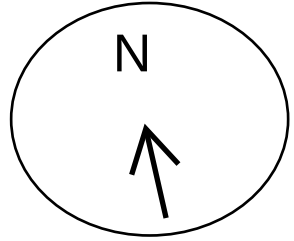

SUPERSEDED

REFER TO THE NEXT PAGE


Proposed Back Elevation
View looking North - East

Drawing title: 104 Barncroft way
Havant PO9 3AH
- **Proposed Back Elevation**

Drawing set: Ground Floor Extension

Drawn: Jacek Kochmanski
Date: 31.07.2020 **Scale:** 1:50

Drawing format: A3 **Drawing No:** 4 of 9

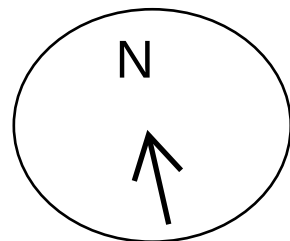


Back Elevation - **As Built**
View looking North - East

Drawing title: 104 Barncroft way
Havant PO9 3AH
-Back Elevation - **As Built**

Drawing set: Ground Floor Extension

Drawn: Jacek Kochmanski
Date: **24.05.2022** Scale: 1:50

Drawing format: A3 Drawing No: 4 of **9**

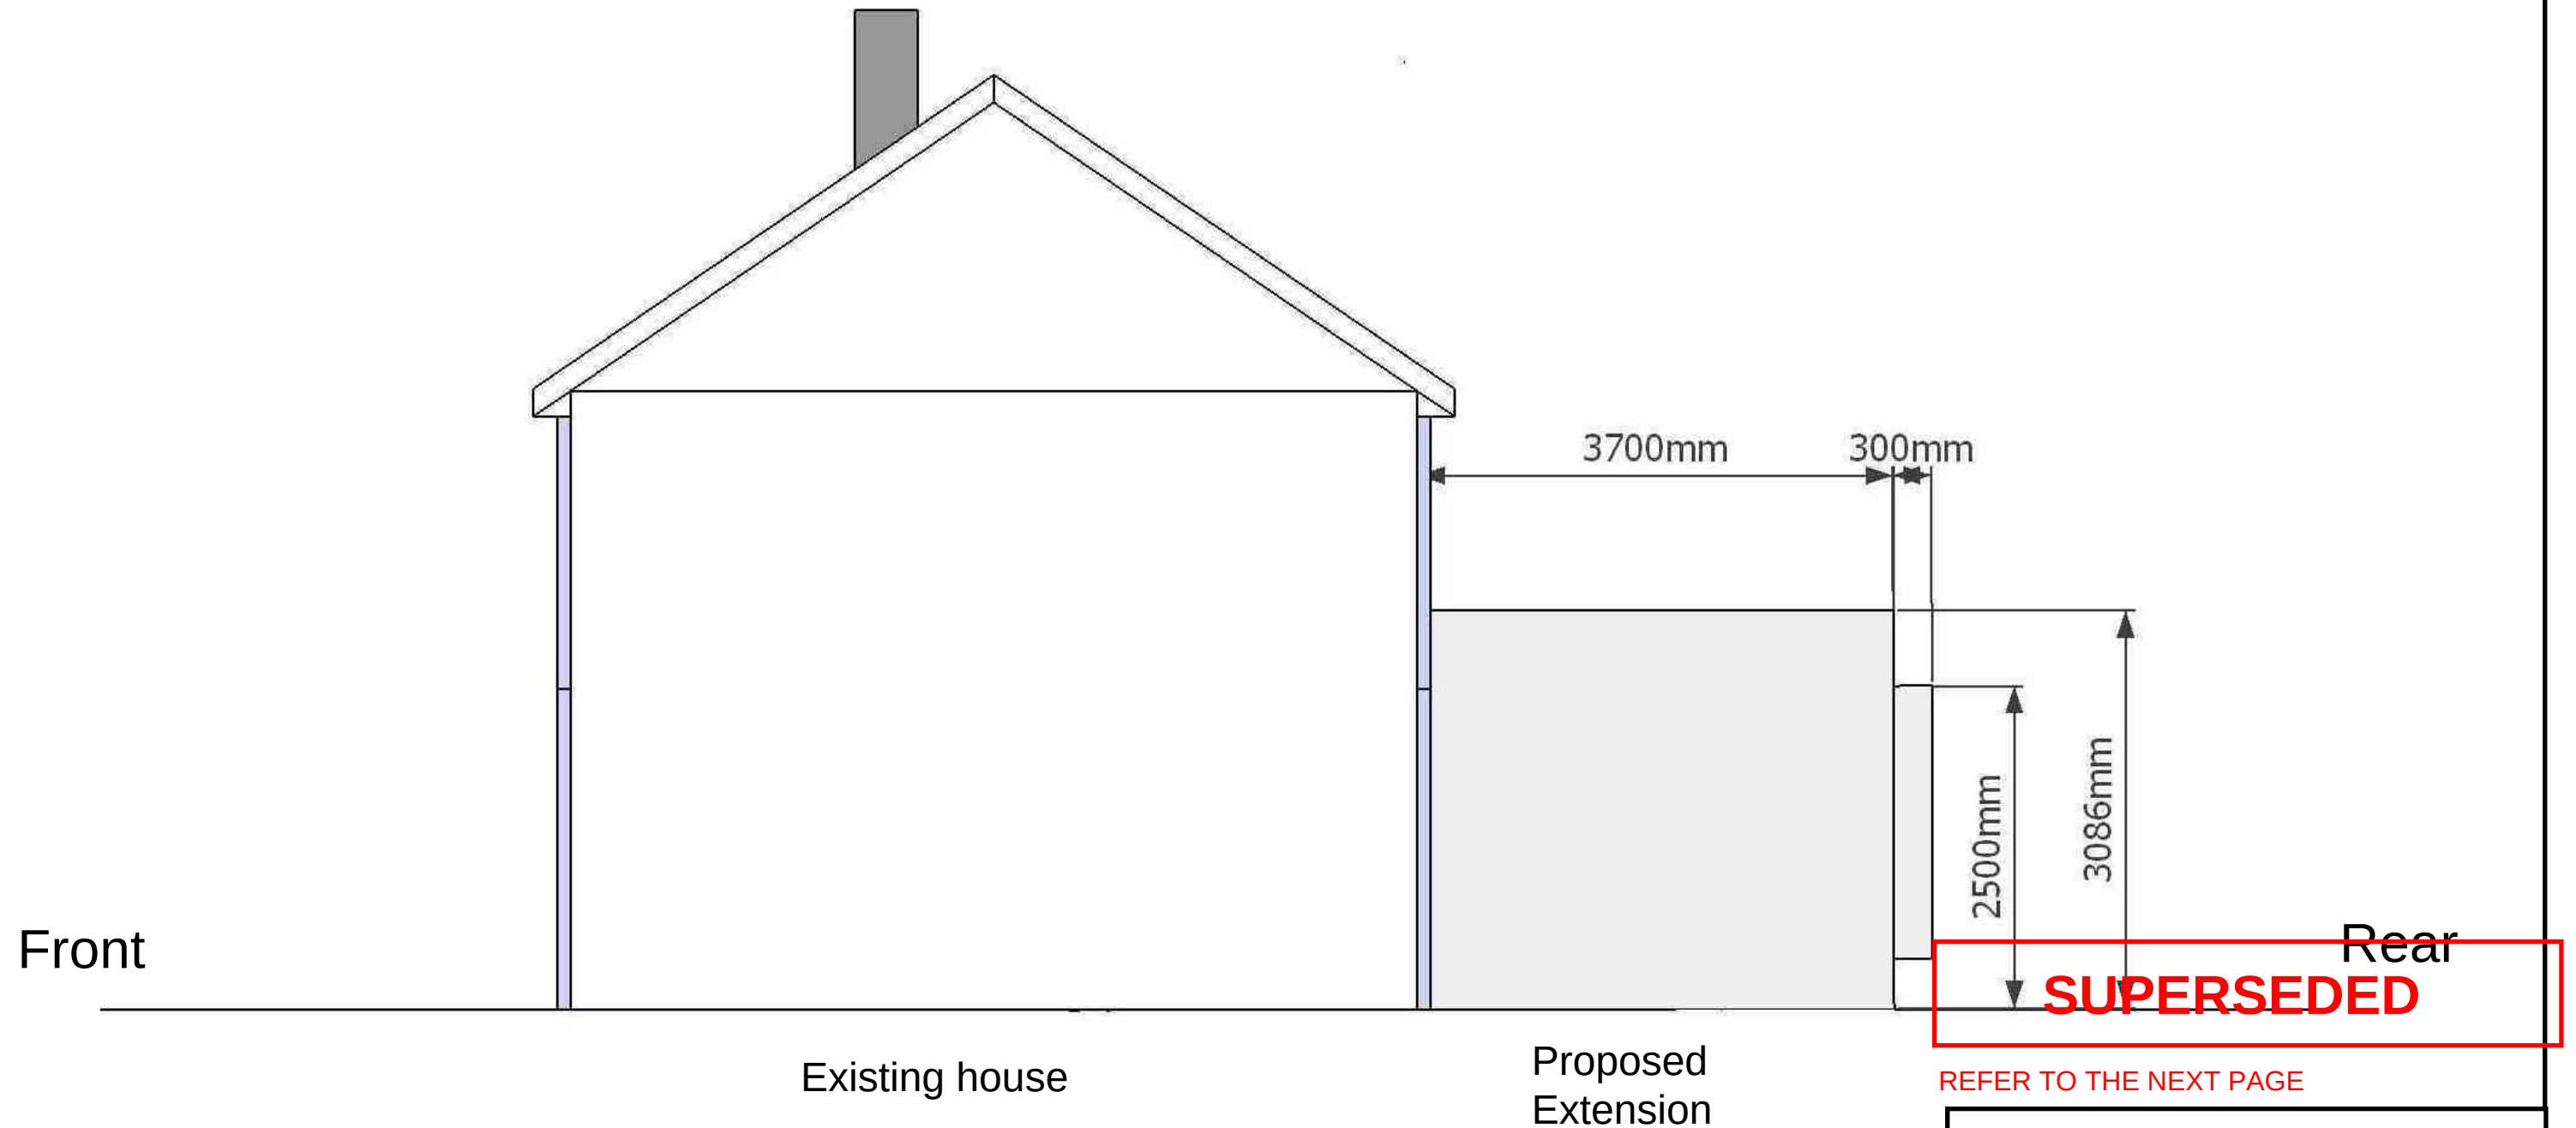


Side Elevation
View looking South - East

Drawing title: 104 Barncroft way
Havant PO9 3AH
- Side view
- Looking South East

Drawing set: Ground Floor Extension

Drawn: Jacek Kochmanski
Date: 31.07.2020 **Scale:** 1:50

Drawing format: A3 **Drawing No:** 5 of 9

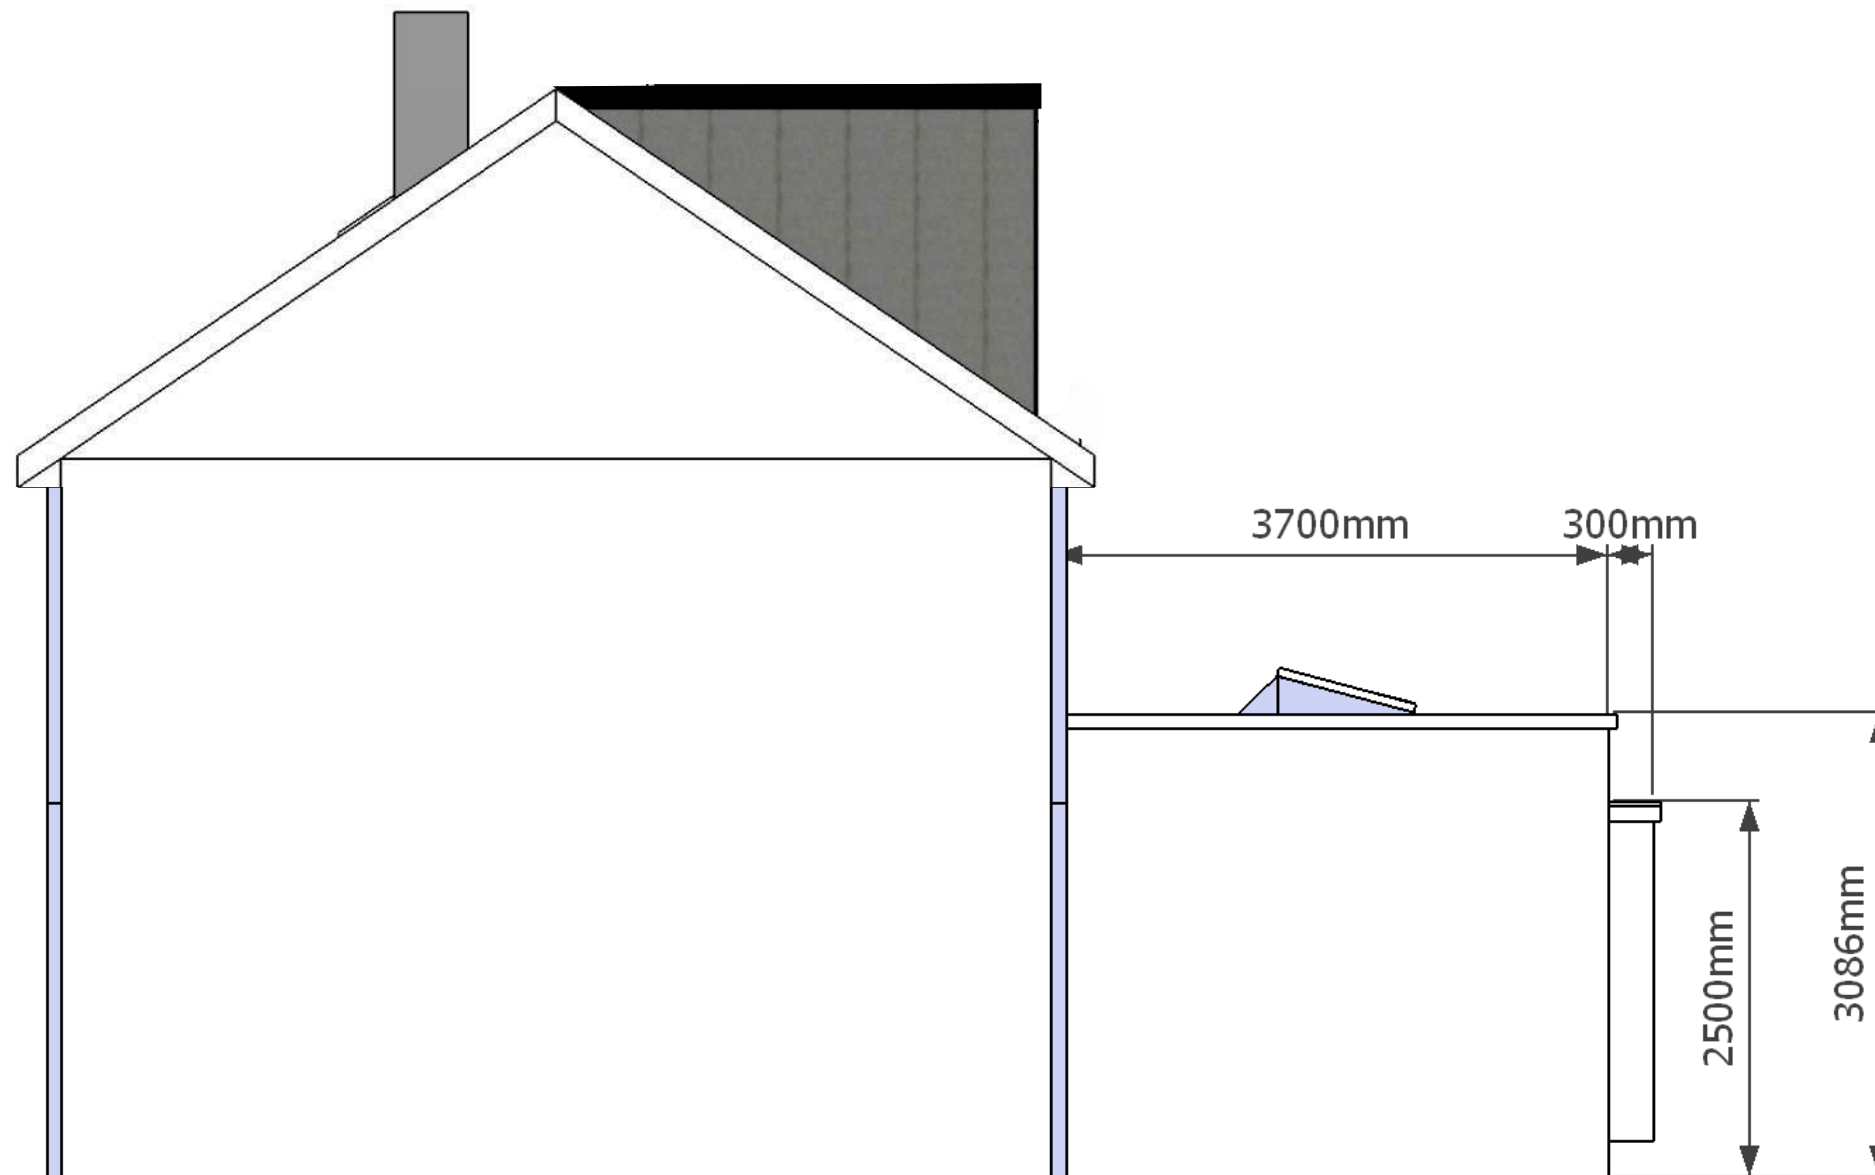

Front

Rear

Existing house

As Built
Extension


Side Elevation
View looking South - East

Drawing title: 104 Barncroft way
Havant PO9 3AH
- Side view
- Looking South East

Drawing set: Ground Floor Extension

Drawn: Jacek Kochmanski
Date: **24.05.2022** Scale: 1:50

Drawing format: A3 Drawing No: 5 of **9**

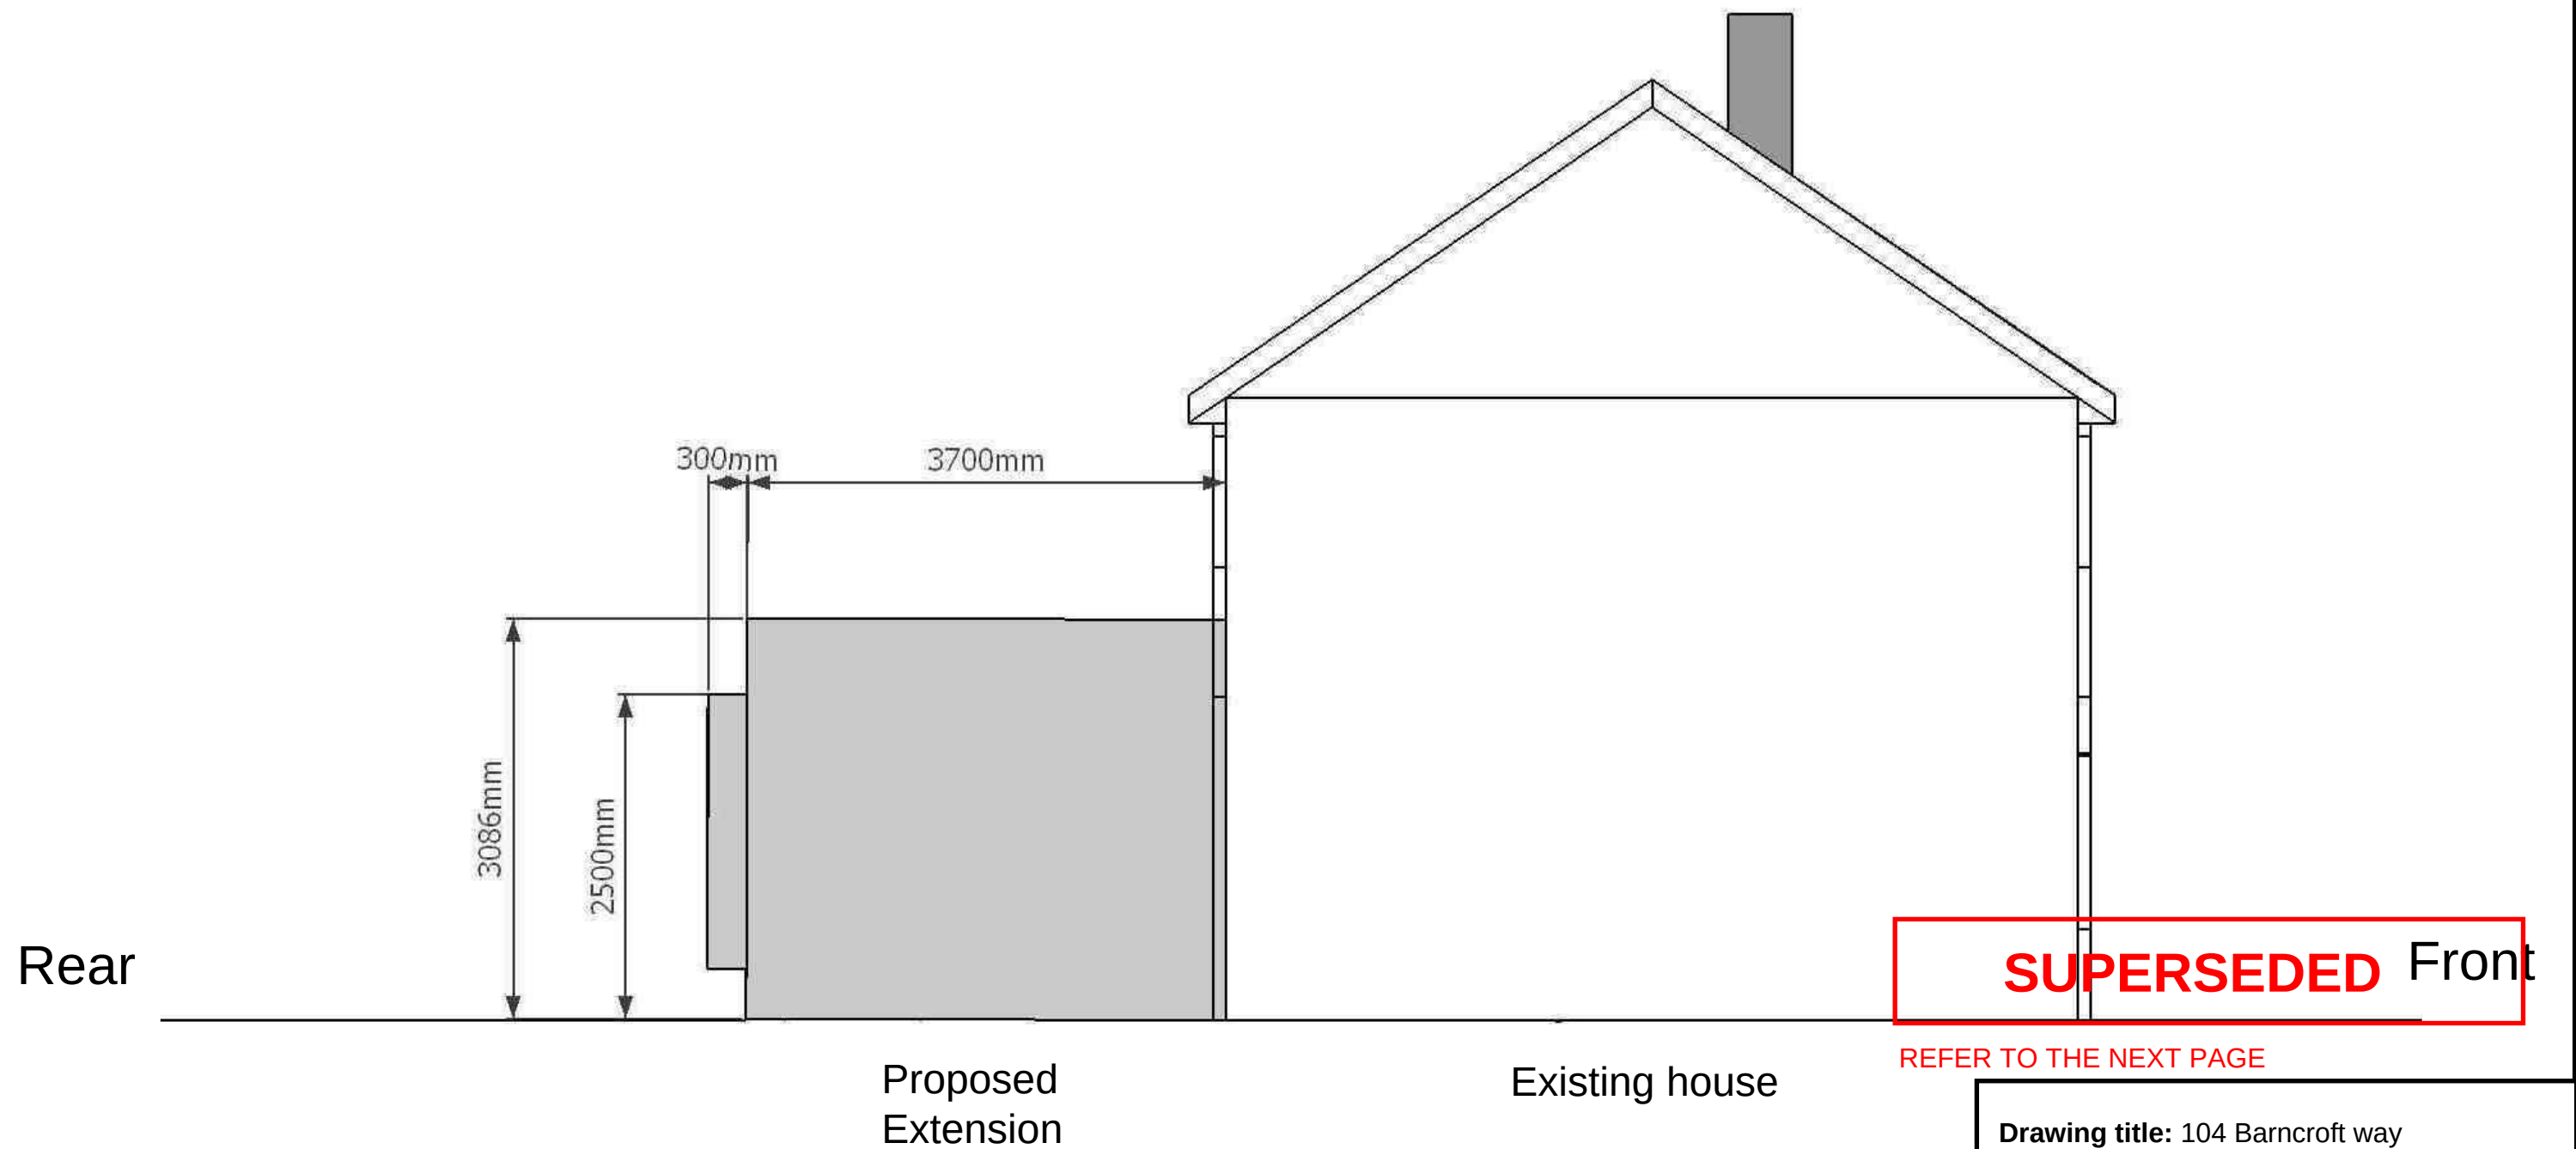


Side Elevation
View looking North - West

Drawing title: 104 Barncroft way
Havant PO9 3AH
- Side view
- Looking North West

Drawing set: Ground Floor Extension

Drawn: Jacek Kochmanski
Date: 31.07.2020 **Scale:** 1:50

Drawing format: A3 **Drawing No:** 6 of 9

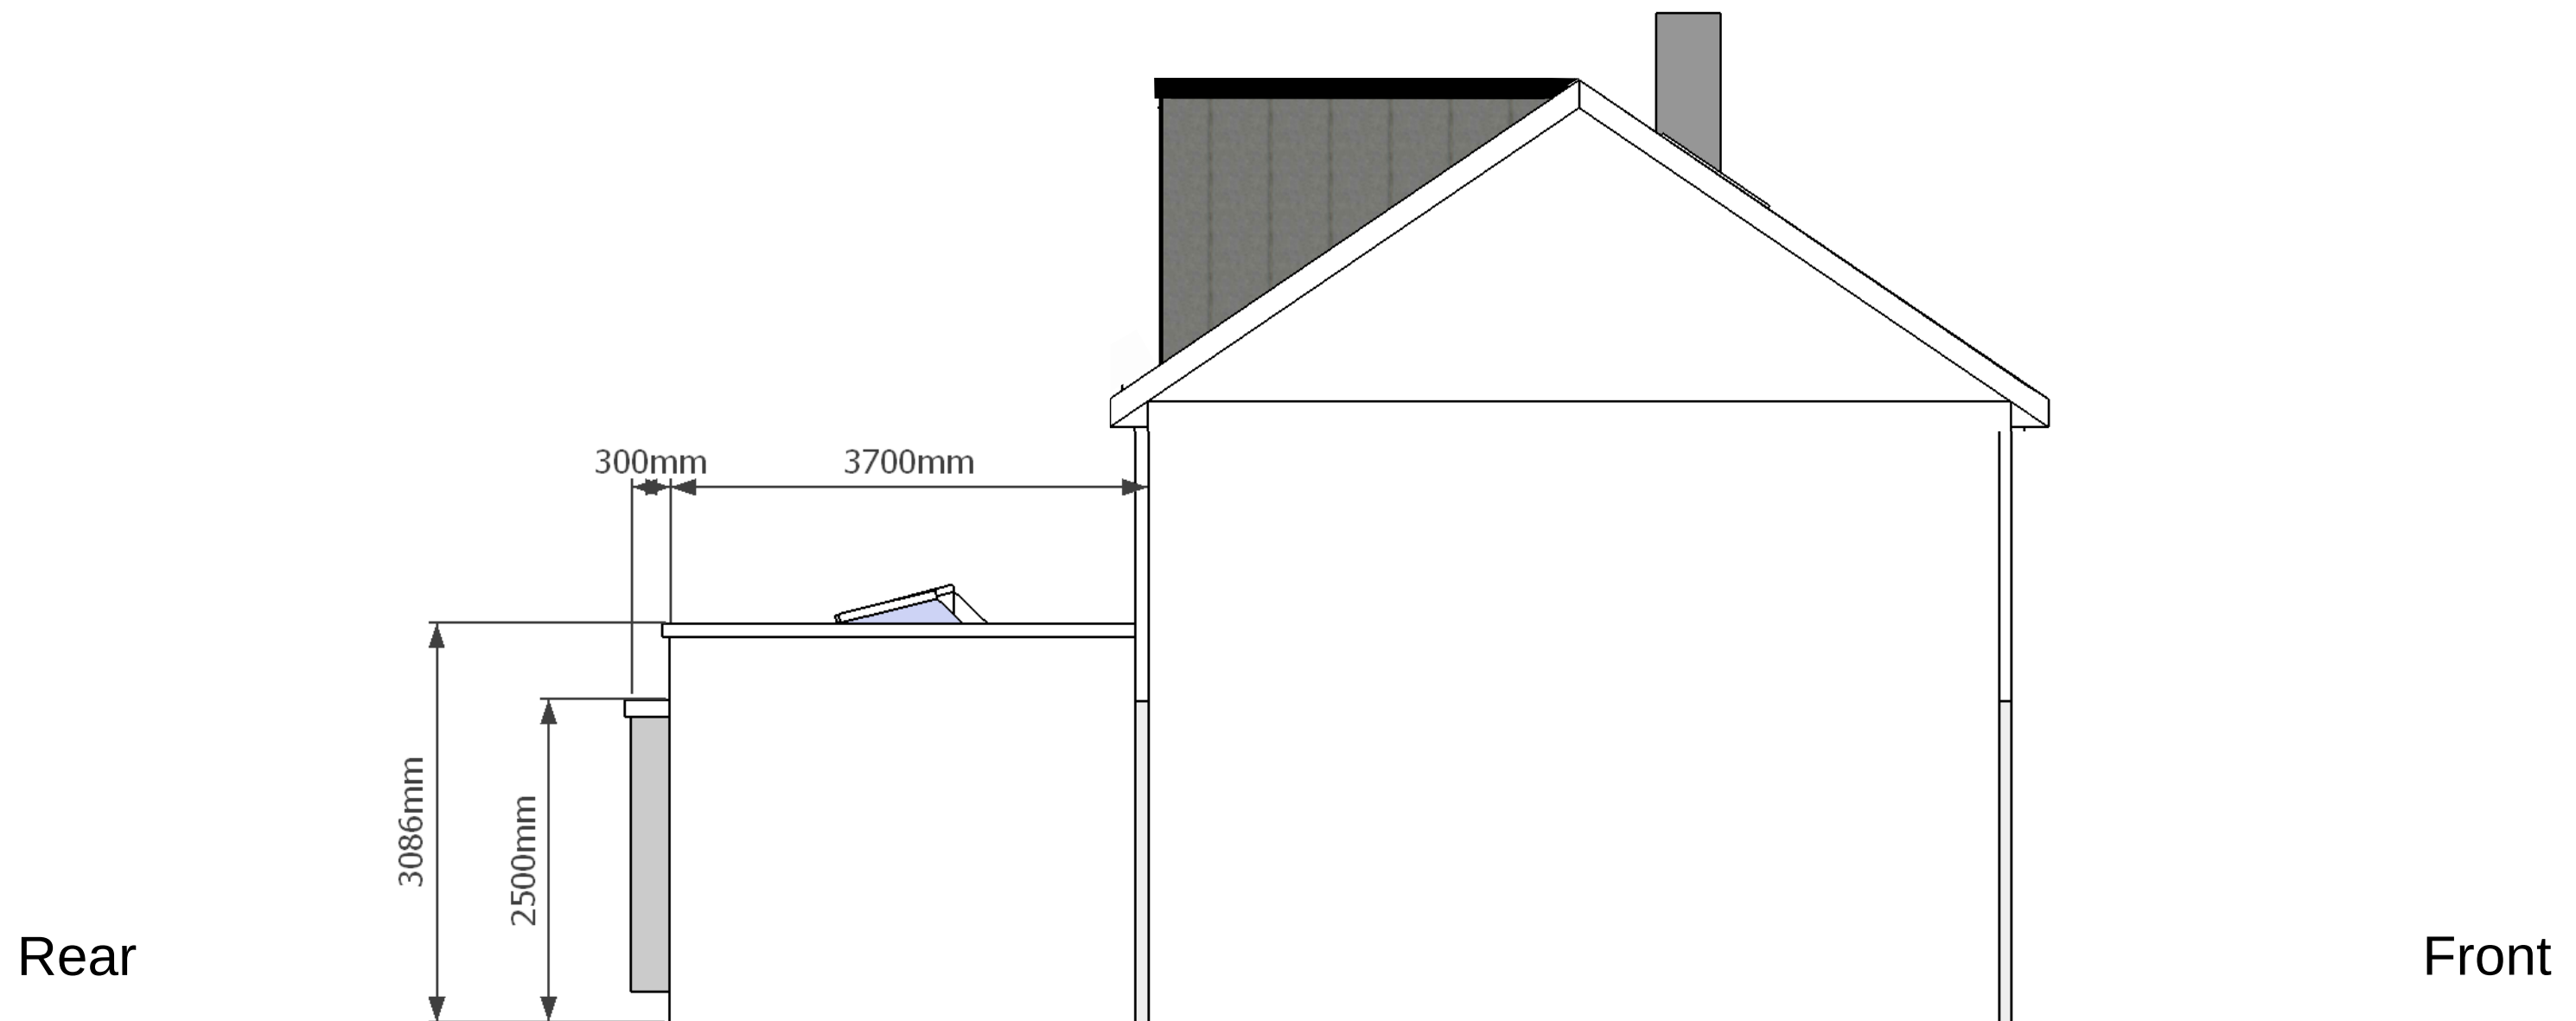

As Built
Extension

Existing house


Side Elevation
View looking North - West

Drawing title: 104 Barncroft way
Havant PO9 3AH
- Side view
- Looking North West


Drawing set: Ground Floor Extension

Drawn: Jacek Kochmanski
Date: **24.05.2022** Scale: 1:50

Drawing format: A3 Drawing No: 6 of **9**

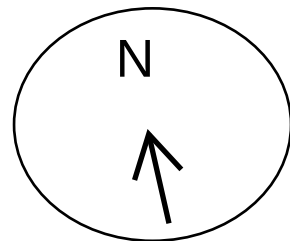

Front

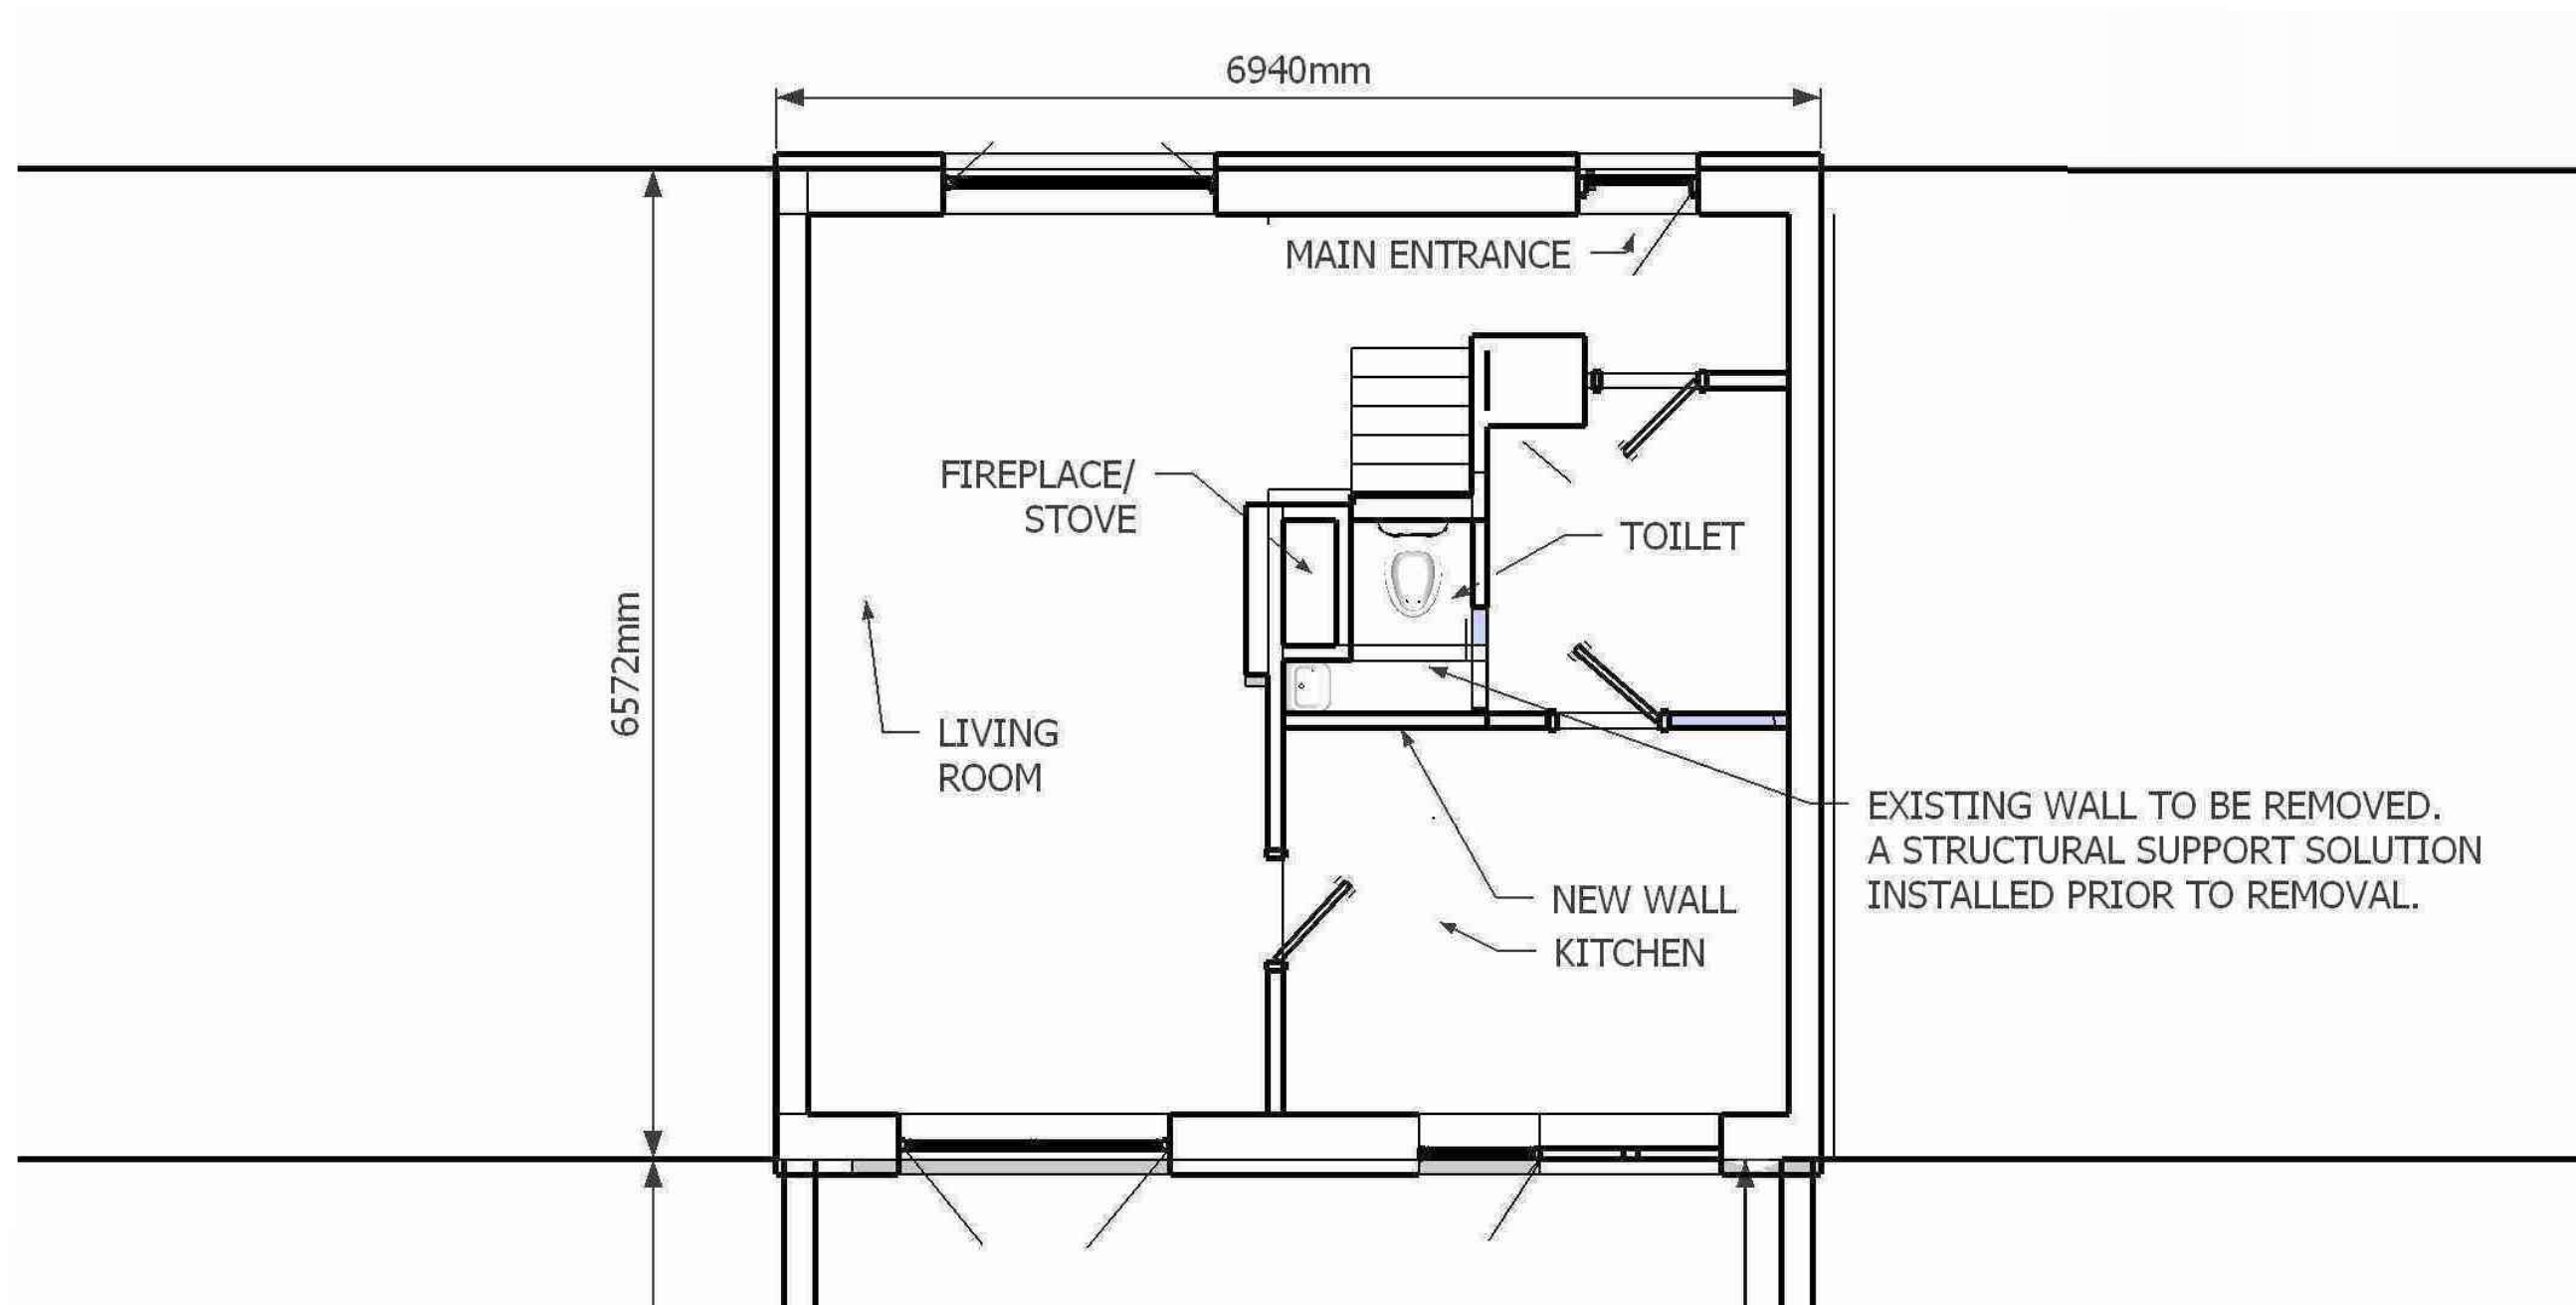


Rear

Drawing title: 104 Barncroft way
Havant PO9 3AH
- **Ground Floor Plan**


Drawing set: Ground Floor Extension

Drawn: Jacek Kochmanski
Date: 31.07.2020

Drawing format: A3 **Drawing No:** 7 of 9

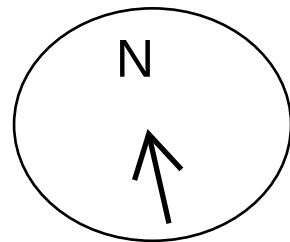

Front

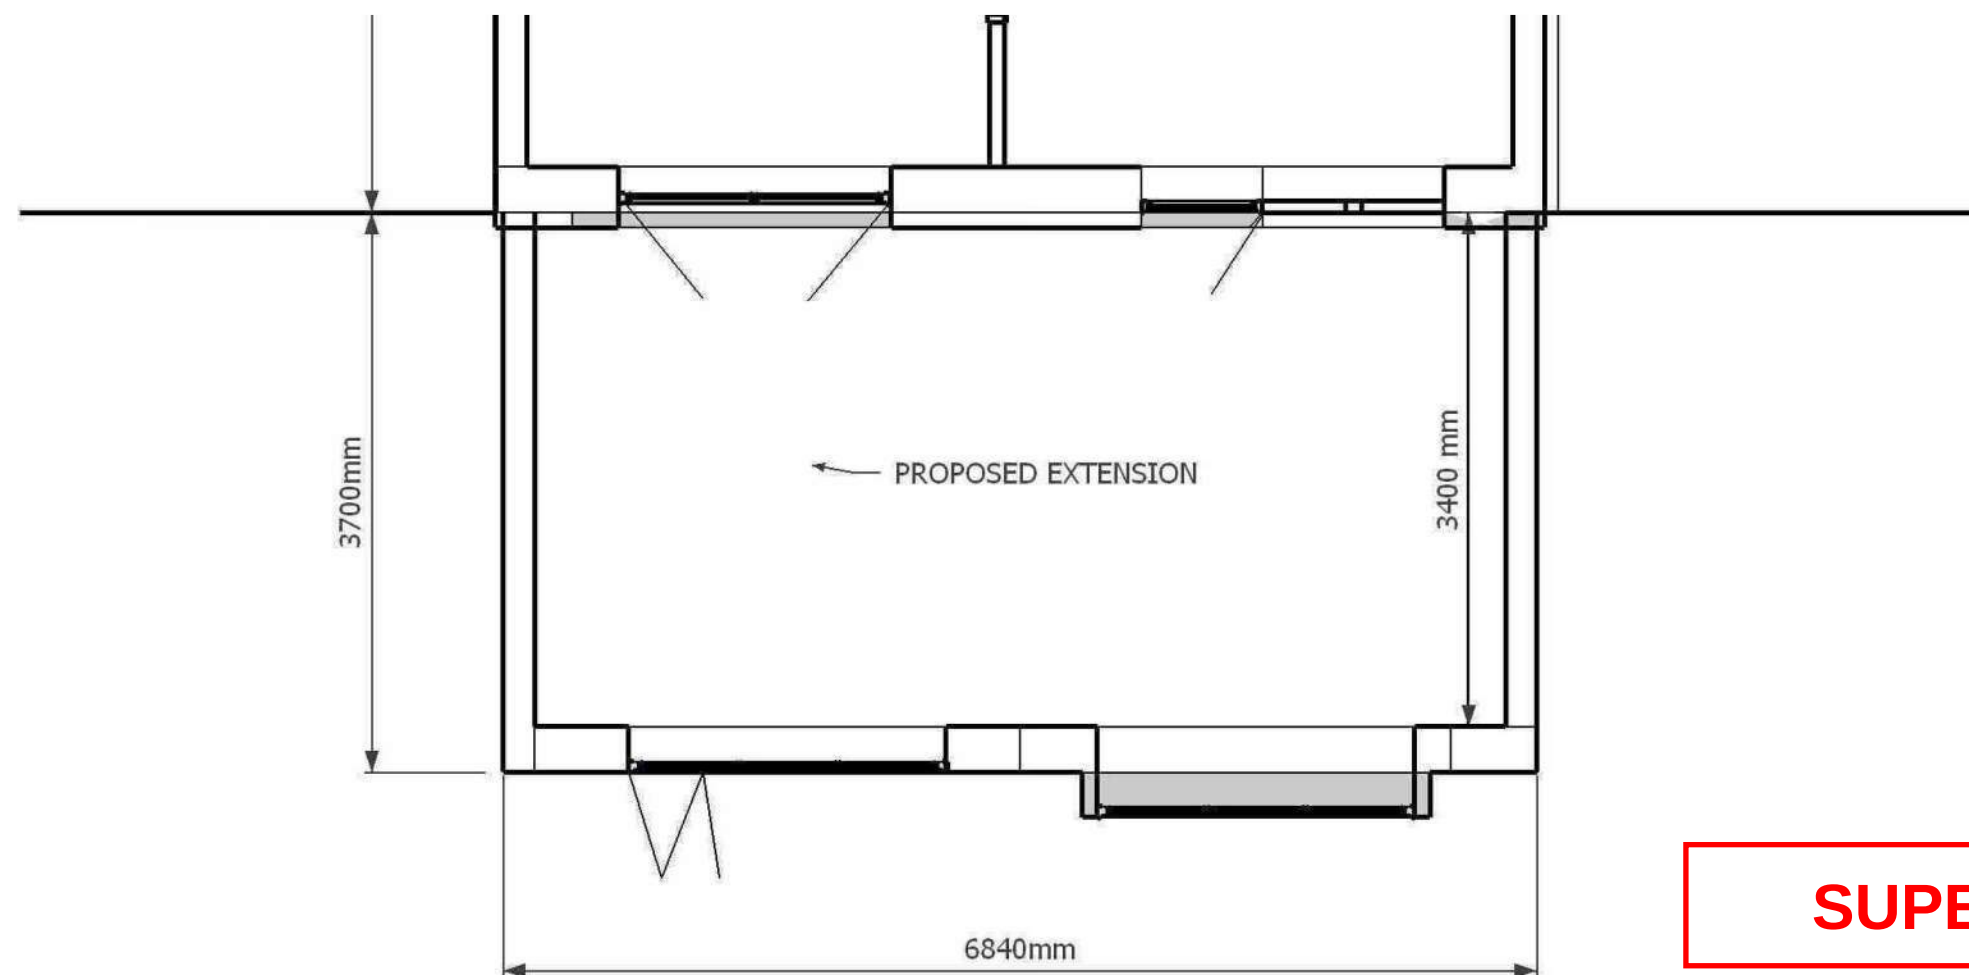

SUPERSEDED

REFER TO THE NEXT PAGE


Drawing title: 104 Barncroft way
Havant PO9 3AH
- **Proposed Extension Floor Plan**

Drawing set: Ground Floor Extension


Drawn: Jacek Kochmanski
Date: 31.07.2020

Drawing format: A3 **Drawing No:** 8 of 9

Rear

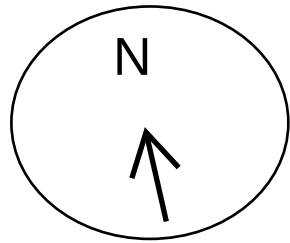

Front

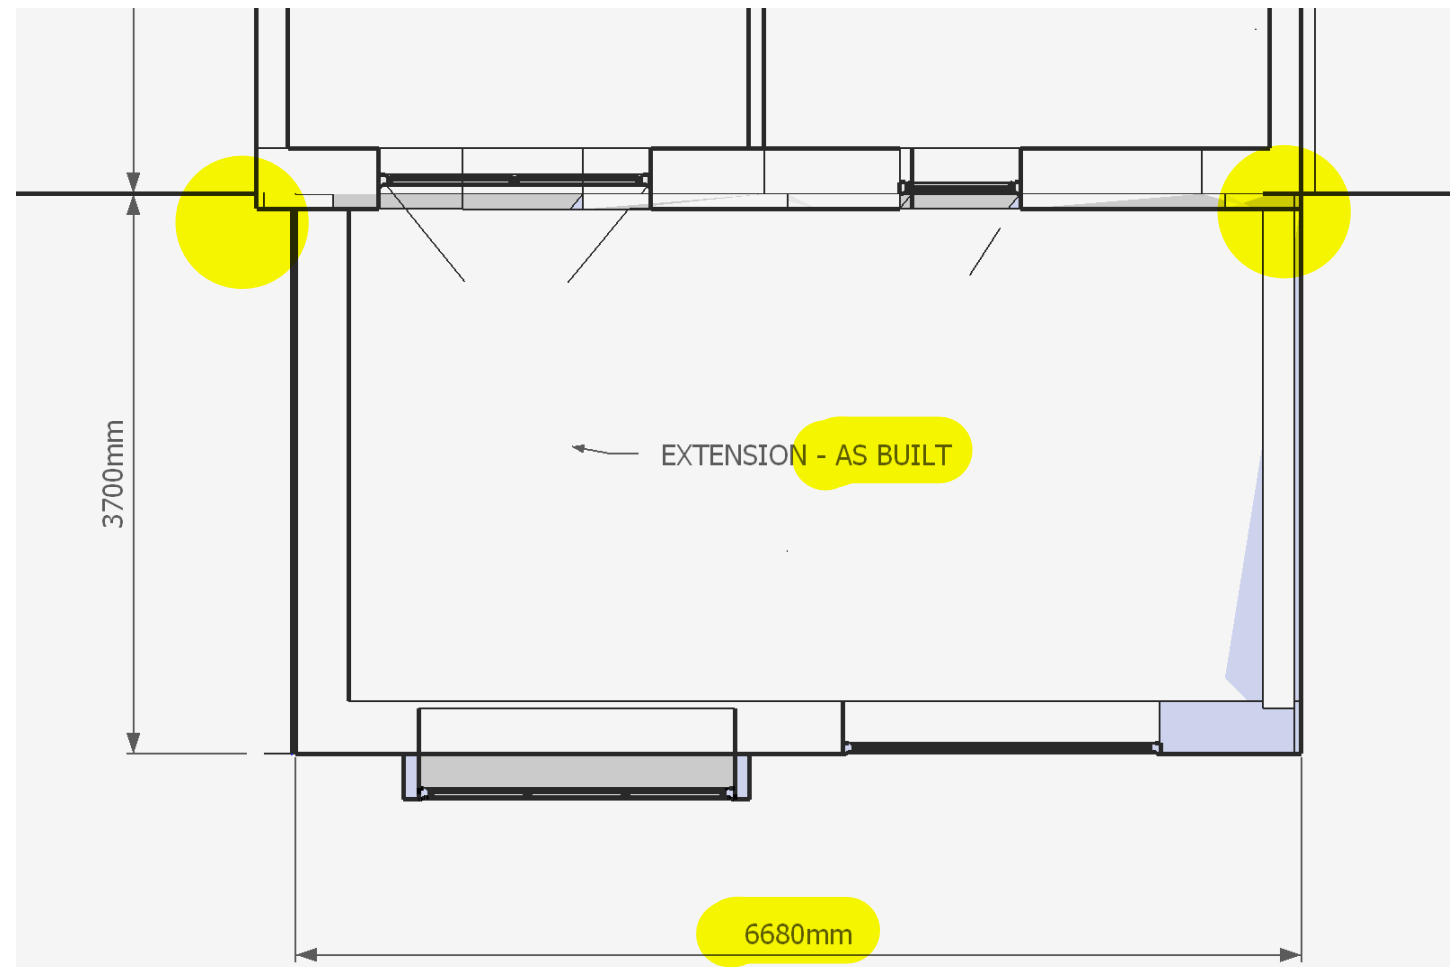

Rear


Drawing title: 104 Barncroft way
Havant PO9 3AH
- Extension Floor
Plan - **As Built**

Drawing set: Ground Floor Extension


Drawn: Jacek Kochmanski

Date: **14.03.2022**

Drawing format: A3 Drawing No: **8 of 9**

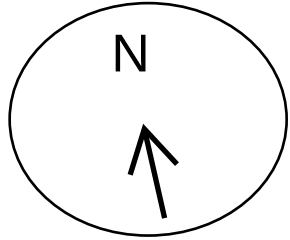

Front

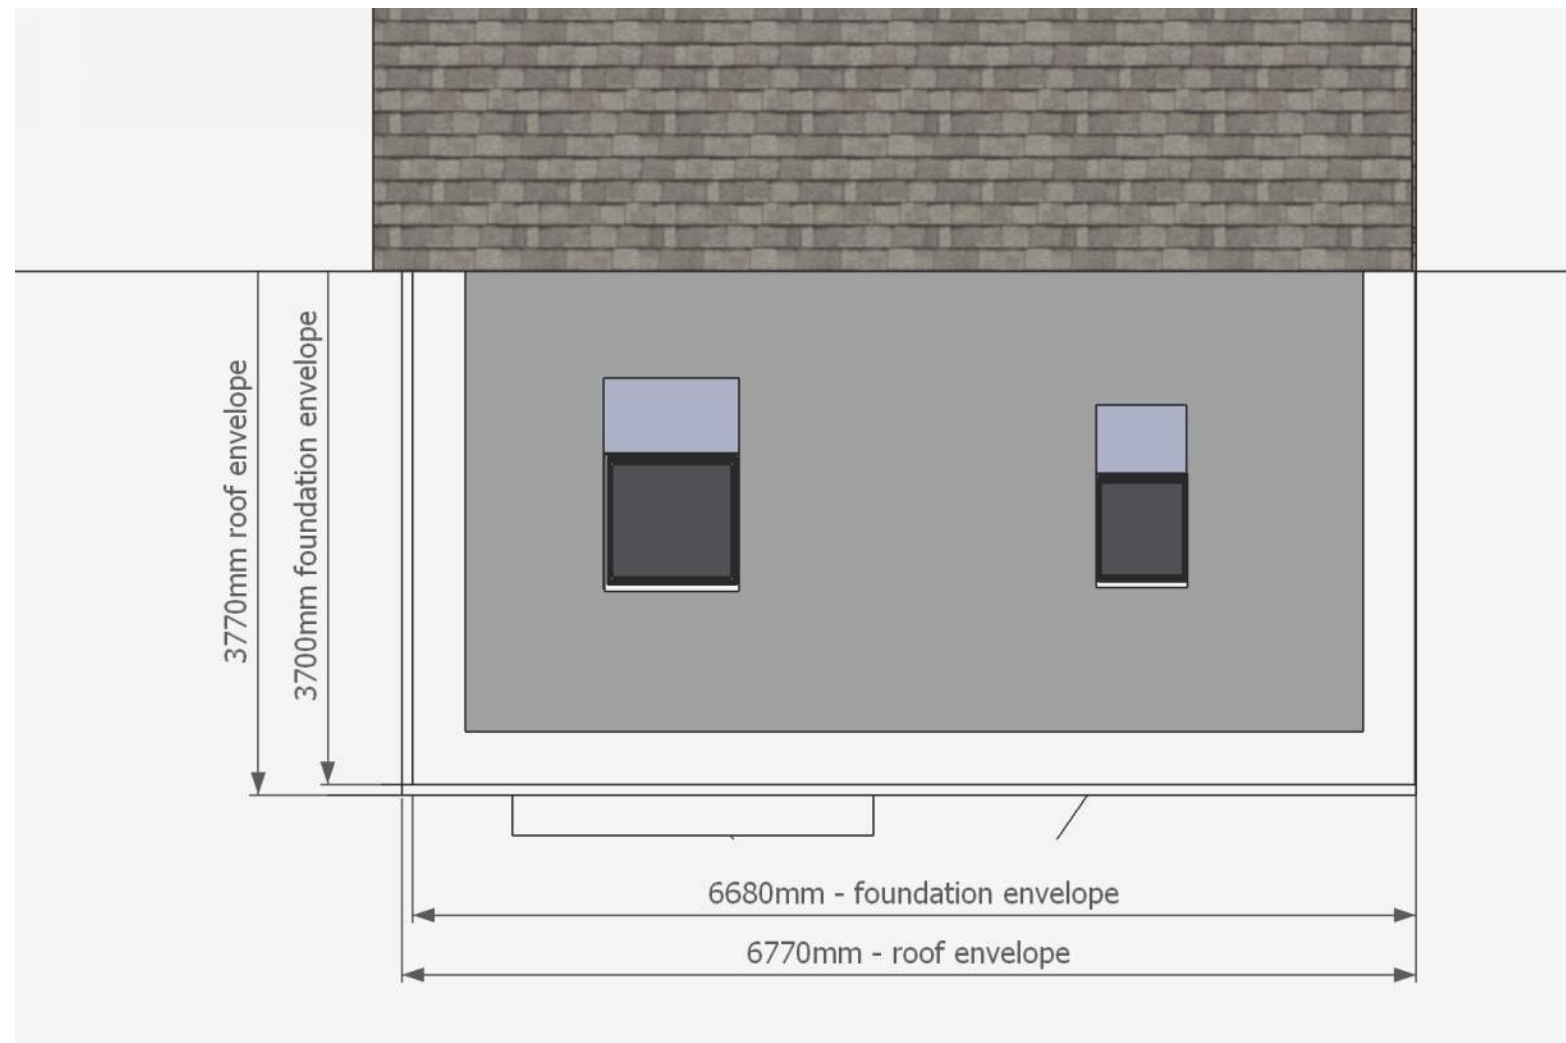

Rear

Drawing title: 104 Barncroft way
Havant PO9 3AH
- Extension Roof Plan
- As Built

Drawing set: Ground Floor Extension

Drawn: Jacek Kochmanski
Date: **16.05.2022**

Drawing format: A3 Drawing No: : **9 of 9**