




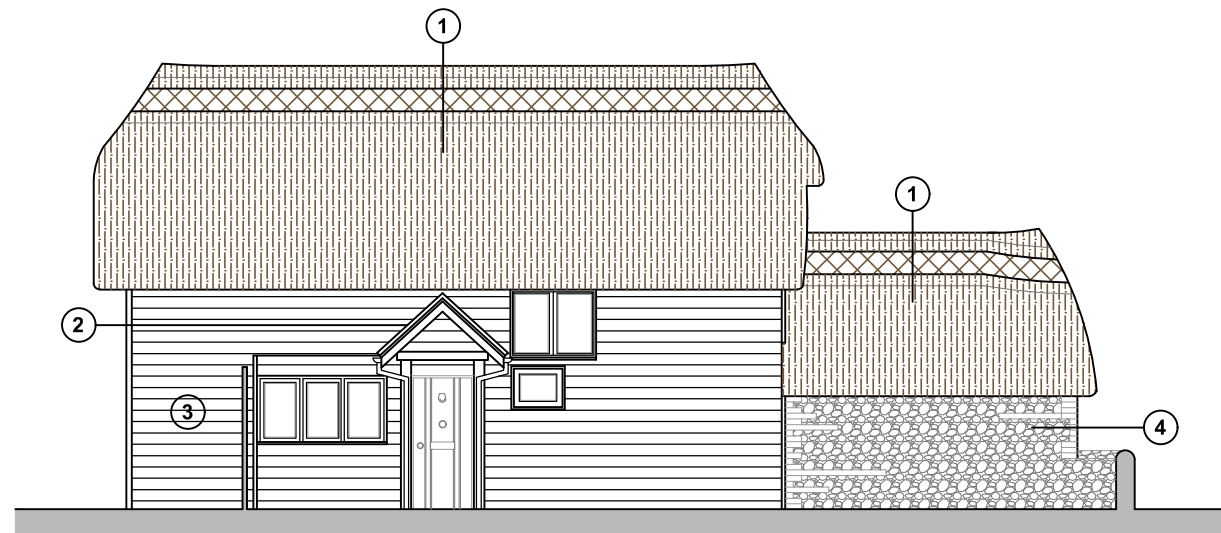


North Elevation (Front)

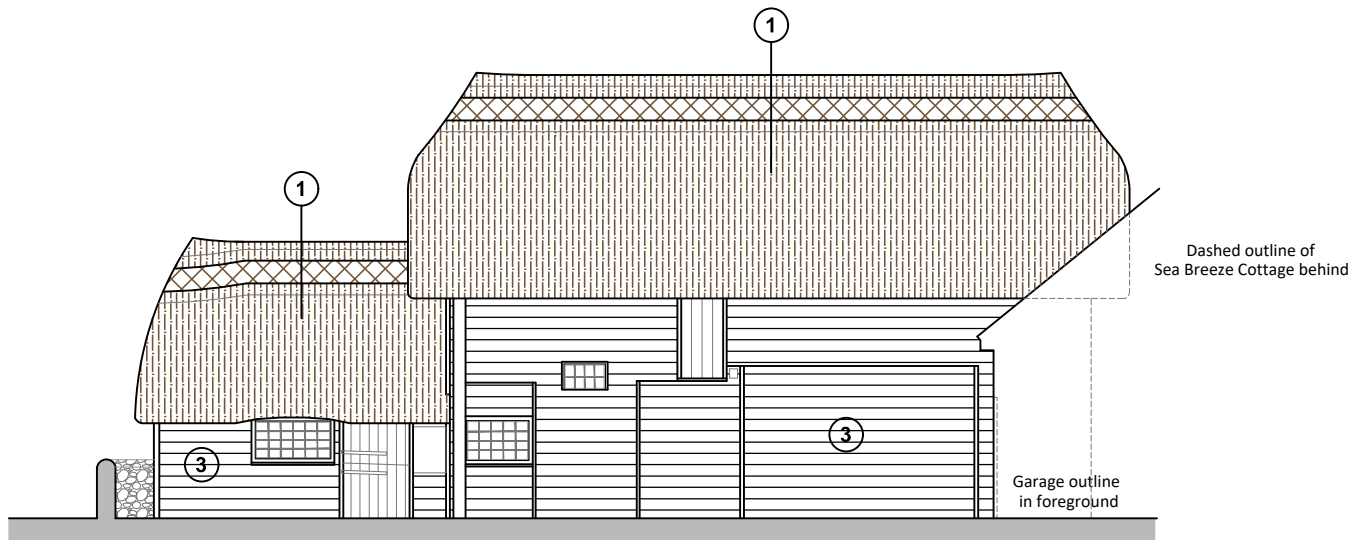


South Elevation (Rear)

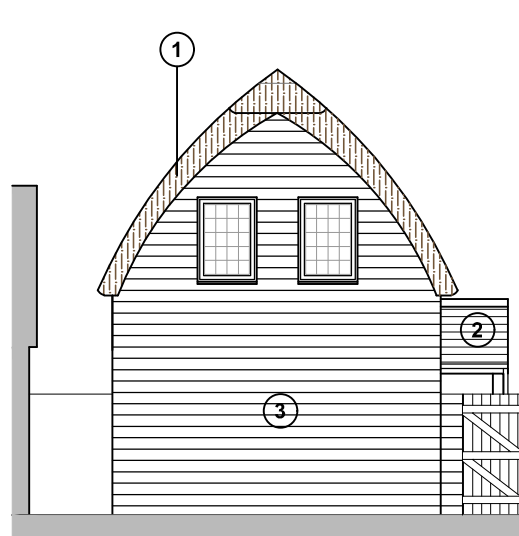


East Elevation (Side)

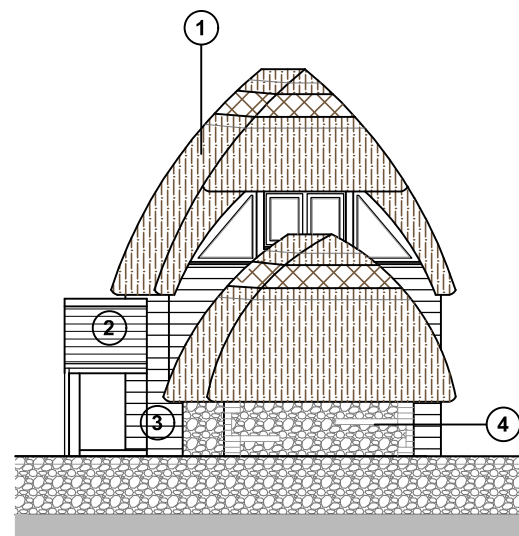

West Elevation (Side)

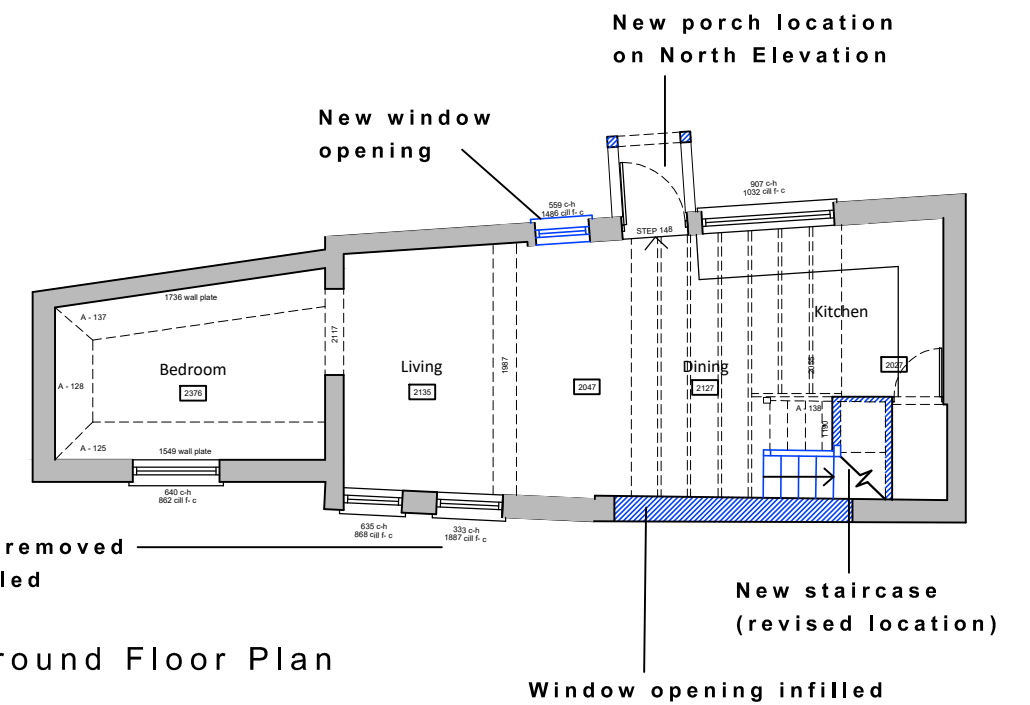

Ground Floor Plan

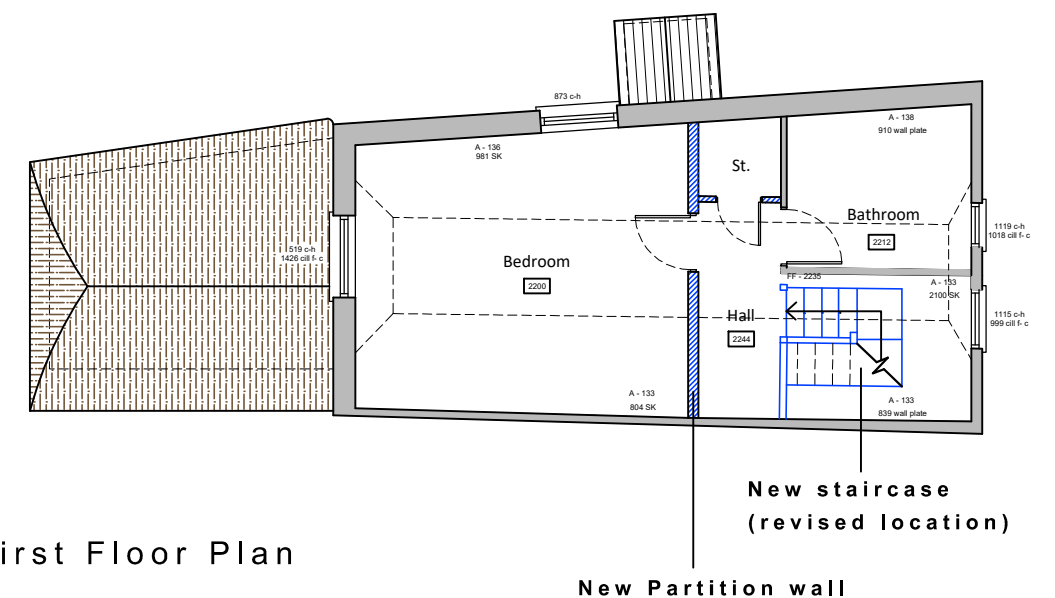


First Floor Plan

Schedule of materials:

- ① Thatch Roof
- ② Plain clay tiles
- ③ Black painted timber cladding
- ④ Varying stone/flint /brick wall

As Built Plans & Elevations scale 1:100

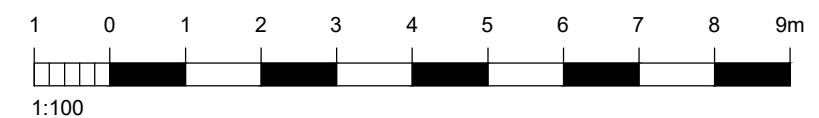

For MR & MRS WILKINSON	Title AS BUILT PLANS & ELEVATIONS			Office Tel: 01243 933732
Project AS BUILT PLANS AT SEA BREEZE COTTAGE, BEACH ROAD, HAYLING ISLAND, PO11 9DT	Date MAY 2022	Drawn LL	Scale 1:100 @ A3	Checked -
	Job Number PL 606.22	Drawing Number -01	Revision A	Email: admin@jb-architecturedesign.com Web: www.jb-architecturedesign.com

