



4 East Garage Elevation
1 : 100

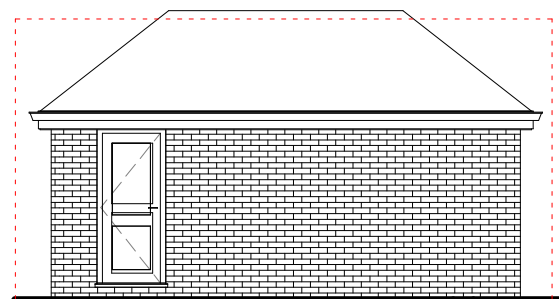


5 North Garage Elevation
1 : 100

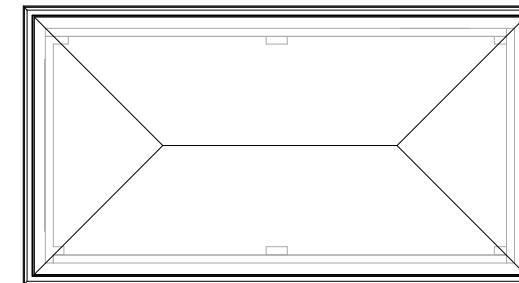


2 Garage Roof Plan
1 : 100

----- Outline of previous garage


(It should be noted that this was in place and used as storage whilst the house was constructed and then demolished and replaced)

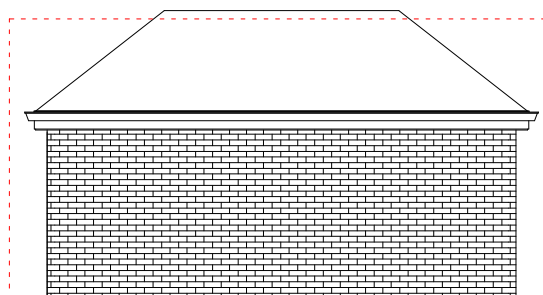

6 South Garage Elevation
1 : 100

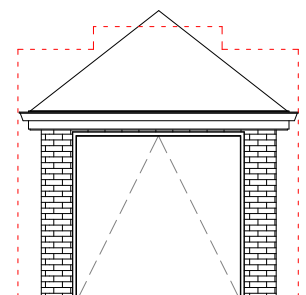


7 West Garage Elevation
1 : 100

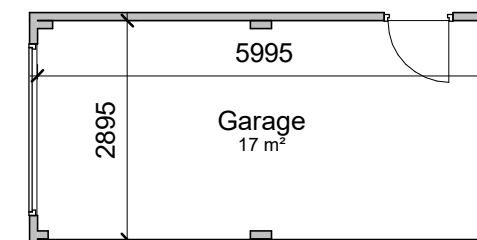

3 Garage Floor Plan
1 : 100




Height of previous garage
3.295M at Eaves and 3.5M
at peak of parapet

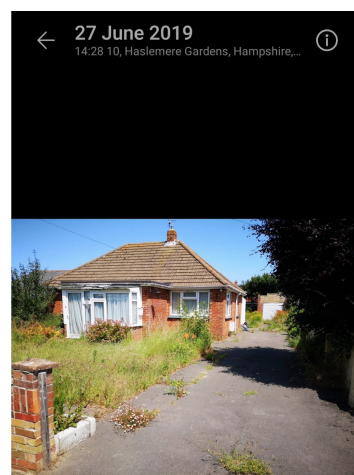

As built new garage



IJ Murray
Associates Ltd

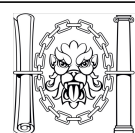

CIAT
REGISTERED PRACTICE

www.ijma.co.uk

I J Murray Associates
Ltd
200 Seafront
Hayling Island
Hampshire
PO11 9HR
Phone 07779 246915

These drawings are for planning and building regulation purposes only and are not for construction. All dimensions should be checked on site before work commences

These drawings are the property of IJ Murray Associates Ltd and should not be reproduced or used in any way without the permission of a Director of IJ Murray Associates Ltd

Nick Porcher

22 Haselmere Grdns HI

Garage plans

Project number	Project Number
Date	Issue Date
Drawn by	Author
Checked by	Checker

A112 V6.2 BRs

Scale 1 : 100