





Roof Plan
1:100 @A1

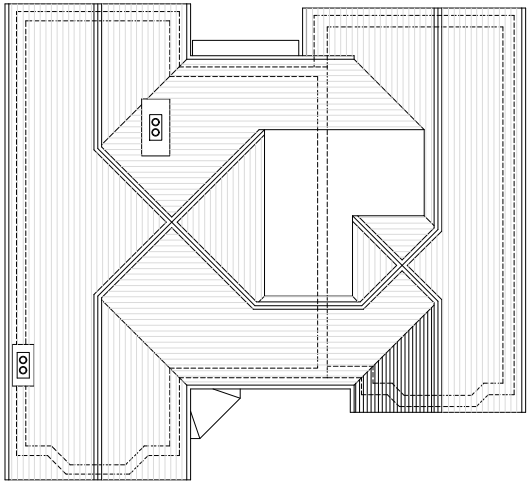


First Floor Plan
1:100 @A1

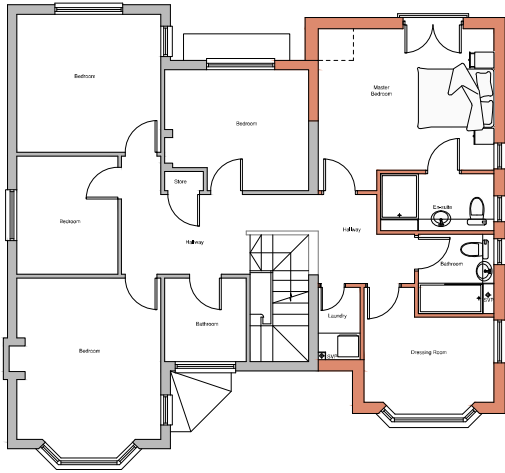


Ground Floor Plan
1:100 @A1

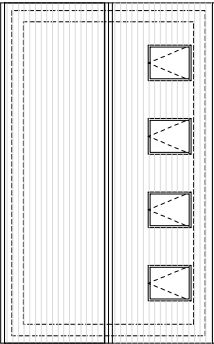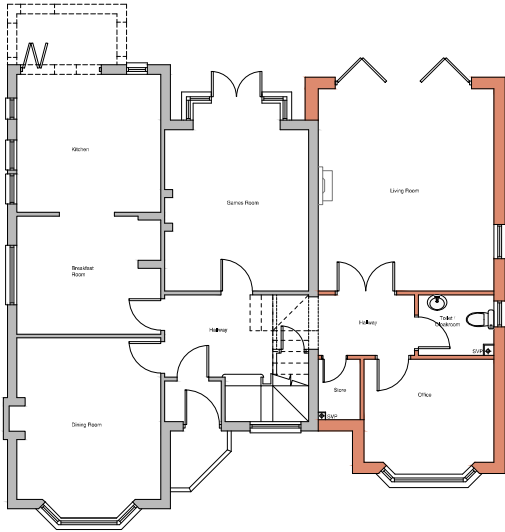

Roof Plan
1:100 @A1

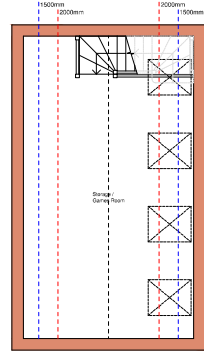

First Floor Plan
1:100 @A1

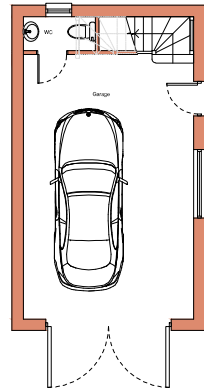


Ground Floor Plan
1:100 @A1



West Elevation (Front)
1:100 @A1




South Elevation (Side)
1:100 @A1

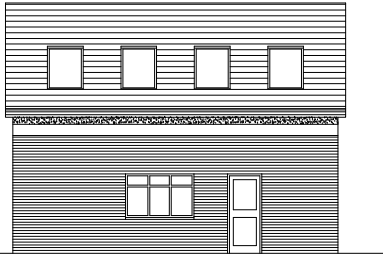

North Elevation (Side)
1:100 @A1



East Elevation (Rear)
1:100 @A1

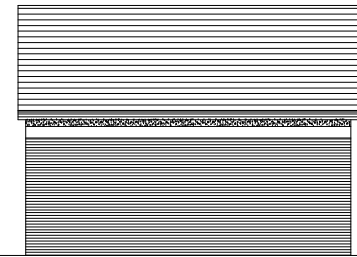

PLANNING

project	13 Langstone Road Havant PO9 1RA		
detail	As Built Plans & Elevations		
date	Nov 2018	status	Planning
a1 scale	a3 scale	job no.	rev
As indicated		1005-PD103	