

Dotted Red line indicated outline of Planning Approved Design

Aluminium rooflight slot

Approx 19° pitch to roof with Roofing tiles.
Colour and type subject to approval of local authority.

External walling finished in-

Facing brickwork.
Colour and type of facing brickwork subject to approval of local authority.

Aluminium panelling to garage door


Aluminium fascia. panelling

Door & Sidelight in recess

10.42m

SVPs to terminate min 1.0m above operable windows that are within 3.0m and to be topped with protective cage or to terminate to ridge or tile outlet.

FRONT ELEVATION

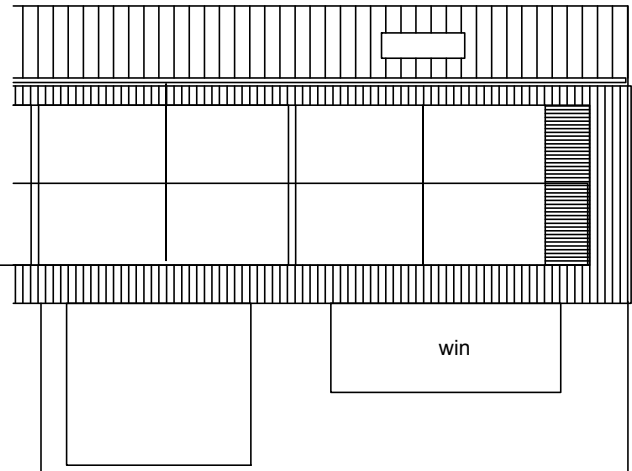

4.018m

cbf

REAR ELEVATION

Dotted Red line indicated outline of Planning Approved Design

Aluminium fascia/panelling

cbf

Brickwork

Dotted Red line indicated outline of Planning Approved Design

SIDE ELEVATION

4.1m

4.09m

Dotted Red line indicated outline of Planning Approved Design

Aluminium fascia. panelling

SIDE ELEVATION

Copyright

These drawings and all drawings prepared by Design & Materials Ltd are the property of Design & Materials Ltd and are protected under copyright. They must not be used, or reproduced in any form, without the written consent of Design & Materials Ltd.

The plans and information contained therein are supplied for the sole purpose of the construction of the building, or buildings in conjunction with an all-in package of architectural and materials supply service purchased from Design & Materials Ltd.

Revisions:		
A	Dec 2015	Drawing Updated
B	Aug 2016	Drawing Updated
C	Aug 2016	Drawing updated
D	Aug 2016	Drawing Updated
E	Sept 2016	Revised Front Elevation

THIS DRAWING IS FOR PLANNING PURPOSES ONLY.
DO NOT USE FOR BUILDING.

Client:
Mr & Mrs T Stallard
Project:
Replacement Dwelling @

3 Swans Walk
Hayling Island
PO11 9TX

Date: Nov 2015
Scale: 1:100
Paper Size: A2

Revision: **E**

Drawing No. **T355/2**
Elevations

Design & Materials Limited
enquiries@designandmaterials.uk.com
www.designandmaterials.uk.com
Consultants throughout the UK

Head Office
8 The Point
Coach Road
Shireoaks
Nottinghamshire
S81 8BW

T: 01909 531454
F: 01909 484179



Design & Materials