

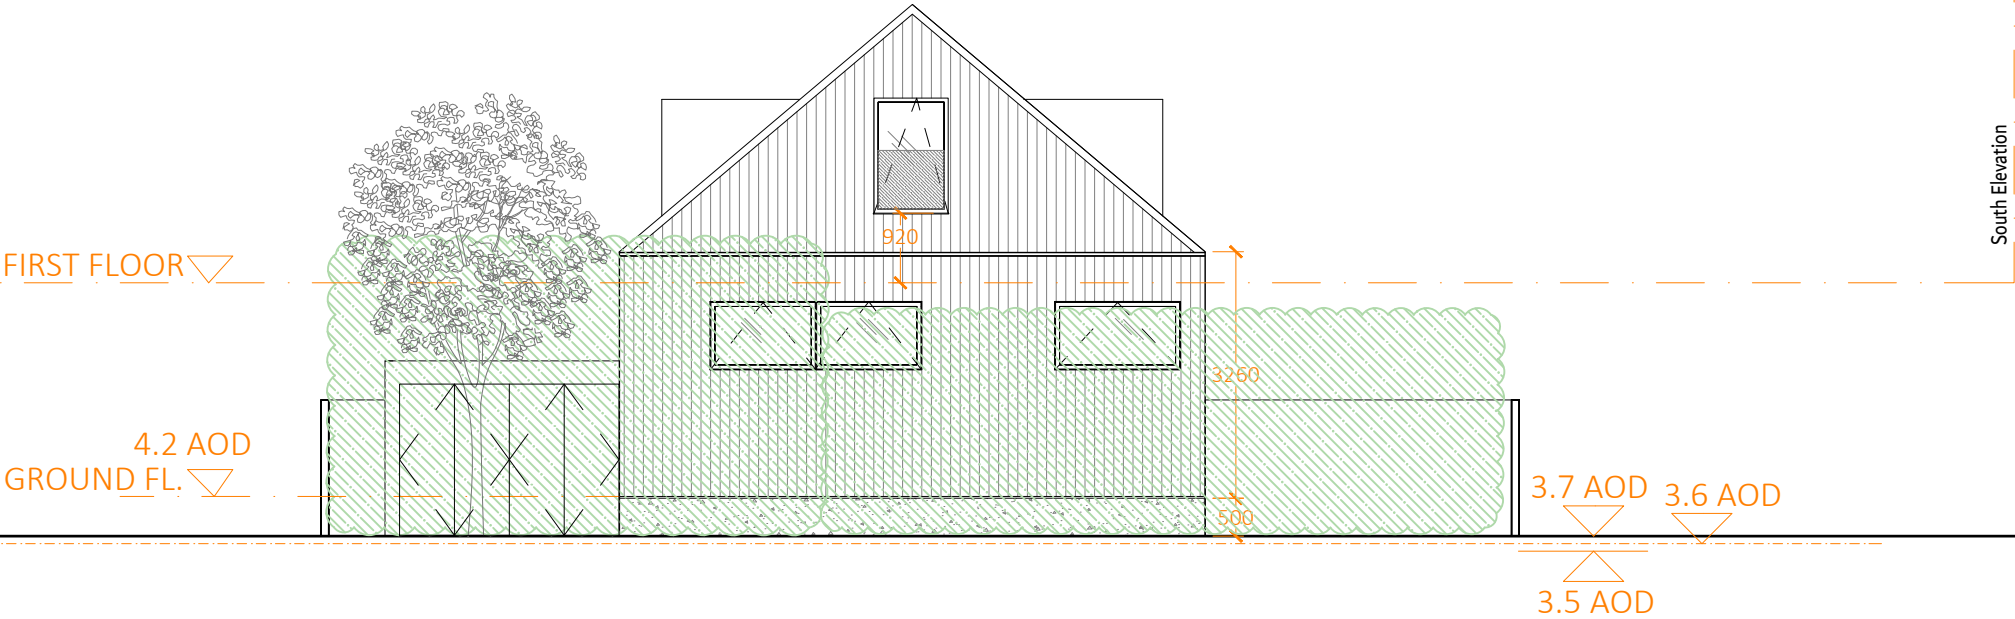
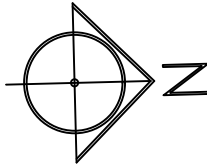



Proposed South and West Elevations

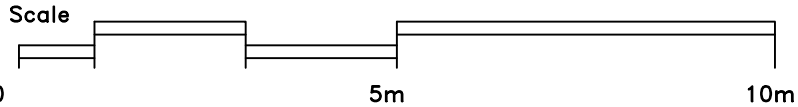

South Elevation

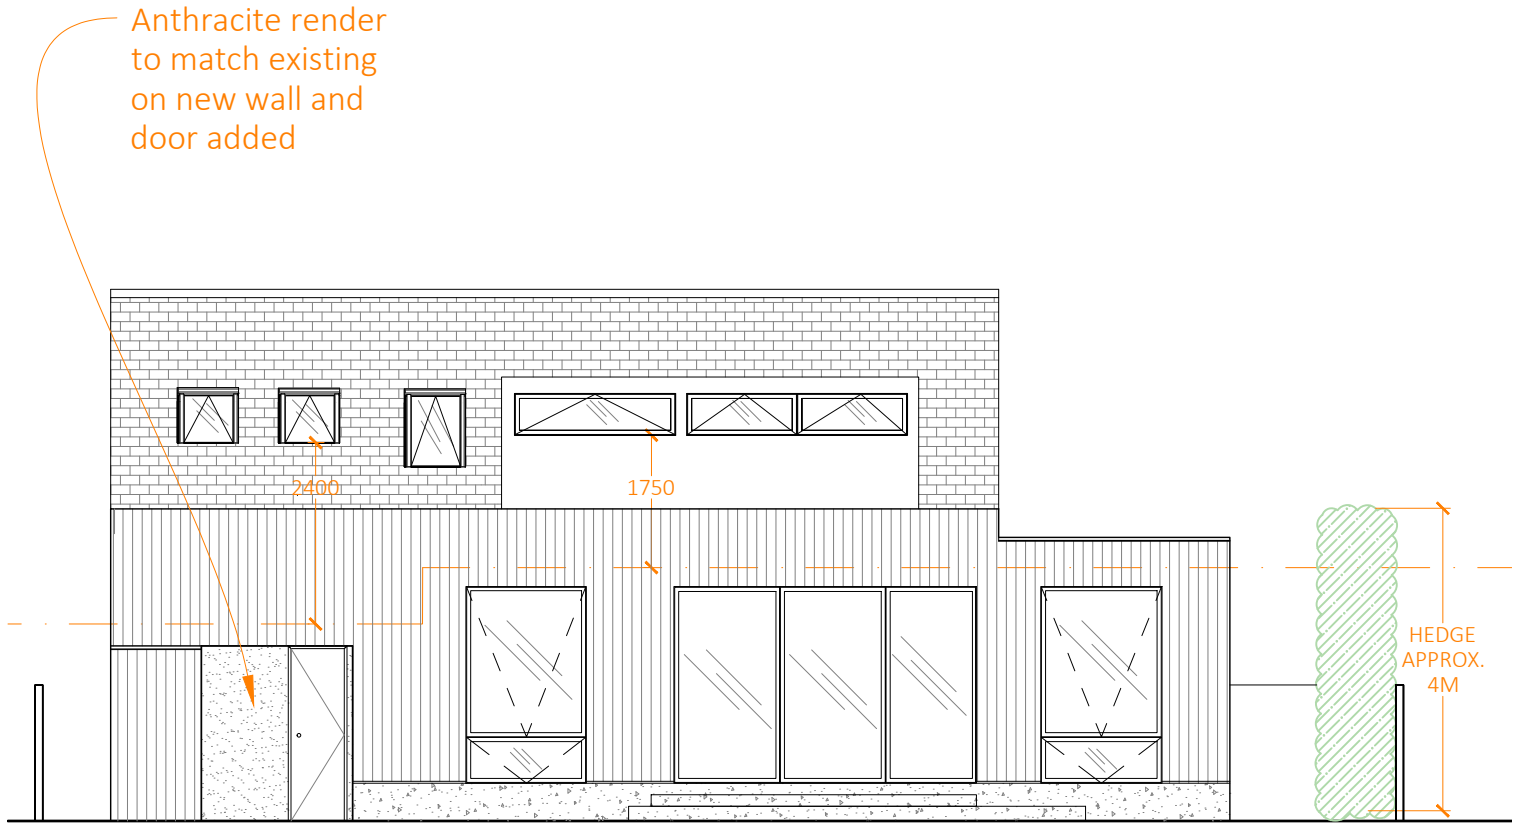

West Elevation

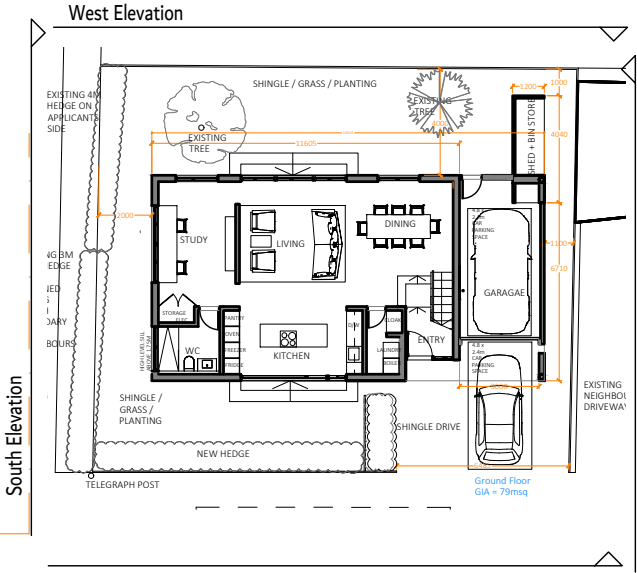

CURRENT 1:1000 YEAR  
EXTREME TIDAL FLOOD  
LEVEL FOR CICHESTER  
HARBOUR = 3.6 ADD.  
HBC STRATEGIC RISK  
ASSESMENT, SITE REF  
HY16 NAB CAR PARK,  
PAGE 27)

REV: A 04/02/2021 Reduced height by 200mm  
and bulk of rear first floor extension, original  
proposal shown in dotted red line  
REV: B 09/02/2021 Revised proposal added  
REV: C 31/03/2022 Additional Application

PLANNING

**RS**  
ARCHITECTURE

CLIENT:

PROJECT:  
**3 Nutbourne**

TITLE:  
Proposed South + West Elevations

DRAWING NUMBER : 008.C

Scale : 1:100 @ A3

DATE: 31/03/2022  
DRAWN BY: AS APPROVED BY: RS

194 Southwood Road, Hayling Island,  
Hampshire, PO11 9QL  
07887933281  
rob@rs-architecture.co.uk  
www.rs-architecture.co.uk