
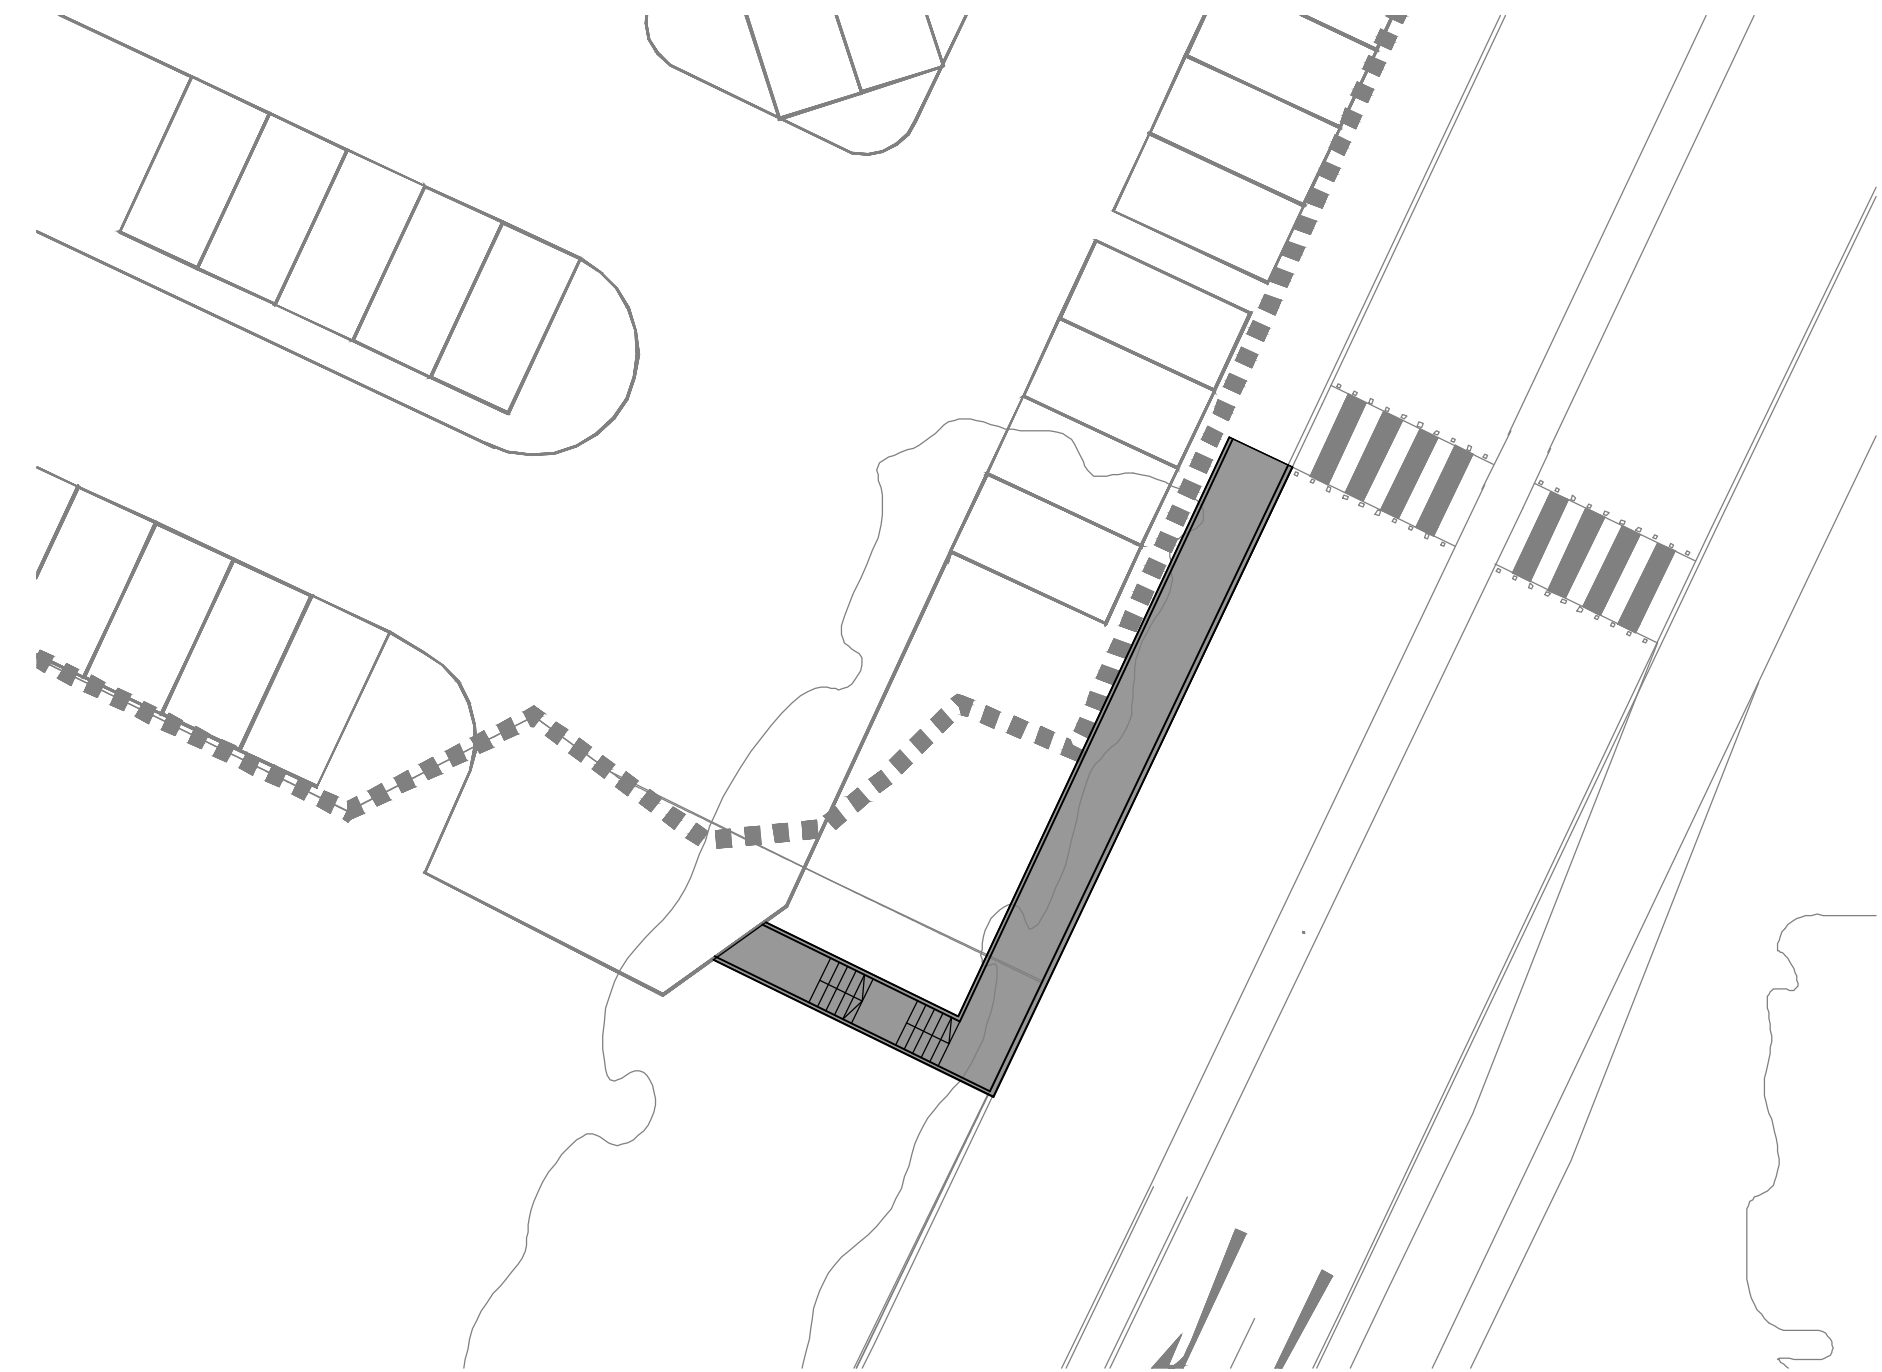


proposed no. carparking spaces - 24no.

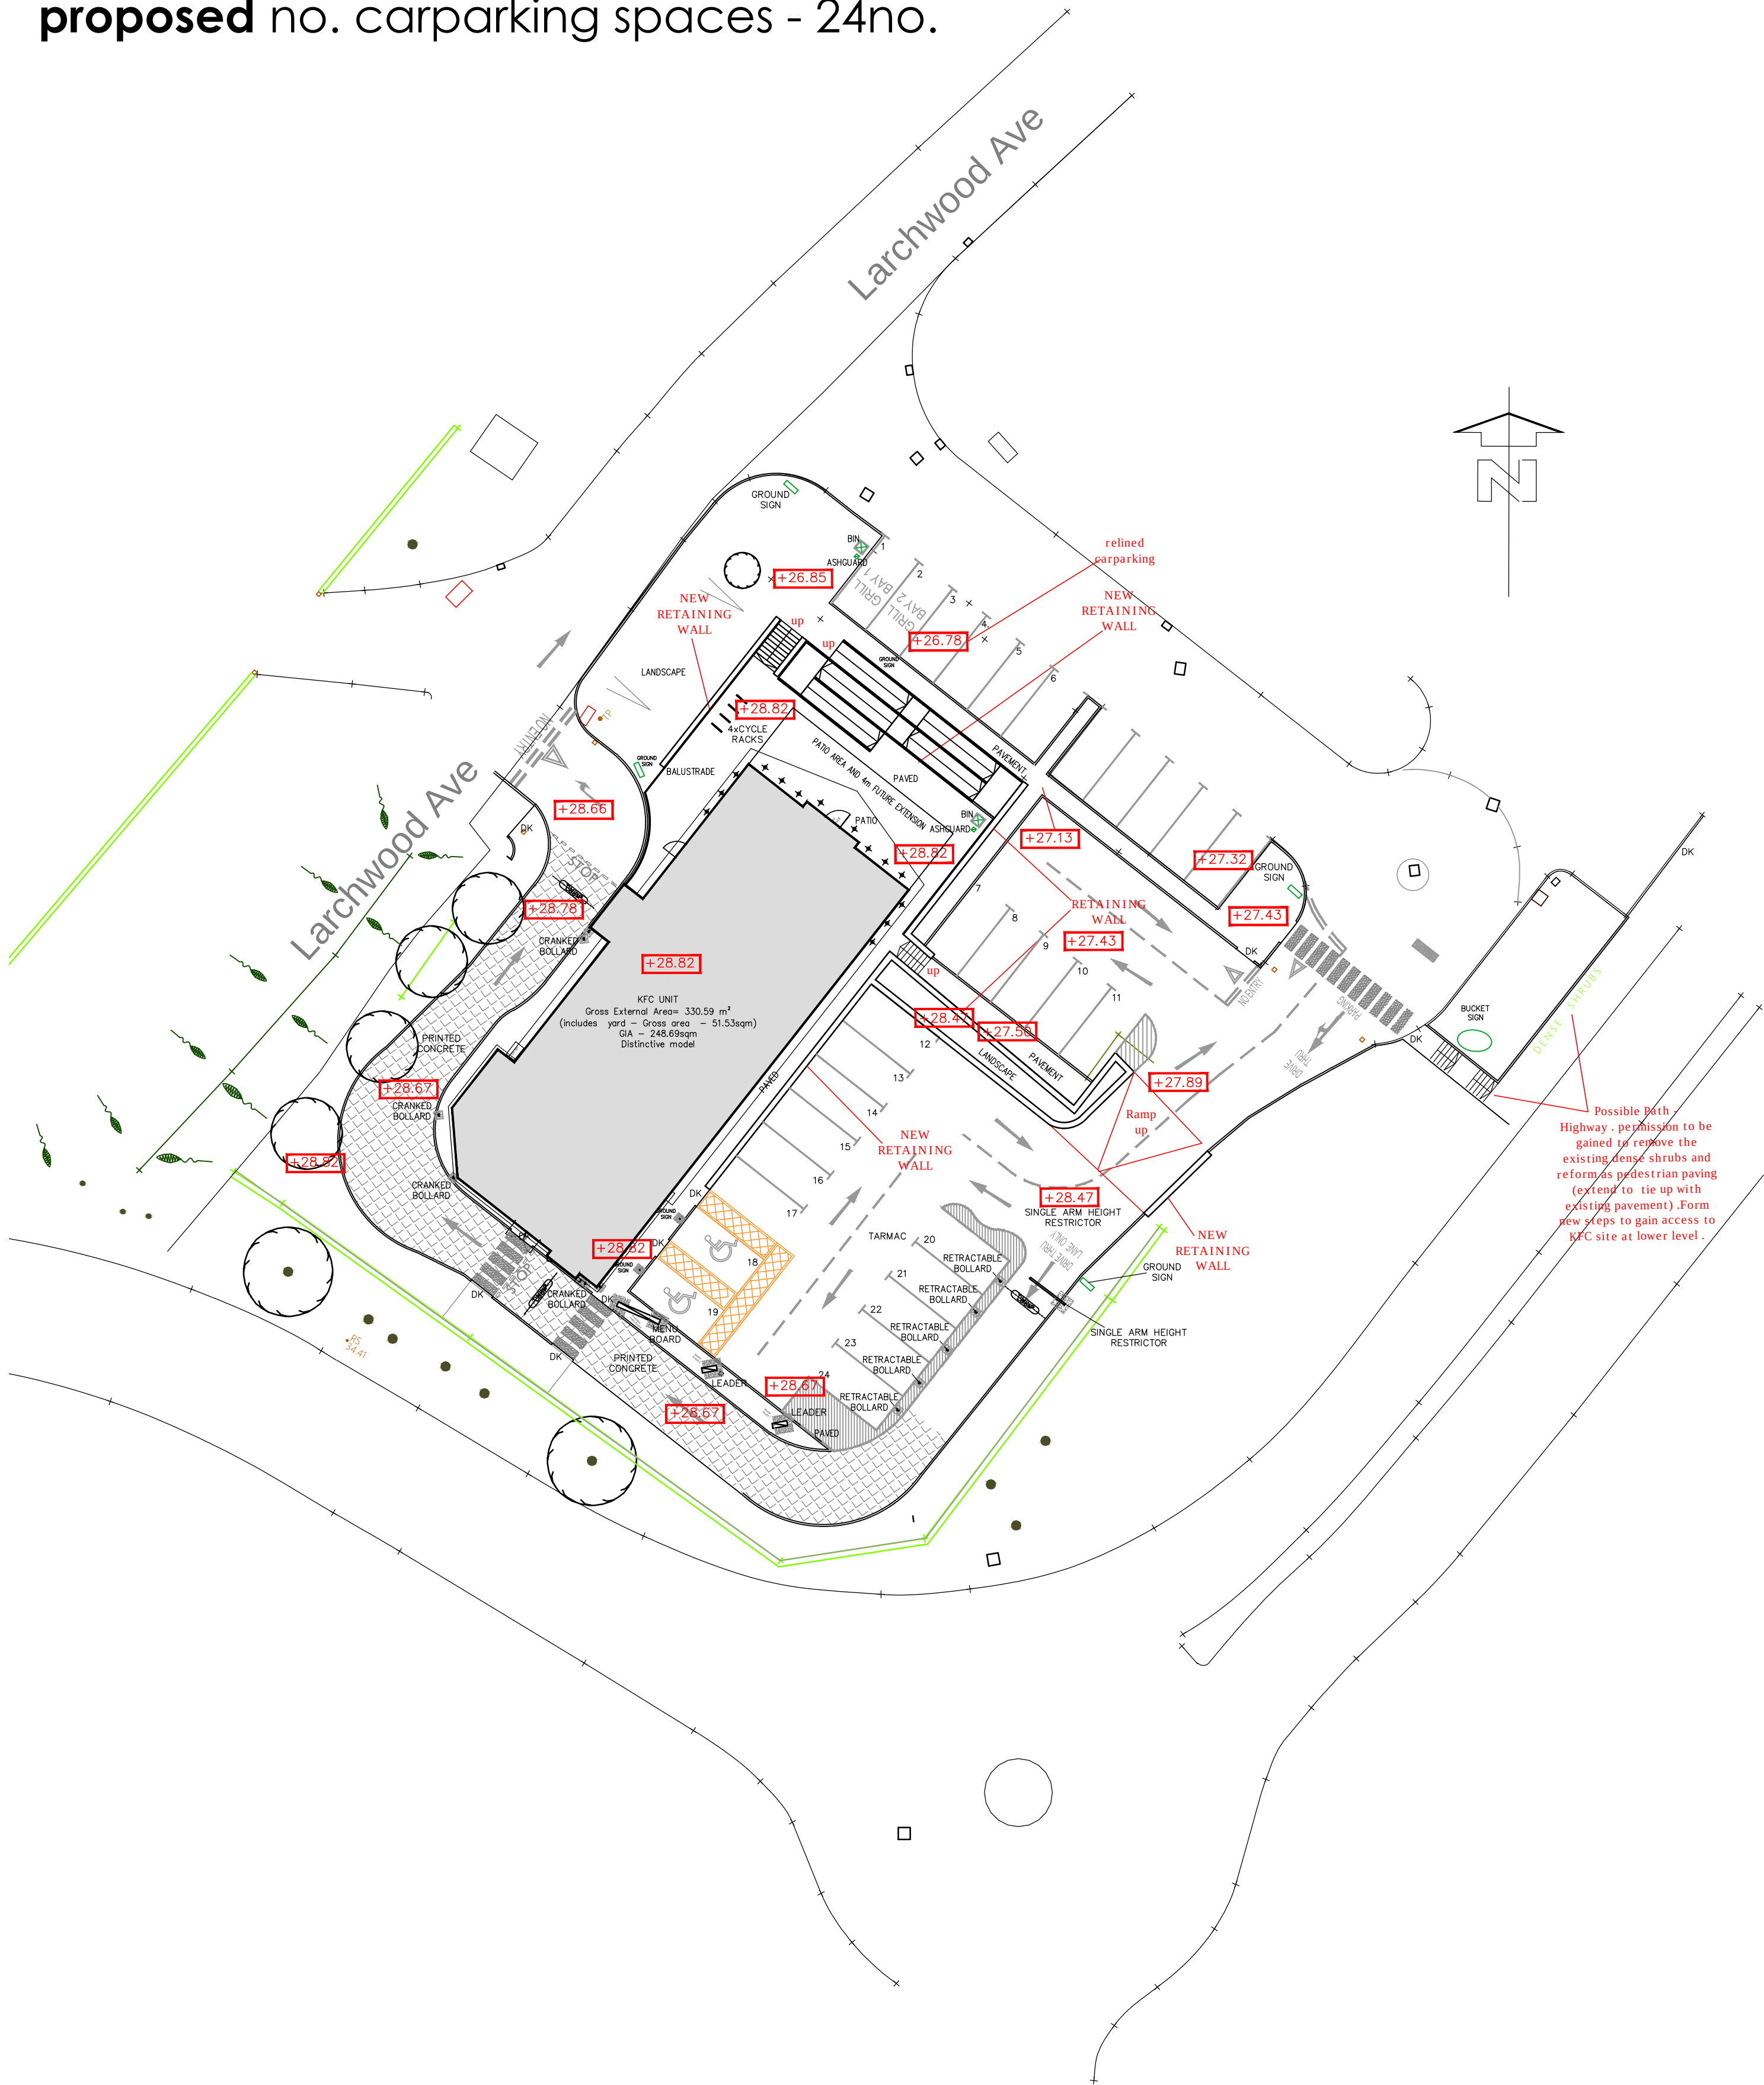


proposed new path from pedestrian access
scale - 1:250 @ A1 1:500 @ A3

proposed site plan scale - 1:250 @ A1 1:500 @ A3

SITE DESIGN SIGNOFF	
Name / Title	
Signature	Date

ALL DIMENSIONS TO BE CHECKED ON SITE.
DO NOT SCALE FROM THIS DRAWING EXCEPT FOR THE PURPOSES OF LOCAL AUTHORITY PLANNING

rev	date	description
H	14.07.16	Carparking space numbers corrected and levels added back as requested by LW (NS)
G	12.07.16	Site red line boundary and OS location plan omitted following comments from LW (NS)
F	08.07.16	Additional pedestrian crossing added to aid with access to the rear delivery doors. (NS)
E	23.06.16	DT lane widened for mini bus swept path (NS)
D	21.06.16	Site plan updated to allow for new pedestrian path(and associated clearing works) and omitting retaining wall to DT lane (NS)
C	06-06-16	Access ramp building and proposed path from McDonald's pedestrian access (ARS)
B	11-03-16	KFC updated to latest building and signage updated to suit(BF)
A	25-02-15	Clean version of approved Site Plan Ref: G213 rev D (SS)

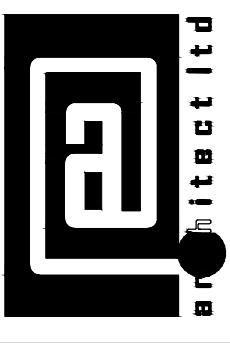

ripon house, suite 7
35 station lane
hornchurch
essex, rm12 6jl
tel.: 01708 477899
fax: 0709 223 4930
e.: office@architect.ltd.uk
web: www.architect.ltd.uk



NEW BUILD.

store address
KFC BEDHAMPTON

Larchwood Avenue
P09 3QW

drawing title
PROPOSED
Site Plan
for Planning

drawn by	checked	date
NS		JUN 2016
store no.	scale	
0000	1:250 / 1:200	

drawing no.	revision
0000/2011/B122/14-0062	H

PLANNING