
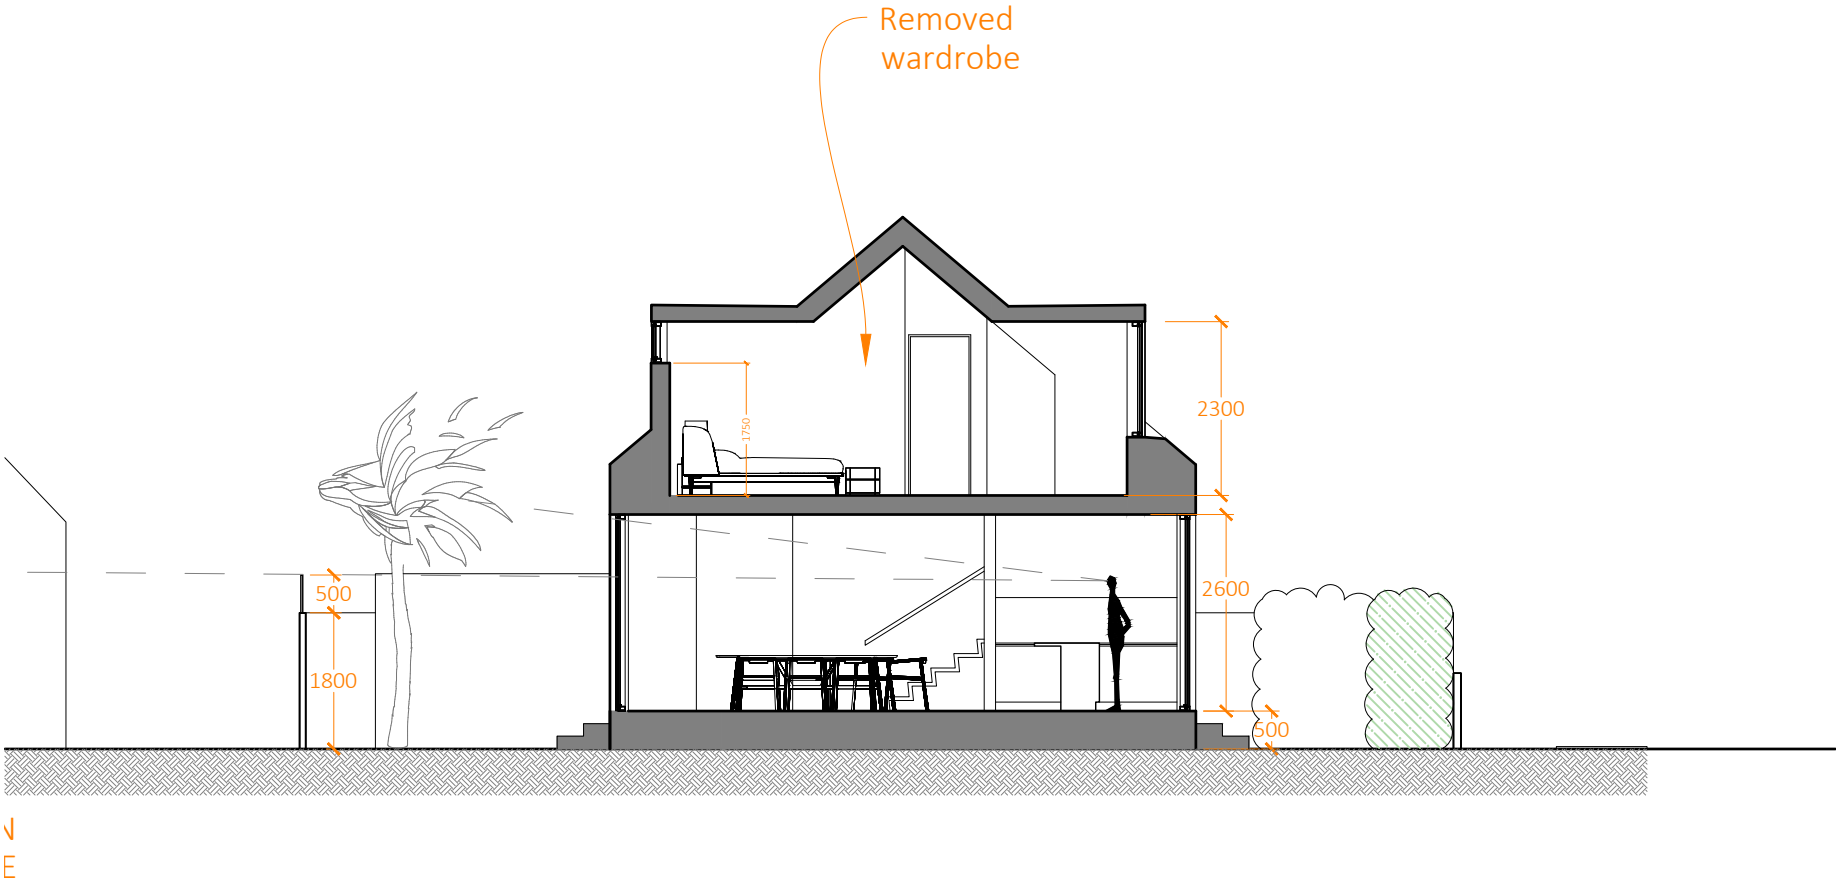
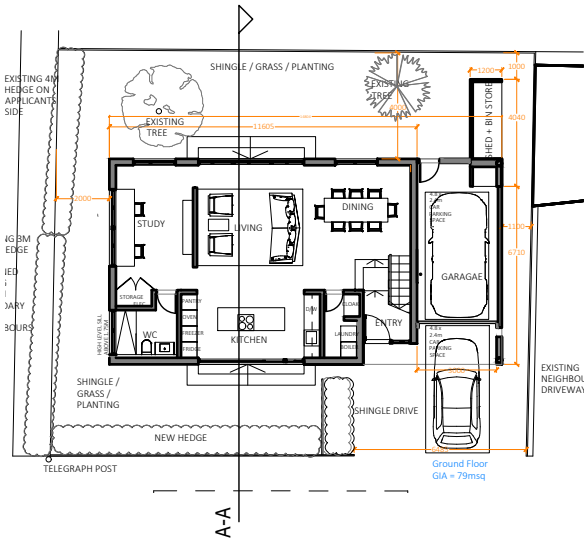
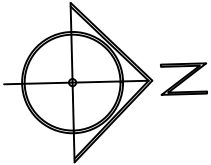


Proposed Section A-A

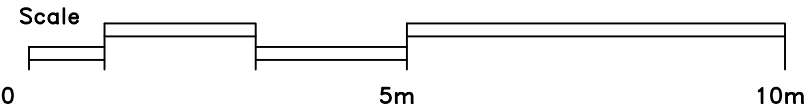

REV: A 04/02/2021 Reduced height by 200mm
and bulk of rear first floor extension, original
proposal shown in dotted red line
REV:B 31/03/2022 Additional Application

PLANNING

RS
ARCHITECTURE

CLIENT:

PROJECT:
3 Nutbourne

TITLE:
Proposed Section A-A

DRAWING NUMBER : 008.B

Scale : 1:100 @ A3

DATE: 31/03/2022
DRAWN BY: AS APPROVED BY: RS

194 Southwood Road, Hayling Island,
Hampshire, PO11 9QL
07887933281
rob@rs-architecture.co.uk
www.rs-architecture.co.uk