

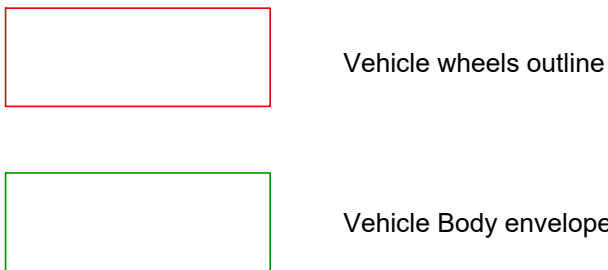




Tractor & Trailer	
Overall Length	16.423m
Overall Width	2.500m
Overall Body Height	2.713m
Min Body Ground Clearance	0.438m
Max Track Width	2.500m
Lock to lock time	4.00s
Kerb to Kerb Turning Radius	4.620m

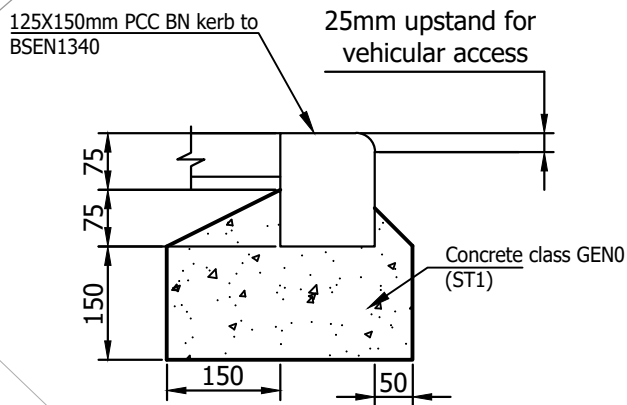

- GENERAL NOTES**
1. The location, size, depth and identification of existing services that may be shown or referred to on this drawing have been assessed from non intrusive observations , record drawings or the like. The contractor shall safely carry out intrusive investigations, trial holes or soundings prior to commencing work to satisfy himself that it is safe to proceed and that the assessments are accurate. any discrepancies shall be notified to gta prior to works commencing.
 2. Tender or billing drawings shall not be used for construction or the ordering of materials.
 3. Do not scale. All dimensions and levels to be site confirmed.
 4. This drawing shall be read in conjunction with all relevant architects, consultants drawings and specifications, together with H&S plan requirements
 5. Copyright : This drawing must not be copied, amended nor reproduced without the prior written agreement of gta.
 6. All drawings specifications and recommendations made by gta are subject to Local Authority and other relevant Statutory Authorities approval. Any works or services made abortive due to the client proceeding prior to these approvals is considered wholly at the Clients risk. gta hold no responsibility for resulting abortive works or costs.

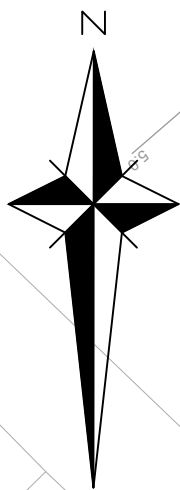

DROPPED BN KERB DETAIL

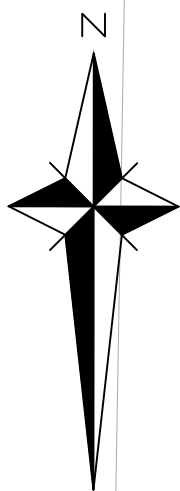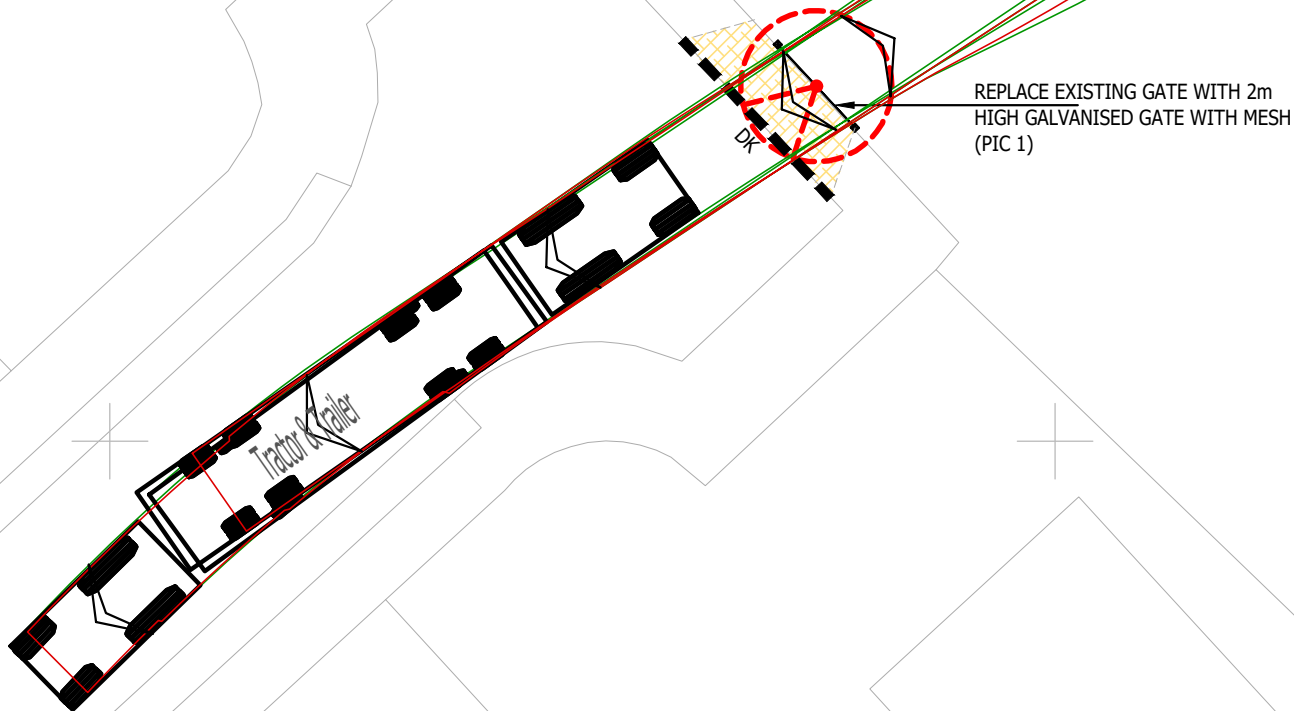

LEGEND

- TYPE 1 GRANULAR FILL 250mm DEEP
- 2m VISIBILITY SPLAY
- 25mm UPSTAND PCC BN DROPPED KERBS FOR VEHICLES

P5	TRACTOR AND TRAILER TRACKING SHOWN	26.01.22	MB	MW
P4	EXISTING GATE MOVED	13.12.21	KW	MW
P3	KISSING GATE REMOVED	06.12.21	KW	MW
P2	GATE REVISED	29.11.21	KW	MW
P1	INITIAL ISSUE	26.11.21	KW	MW

Rev	Amendments	Date	Dsn	Chk
-----	------------	------	-----	-----

Status **PLANNING**

Client **BARRATT HOMES**

Architect

Project **PEBBLE WALK, SINAH LANE
HAYLING ISLAND, HANTS**

Title **TEMPORARY ACCESS
PLANNING LAYOUT**

Date **NOVEMBER 2021** Scale @ A2 **1:200**

Clients Ref. **10162**



Gloucester House, 66a Church Walk,
Burgess Hill, West Sussex, RH15 9AS
Tel.01444 871444 Web: www.gtacivils.co.uk

Drawing Number **10162/103** Rev. **P5**