


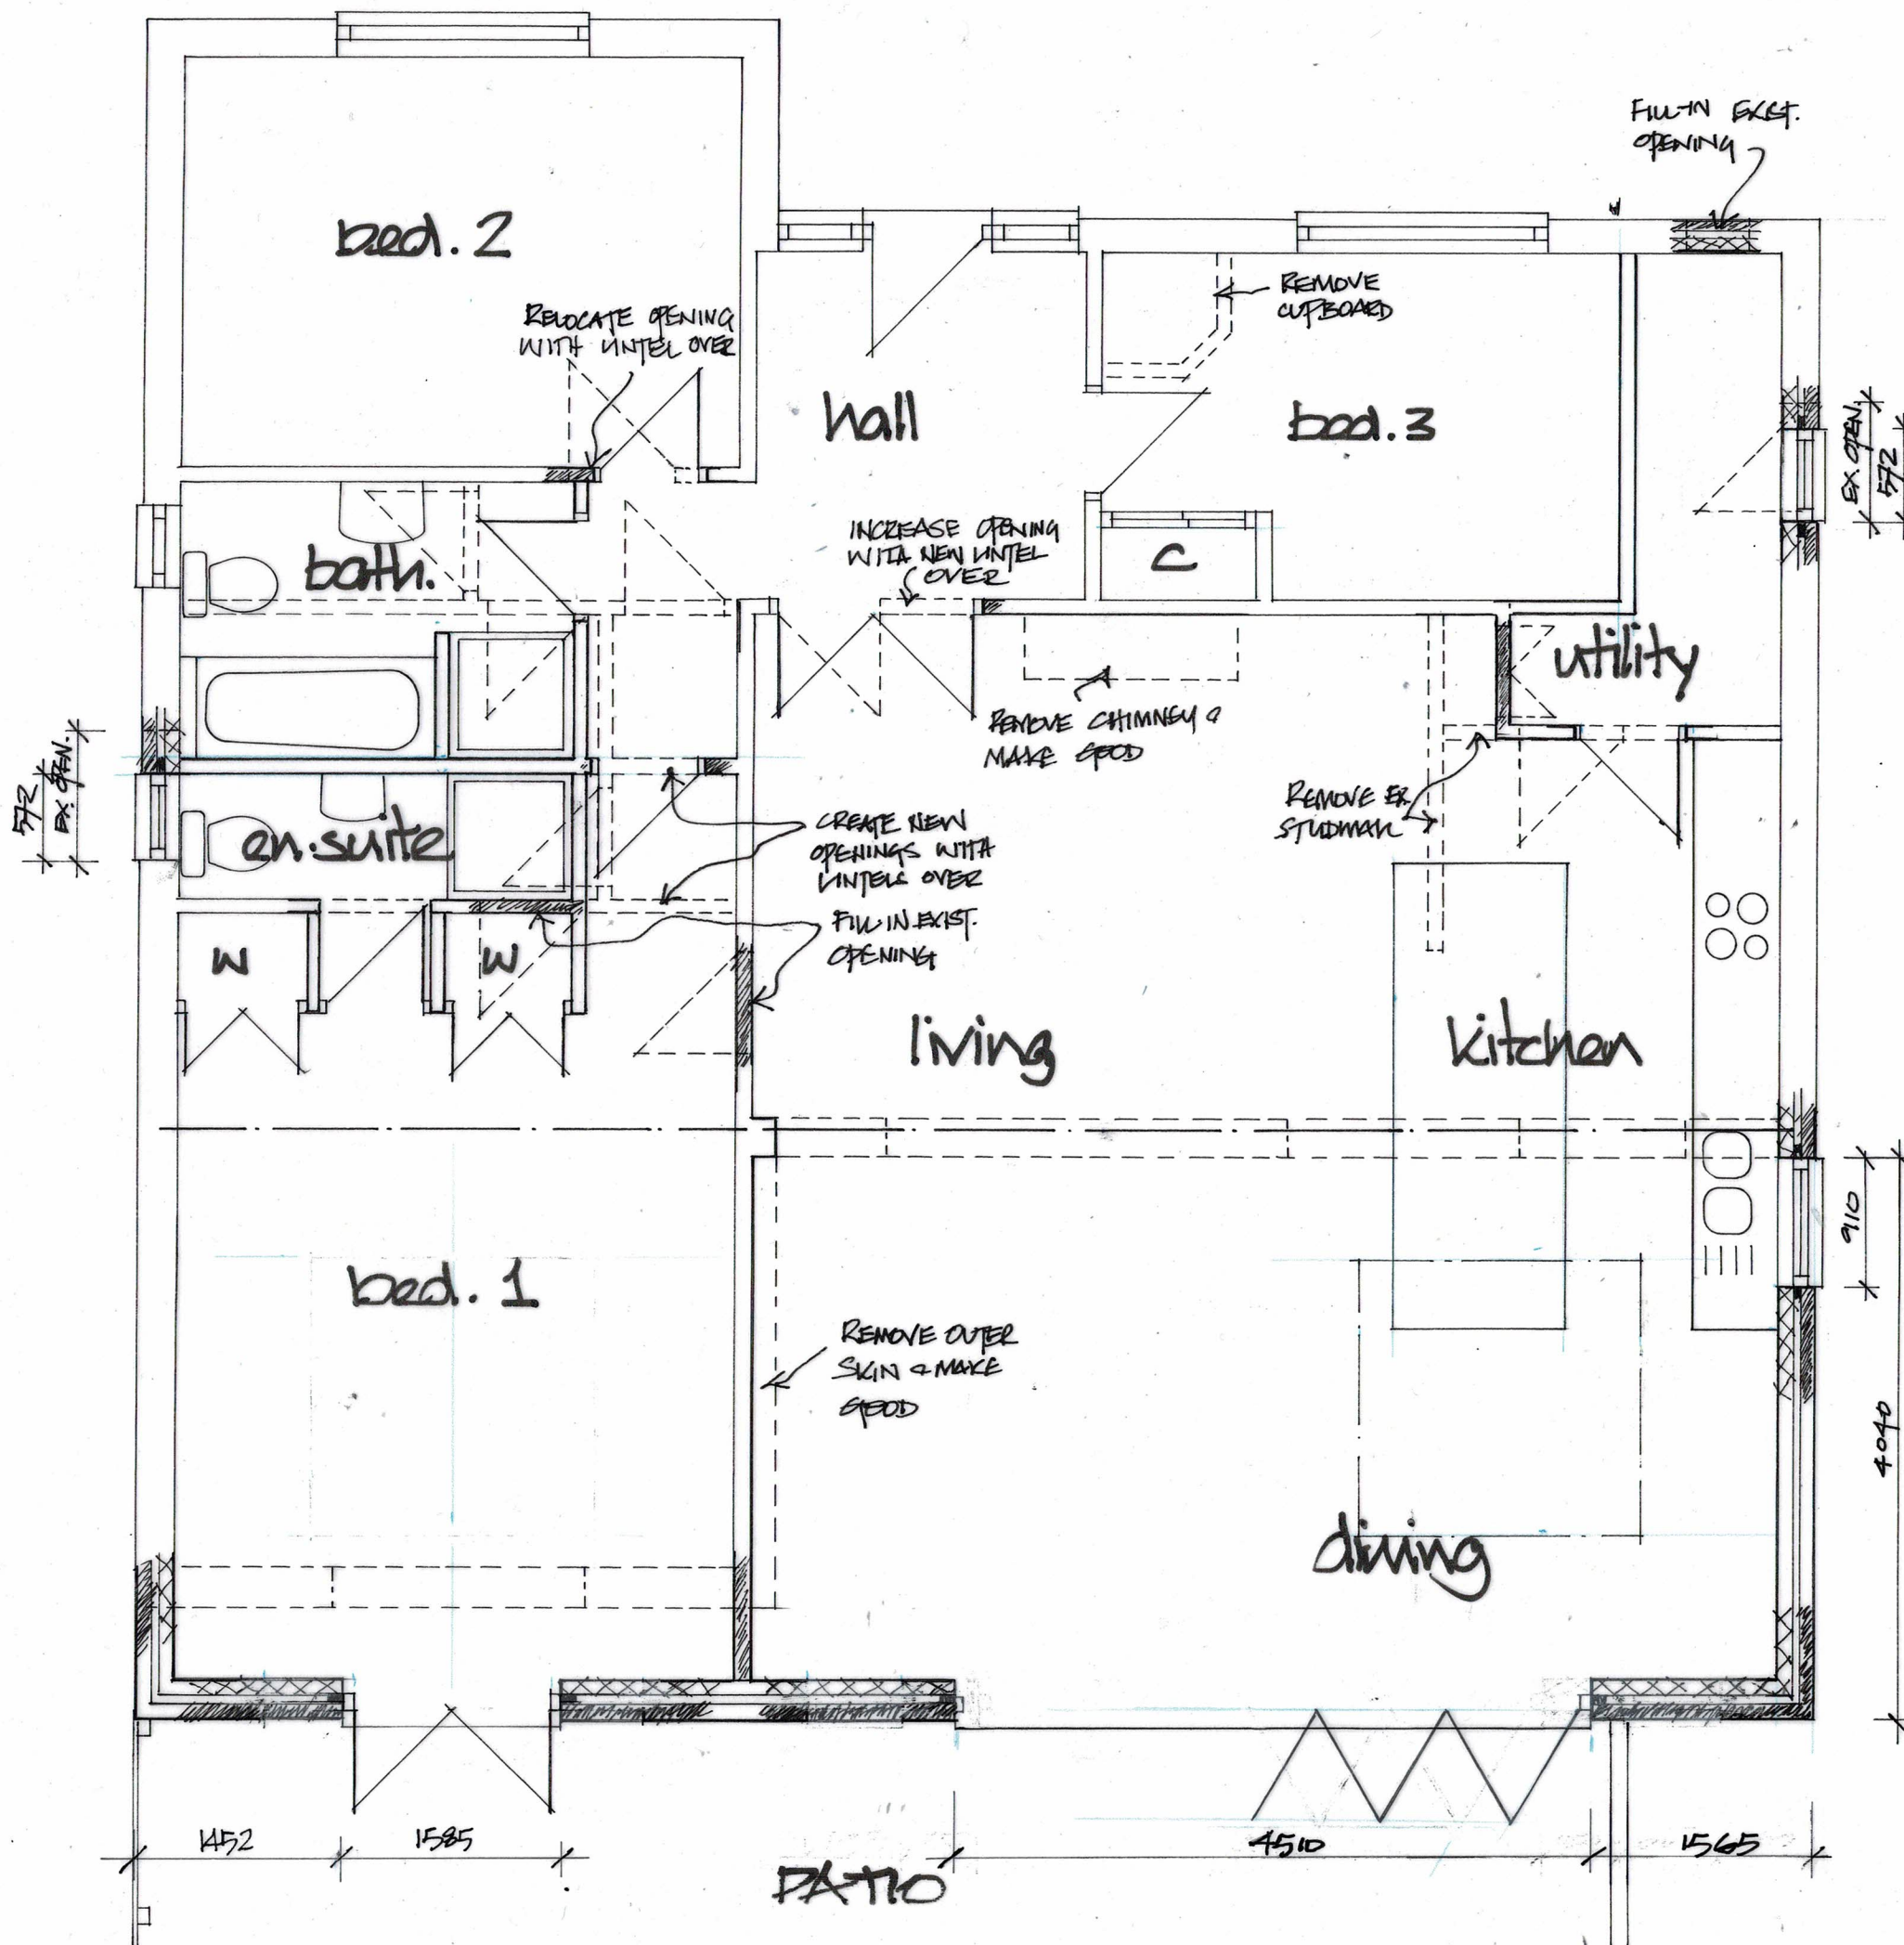

A		SEPT 21 AS BUILT REVISIONS	ST
DEREK TREAGUS ASSOCIATES ARCHITECTURAL SERVICES Tel: 07956 624094 Email: derek.treagus@gmail.com			
Project	REAR EXTENSION AT 8 WARFIELD CRESCENT, WATERLOOVILLE, HAMPSHIRE.		
Client	Mr & Mrs Lovell		
Subject	Building Regs Drawing Proposed Floor Plan		
Date:	Oct 2020	Scale:	1:50 @ A3
Rev:	A	Drg. No.	20/935/01
- Copyright reserved. - All dimensions are to be site confirmed and should not be scaled unless for Planning purposes. - Verify all queries with the office.			