




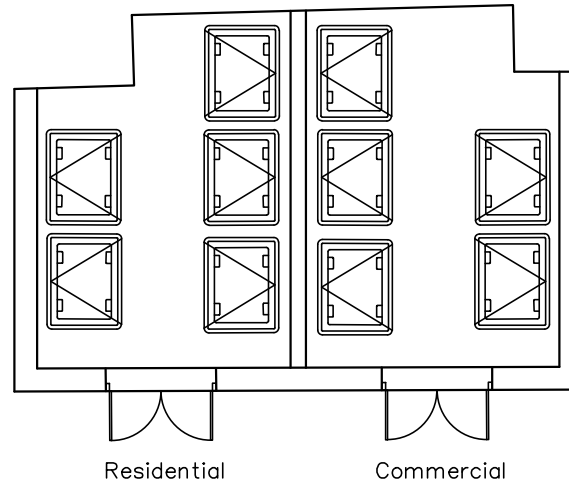


As Built Plan

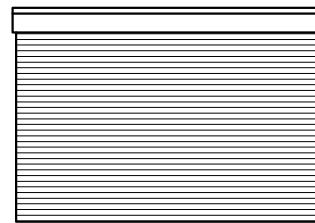

South &
North

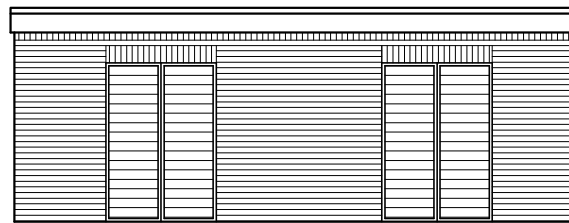

West

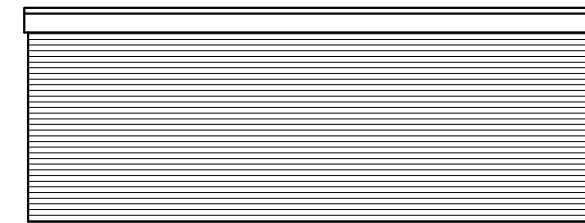

East

As Built Elevations



Critchley Architecture And Design Ltd.
Contact: 02392 474 919 | info@caad.online
The Old Brewery, 15E South Street, Havant, PO9 1BU

As Built Bin Store Drawings

Revisions	Note/Date/Initial
a)	
b)	
c)	
d)	

Sussex House,
44-54
West St,
Havant,
PO9 1PG

Scale A1=1:50, A3=1:100
Drawn SAR
Date 10/01/2022

19055-554⁰

10m

20m

30m

40m