
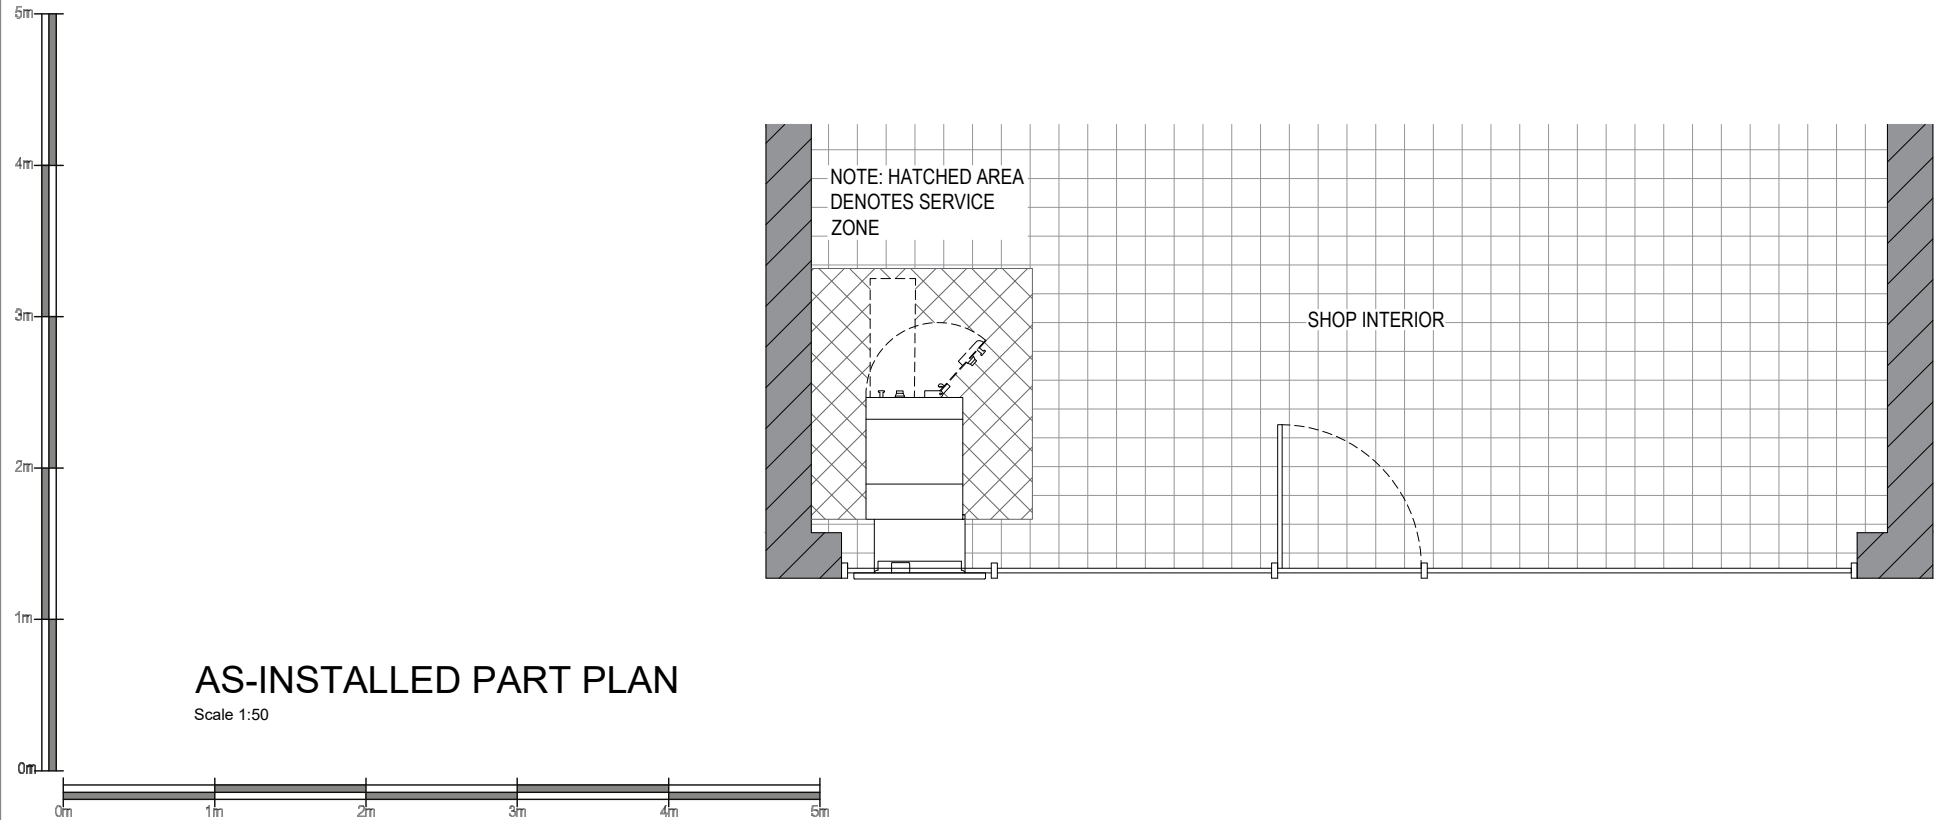


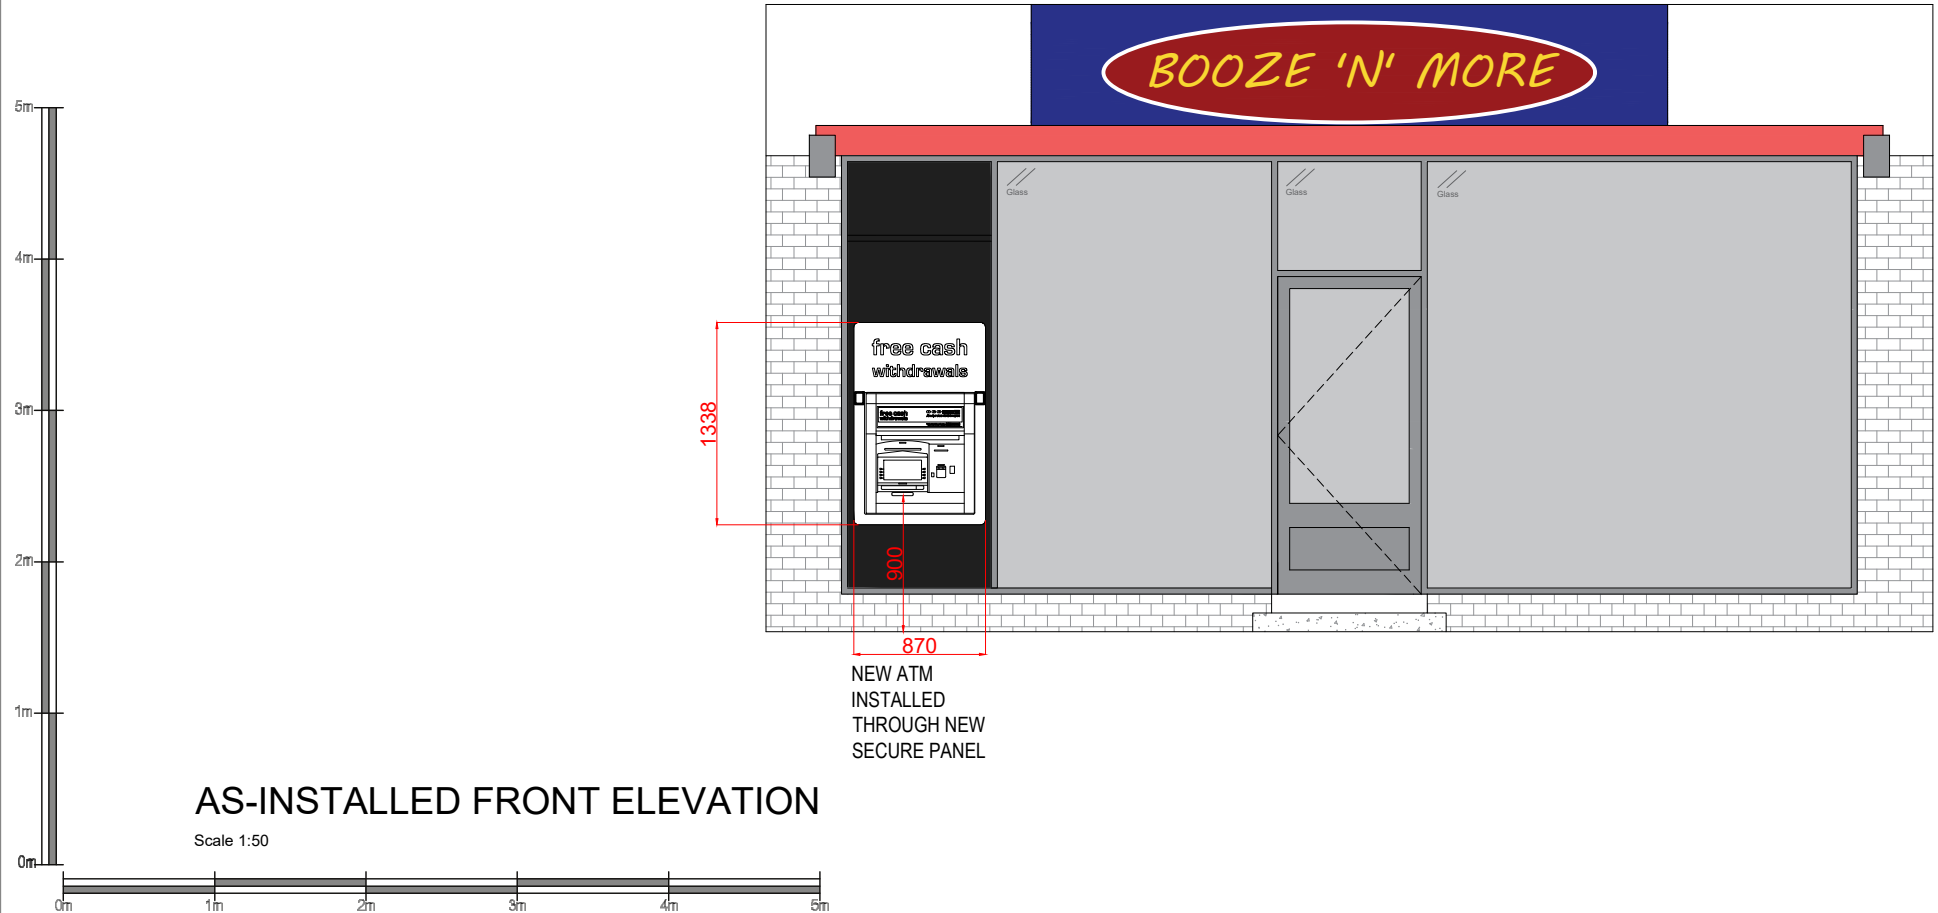

Date: Comments: By:

GENERAL NOTES:
1) All dimensions in millimeters unless otherwise stated.

Site:
Grande Wines (Londis),
98 Bedhampton Road,
Havant,
PO9 3EZ

Drawing Title:
As-Installed Plan and Elevation

Ref: T020574_AI	Date: 03/09/2021	Rev:
Scale: 1:50	Paper: A3	Date Rev: