



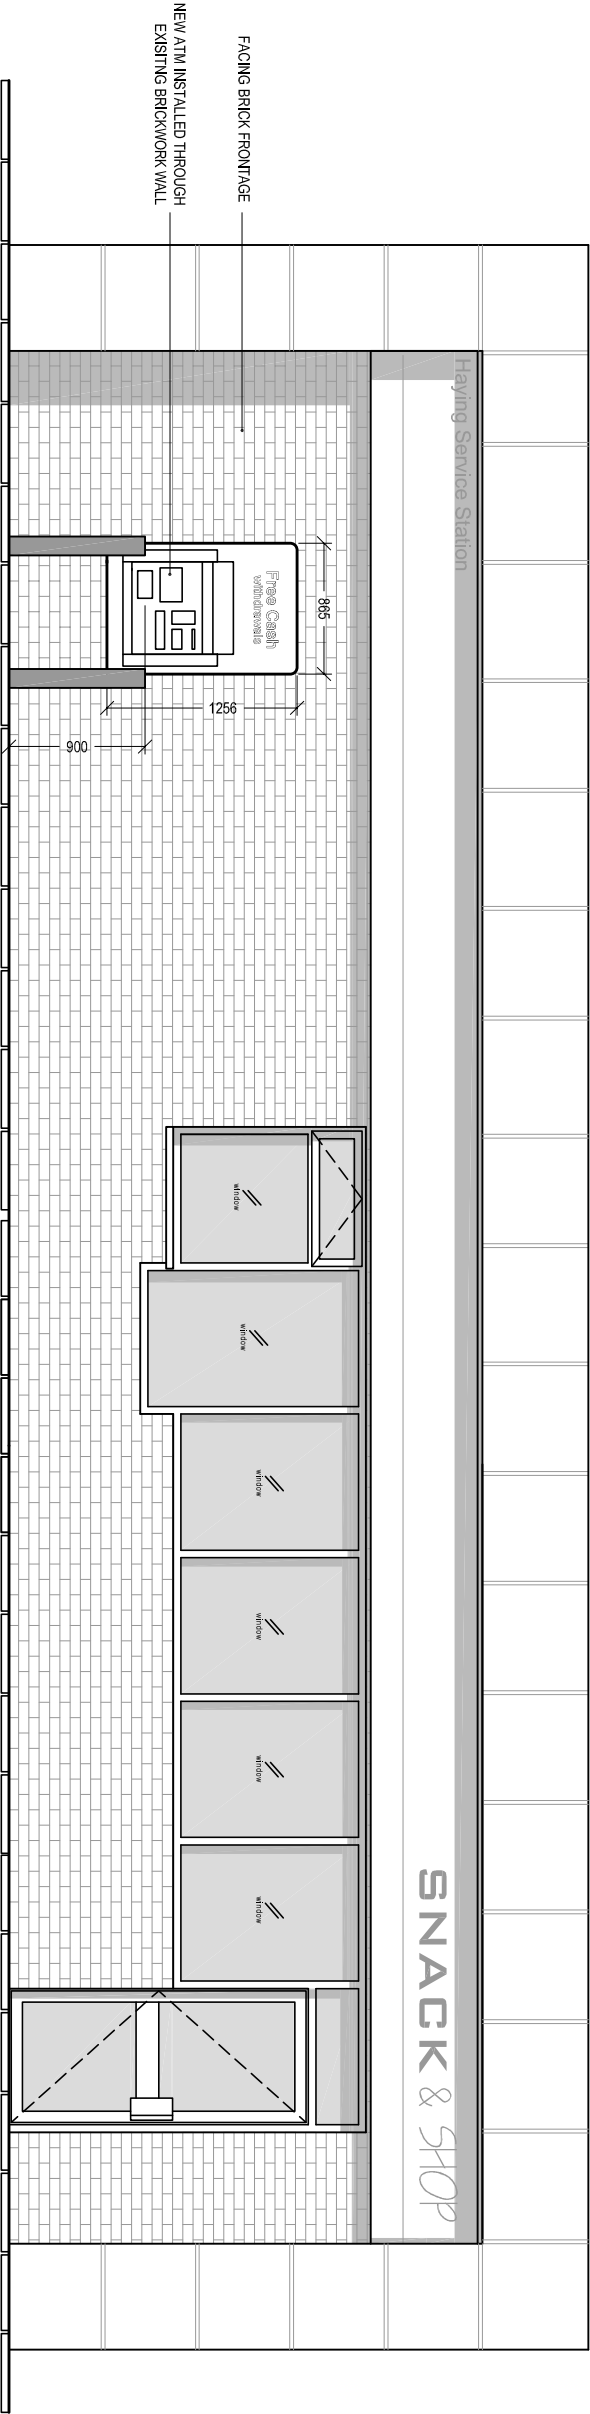

AS INSTALLED FRONT ELEVATION

Scale 1:50

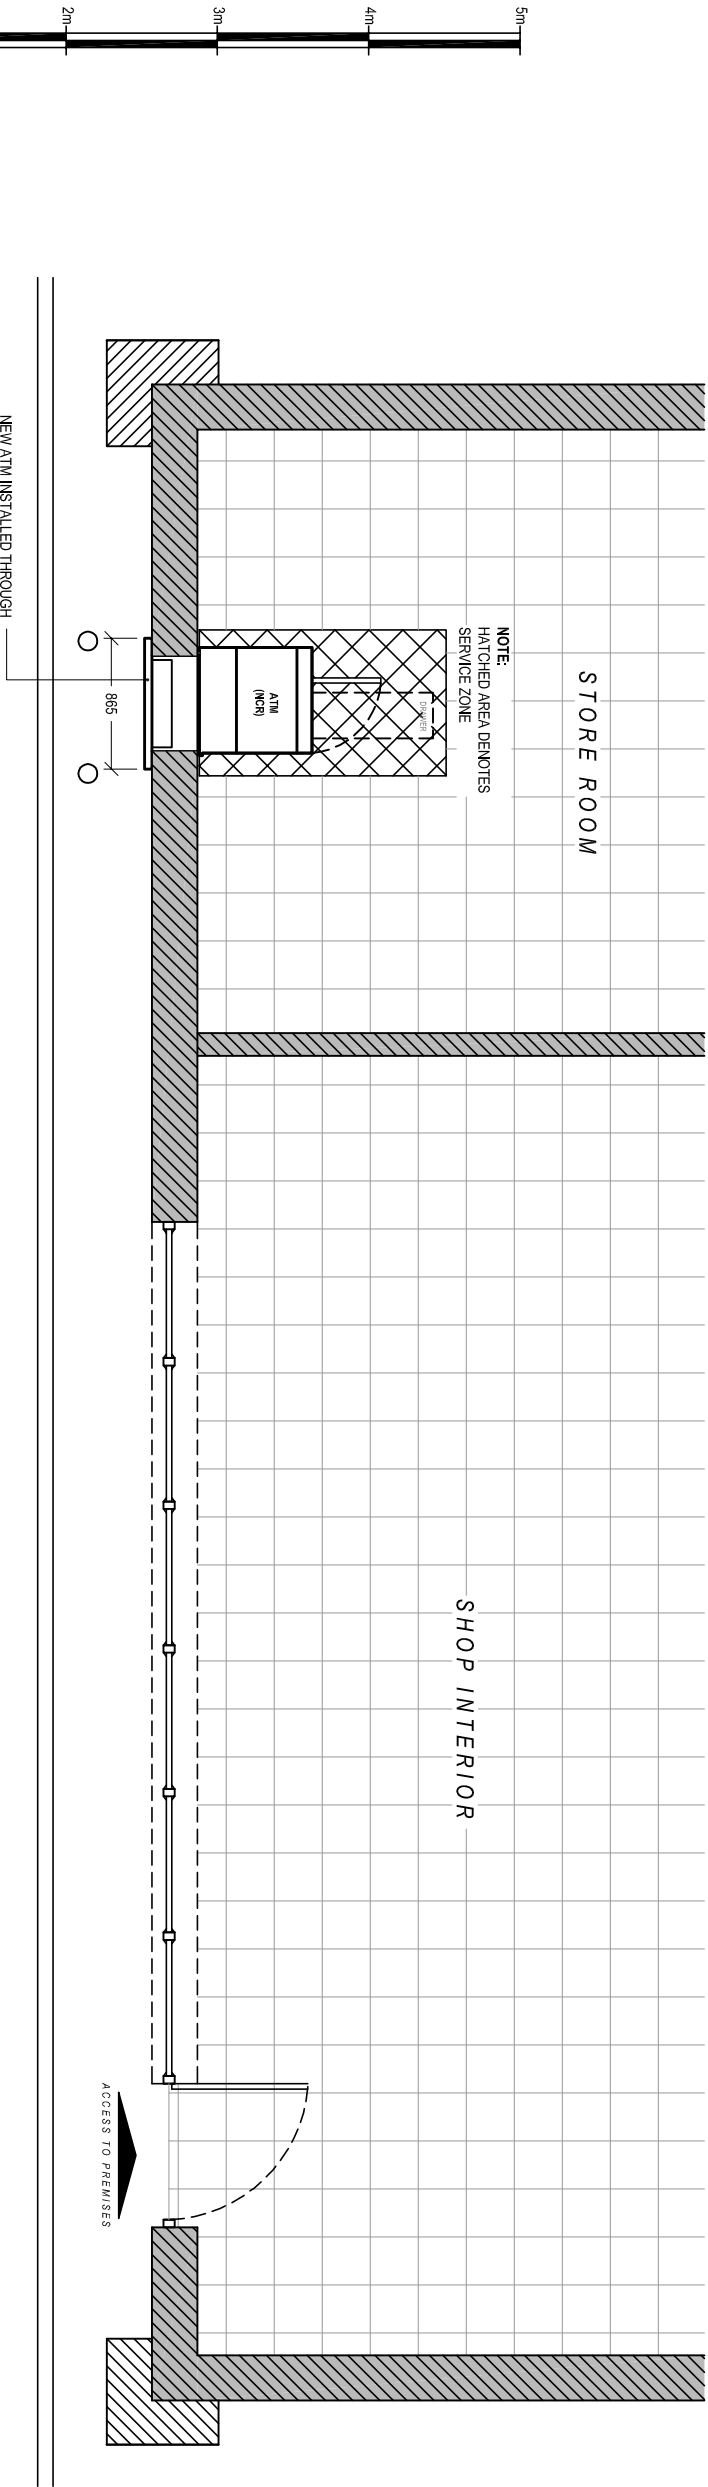

AS INSTALLED PART PLAN

Scale 1:50



GENERAL NOTES:			
1) All dimensions in millimeters unless otherwise stated.			
Site:			
EURO GARAGE - HAYLING (ISLAND)			
181-183 Havant Road			
Hayling Island			
PO11 0LG			
Drawing Title:			
As Installed Elevations and Plans			
Ref:	Date:	Rev:	
NM-04-2016-74-2	14-04-2016		
Scale:	Paper:	Date Rev:	
1:50	A3		