




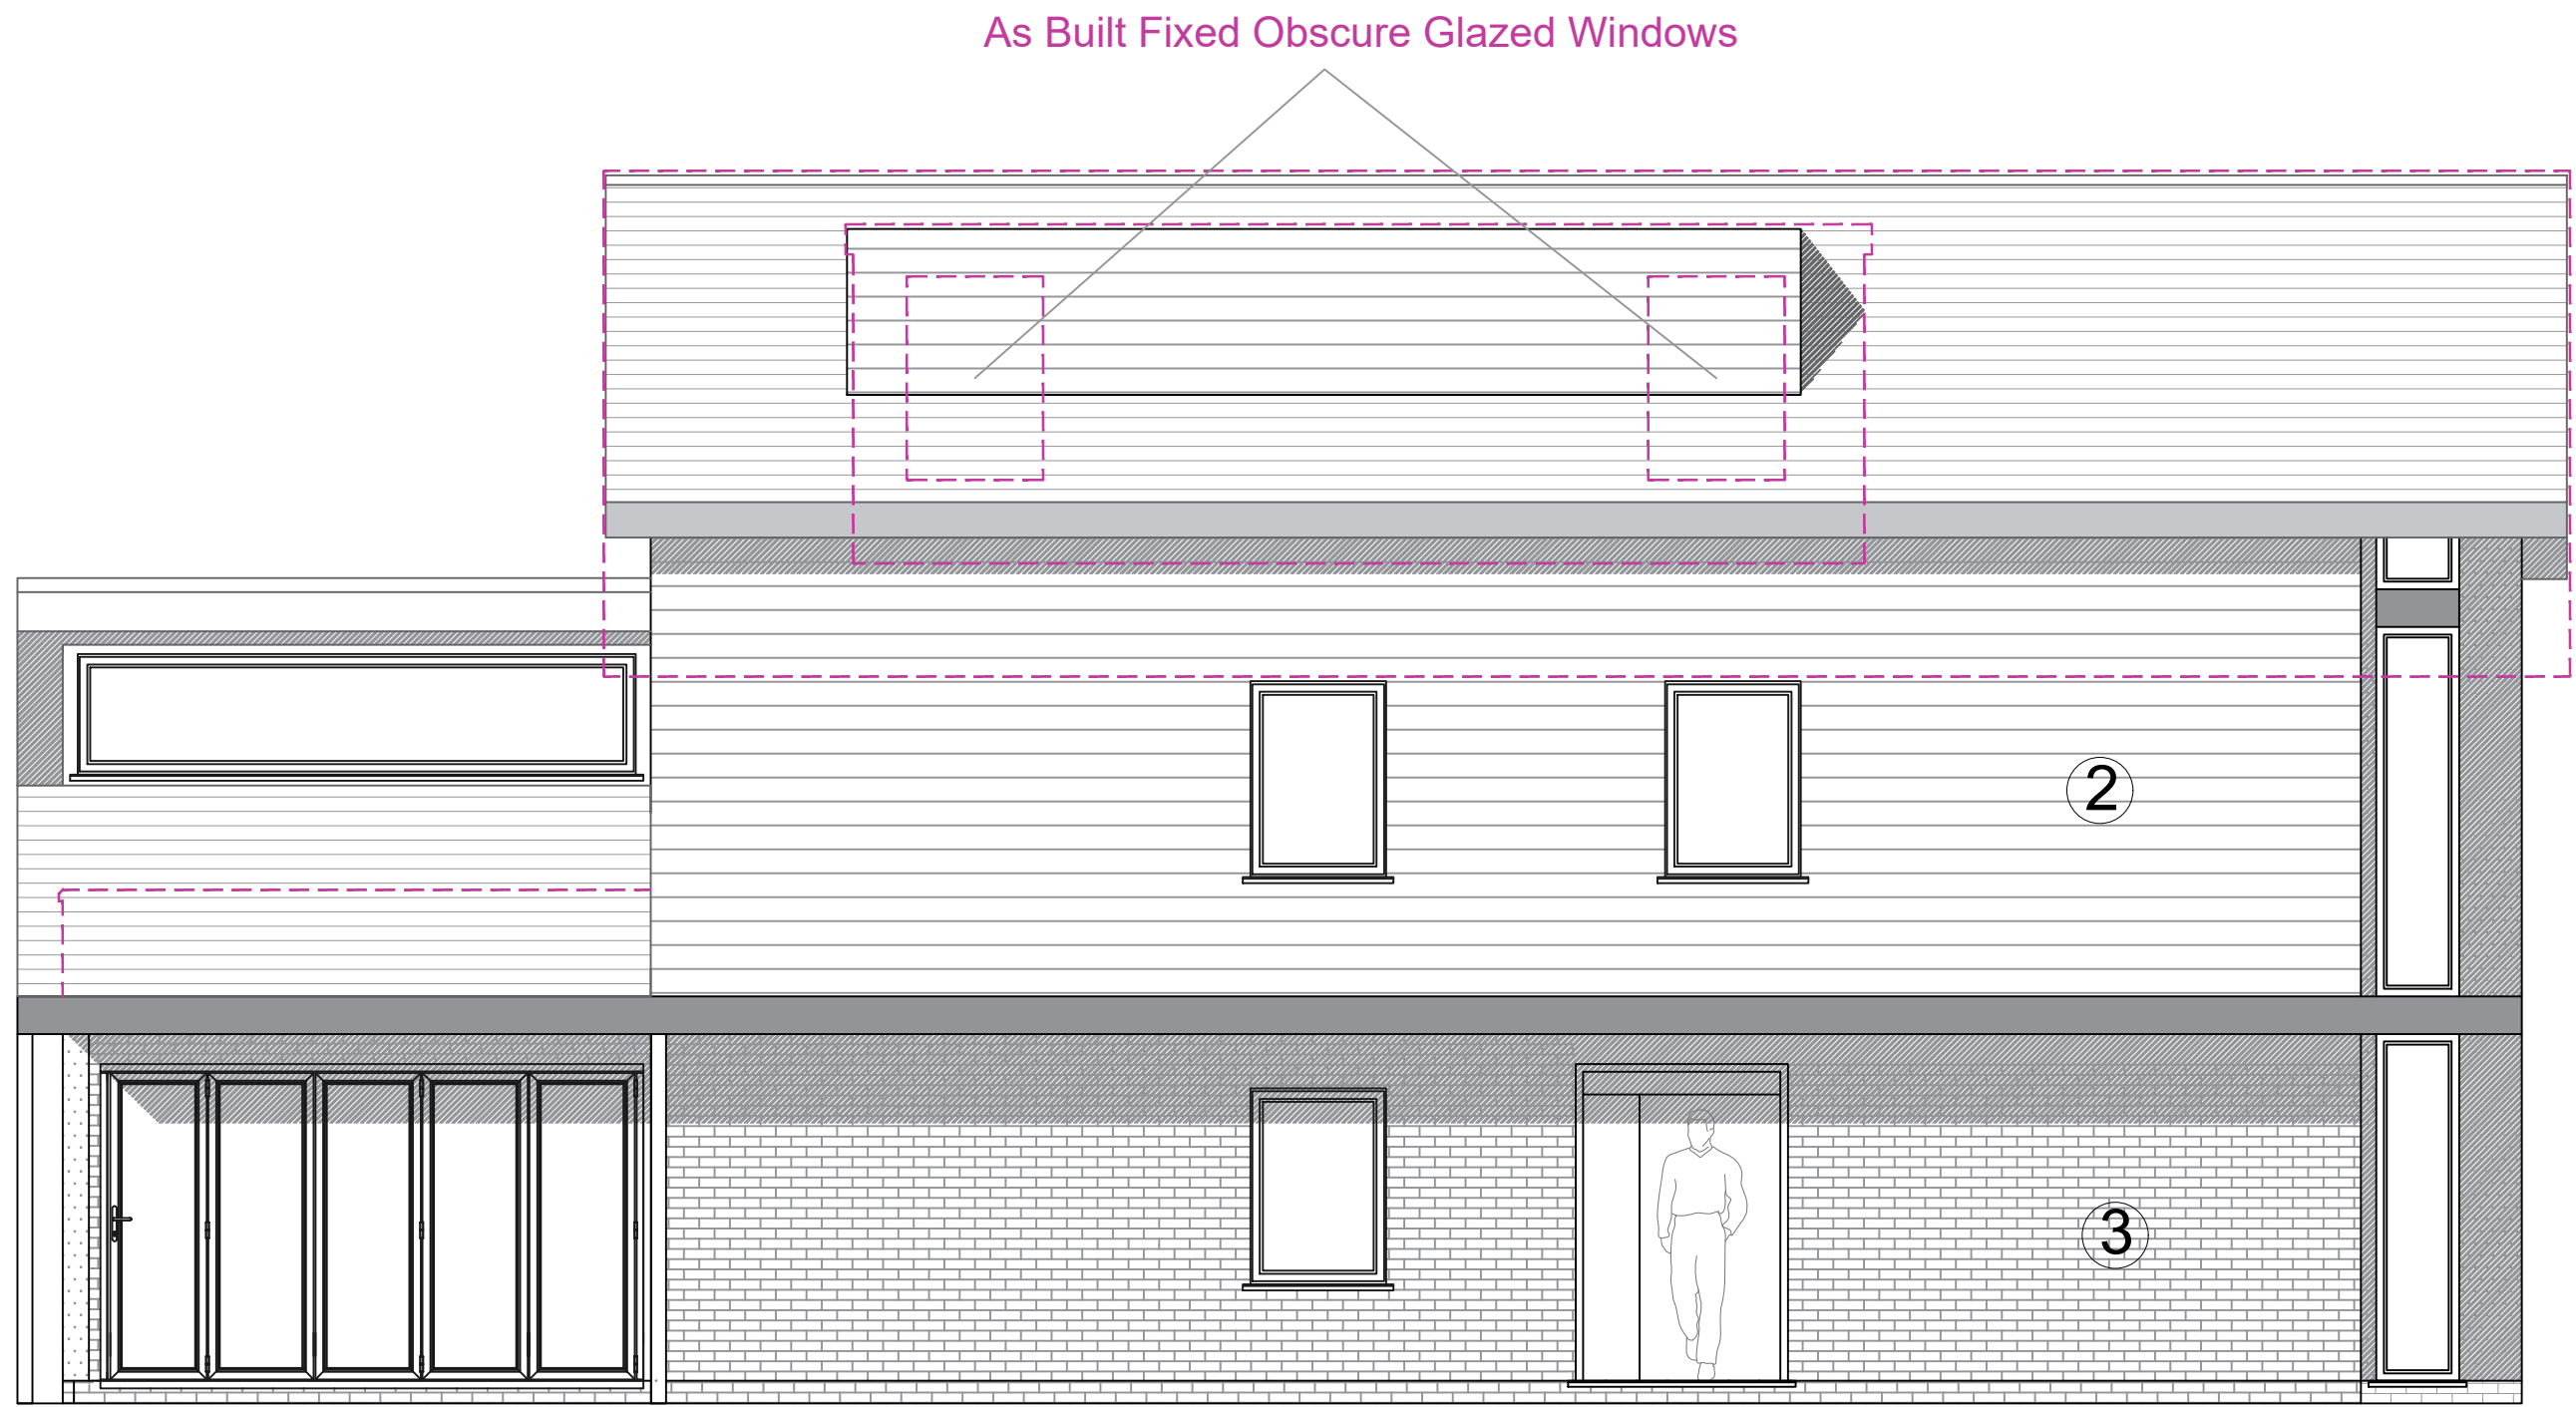


Proposed North East Elevation @ 1:50

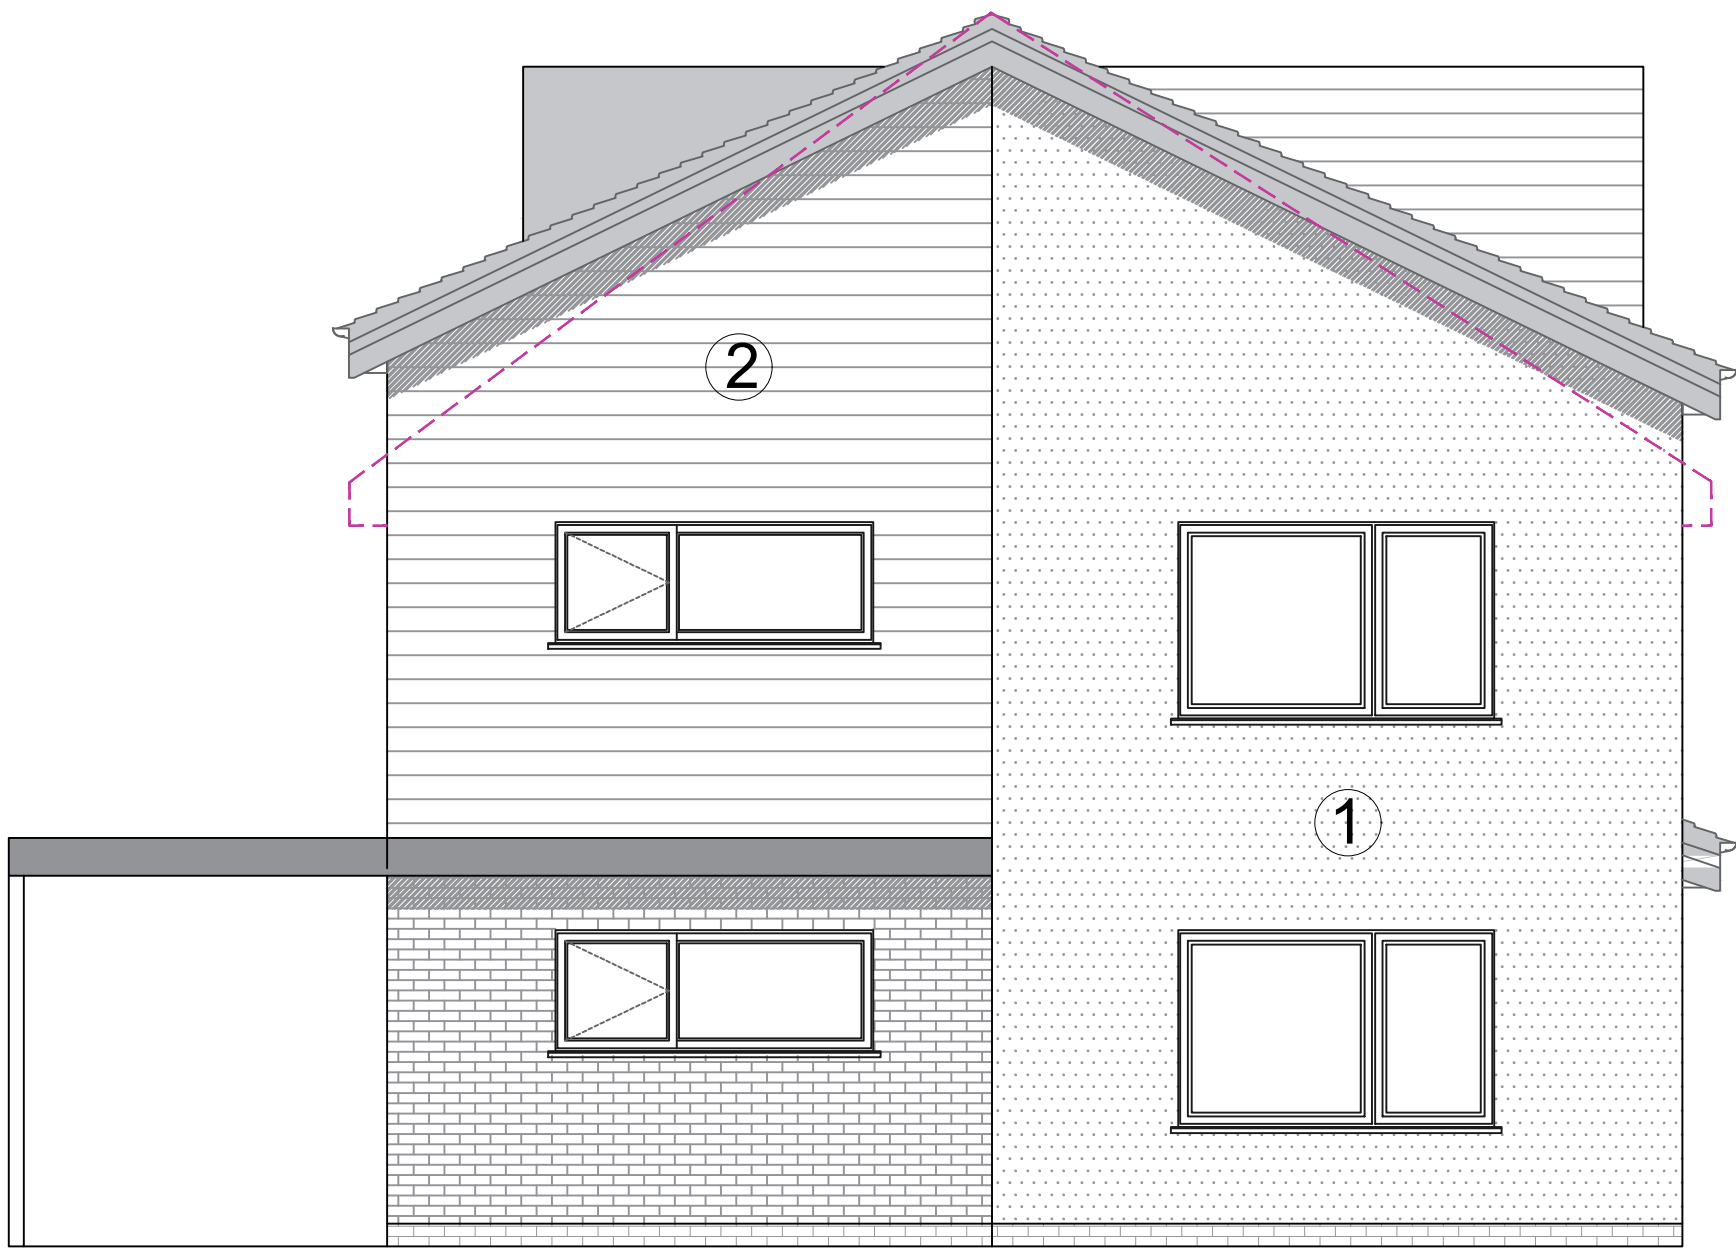

Proposed North West Elevation @ 1:50

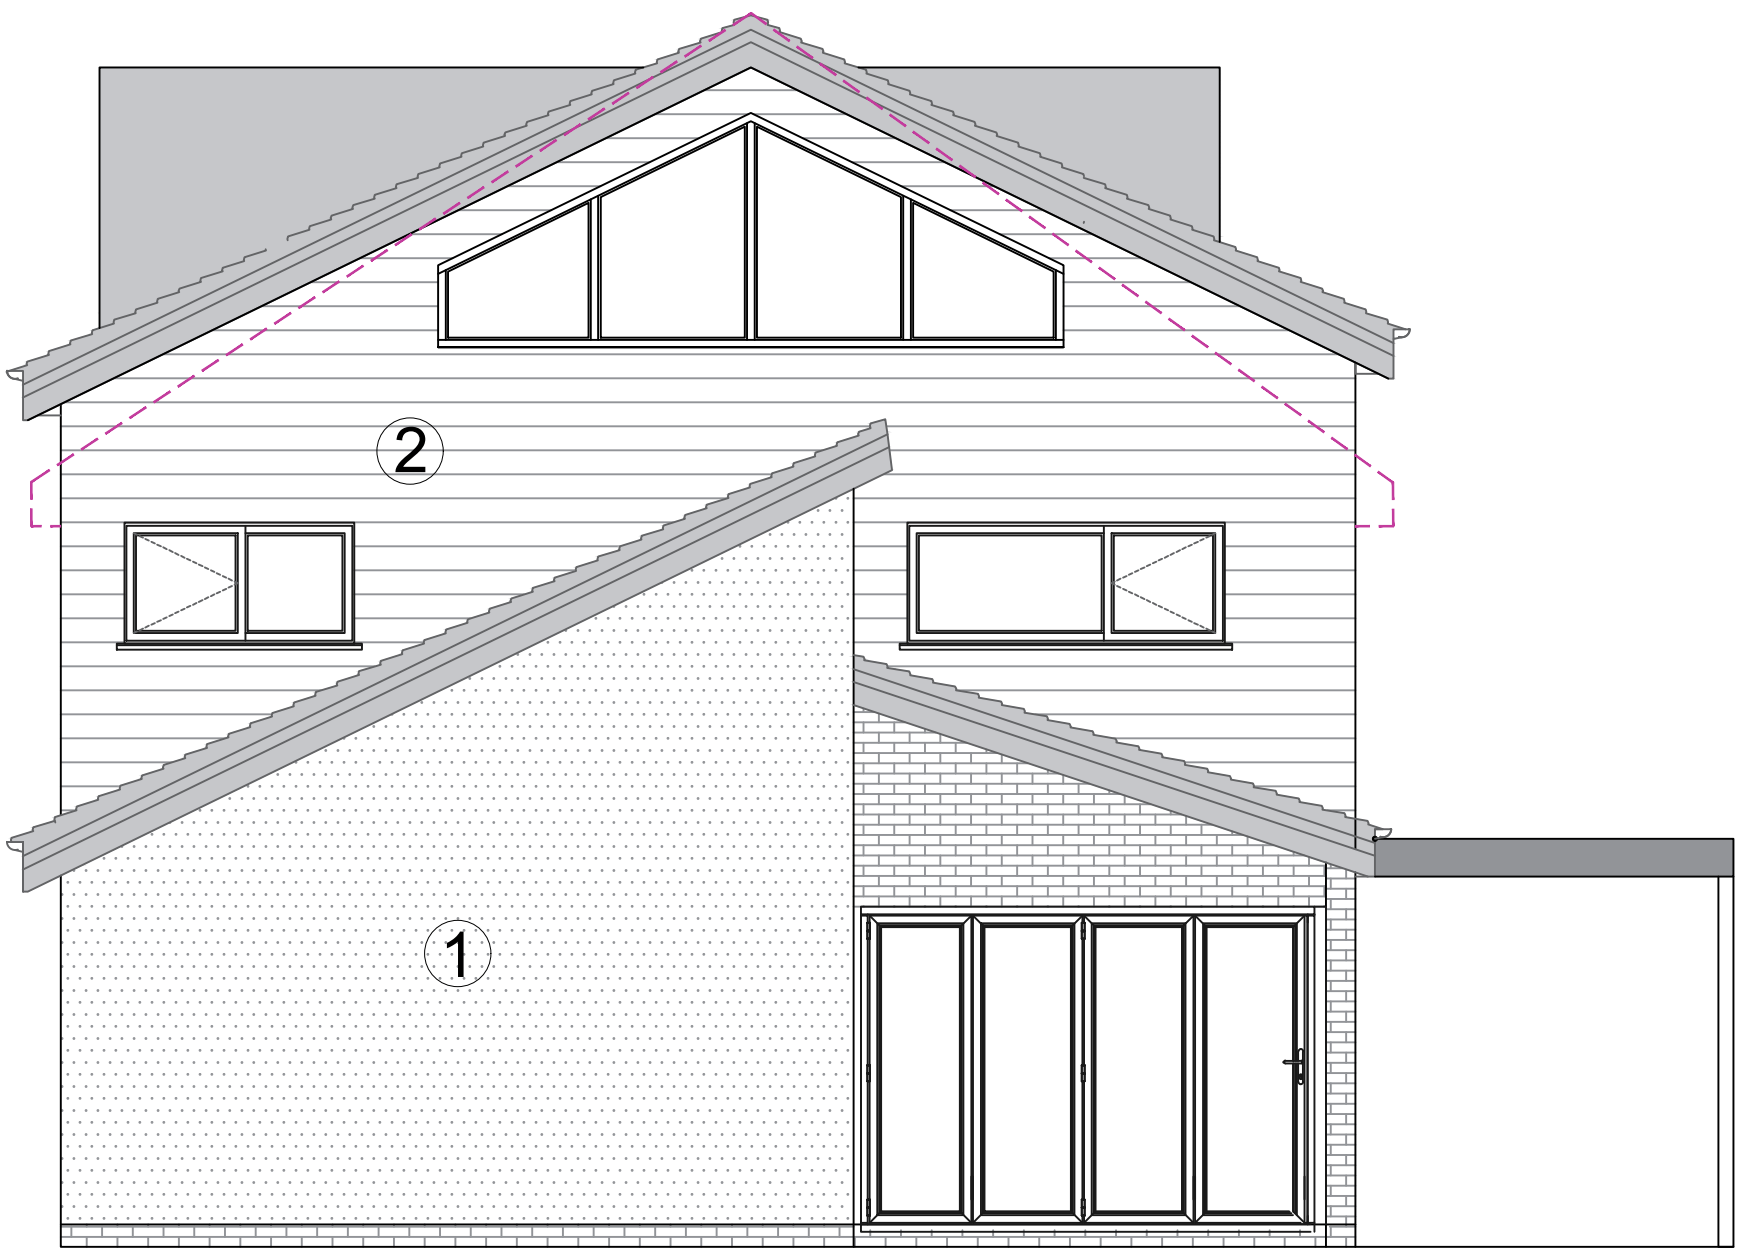

South East Elevation @ 1:50

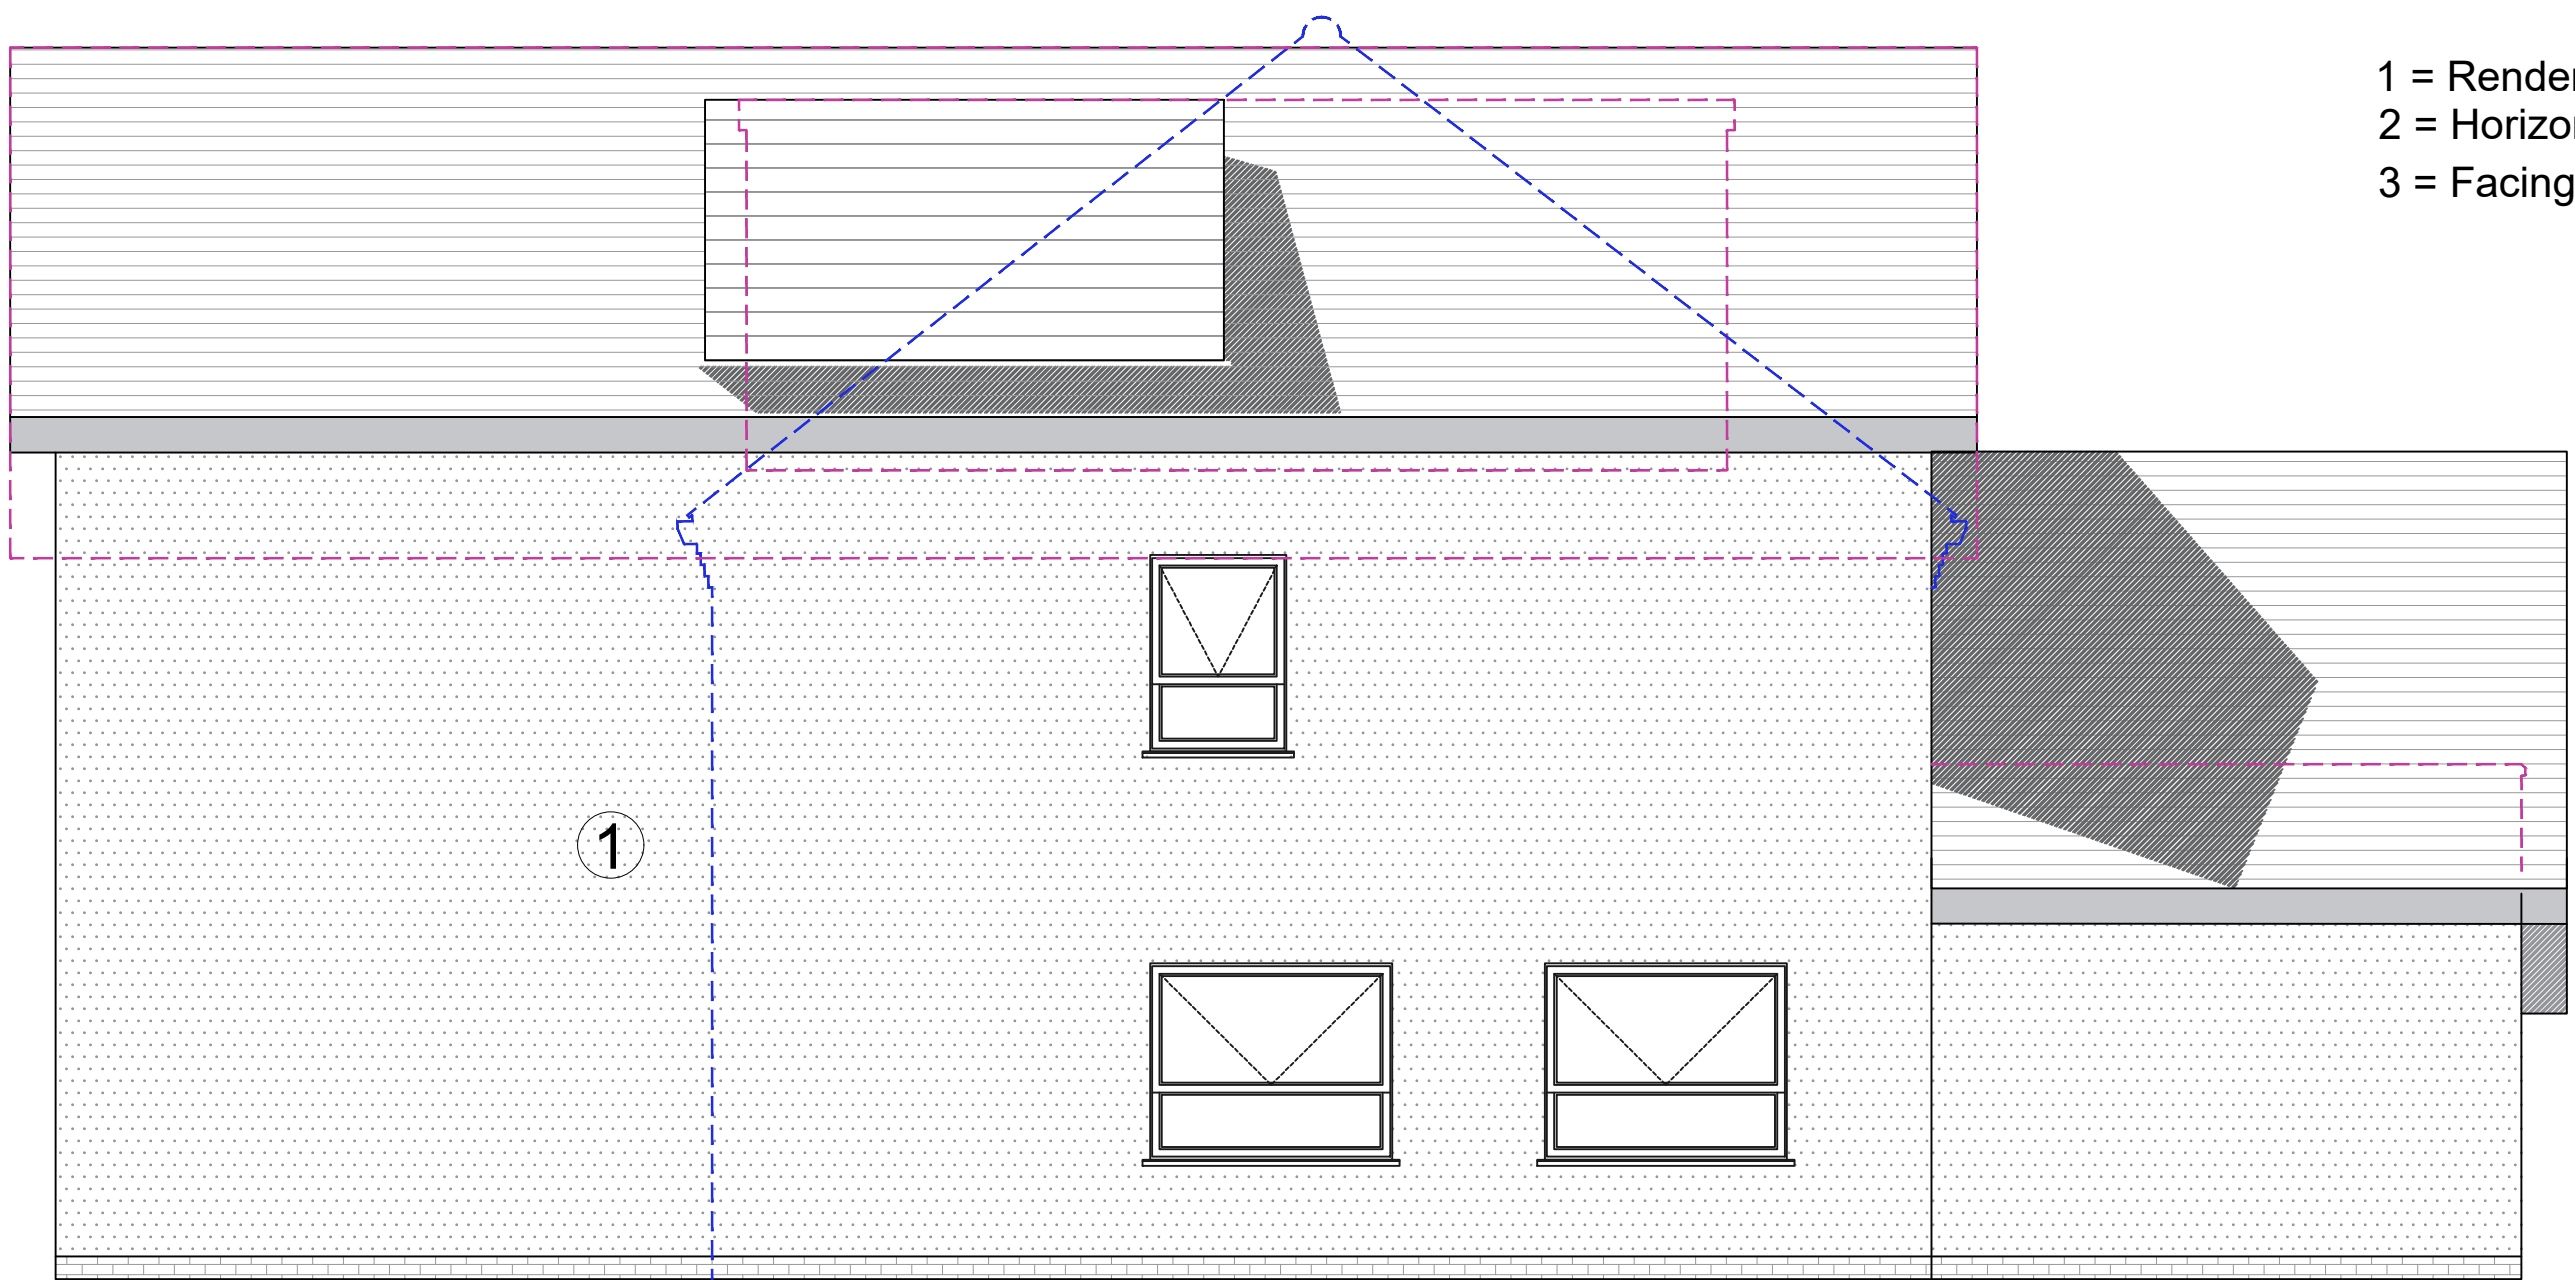

Proposed South West Elevation @ 1:50

Material Schedule;
1 = Render
2 = Horizontal Timber Cladding
3 = Facing Brickwork



notes:

----- = Outline of As Built Structure
----- = Outline of Demolished Gable

Proposed Materials:
External Wall - Facing Brickwork
Roof - Plain Clay Tiles
Windows - Timber Frame, Reconstituted Stone Sills
Rainwater Goods - Black UPVC


Mr Eyre
200 Park Avenue
Purbrook, Waterlooville

title: Approved Elevations

status: Planning
date: June 2021
scale: 1:50@A1
drawn: HJ
chk'd: GR

job: 1040
dwg: 1303

rev: /

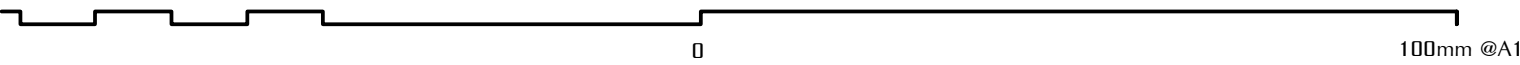

NOTE: The contractor is responsible for checking all site dimensions and levels. These should be checked prior to the ordering of any components and before the commencement of the works. All discrepancies should be brought to the attention of the Contract Administrator