



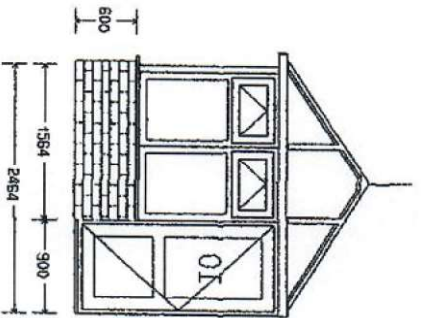


View 1


AS CONSTRUCTED in 2000
AT 86, SINAH LANE, H.I.

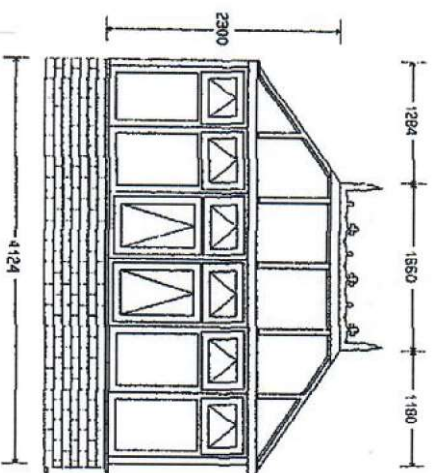

View 2

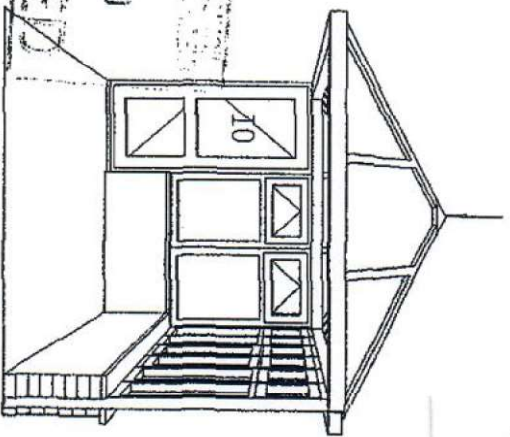

View 3

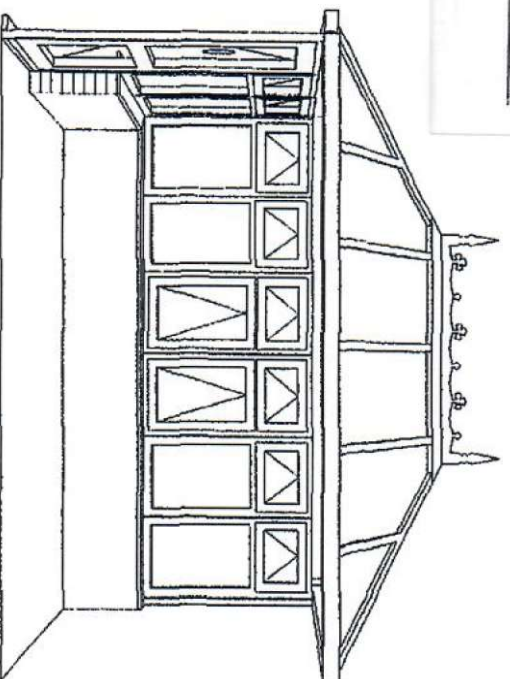

View 4

HAVANT
PLANNING AND
SERVICES

20 MAR 2000

RECEIVED

PREPARED FOR: Mr Brian Thornton
86 Sinah Lane
Havling Island

PREPARED BY: Stuart McLoughlin

SCALE : 1:45

DATE : 12 FEB 2000

DRAWING NO : 201