


EXTERNAL SIGNAGE SCHEDULE (n.t.s.)		
sign no.	signage image (n.t.s.)	description
1.		1no 700mm cap height white with red highlight channels individual letters internally illuminated. 5mm moulded acrylic KFC letters 125mm deep. Registered 'R' sign in red and 125mm deep. Ref. white R&H 7328 Translucent Acrylic Ref. cardinal red highlights 3M 3630-53 Ref edge return grey RAL 7022 / PMS 418 1no sign fixed to building at 3219mm between building FFL and sign's underside. 1 no. suspended from the underside of the canopy at 3270 between building FFL and sign's underside. Letters to be fixed back to building. Illumination by GE tetra max white LED's Luminance level = 250 Candela per sqm
2.		2no 700mm cap height red with white highlight channels individual letters internally illuminated. 5mm moulded acrylic KFC letters 125mm deep. Ref. cardinal red 3M 3630-53 Ref. white highlights R&H 7328 Translucent Acrylic Ref. edge return grey RAL 7022 / PMS 418 1no. at 2335mm between building FFL sign's underside Letters to be fixed back to building. Illumination by GE tetra mini max white LED's
3.		1no 2960mm high (above pavement FFL) x 2340mm wide goal post height restriction to drive thru entrance (2500mm clear height), non-illuminated mid steel height restrictor frame all to be finished grey ral 7022 with red sign and white text detail. Red chains and hooks and red and white striped cross bar.
4.		1no 900mm high x 1580 mm wide applied individual aluminium graphic in white. 1125mm between building FFL and sign's underside.
5.		1no 900mm high x 1580 mm wide applied individual aluminium graphic in black. 1125mm between building FFL and sign's underside.
6.		2no. 1200mm high (above pavement FFL), 400mm wide x 300mm high disabled parking sign manufactured from 3mm aluminium being primed & powder coated grey RAL 7022 having digitally printed vinyl with protective laminate applied to face. Sign affixed Ø76mm C.H.S. aluminium primed post, powder coated grey RAL 7022.
8.		2no. 2303mm high (above pavement FFL) x 830mm wide x 275mm deep. 1 door, 2 panel order menu unit , aluminium supporting post and door frames finished in Grey RAL 7022. Main aluminium signcase finishes in Grey RAL 7022. Illumination via banks of LED. Frames to be glazed on 6mm clear acrylic panel backed up with 3mm opal 050 perspex panel with poster between. Luminance level = 250 Candela per sqm
9.		1no 2323mm high (above pavement FFL) x 2545mm wide x 275mm deep. 4 door, 8 panel main order menu unit , aluminium supporting post and door frames finished in Grey RAL 7022. Main aluminium signcase finishes in Grey RAL 7022. Illumination via LED light fittings. Frames to be glazed in 6mm clear acrylic panel backed up with 3mm opal 050 perspex panel with poster between. Luminance level = 250 Candela per sqm
9a.		1950mm high x 1950mm wide x 125mm Colonel logo box powder coated grey RAL 7022. 2758mm between building FFL and sign's underside. Internally illuminated Colonel logo flex box fixed to building front. Finish flex box colonels logo extruded aluminium sign comp system finished Grey RAL 7022 illumination provided banks of LED. Flex face substrate is to be decorated with face applied 3M self adhesive vinyl's to match corporate colours Cardinal red/ white/black and warm biege.

EXTERNAL SIGNAGE SCHEDULE (n.t.s.)		
sign no.	signage image (n.t.s.)	description
10.		1200mm high (above FFL) x 760mm wide x 260mm deep directional ground signs to be positioned in location shown. Signage size 500x700mm. Frame finished in Ral 7022. Sign panel to be non illuminated with reflective vinyls to face. Non illuminated
11.		1200mm high (above FFL) x 760mm wide x 260mm deep directional ground signs to be positioned in location shown. Signage size 500x700mm. Frame finished in Ral 7022. Sign panel to be non illuminated with reflective vinyls to face. Non illuminated
12.		1200mm high (above FFL) x 760mm wide x 260mm deep directional ground signs to be positioned in location shown. Signage size 500x700mm. Frame finished in Ral 7022. Sign panel to be non illuminated with reflective vinyls to face. Non illuminated
13.		1200mm high (above FFL) x 760mm wide x 260mm deep directional ground signs to be positioned in location shown. Signage size 500x700mm. Frame finished in Ral 7022. Sign panel to be non illuminated with reflective vinyls to face. Non illuminated
14.		POLESIGN - Type 'X' 8m high totem sign 1 nos 9000mm high (above FFL) x 1910mm wide x 1178mm deep blade totem sign . Face panels 5mm opal polycarb panel with face applied 3m vinyl colone. Column to be M/steel CHS upright Painted Umber grey RAL 7022. Refer to Avon Sign drawings for further details. Luminance level = 250 Candela per sqm
15.		Approx 450mm high x 450mm wide, aluminium sign wall mounted at high level. 2188mm between building FFL and sign's underside. Arrow and "order here" words to be in black.
16.		Approx 450mm high x 450mm wide, aluminium sign wall mounted at high level. 2532mm between building FFL and sign's underside. Arrow and "pick up here" words to be in black.

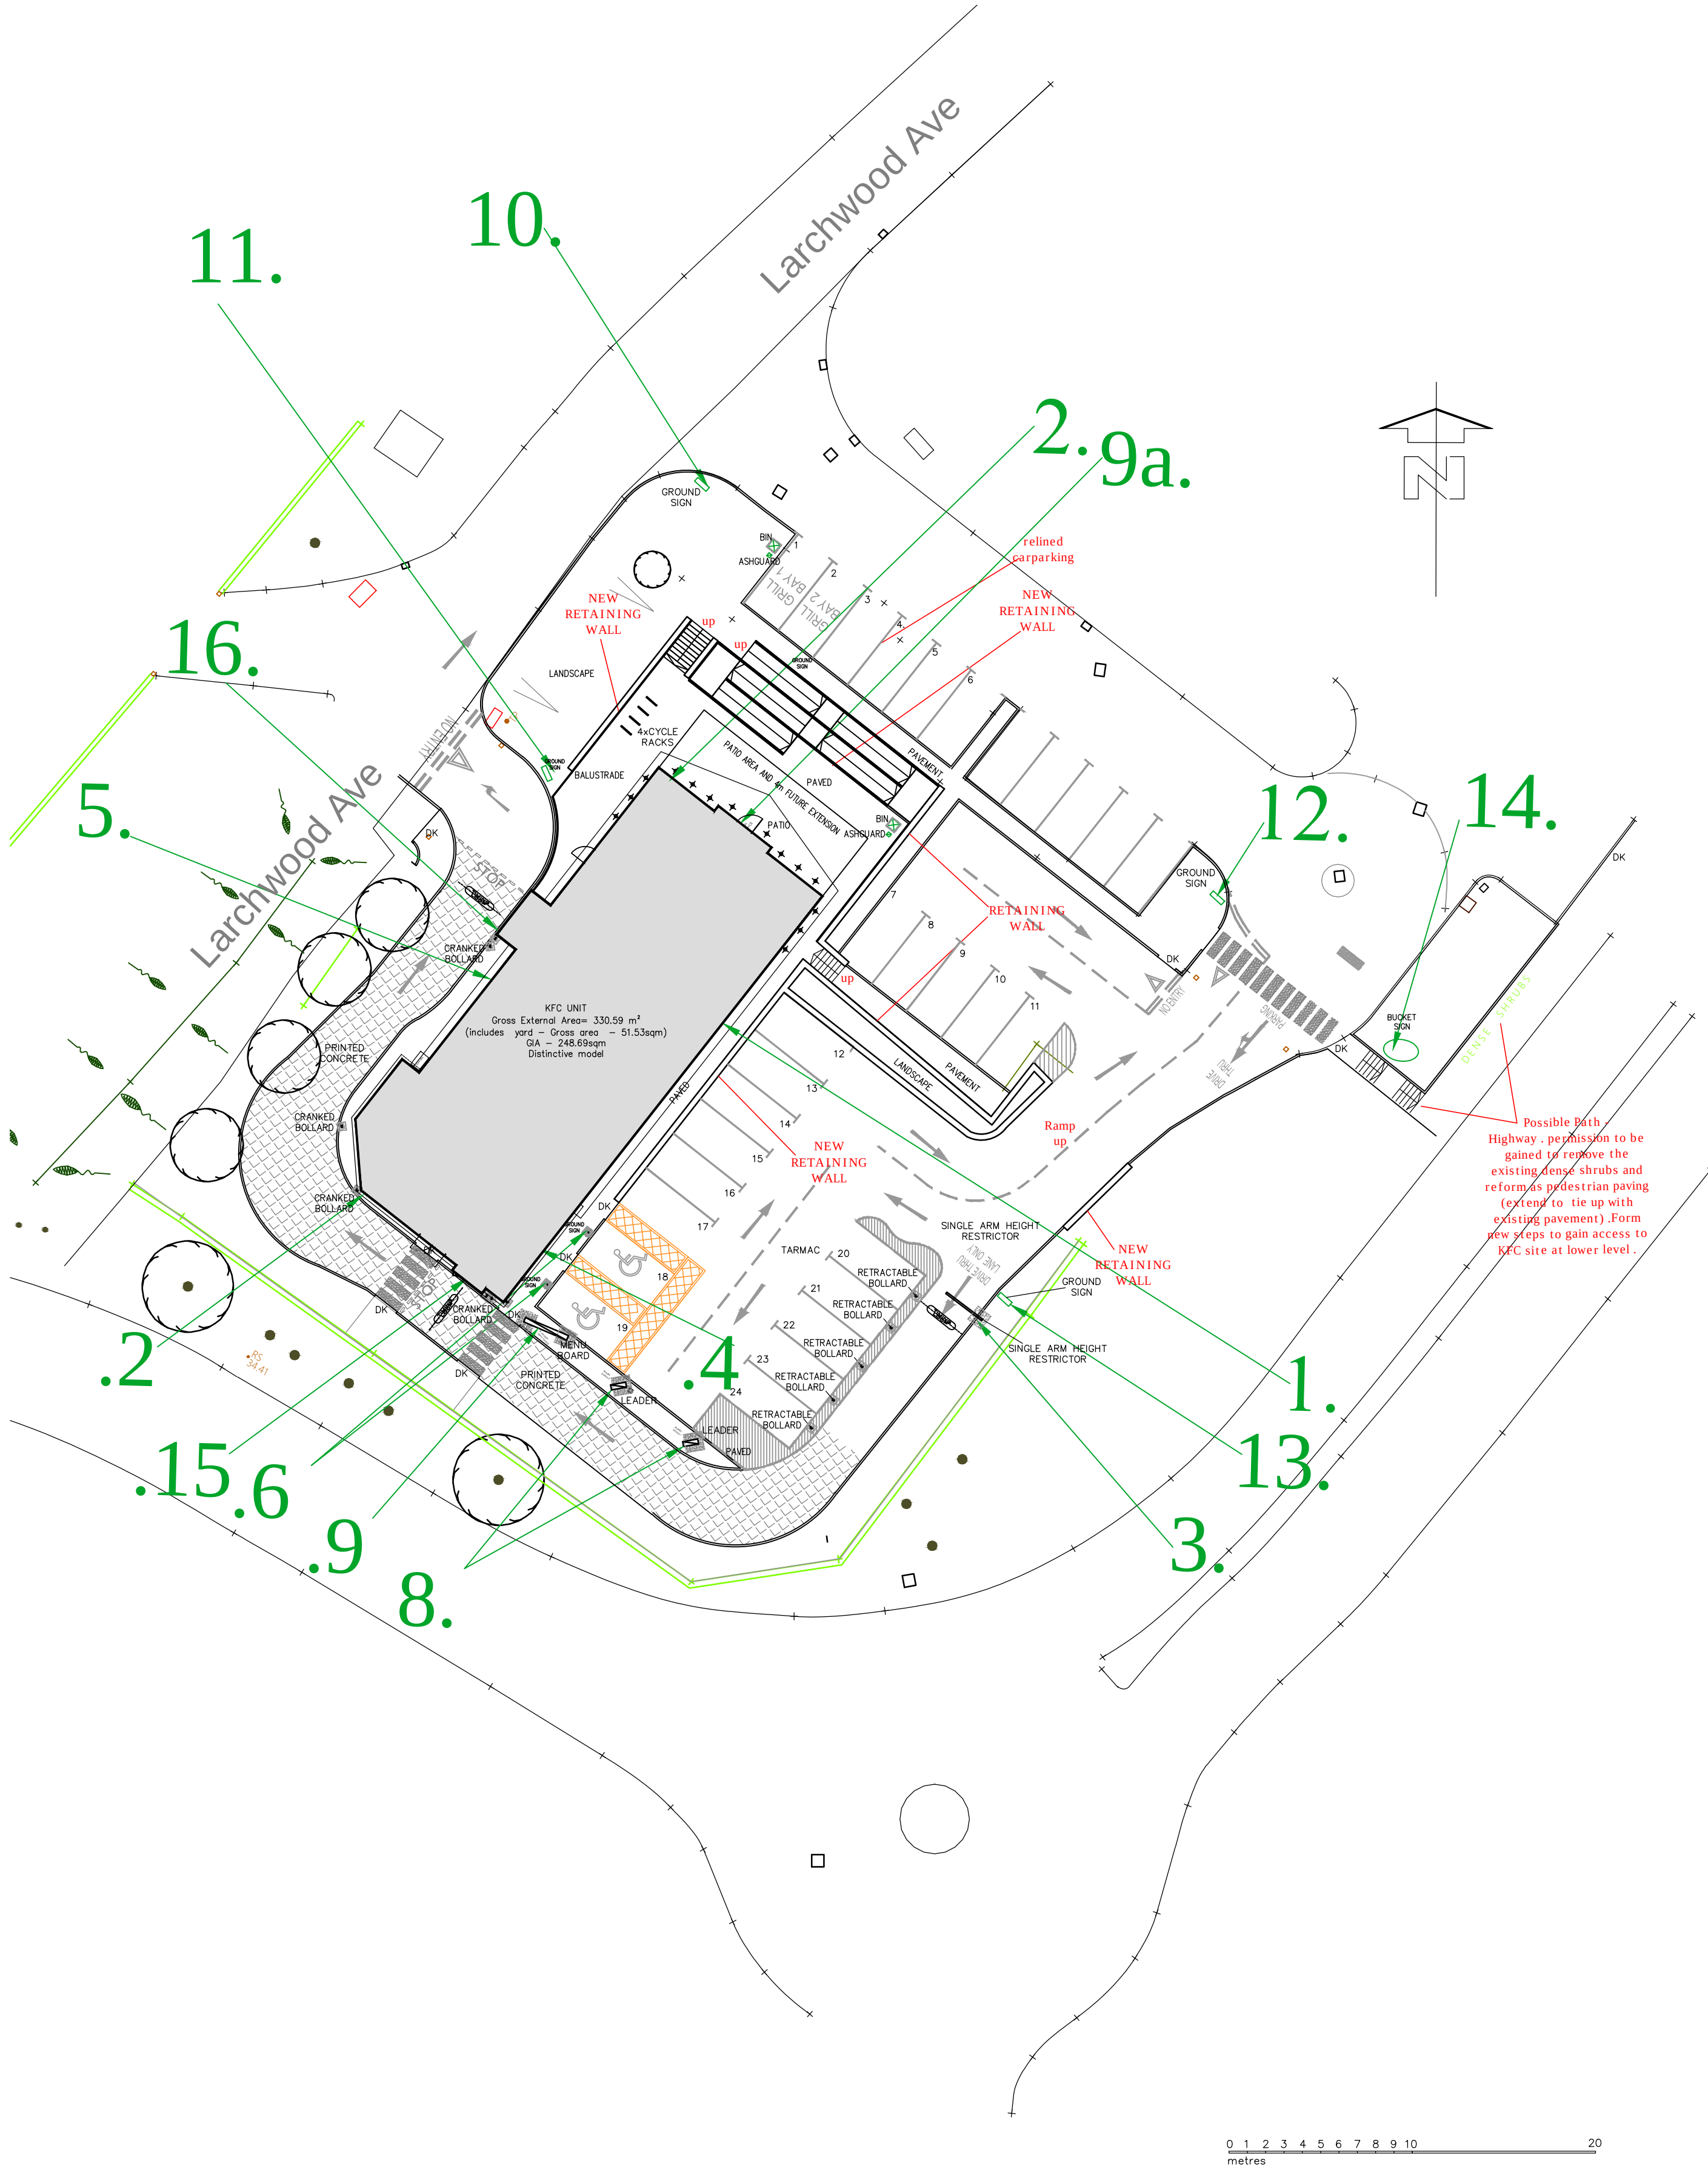

proposed site plan scale - 1:250 @ A1 1:500 @ A3

SITE DESIGN SIGNOFF	
Name / Title	
Signature	Date

ALL DIMENSIONS TO BE CHECKED ON SITE.
DO NOT SCALE FROM THIS DRAWING EXCEPT FOR THE PURPOSES OF LOCAL AUTHORITY PLANNING

rev	date	description
H	14.07.16	Carparking space numbers corrected (NS)
G	12.07.16	Site red line boundary and omitted following comments from LW (NS)
F	08.07.16	Additional pedestrian crossing added to aid with access to the rear delivery doors. ral colour spec updated all sign frames following model change (ral 7022) (NS)
E	23.06.16	DT lane widened for mini bus swept path (NS)
D	21-06-16	Site plan updated to allow for new pedestrian path(and associated clearing works) and omitting retaining wall to DT lane (NS)
C	06-06-16	Access ramp building and proposed path from McDonald's pedestrian access (ARS)
B	11-03-15	KFC updated to latest distinctive model and signage updated to suit(BF)
A	25-02-15	Clean version of approved Site Plan Ref: G213 rev D (SS)

ripon house, suite 7
35 station lane
hornchurch
essex, rm12 6jl
tel.: 01708 477899
fax: 0709 223 4930
e.: office@architect.ltd.uk
web.: www.architect.ltd.uk



NEW BUILD.

store address
KFC BEDHAMPTON

Larchwood Avenue
P09 3QW

drawing title
PROPOSED
Site Plan
for Planning

drawn by	checked	date
AI		JUN 2016
store no.	scale	
0000	1:250 / 1:1250	

drawing no.	revision
0000/2011/B121/14-0062	H

PLANNING