




AS INSTALLED FRONT ELEVATION

Scale 1:50

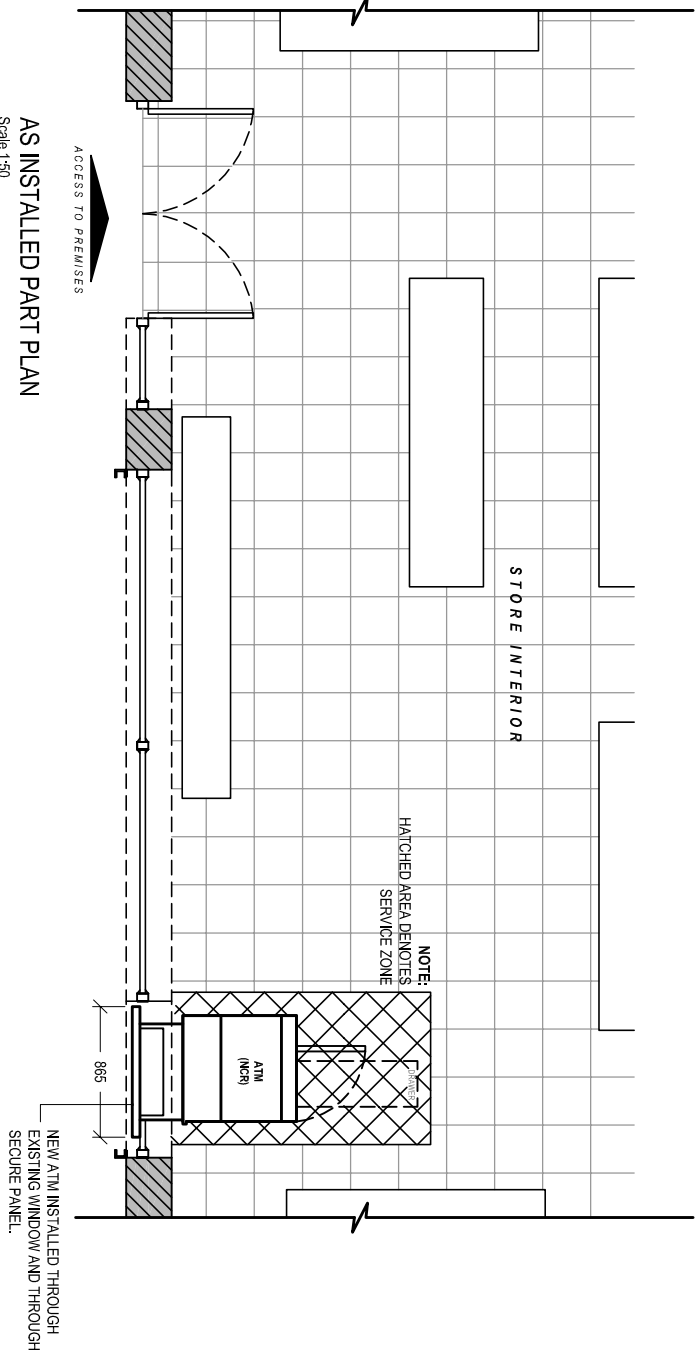

AS INSTALLED PART PLAN

Scale 1:50

Date: _____ By: _____

Comments: _____

GENERAL NOTES:

1) All dimensions in millimeters unless otherwise stated.

Site:

NIKKI ENTERPRISE Ltd

ELLYS CONVENIENCE

37 Park Parade

Hasant

PO9 5AA

Drawing Title:

As Installed Elevations and Plans

Ref:	Date:	Rev:
NM-02-2015-25-2	07-02-2016	
Scale:	Paper:	Date Rev:
1:50	A3	