




EXISTING PART GROUND FLOOR PLAN

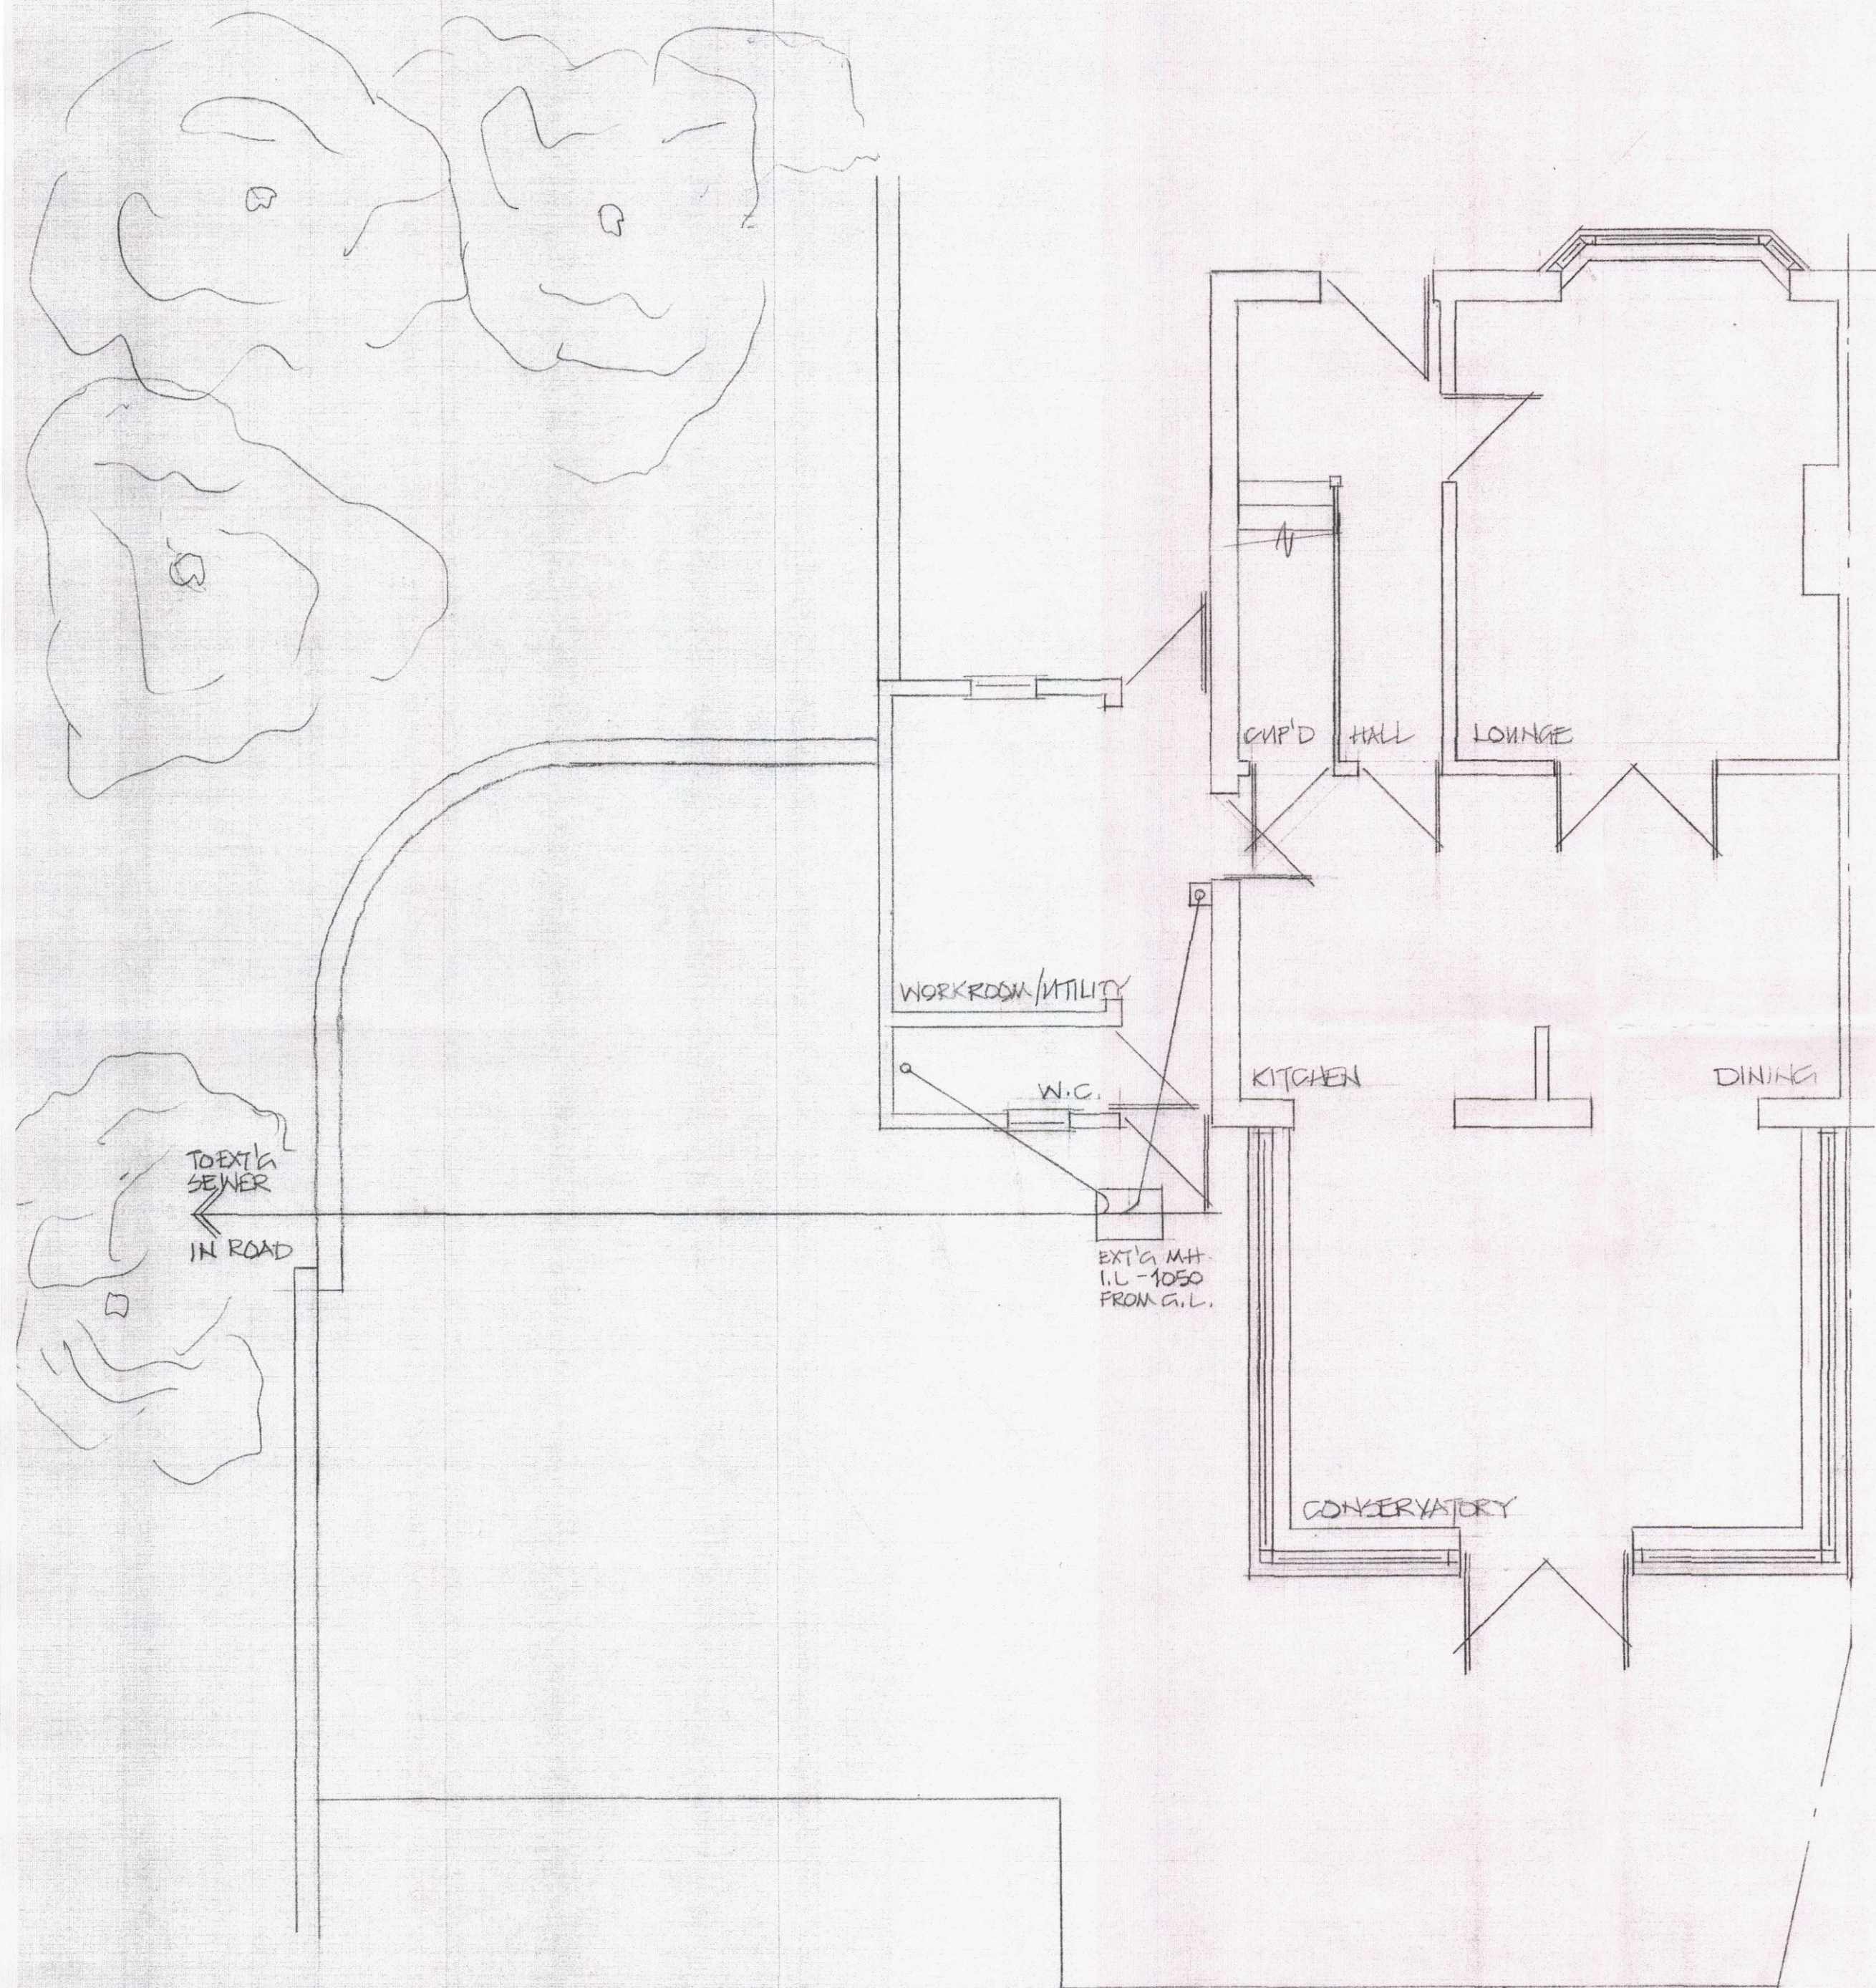

MR & MRS HUNT

5 LEWIS RD
EAKSWORTH
HANTS PO10 7RP

AS BUILTS (Ground floor plan)

David Niven Design Ltd

davidnivedesign@gmail.com
07873 342607 01243 330070
74 Westbourne Avenue,
Emsworth, Hampshire PO10 7QU



Architectural Design & Planning

1:50 JULY '15 15/1084/1