


SUPERSEDED

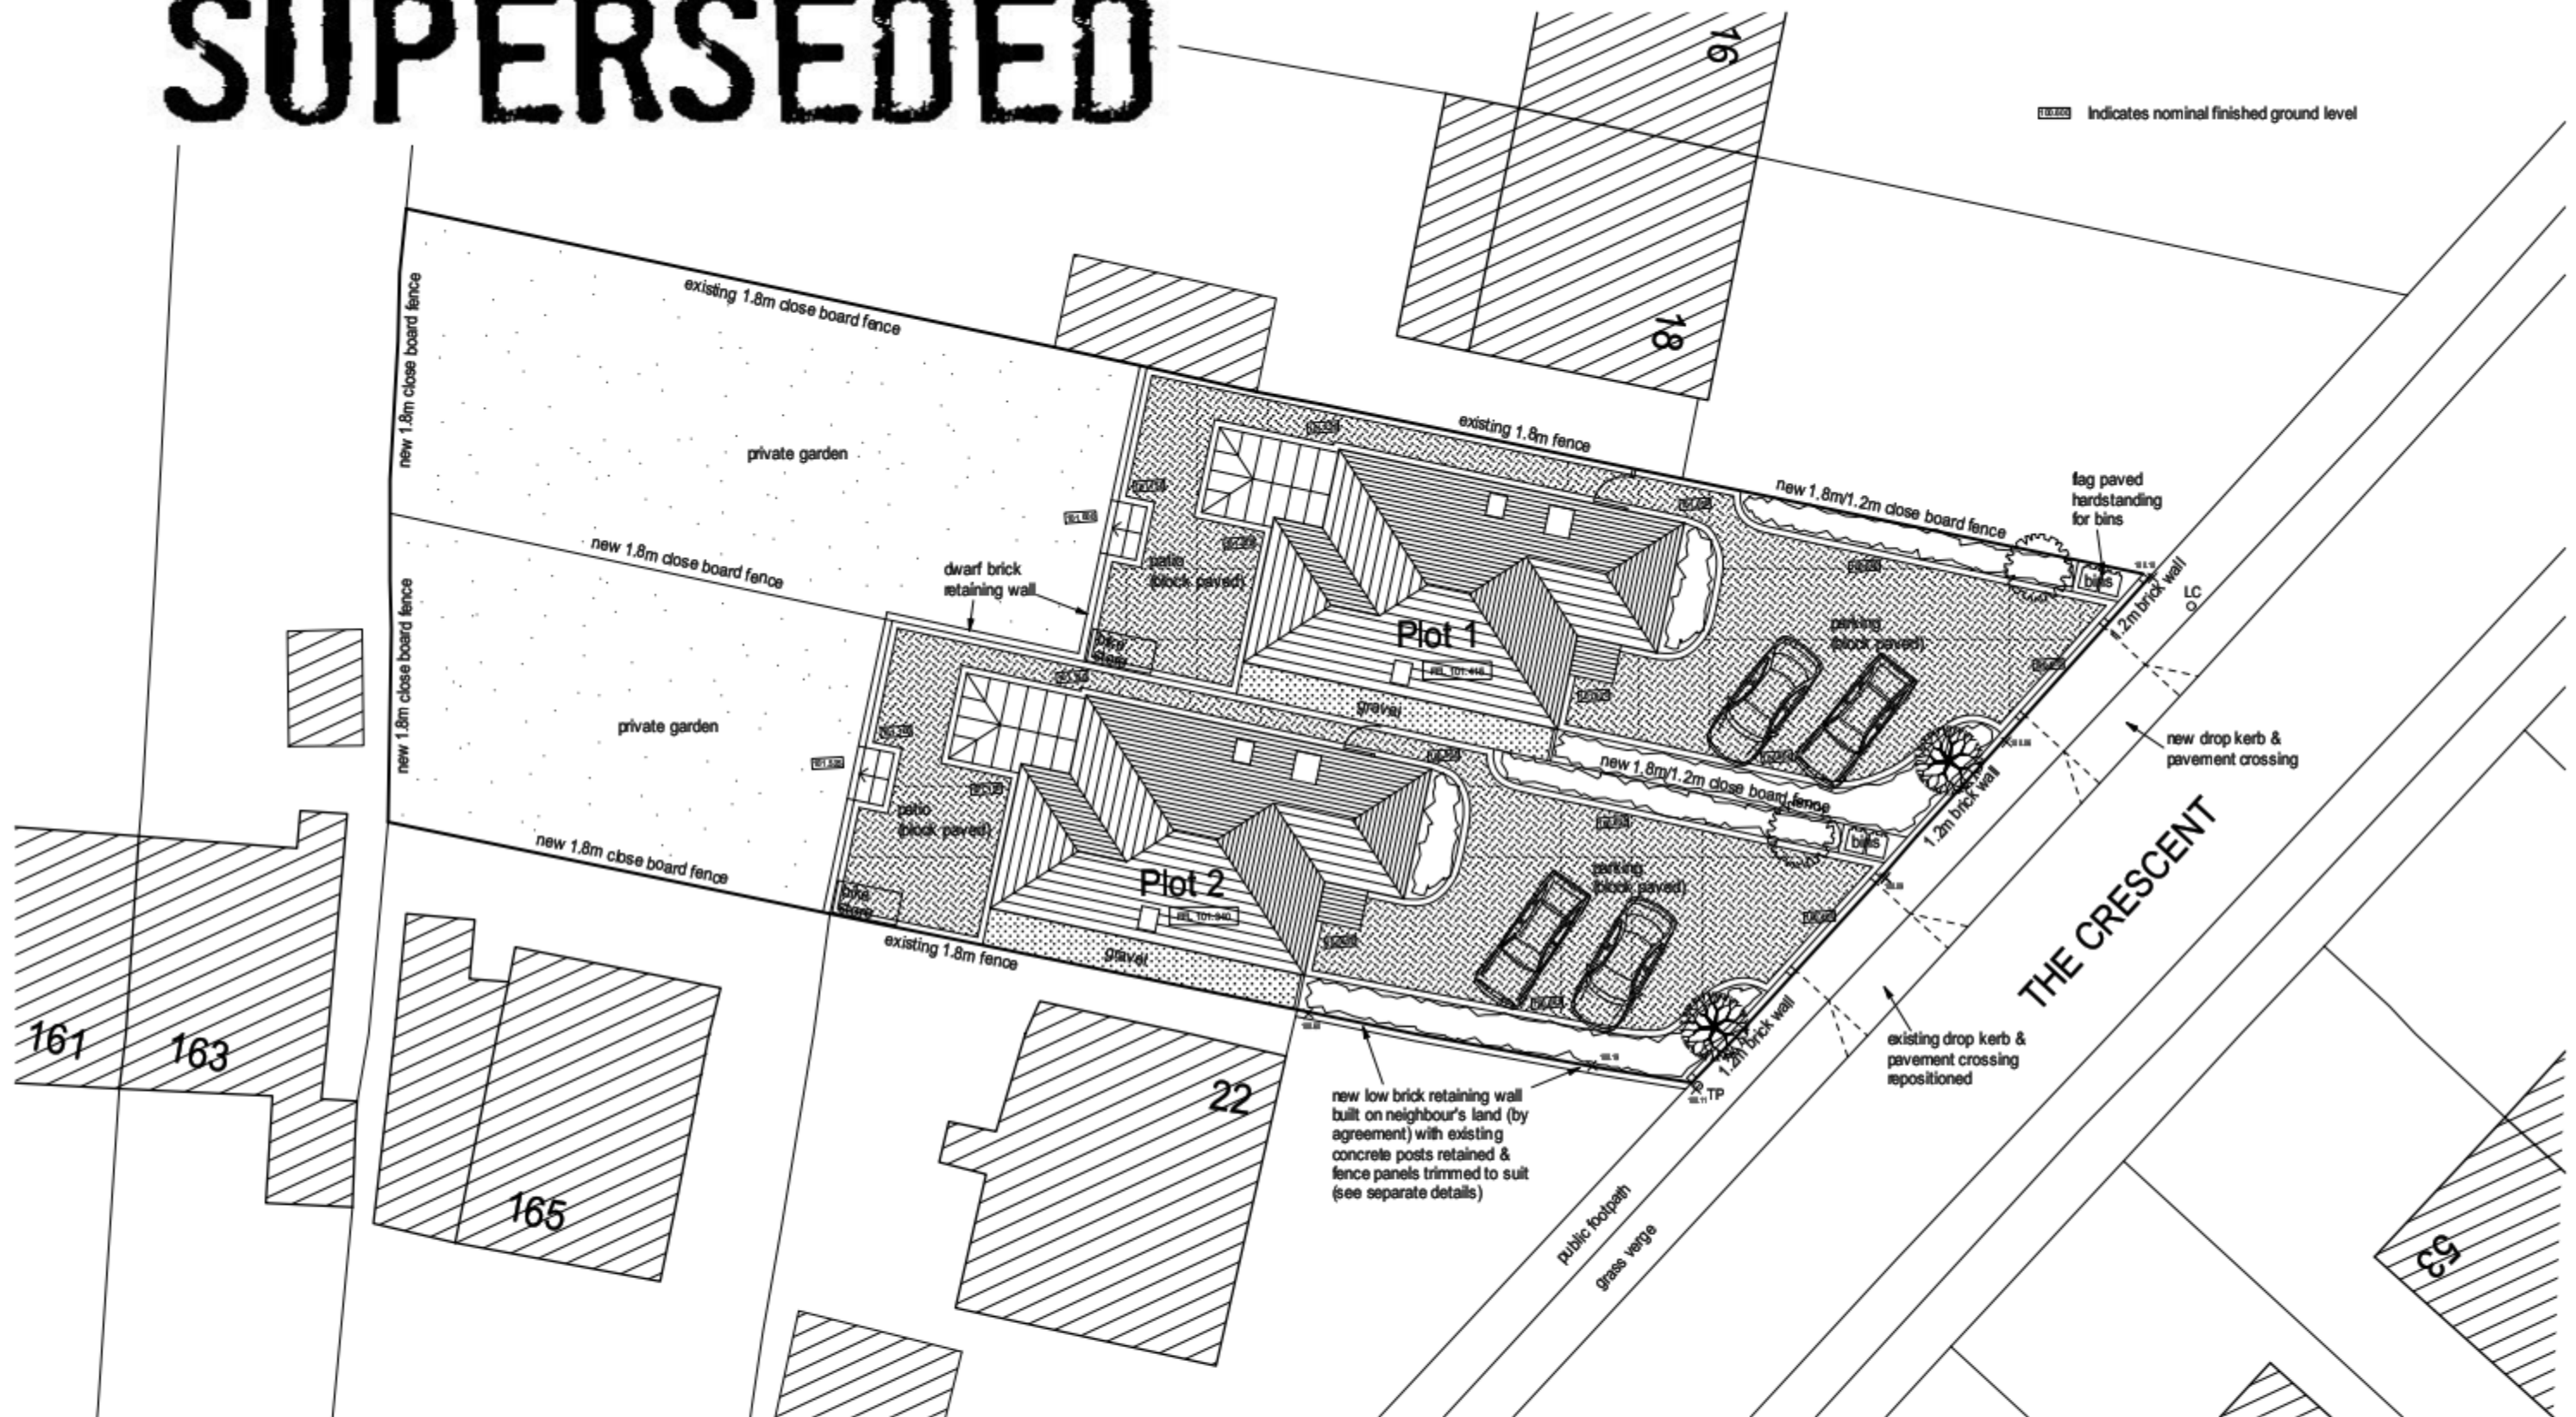

Proposed Site Plan 1:200

This drawing is the copyright of the Architect and must not be reproduced without permission, except by the Local Planning Authority for planning purposes. Figured dimensions taken in preference to scale. Originals to be checked on site before work commences. No deviation from this drawing will be permitted without the prior written consent of the Architect. Ground floor plans, foundations, structure, etc. and all work below ground is shown provisionally and inspection of ground conditions is essential prior to work commencing. Rain water is shown where the ground conditions are apparent and redesign may be necessary in the light of soil conditions found. The responsibility for establishing the soil and subsoil conditions rests with the Contractor.		A - Updated to show as-built project. 08-07-2015	
		drawing no. 21303/02 rev. A date JUL 2013 scale 1:200 sheet A3	client MEADOWLANDS NEW HOMES LTD.
project 2 NO. DETACHED 4 BED REPLACEMENT DWELLINGS AT 20 THE CRESCENT WATERLOOVILLE, HAMPSHIRE PO7 5EU		Jeffrey Douglas Chartered Architect 11 Oldfield Road • Hatington • Hampshire • PO11 1LJ Tel: (023) 4044 888 • Email: j@jtdesign.co.uk	