





PRE-EXISTING FRONT ELEVATION

Scale 1:50

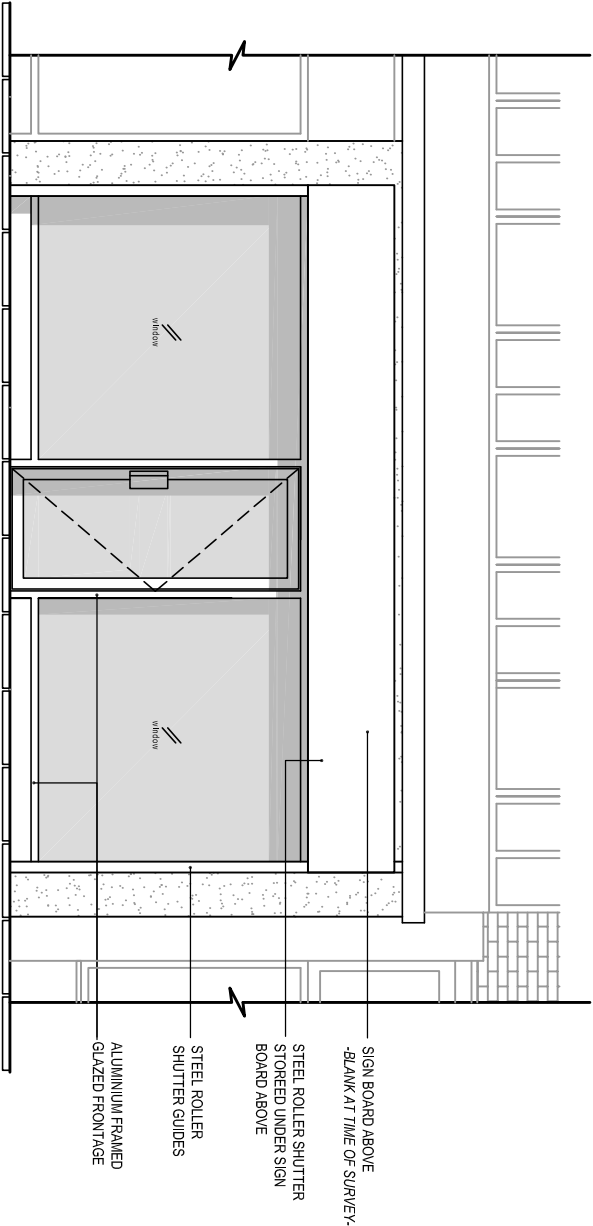


AS INSTALLED FRONT ELEVATION

Scale 1:50

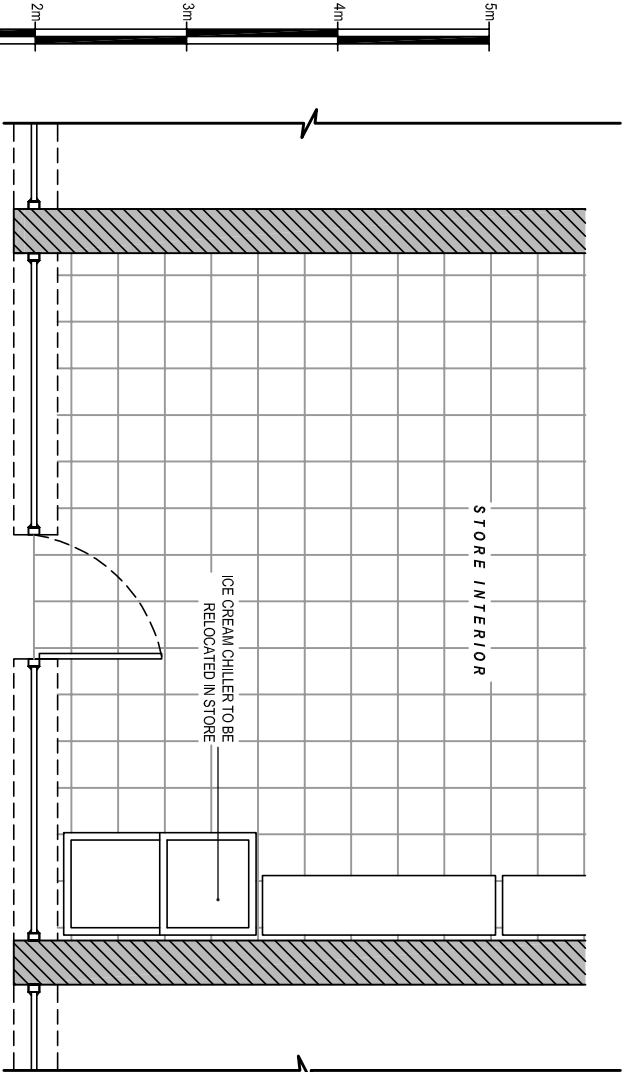

PRE-EXISTING PART PLAN

Scale 1:50

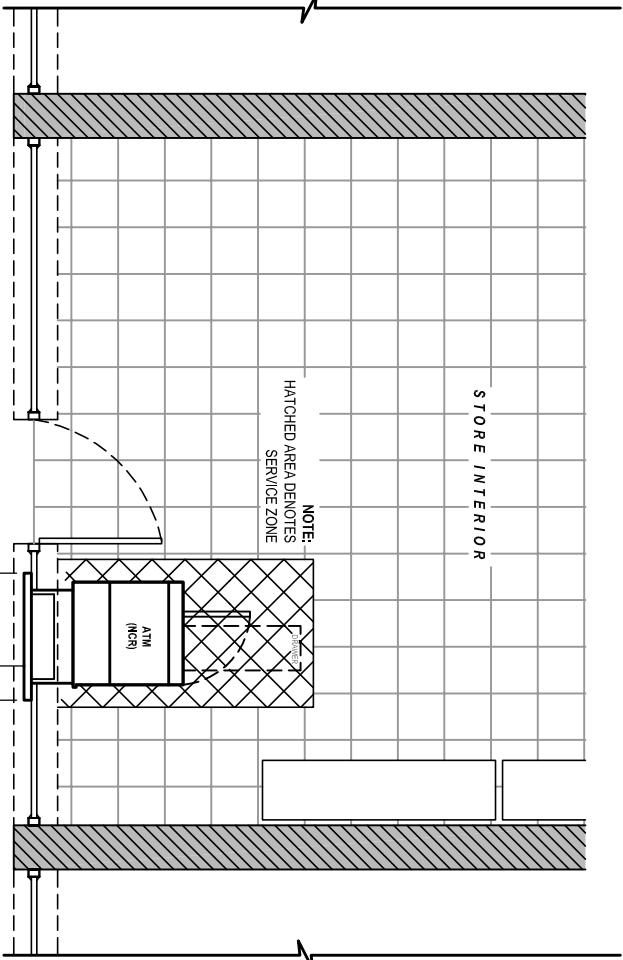

AS INSTALLED PART PLAN

Scale 1:50

Date: _____

Comments: _____

By: _____

GENERAL NOTES:

1) All dimensions in millimeters unless otherwise stated.

Site:

QUEENS STORES

3 Queens Parade,
London Rd
Waterlooville
PO7 7EB

Drawing Title:

Pre Existing & As Installed Elevations and Plans

Ref:	Date:	Rev:
NM-09-2015-19	29-09-2015	
Scale:	Paper:	Date Rev:
1:50	A3	