


SUPERSEDED



Front Elevation (North)

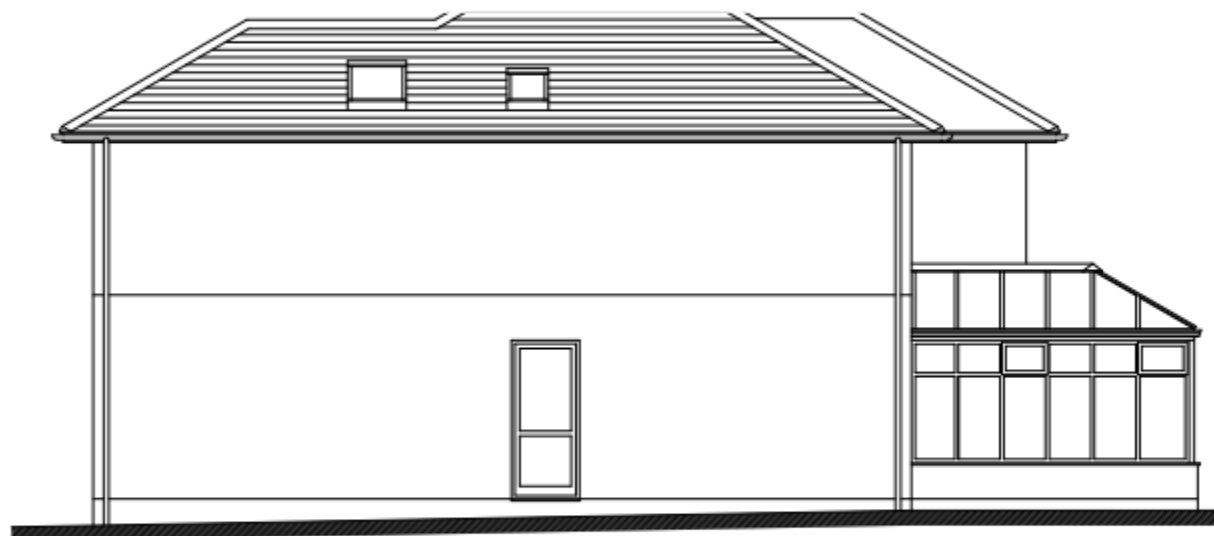


Side Elevation (West)



Section A-A




Rear Elevation (South)

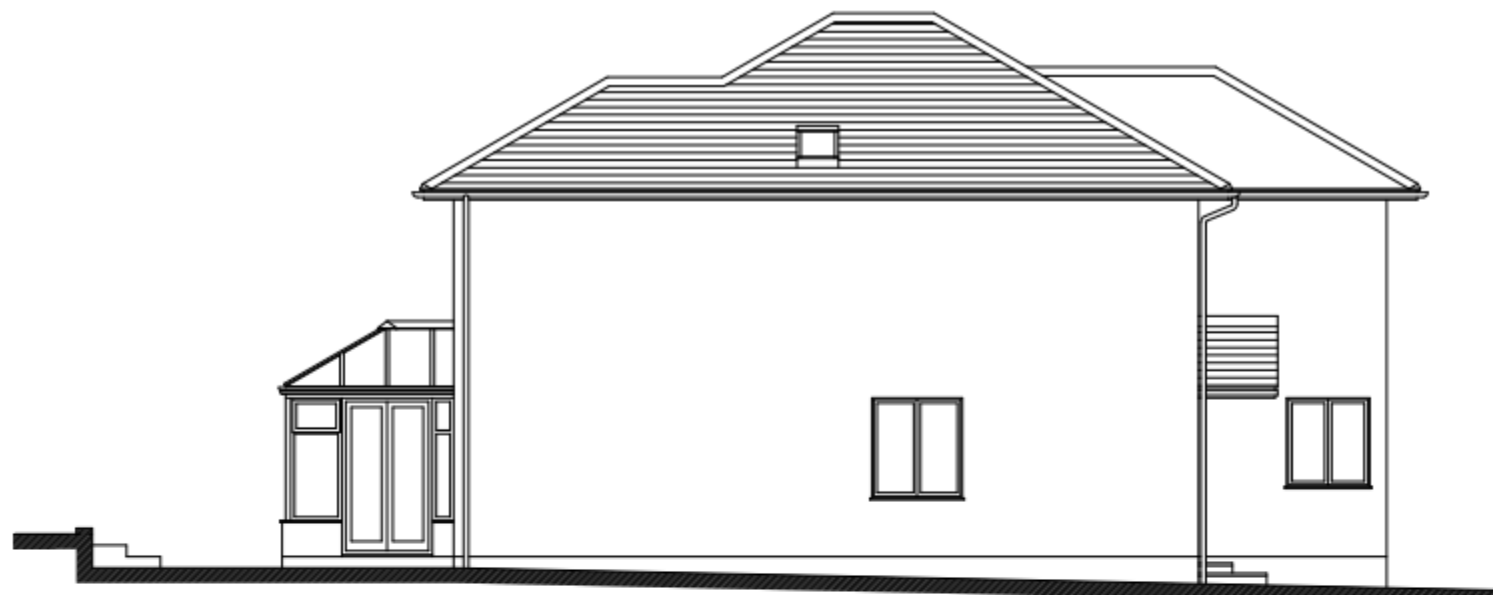

Side Elevation (East)

See separate schedule for details of external materials

Plots 1 & 2 Houses Similar

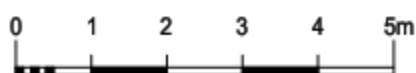

This drawing is the copyright of the Architect and must not be reproduced without permission, except by the Local Planning Authority for planning purposes. Figured dimensions to be taken in preference to scaled. Dimensions to be checked on site before work commences. No deviation from this drawing will be permitted without the prior written consent of the Architect. Ground floor, walls, foundations, structure, etc. and all work below ground is shown provisionally and inspection of ground conditions is essential prior to work commencing. Revisions are essential when the ground conditions are apparent and redesign may be necessary in the light of soil conditions found. The responsibility for establishing the soil and subsoil conditions rests with the Contractor.		A - Updated to show as-built project 09-07-2015	
		drawing no. 21303/04 rev. A date JUL 2013 scale(s) 1:100 sheet size A3	client MEADOWLANDS NEW HOMES LTD.
project 2 NO. DETACHED 4 BED REPLACEMENT DWELLINGS AT 20 THE CRESCENT WATERLOOVILLE, HAMPSHIRE PO7 5EU		Jeffrey Douglas Chartered Architect 11 4th unit 504 • Hayling Island • Hampshire • PO11 1LJ Tel: (01753) 4044 888 • Email: j@jtdesign.co.uk	