



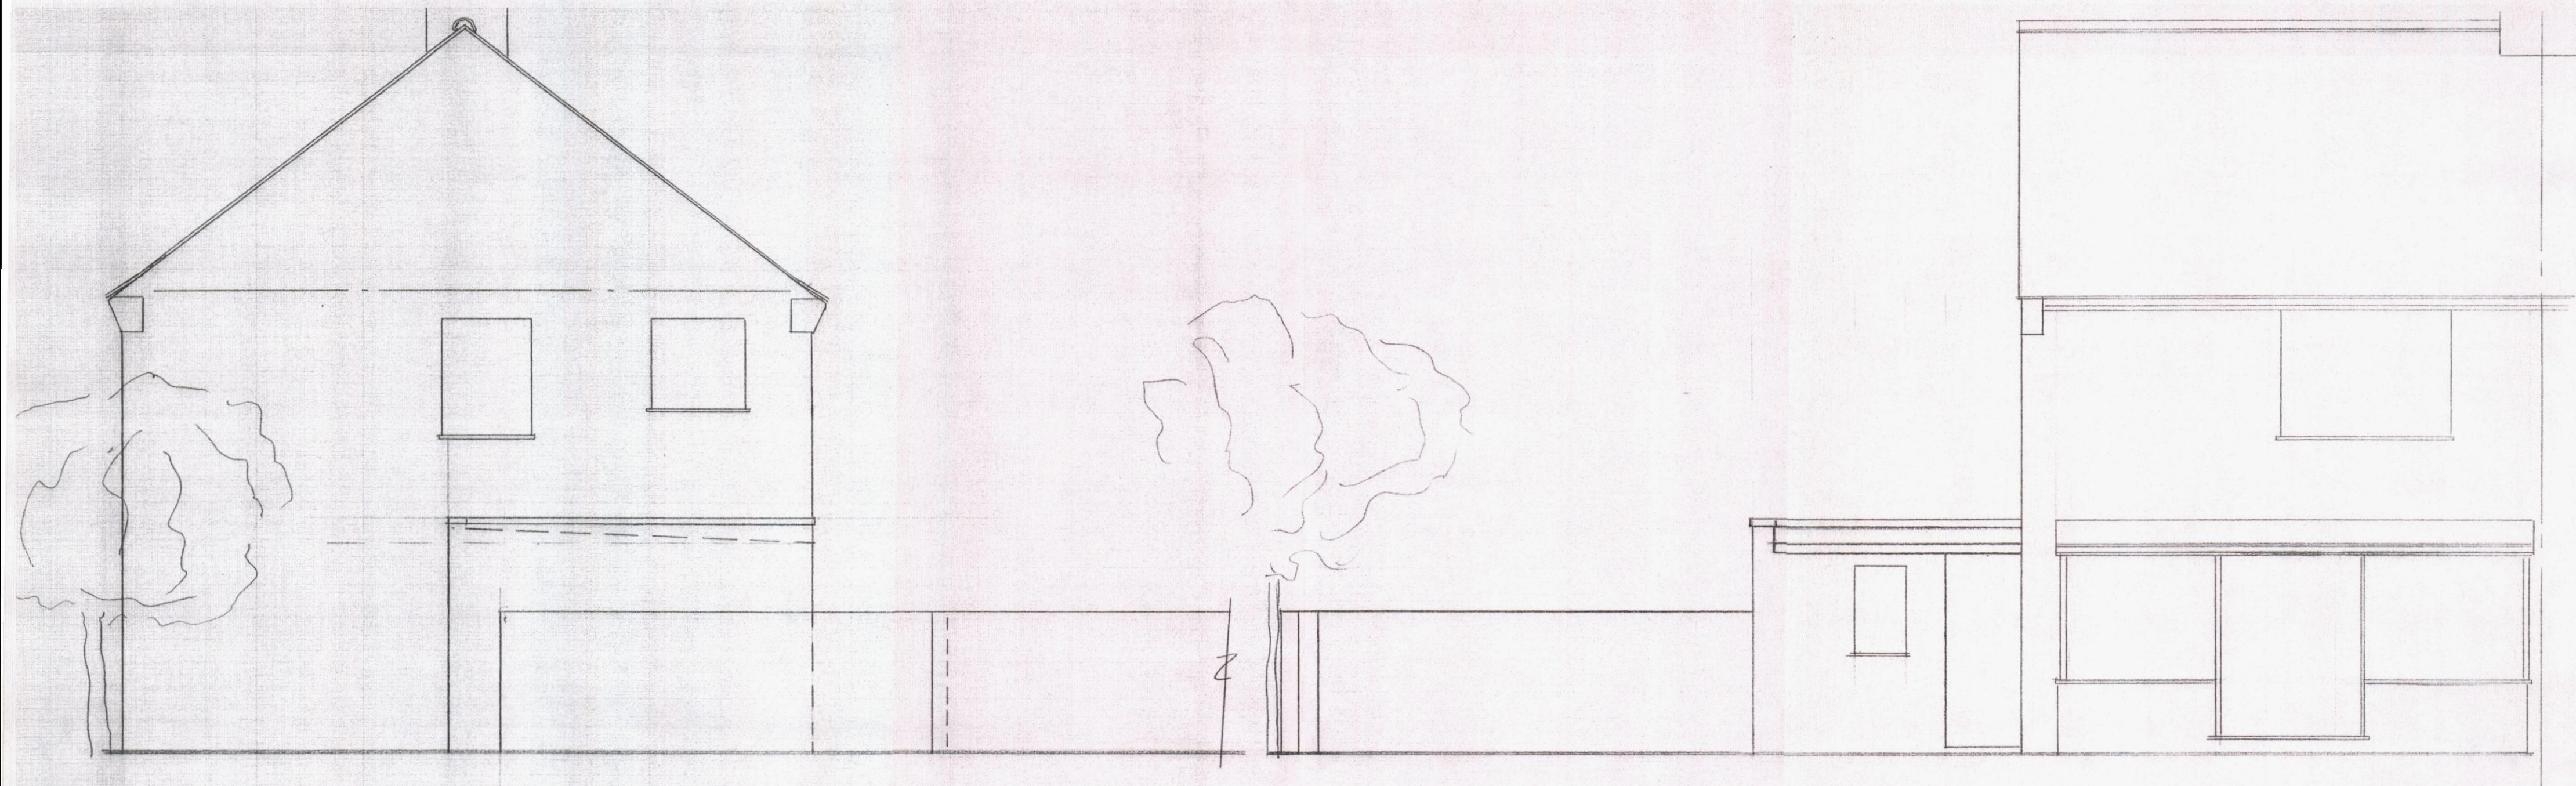

EXISTING SIDE EXTENSION (South)

EXISTING REAR EXTENSION (West)

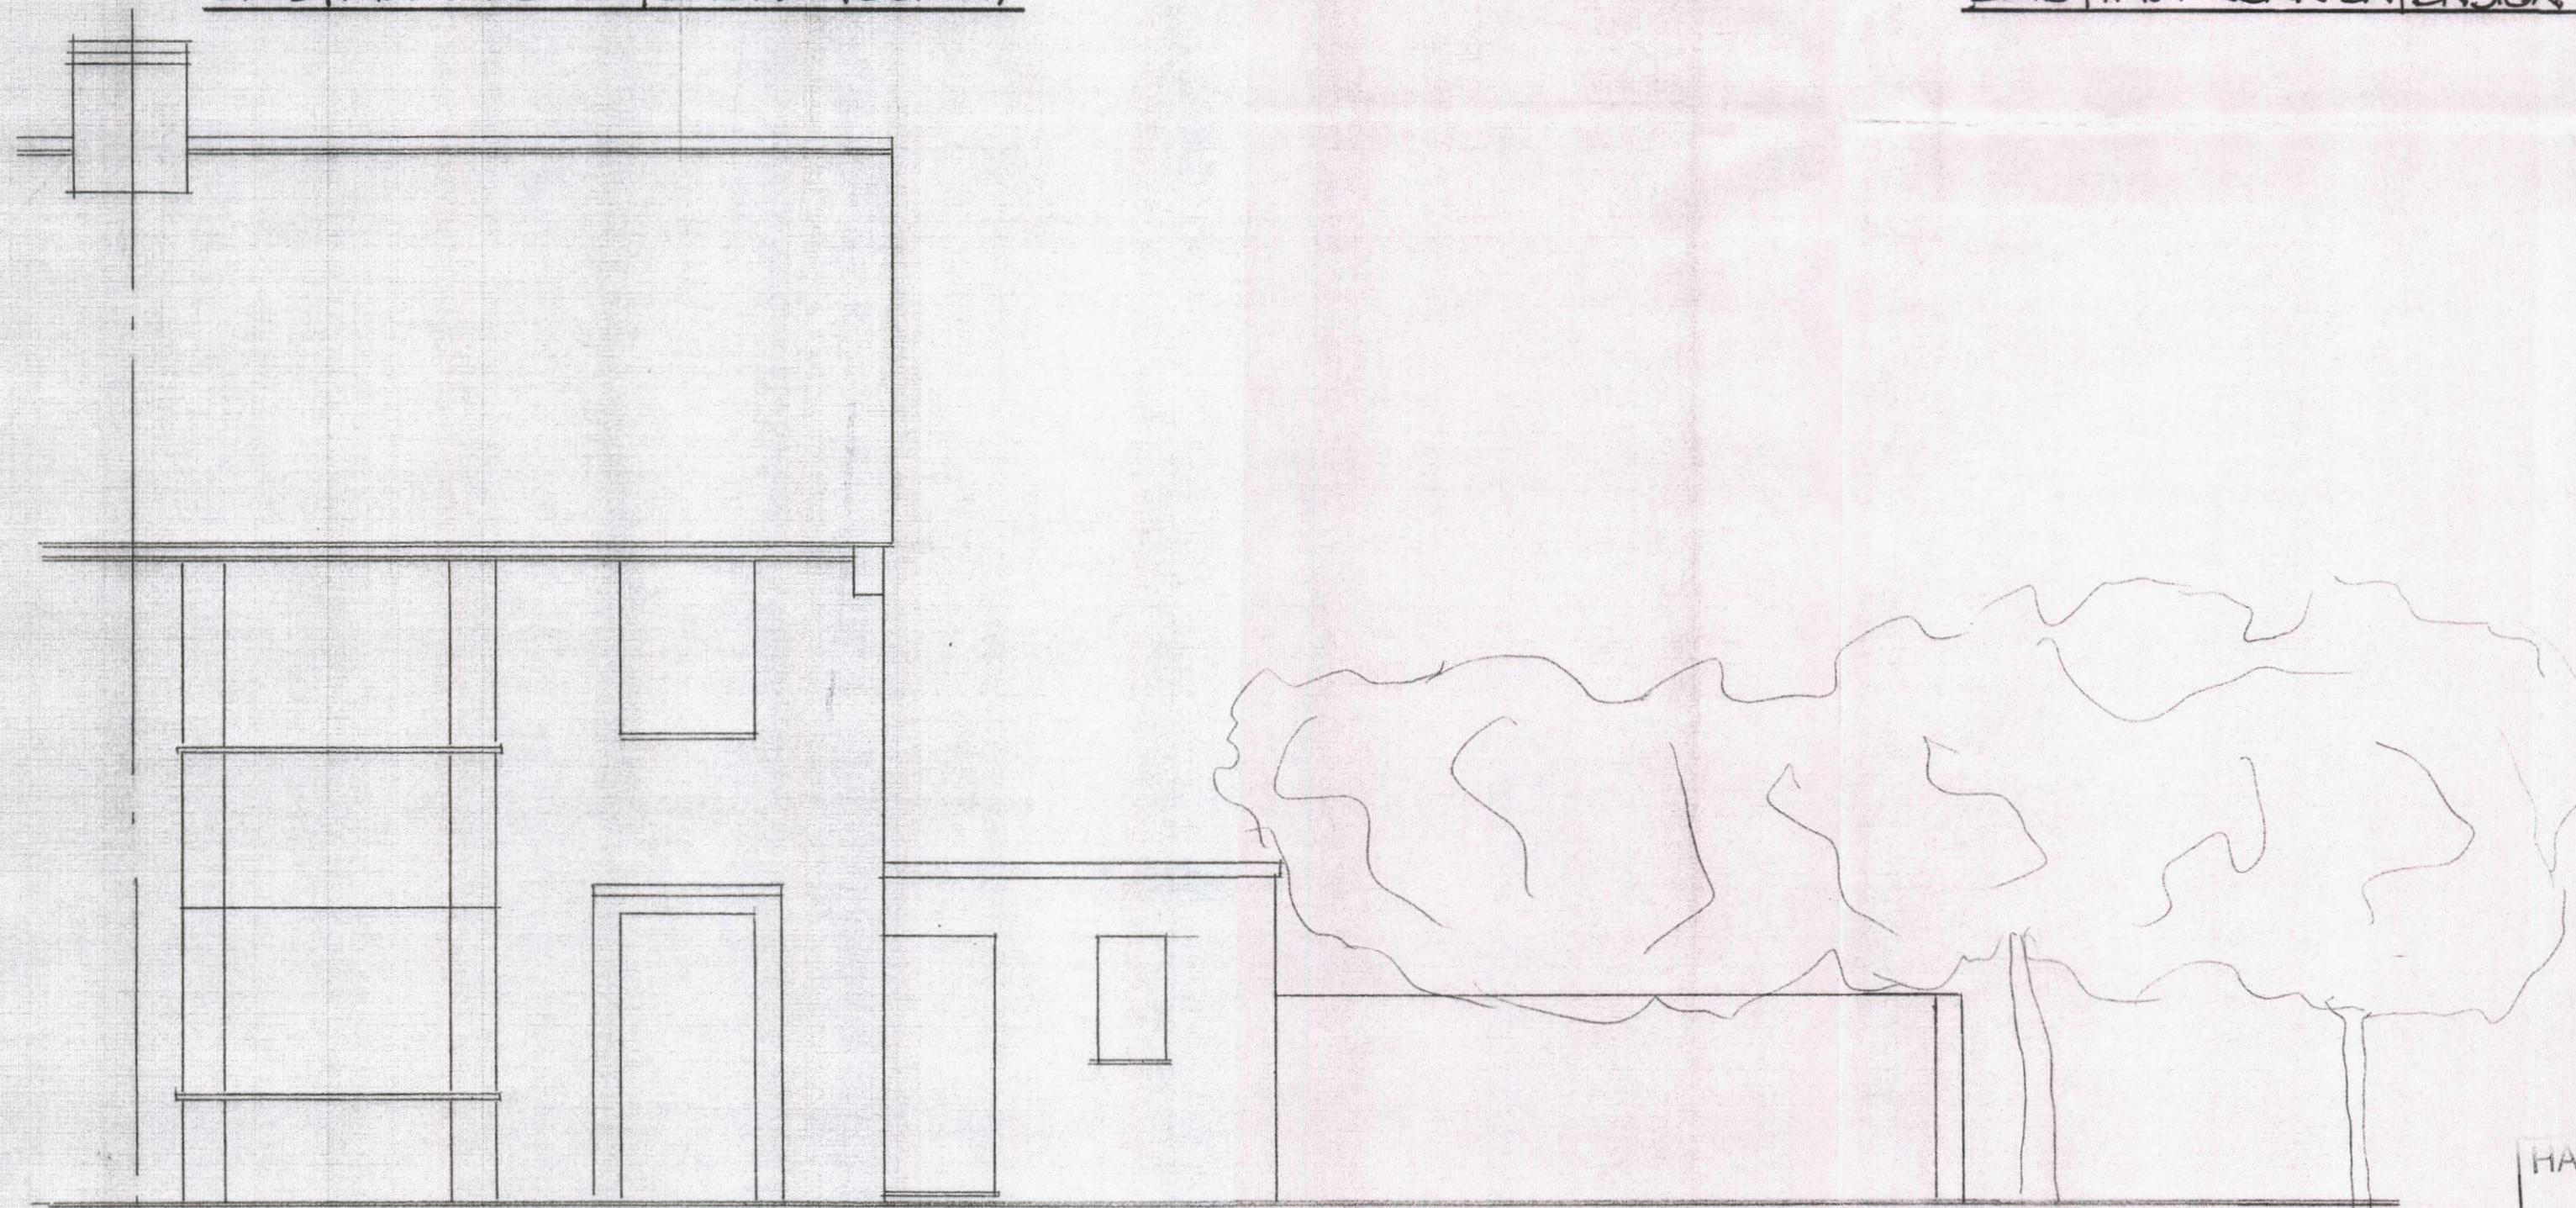

EXISTING FRONT EXTENSION (East)



MR & MRS HUNT

5 LEWIS RD
EMSWORTH
HANTS PO10 7RP

AS BUILTS (Elevations)

David Niven Design Ltd

davidniven.design@gmail.com
01973 342 807 01245 330070
74 Westbourne Avenue,
Emsworth, Hampshire PO10 7QU



Architectural Design & Planning

1:50

JULY '15 15/1084/2