




proposed side (East) Elevation (A1 1:50 A3 1:100)



proposed rear (South) Elevation (A1 1:50 A3 1:100)



proposed front (North) Elevation (A1 1:50 A3 1:100)

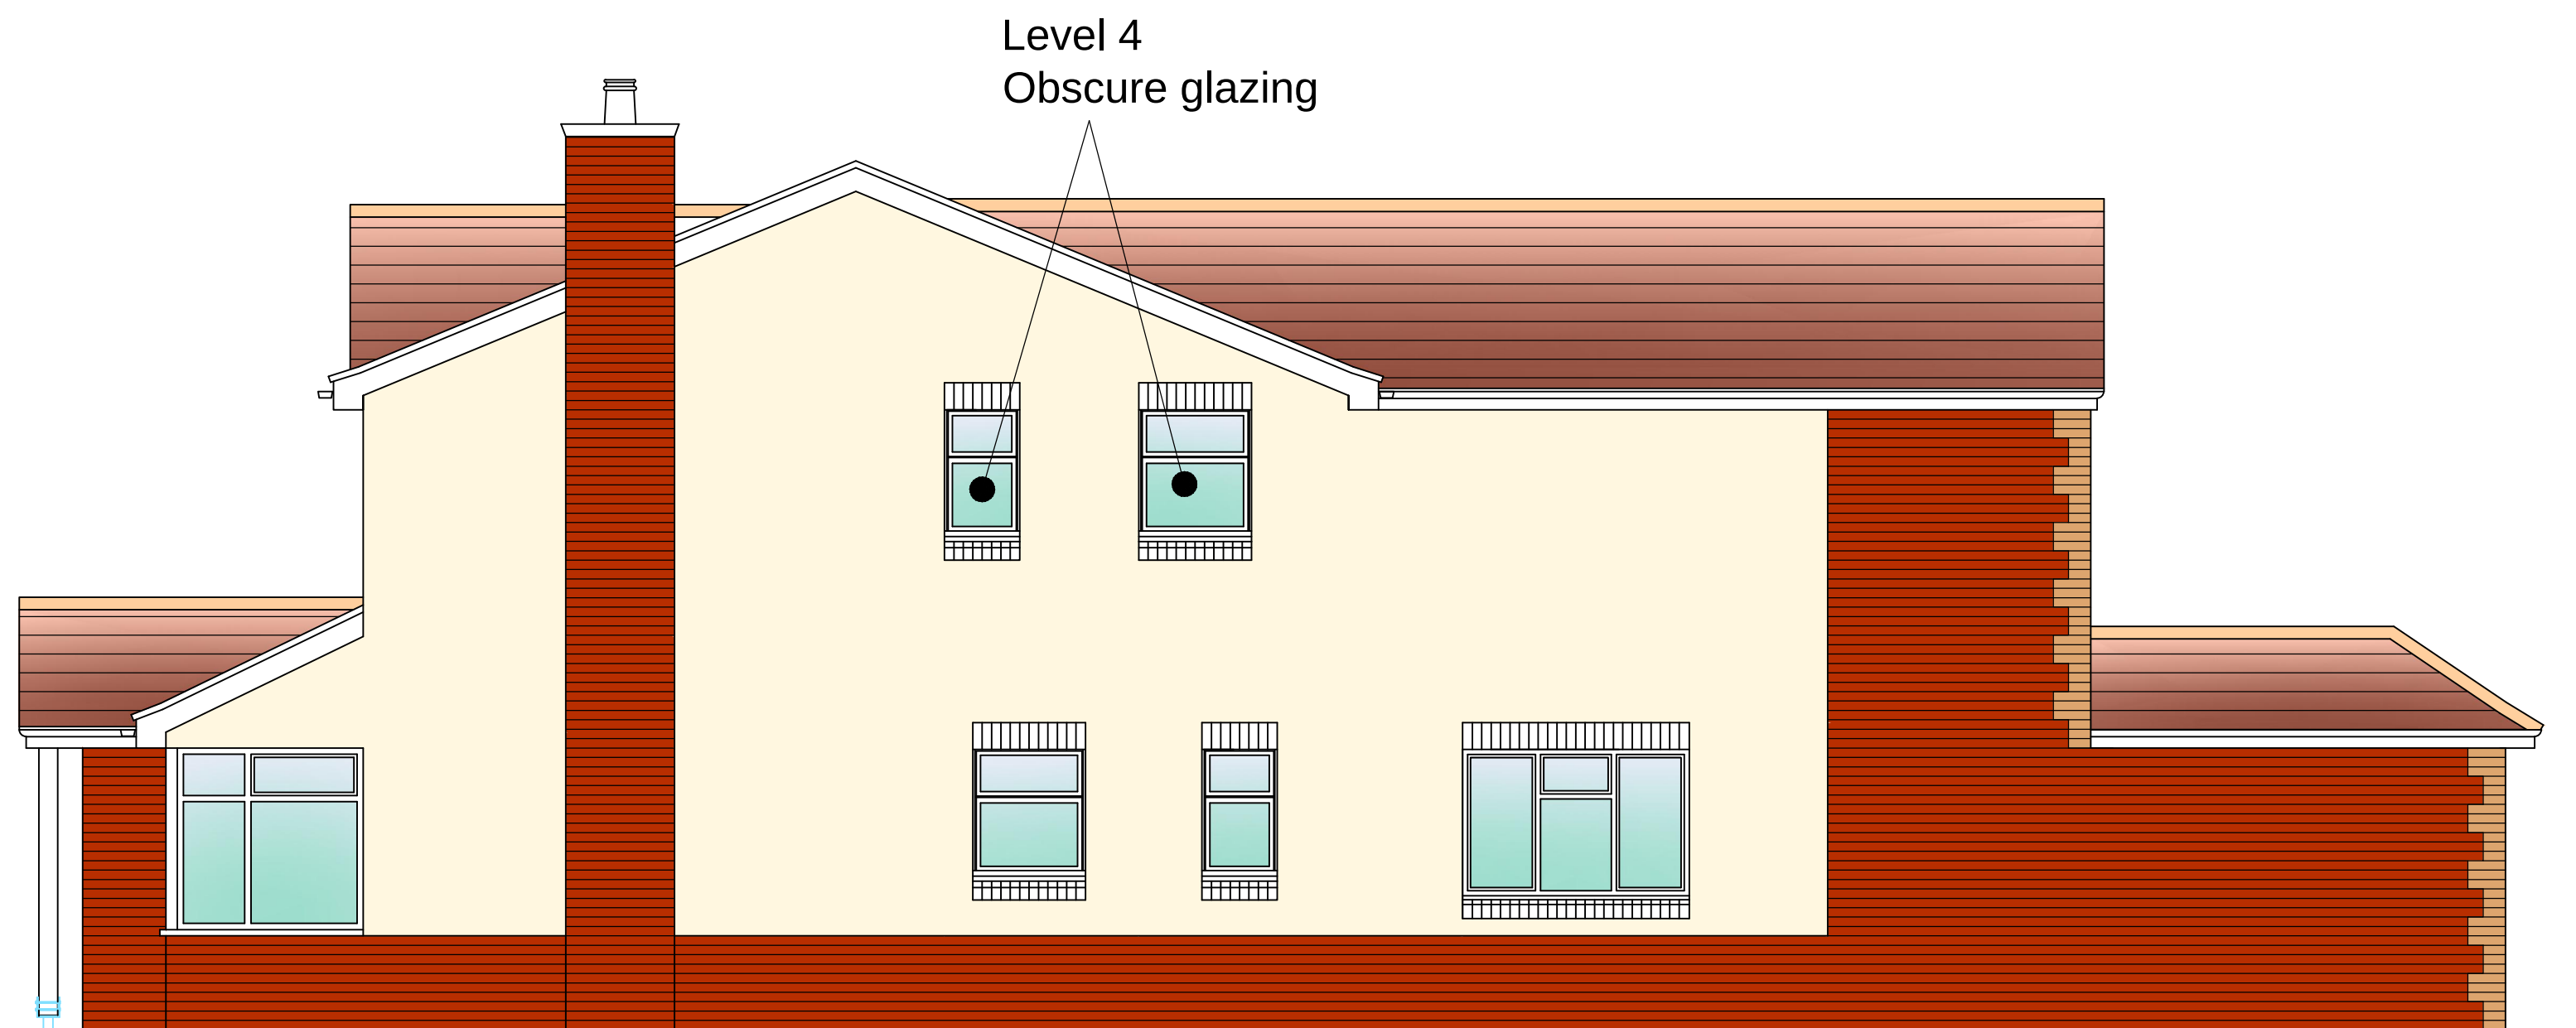

proposed side (West) Elevation (A1 1:50 A3 1:100)

revision	notes	date	drawn	check	revision	notes	date	drawn	check	revision	notes	date	drawn	check	client	notes
A	Material amendments to elevations	22.01.10	mmh													this drawing is the copyright of the Holman Reading partnership llp and must not be reproduced in whole or part or used for the execution of works without their permission.
B	West Elevation amended	24.03.15	mmh													all dimensions to be checked on site prior to commencement of construction works and the architect notified of any discrepancy.
C	Elevations amended as-built	05.05.2015	mmh													figured dimensions are to be used in preference to scaled dimensions.
																no deviation from this drawing will be permitted without prior consent of the architect.
																all drawings are prepared subject to a full measured and structural survey of the buildings and site.
																all structural work is subject to the appointment of a structural engineer to confirm and agree the structural proposals.
																os promap licence no. 100020449.
																scale width 100mm @ a1 - 50mm @ a3

hrp

architects

holman reading

partnership llp

18 Limberline Spur

hilsea, portsmouth, hampshire, po3 5hj

tel: 023 9269 1843

fax: 023 9263 9722

email: info@hrp-architects.com

website: hrp-architects.com

project	Proposed alterations 36 Fernhurst Road Hayling Island			drawn	mmh		checked			
				date	Dec 09		status	Planning		
detail	Proposed elevations			a1 scale	50		a3 scale	100		rev
								8141 -03		C