





NOTES:
Dimensions to be checked on site before commencing work.
Any discrepancies shall be reported to the architect immediately.
Do not scale from these drawings except for planning purposes.
Use figured dimensions only.
Where applicable this drawing is to be read in conjunction with other consultants' drawings.
All drawings to be read in conjunction with specification and all other drawings including structural engineer and mechanical and electrical drawings / specification

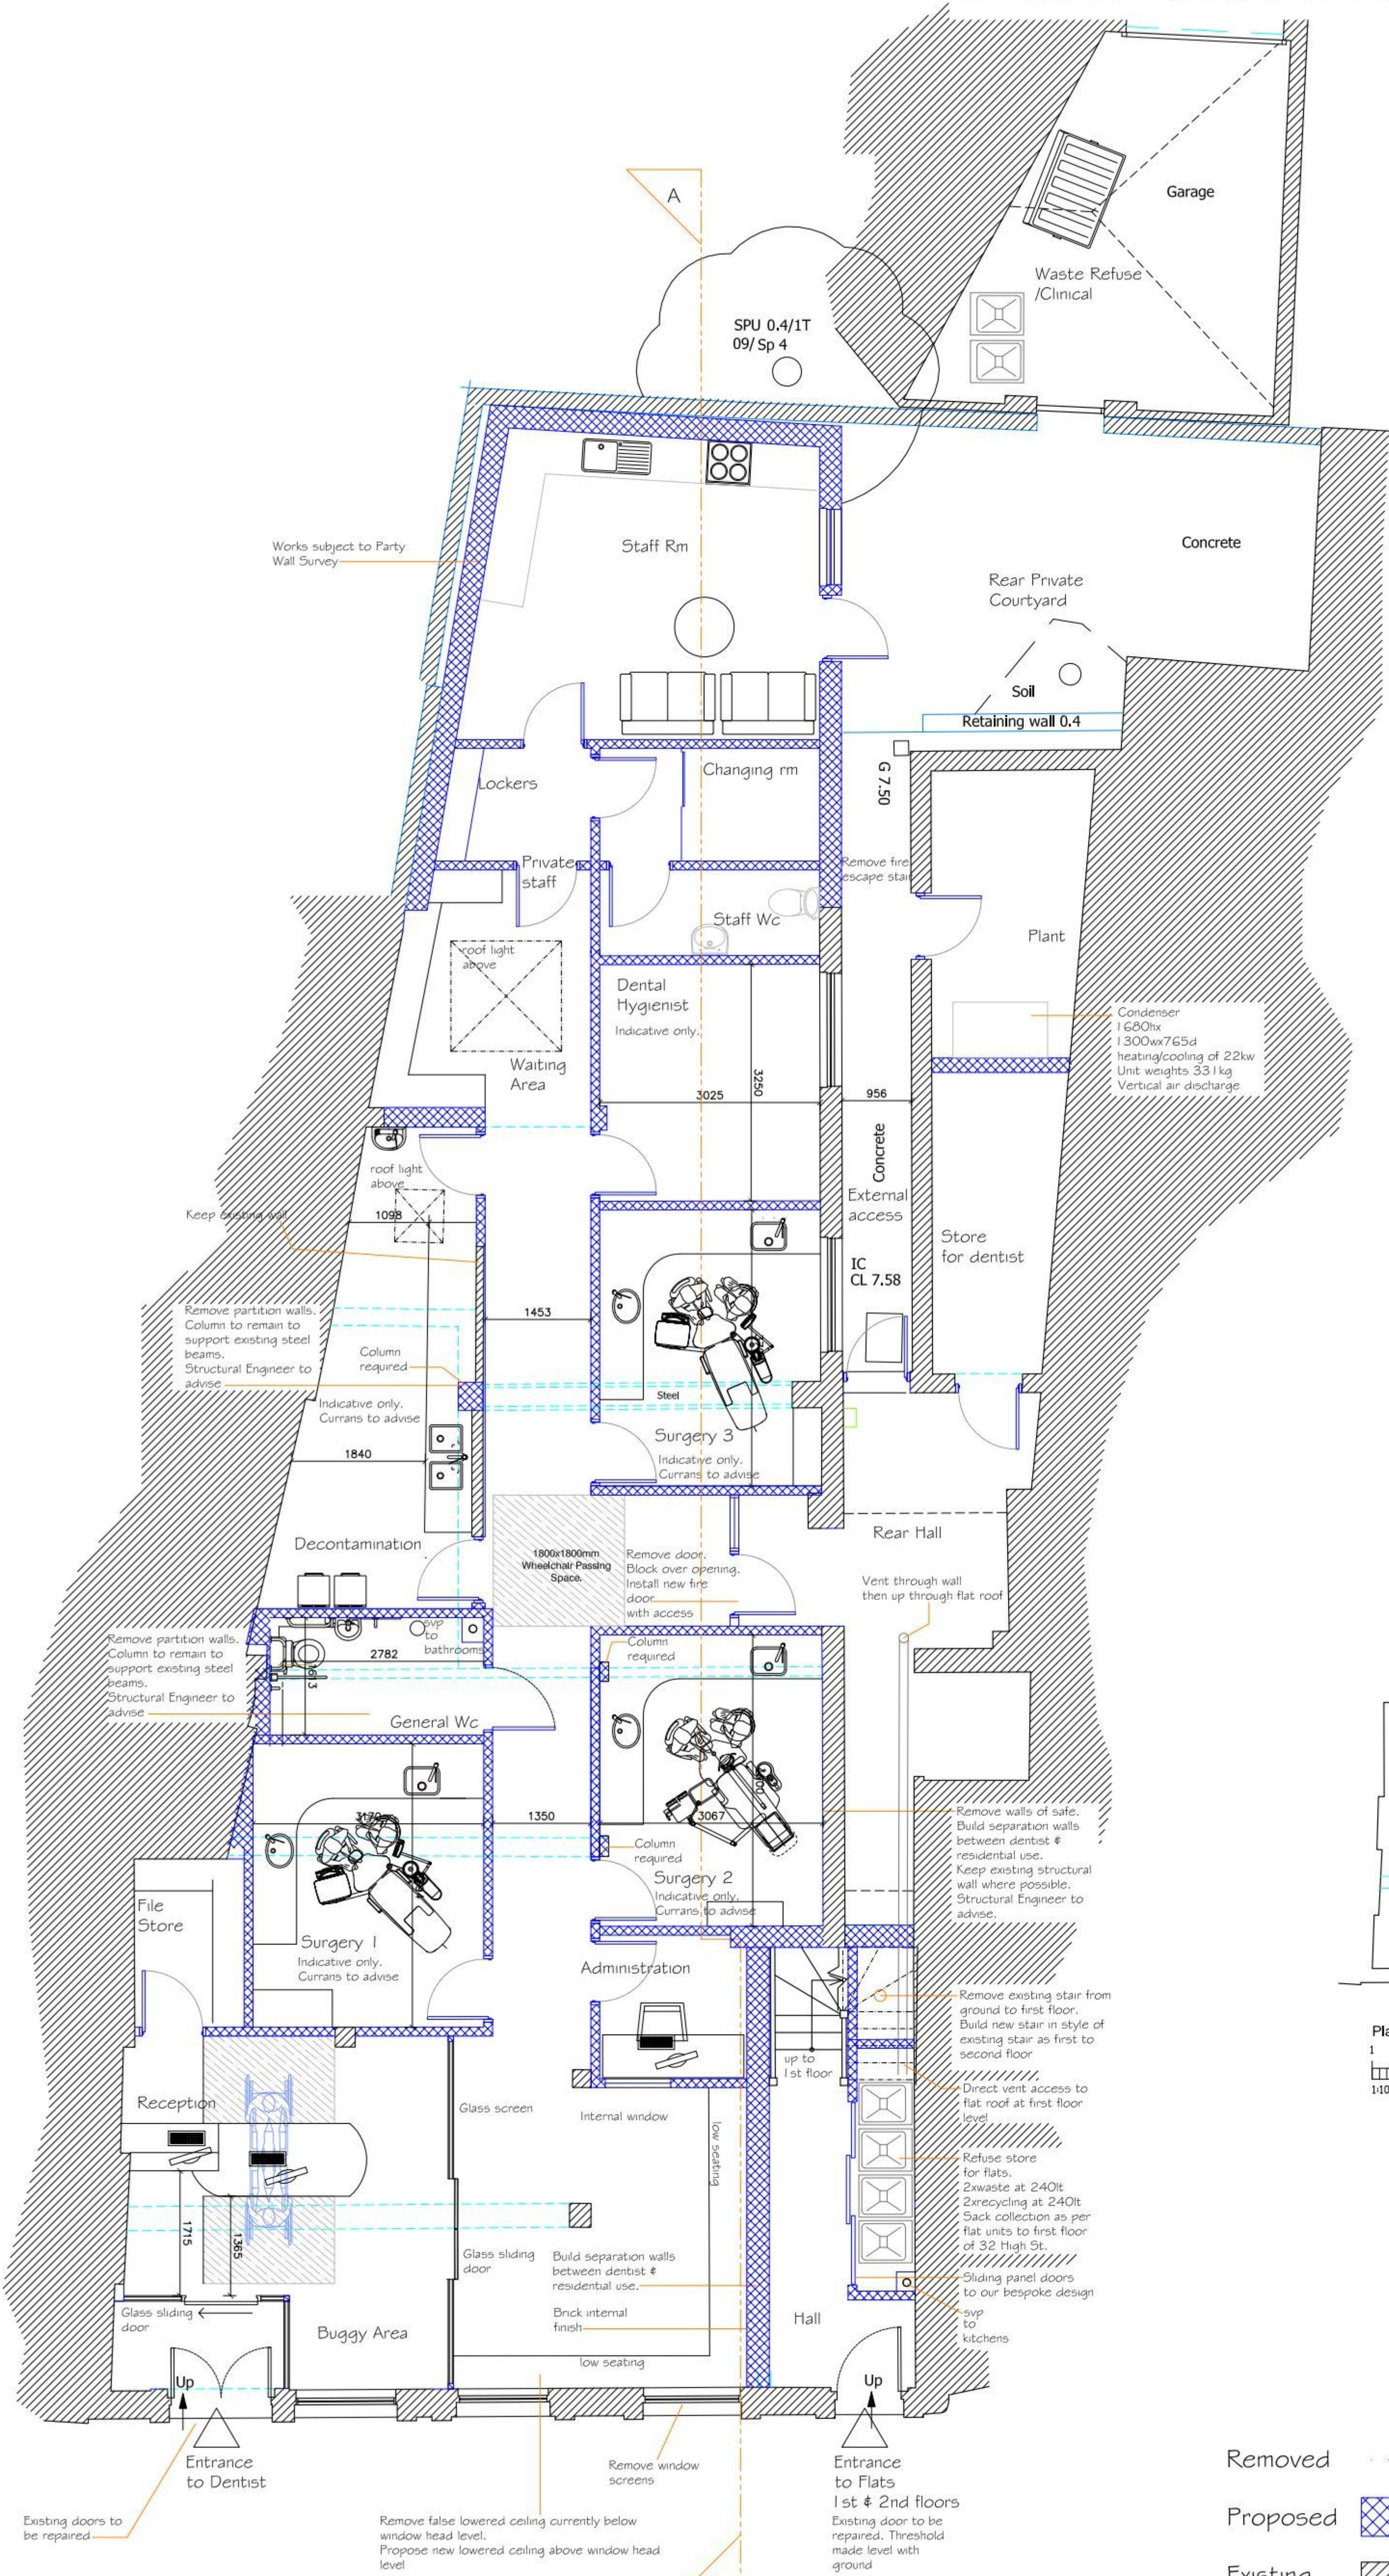

GROUND FLOOR
demolitions plan

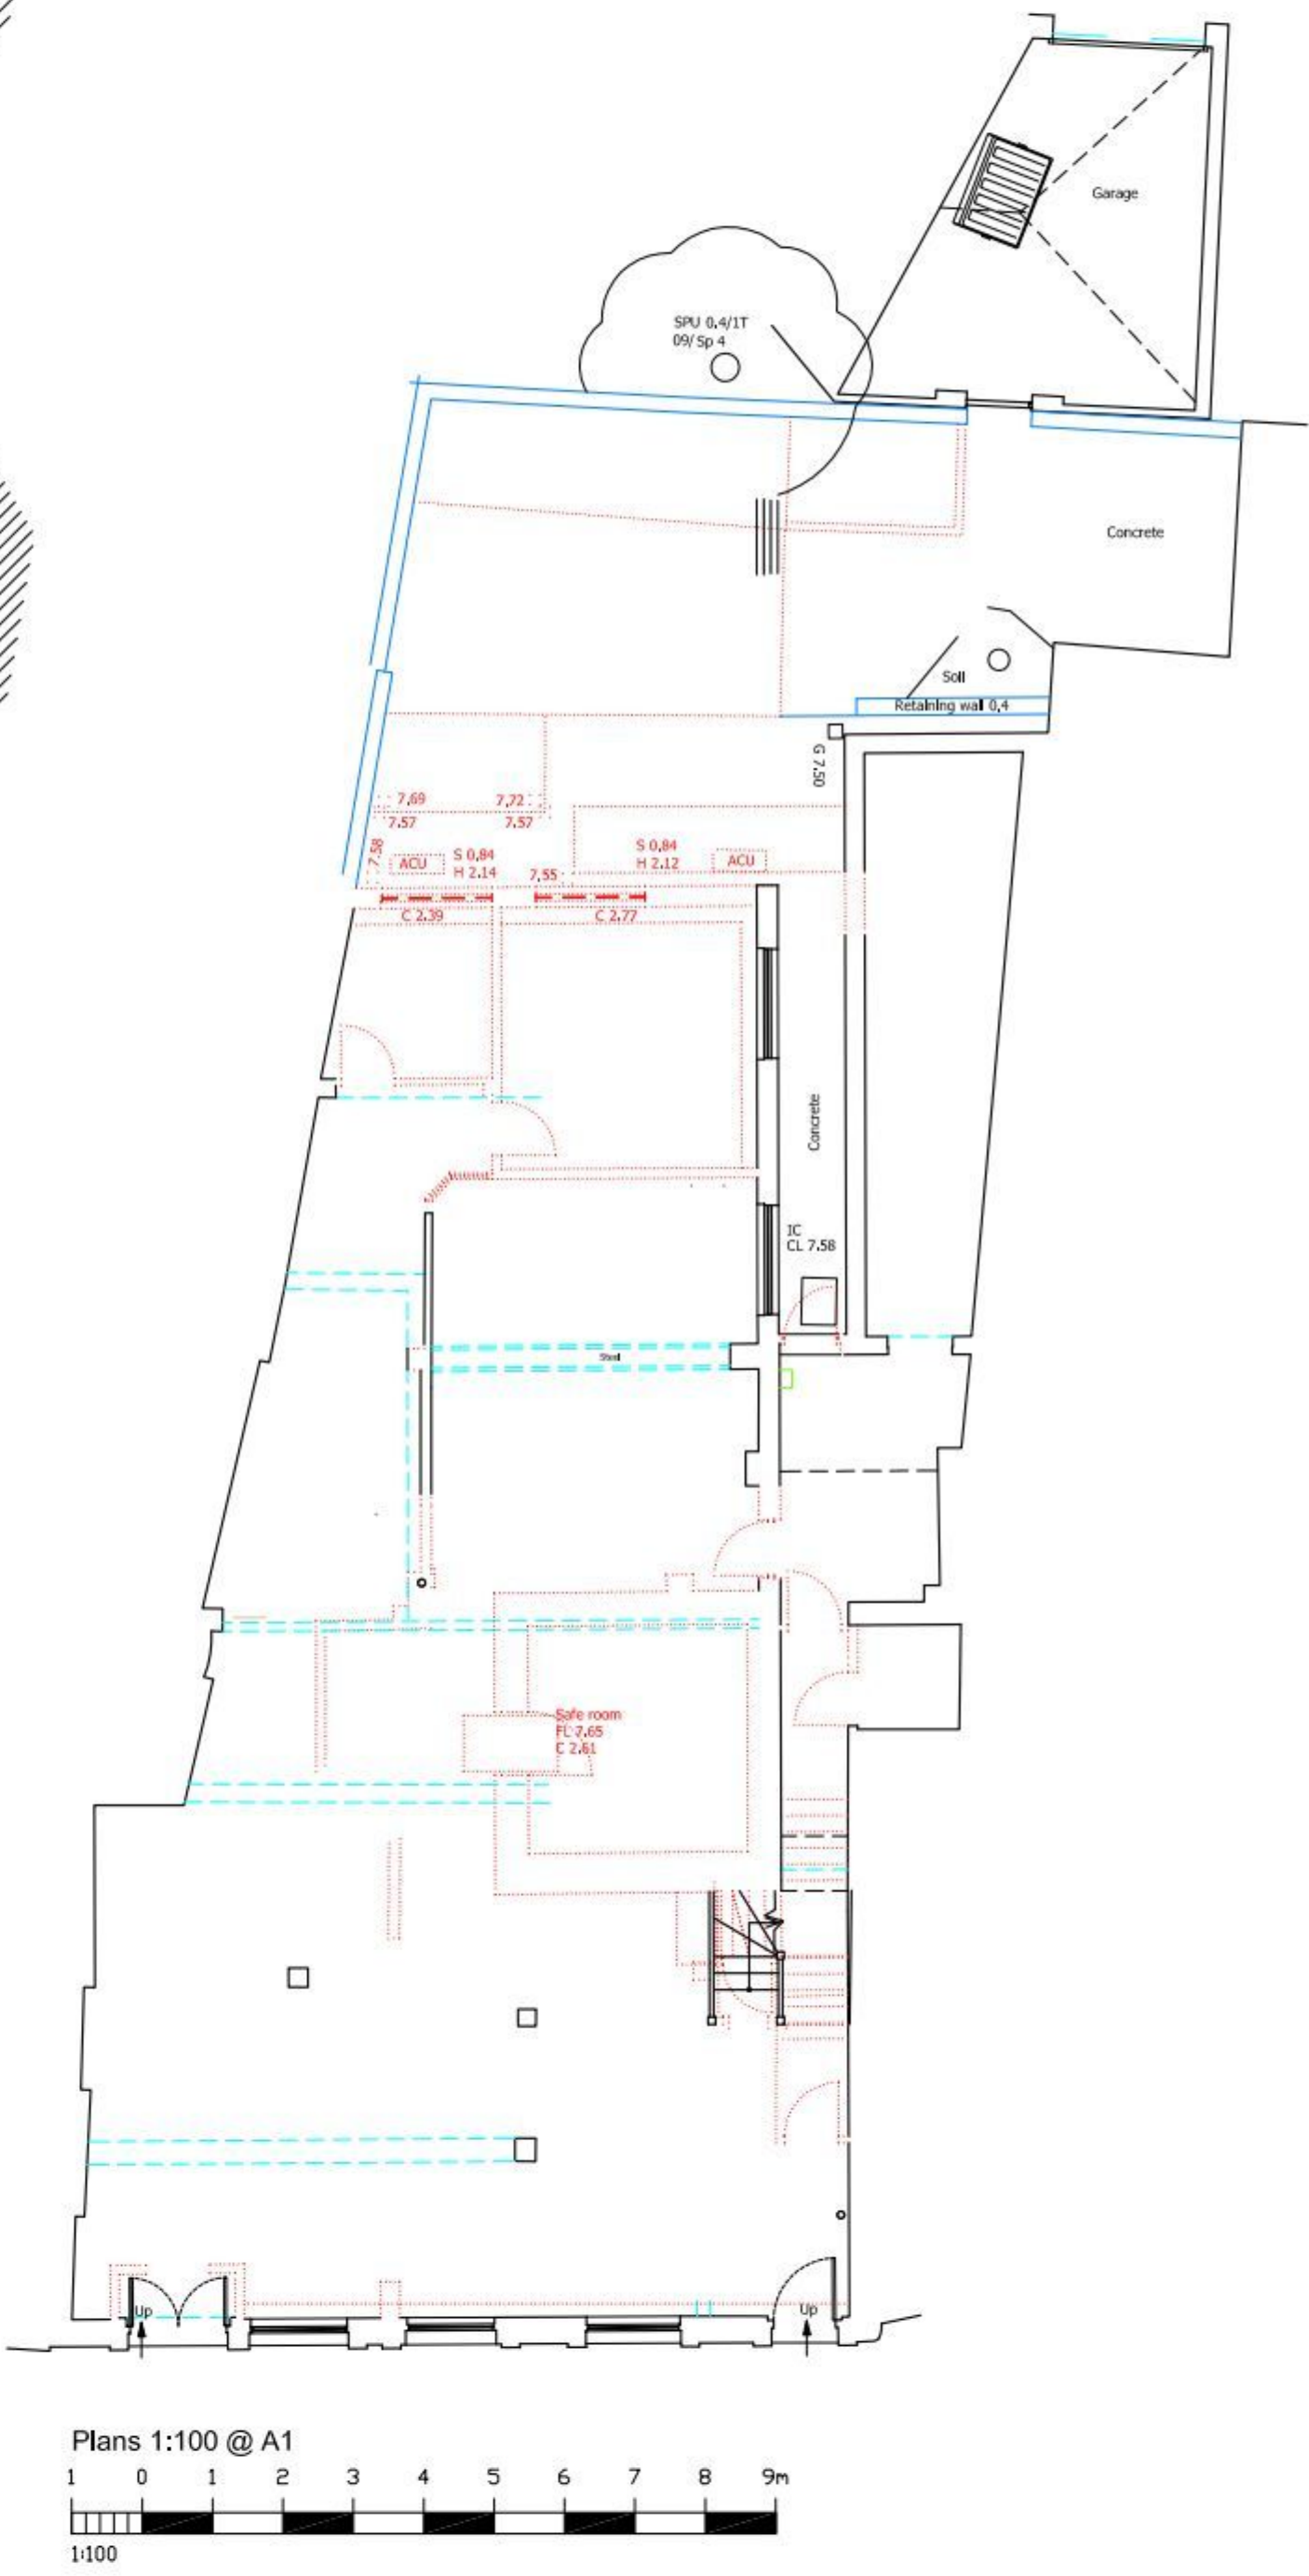

GROUND FLOOR
plan

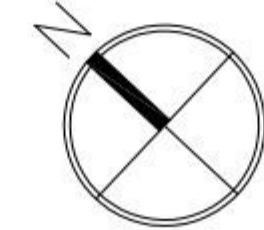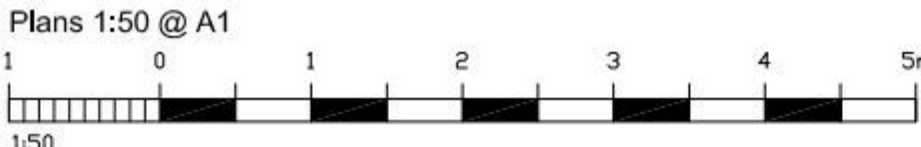

- Removed
- Proposed
- Existing
- Beams

REV	DATE	AMENDMENT	DRAWN
1	01/11/15	Initial Design	KJL
2	02/11/15	Revised Design	KJL
3	03/11/15	Final Design	KJL
4	04/11/15	As Built	KJL

hd architects	Helyer Davies Architects Ltd 1 The Old Flour Mill, Emsworth, PO10 7BT 01243 370 715 www.hdarchitects.co.uk mail@hdarchitects.co.uk
CLIENT Emsworth Dental Surgery	
PROJECT 30 High Street, Emsworth, Hampshire, PO10 7AR	
DRAWING Proposed Plans	SCALE as noted at A1
DATE March 2015	DRAWN KJL
DRAWING NUMBER 15-027_02_Planning	REVISION *