



NOTE
1. Refer to following drawings
Dwg No 10 Foundations
11 First Floor
12 Roof Plan

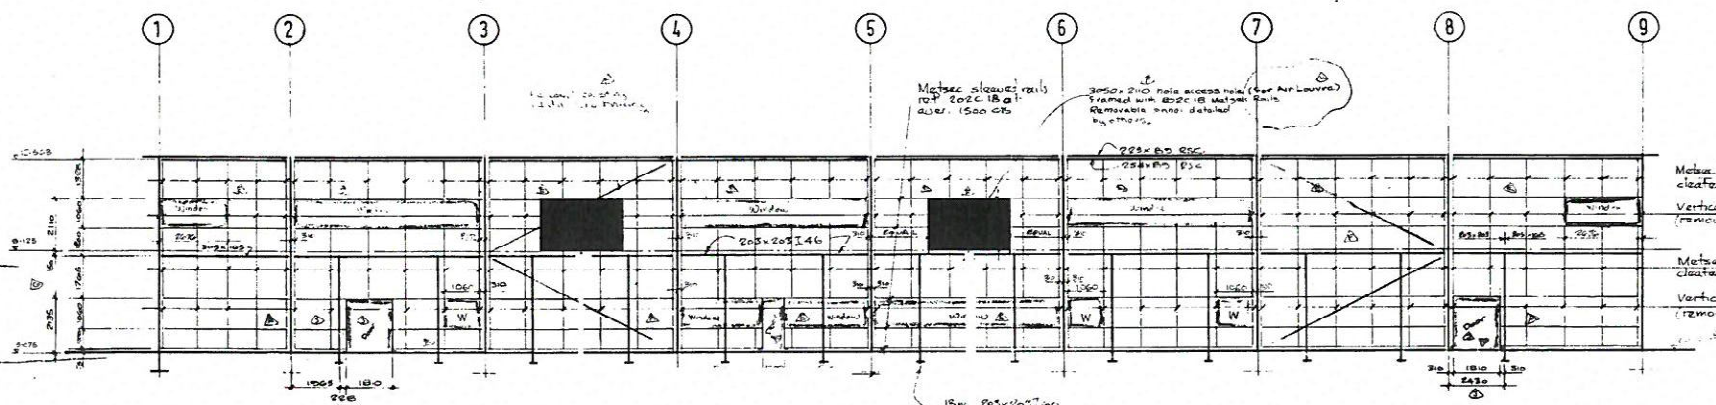


(GRID-A): WEST ELEVATION

Metsec slotted C-section rails complete with vertical end rails at 1500 c/c approx. Provide all necessary prepping work and to manufacturers requirements.

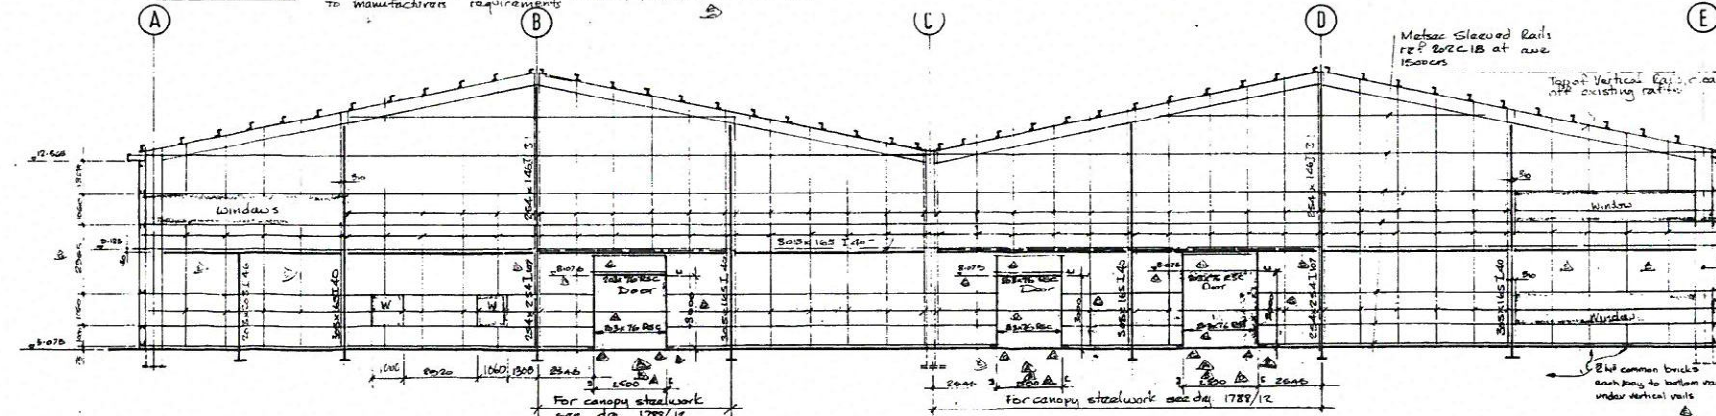


(GRID-9): SOUTH ELEVATION

Vertical mini-zed rail positioned to suit architects requirement.

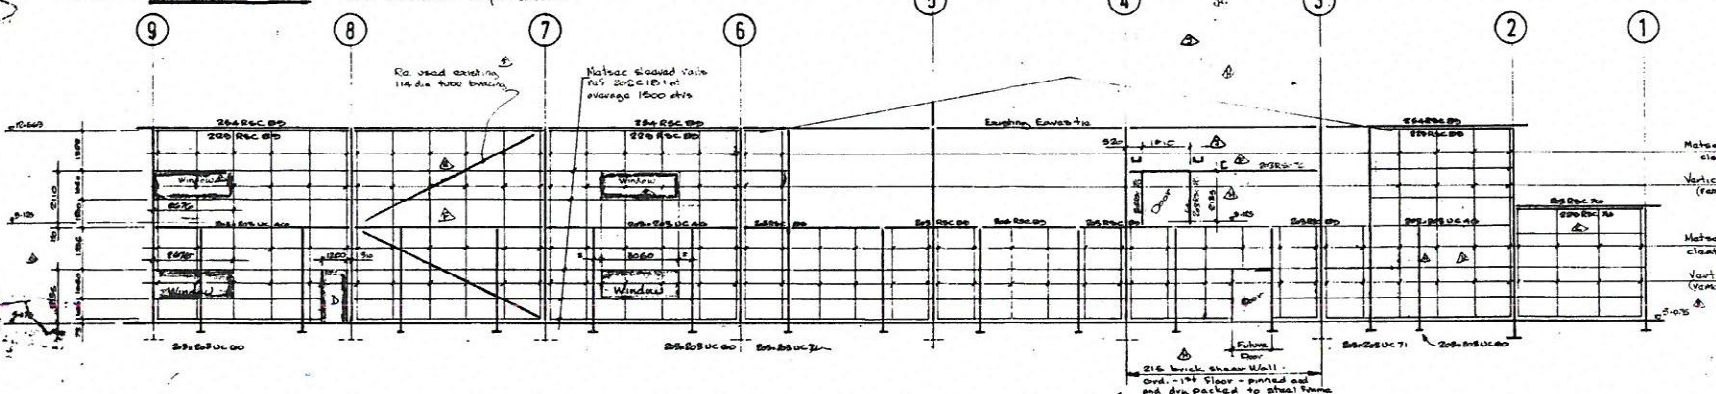


(GRID-E): EAST ELEVATION

(Note as West Elevation above)

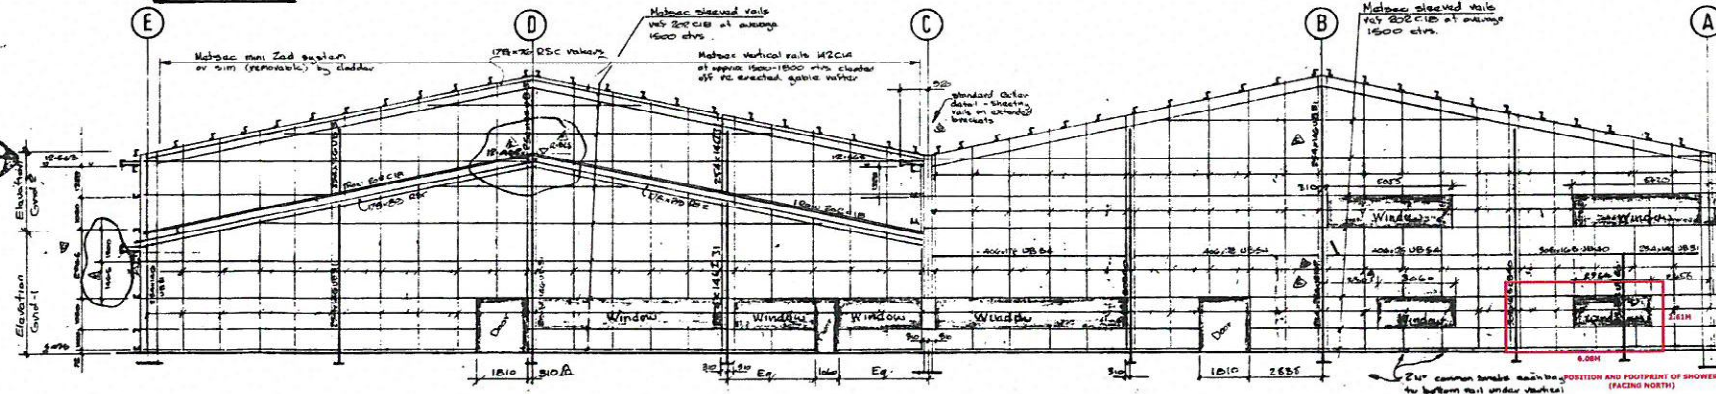

(GRID-1): NORTH ELEVATION

Vertical mini-zed rails positioned to suit architects requirement.

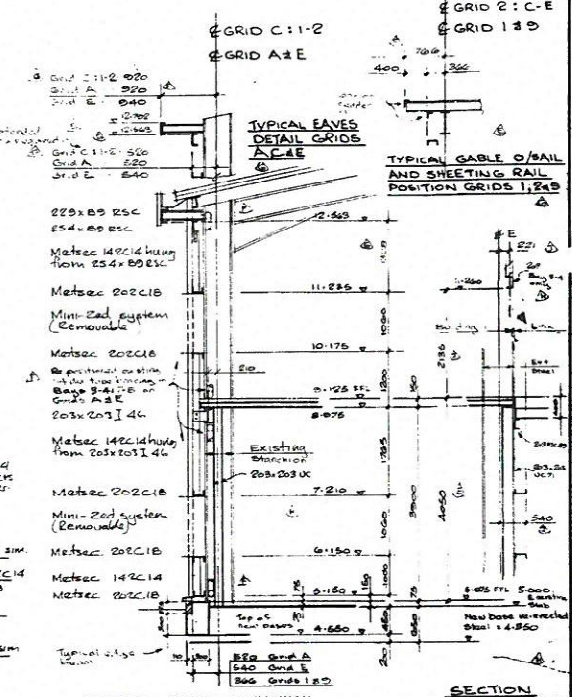

SECTION - WEST ELEVATION
(EAST ELEVATION SIMILAR)

SECTION - LINE E (LINK)

- REV. K. North Elevation/Level corrected 8/1/85
- REV. J. West Elevation/Level corrected 8/1/85
- REV. I. Section Line E corrected 8/1/85
- REV. H. Section Line E corrected 8/1/85
- REV. G. Drawings & Levels added to Elevation 8/1/85
- REV. F. Drawings & Levels added to Elevation 8/1/85
- REV. E. Additional windows added to Elevation 8/1/85
- REV. D. Drawings & Levels added to Elevation 8/1/85
- REV. C. North Elevation/Level corrected 8/1/85
- REV. B. Section Line E corrected 8/1/85
- REV. A. East & North Elevation/Level corrected 8/1/85

W.D. STONE ASSOCIATES LTD
Consulting Civil Structures and Services Engineers

WARINGS CONTRACTORS LTD.

APOLLO FIRE DETECTORS
BROOKSIDE ROAD
HAVANT.
BUILDING 1-ELEVATIONS

PAUL JONES, ARCHITECT, HAVANT, HANTS

Scale 1/100 Date JULY 85

Number	1785	17
Revision	8 K	

RECEIVED
12 SEP 1985
DRAWING & PRINTING
REGISTRAR

RECORD COPY
DO NOT DESTROY