





Front Elevation (North)

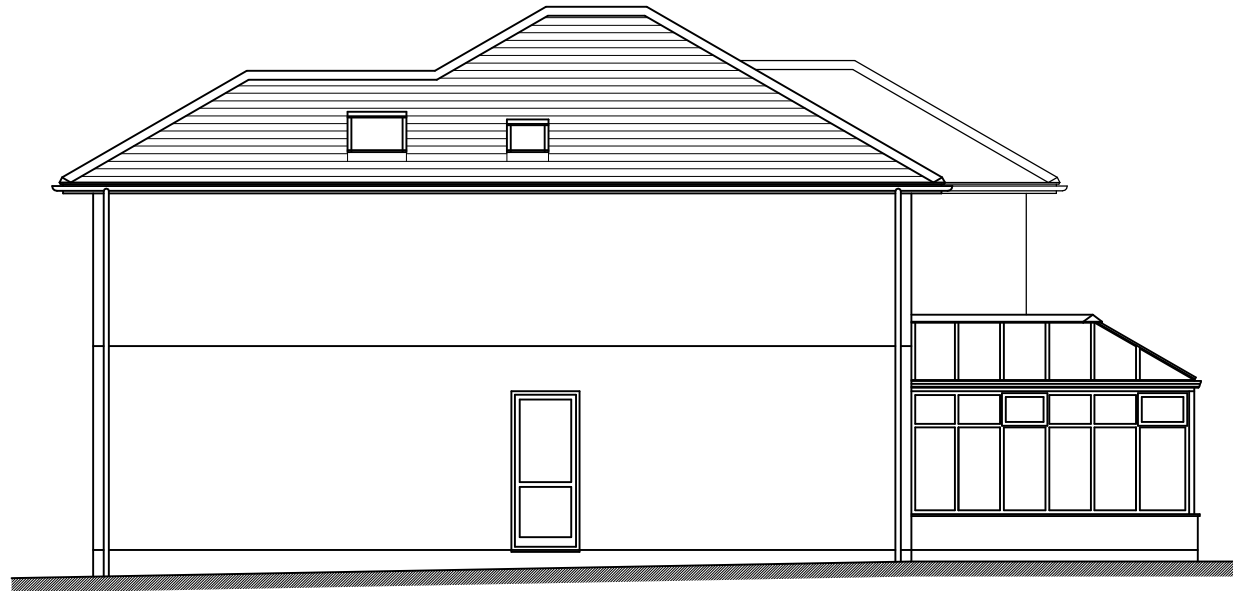


Side Elevation (West)

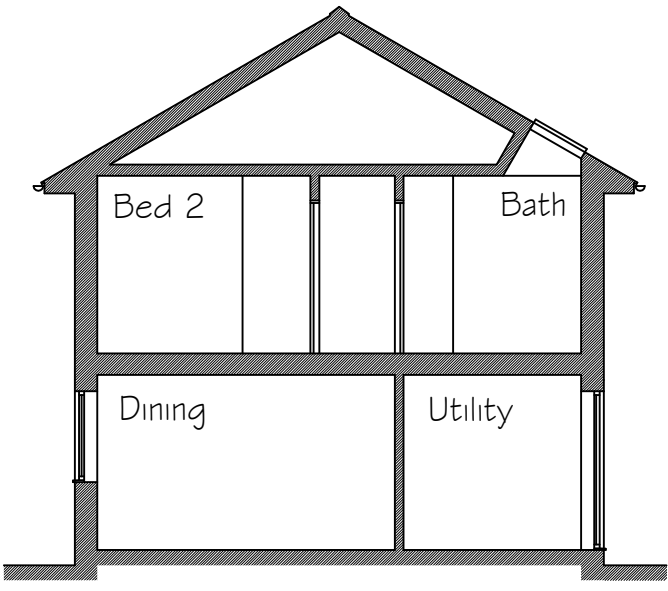

Section A-A




Rear Elevation (South)

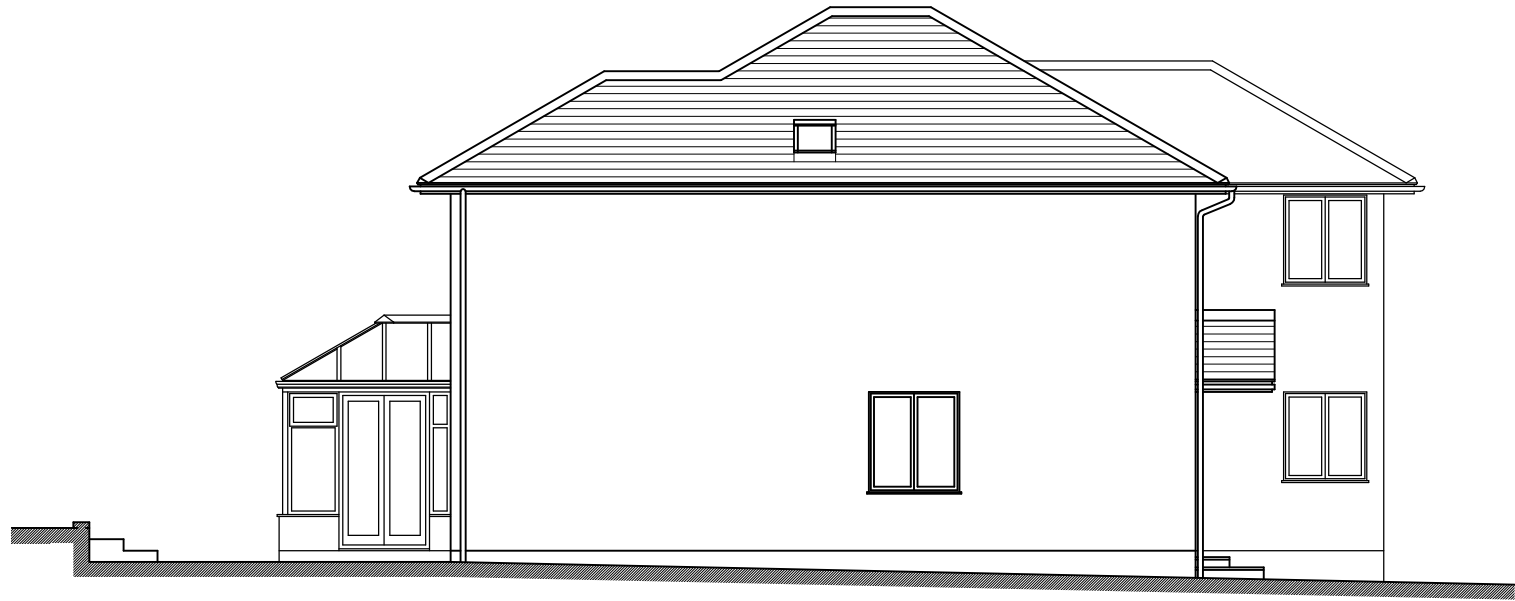

Side Elevation (East)

See separate schedule for details of external materials

Plots 1 & 2 Houses Similar

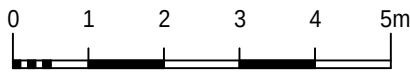

This drawing is the copyright of the Architect and must not be reproduced without permission, except by the Local Planning Authority for planning purposes. Figured dimensions to be taken in preference to scaled. Dimensions to be checked on site before work commences. No deviation from this drawing will be permitted without the prior written consent of the Architect. Ground floor slabs, foundations, structure, etc., and all work below ground is shown provisionally and inspection of ground conditions is essential prior to work commencing. Reassessment is essential when the ground conditions are apparent and redesign may be necessary in the light of soil conditions found. The responsibility for establishing the soil and subsoil conditions rests with the Contractor.	drawing		drawing no.		rev.	date	scale(s)	sheet size
	PROPOSED ELEVATIONS & SECTION (PLOTS 1 & 2 SIMILAR)		21303/04		B	JUL 2013	1:100	A3
	project		client					
	2 NO. DETACHED 4 BED REPLACEMENT DWELLINGS AT 20 THE CRESCENT WATERLOOVILLE, HAMPSHIRE PO7 5EU		MEADOWLANDS NEW HOMES LTD.					
	JEFFREY DOUGLAS CHARTERED ARCHITECT		 JEFFREY DOUGLAS CHARTERED ARCHITECT 114 Havant Road Havant Island Hampshire PO11 0LJ Tel: (023) 9246 8889 E-mail: jdd@jeffreydouglas.co.uk					

B - 1st floor window added where omitted in error. 31-07-2015
A - Updated to show as-built project. 09-07-2015

revisions date