


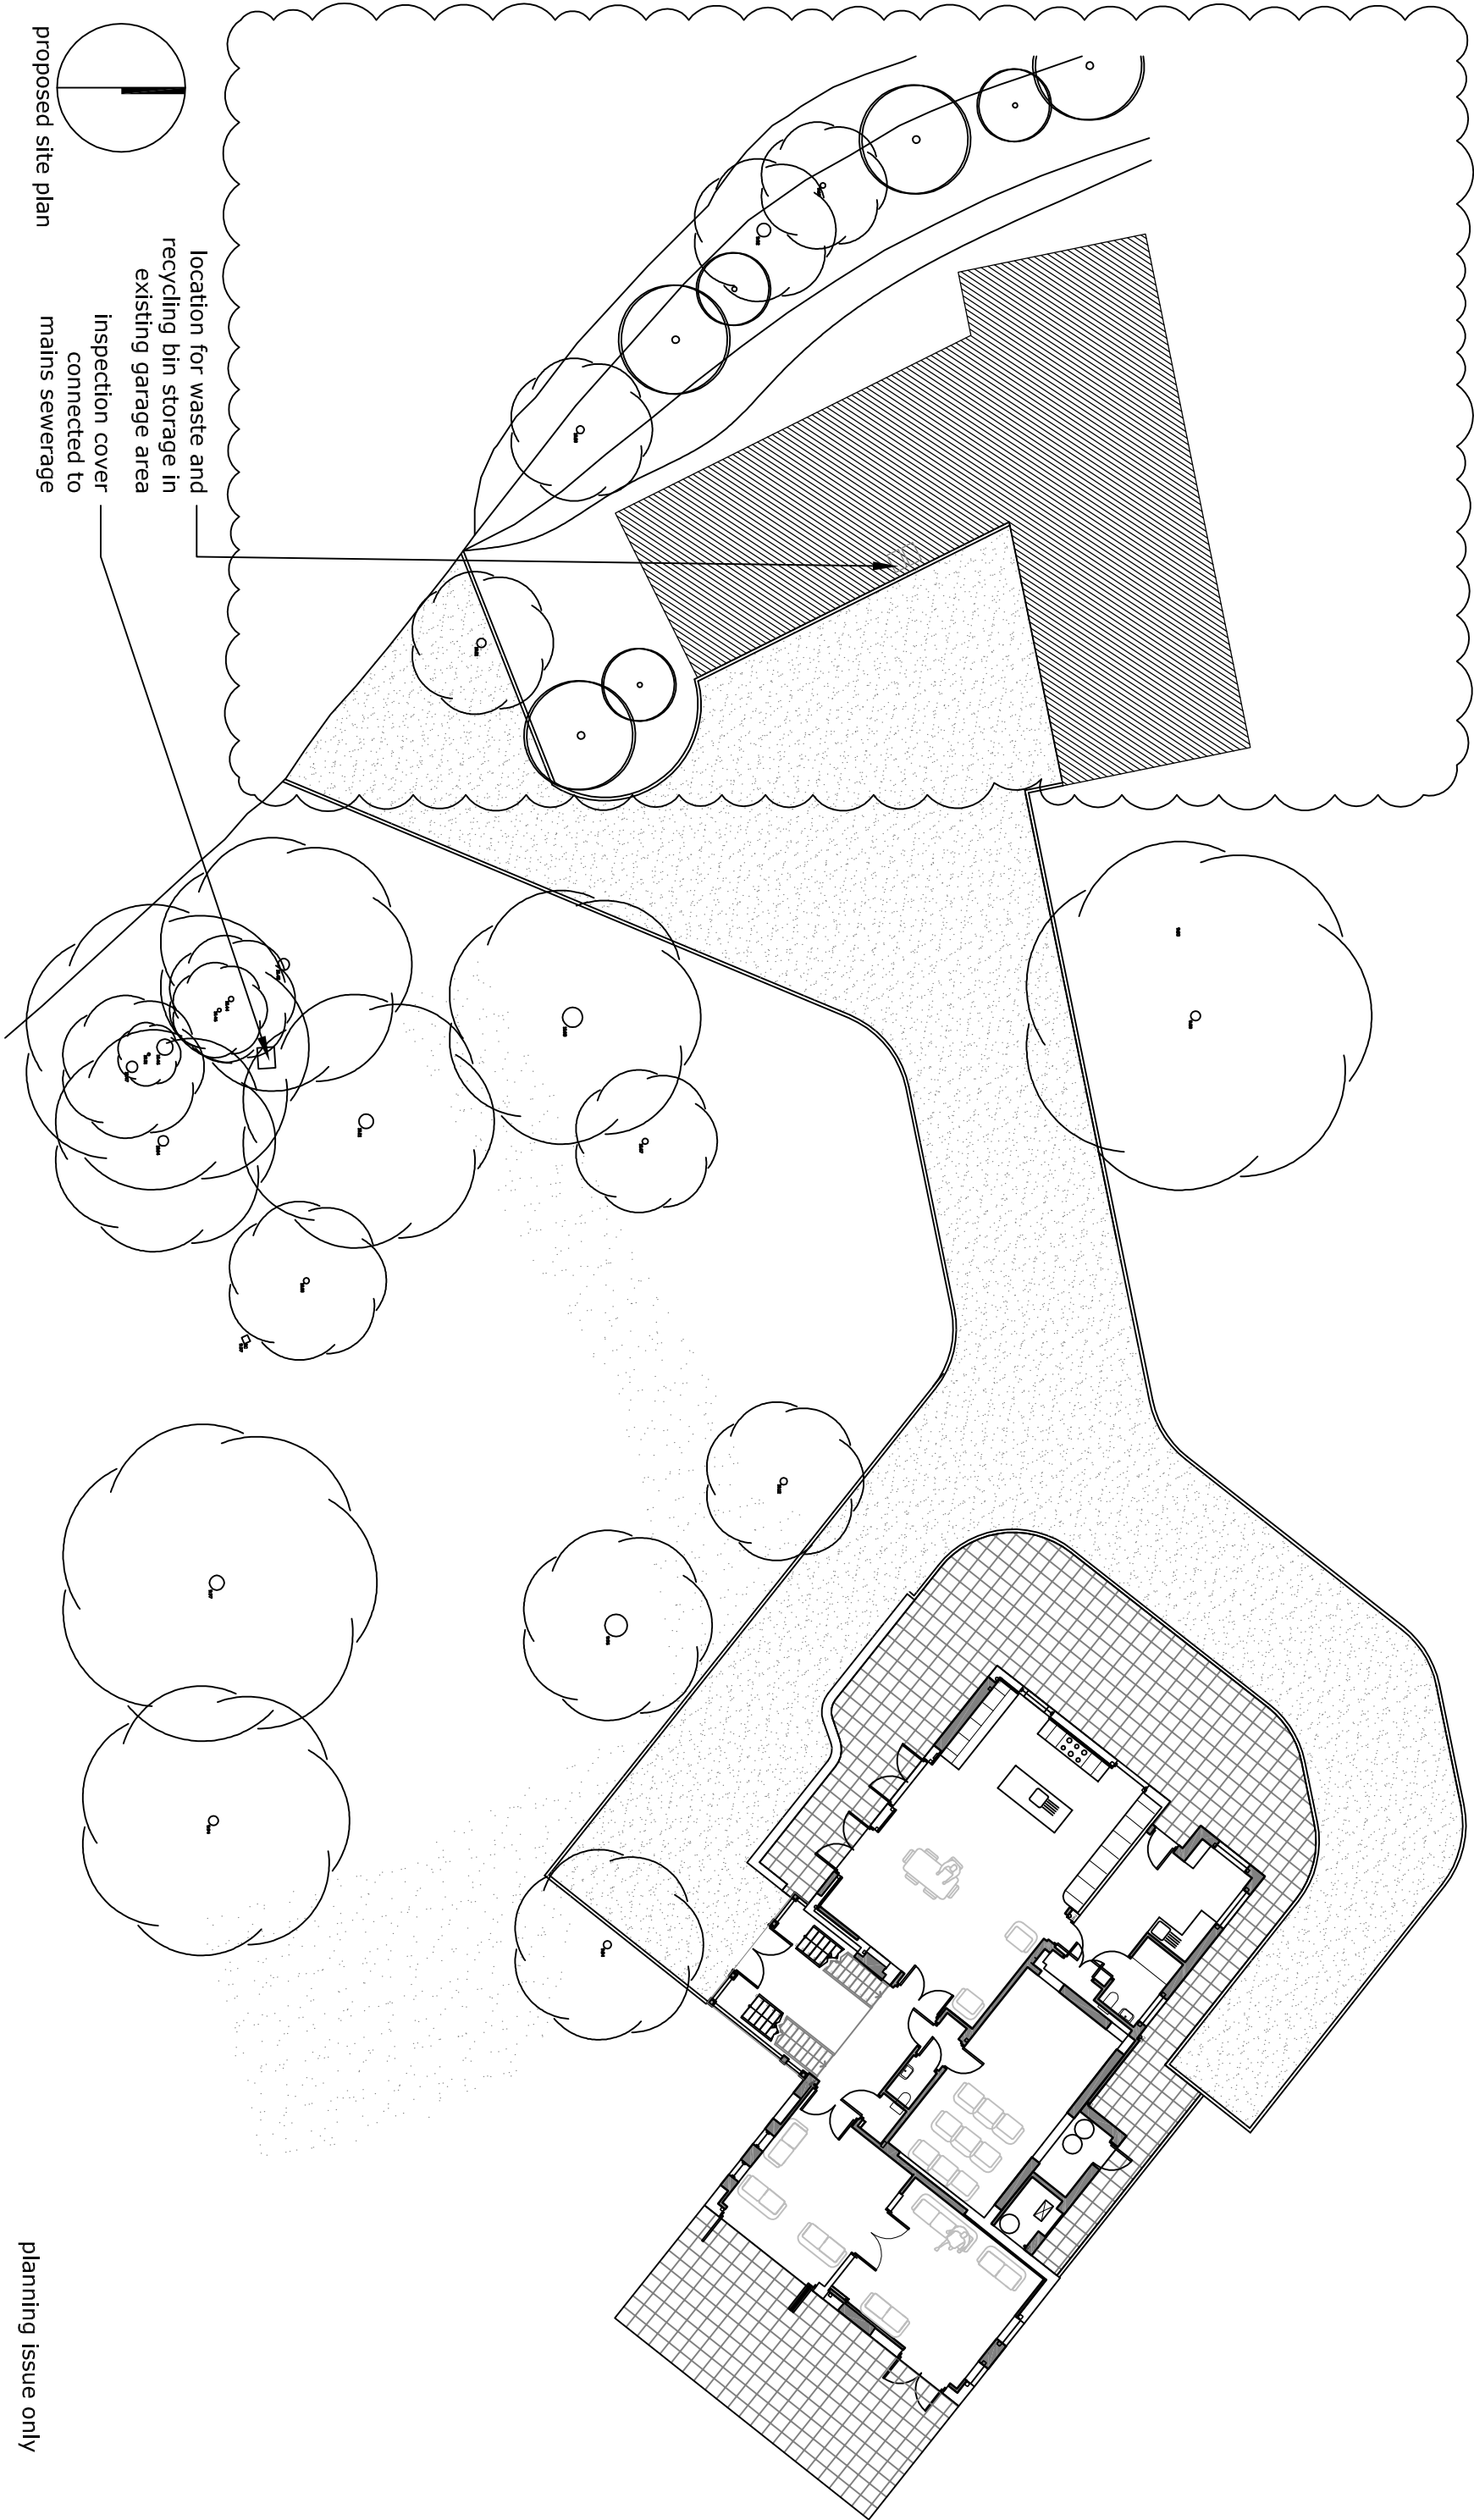

this drawing is not for

construction

this drawing is the

property of:

dwell design

28 beaconsfield avenue

cosham

portsmouth

po6 2pt

revisions

a/30.09.2013/measured line of hedge shown

b/27.10.14/updated for new application

scale bars

1:200



scale

1:200 @ A3

job name

Oak House

date

sept 12

job number

13011

drawing number

(pl)09

drawing name

proposed site plan

status

planning

revision

b

dwell design ltd