



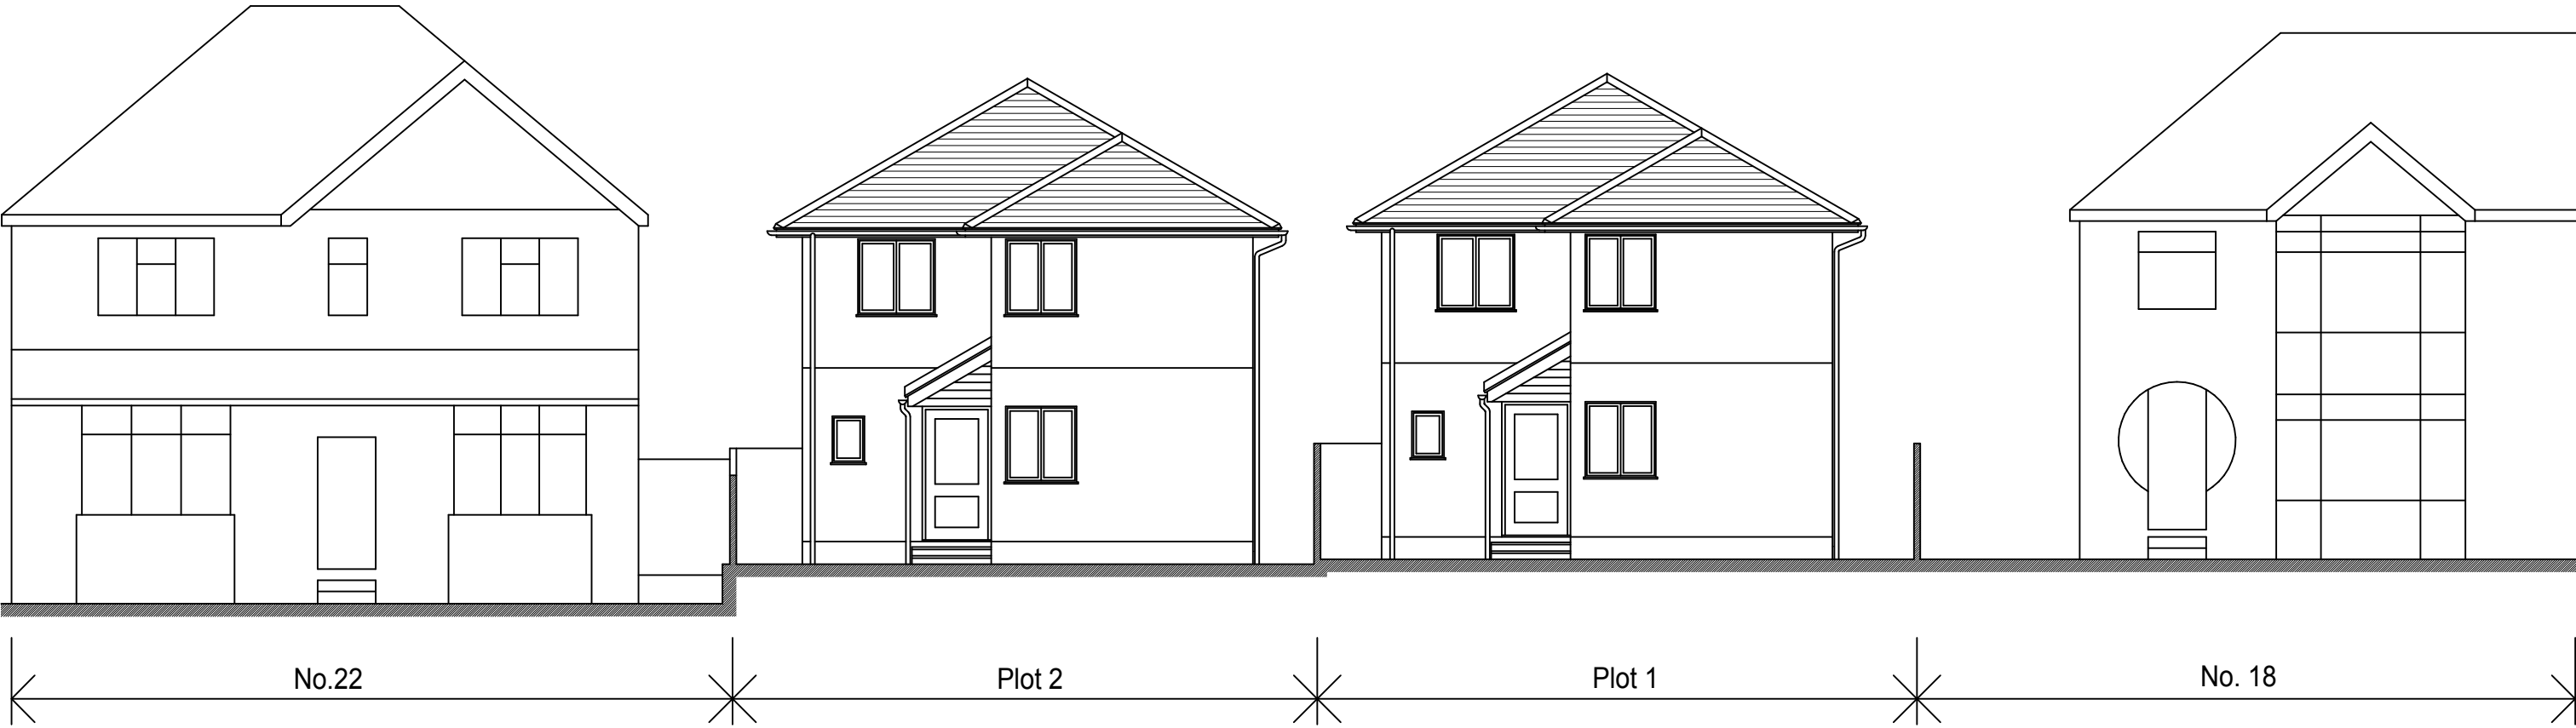

Street Elevation to The Crescent

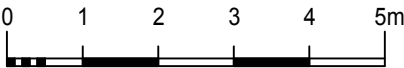

This drawing is the copyright of the Architect and must not be reproduced without permission, except by the Local Planning Authority for planning purposes. Figured dimensions to be taken in preference to scaled. Dimensions to be checked on site before work commences. No deviation from this drawing will be permitted without the prior written consent of the Architect. Ground floor slabs, foundations, structure, etc., and all work below ground is shown provisionally and inspection of ground conditions is essential prior to work commencing. Reassessment is essential when the ground conditions are apparent and redesign may be necessary in the light of soil conditions found. The responsibility for establishing the soil and subsoil conditions rests with the Contractor.	drawing STREET ELEVATION TO THE CRESCENT (NORTH-EAST) project 2 NO. DETACHED 4 BED REPLACEMENT DWELLINGS AT 20 THE CRESCENT WATERLOOVILE, HAMPSHIRE PO7 5EU	A - Updated to show as-built project.		09-07-2015		
		revisions		date		
		drawing no.	rev.	date	scale(s)	sheet size
		21303/05	A	JUL 2013	1:100	A3
		client				
MEADOWLANDS NEW HOMES LTD.						
■ Jeffrey Douglas Chartered Architect  114 Havant Road - Tel: (023) 9246 8889 - Hayling Island - E-mail: jdo@jeffreydouglas.co.uk - Hampshire - PO11 0LJ						