



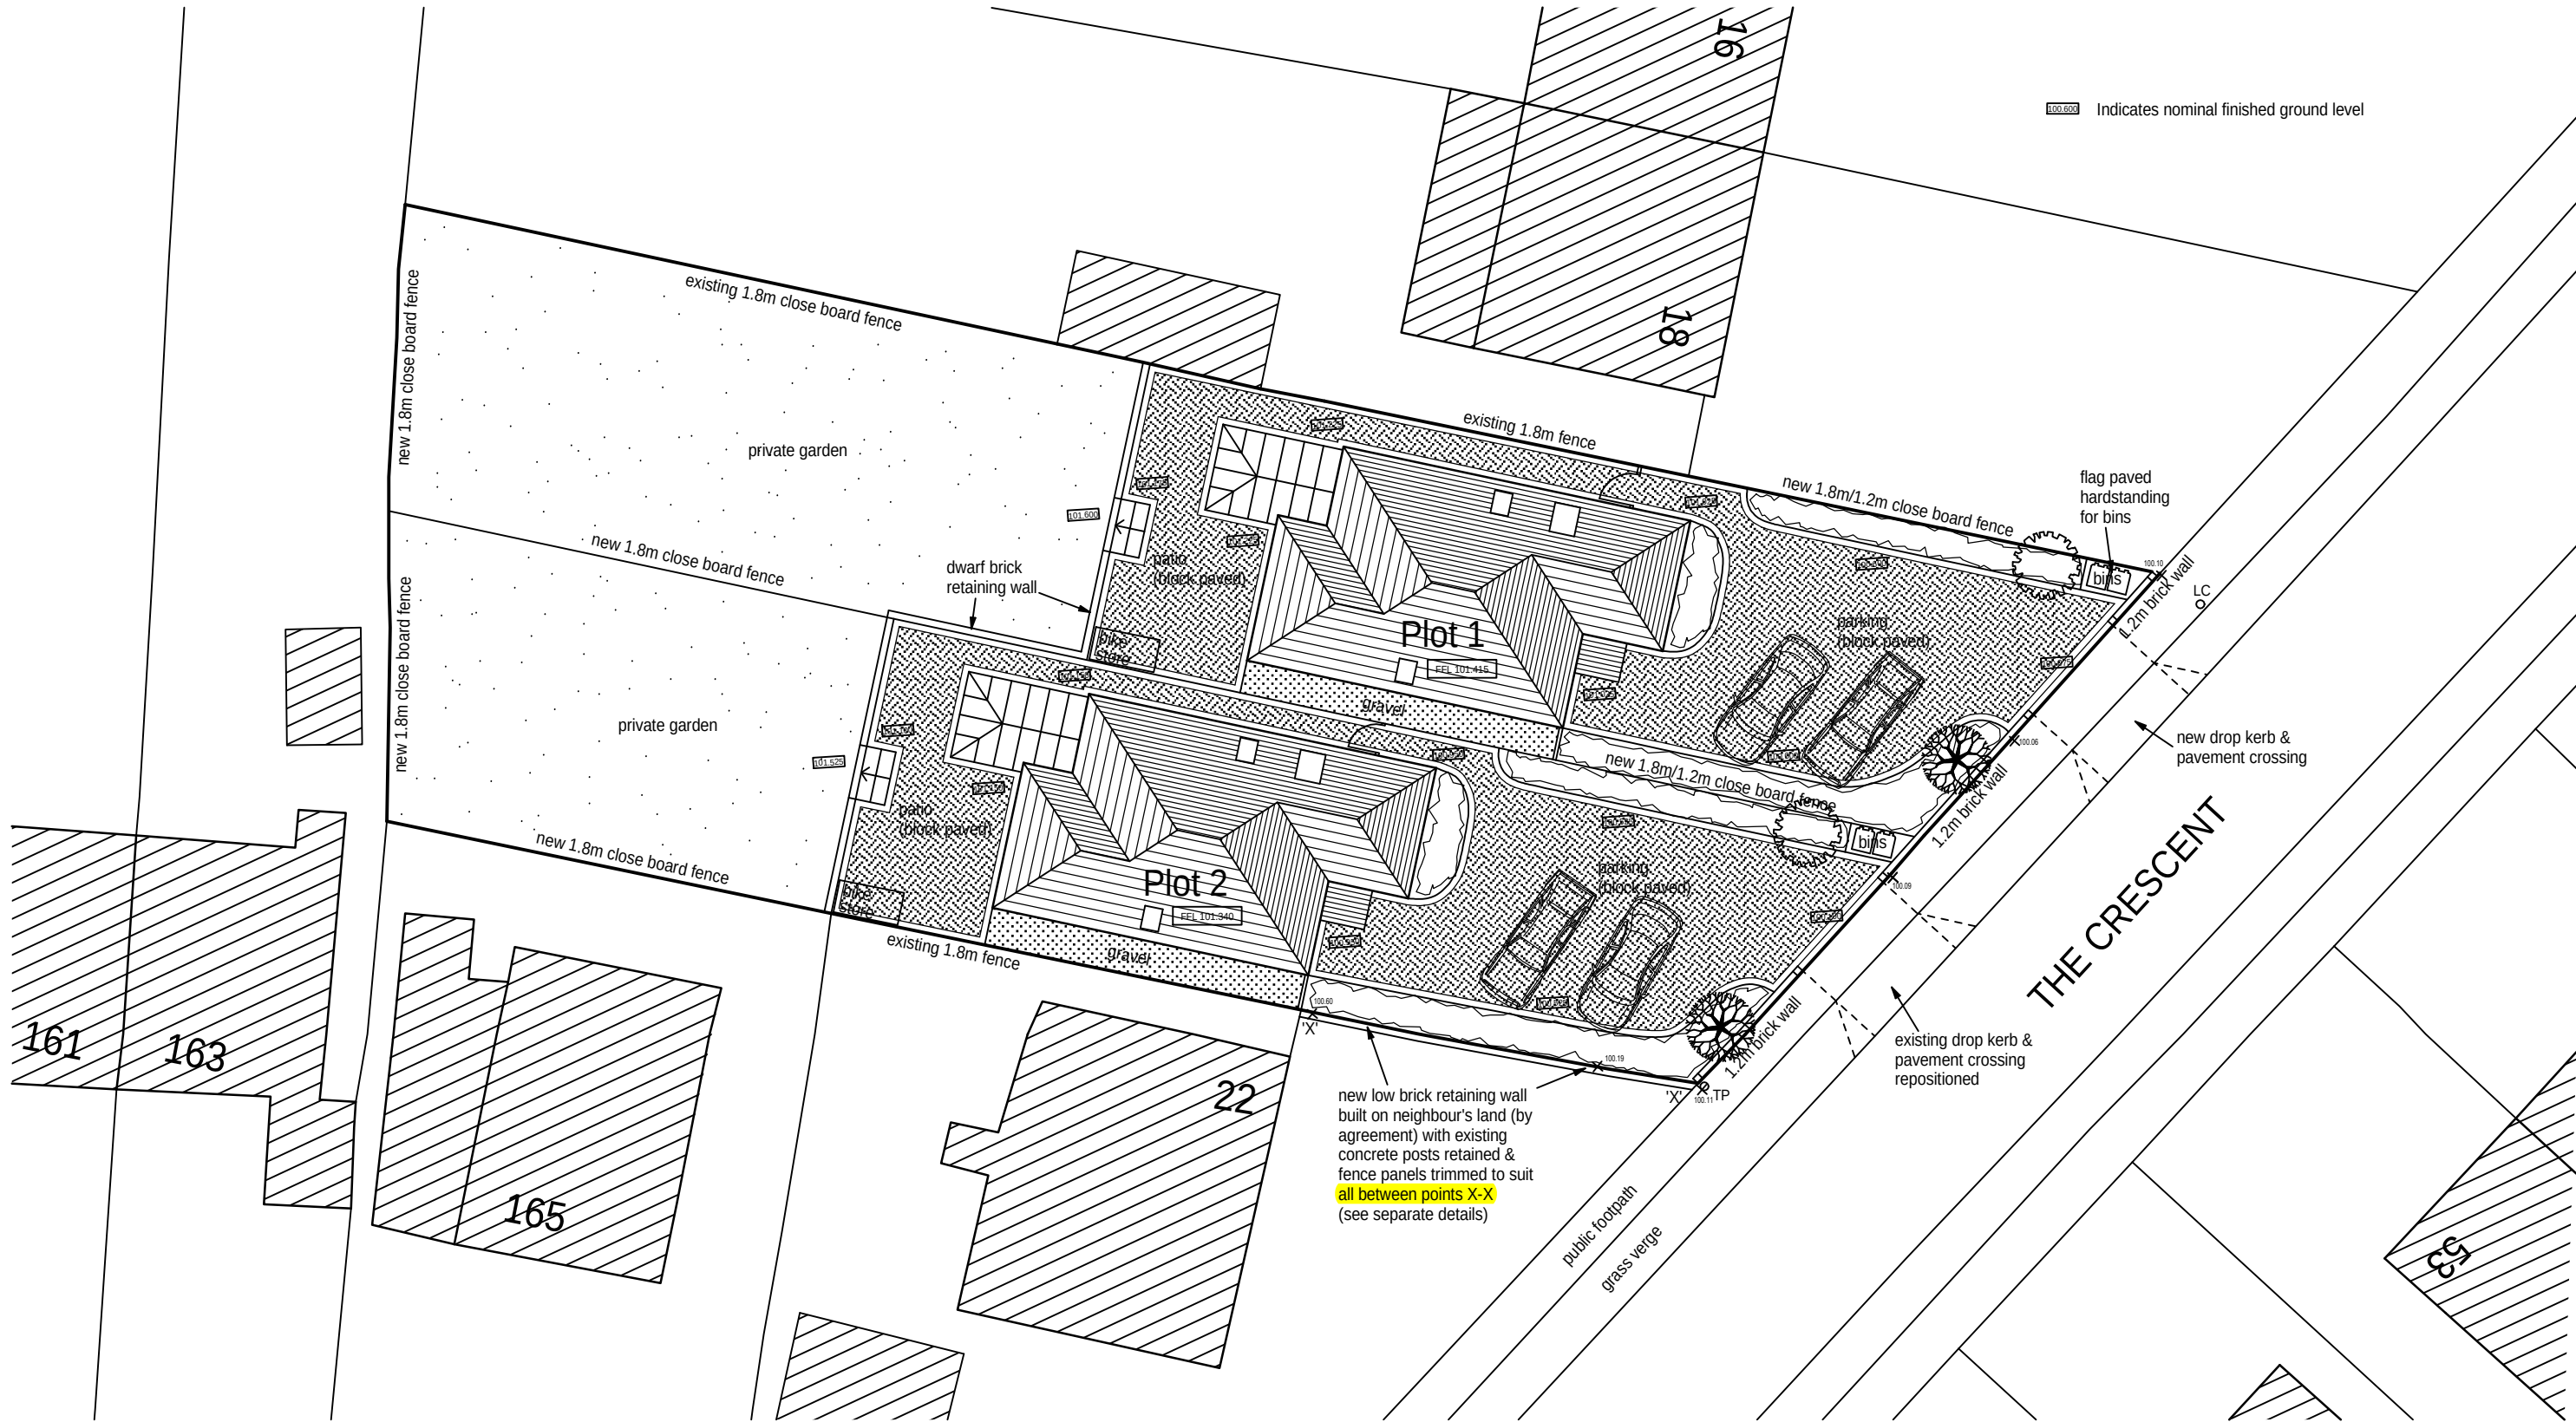

Proposed Site Plan 1:200

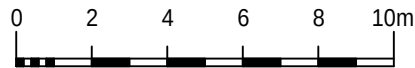

This drawing is the copyright of the Architect and must not be reproduced without permission, except by the Local Planning Authority for planning purposes.

Figured dimensions to be taken in preference to scaled.
Dimensions to be checked on site before work commences.
No deviation from this drawing will be permitted without the prior written consent of the Architect.
Ground floor slabs, foundations, structure, etc., and all work below ground is shown provisionally and inspection of ground conditions is essential prior to work commencing.
Reassessment is essential when the ground conditions are apparent and redesign may be necessary in the light of soil conditions found.
The responsibility for establishing the soil and subsoil conditions rests with the Contractor.

drawing	drawing no. 21303/02			rev. B	date JUL 2013	scale(s) 1:200	sheet size A3
PROPOSED SITE PLAN							
client							
MEADOWLANDS NEW HOMES LTD.							
project							
2 NO. DETACHED 4 BED REPLACEMENT DWELLINGS AT 20 THE CRESCENT WATERLOOVILE, HAMPSHIRE PO7 5EU							
JEFFREY DOUGLAS JEFFREY DOUGLAS Chartered Architect 114 Havant Road Hayling Island Hampshire PO11 0LJ Tel: (023) 9246 8889 E-mail: jdo@jeffreydouglas.co.uk							

B - Extent of work on boundary of No.22 indicated.
A - Updated to show as-built project.
04-08-2015
09-07-2015
date