




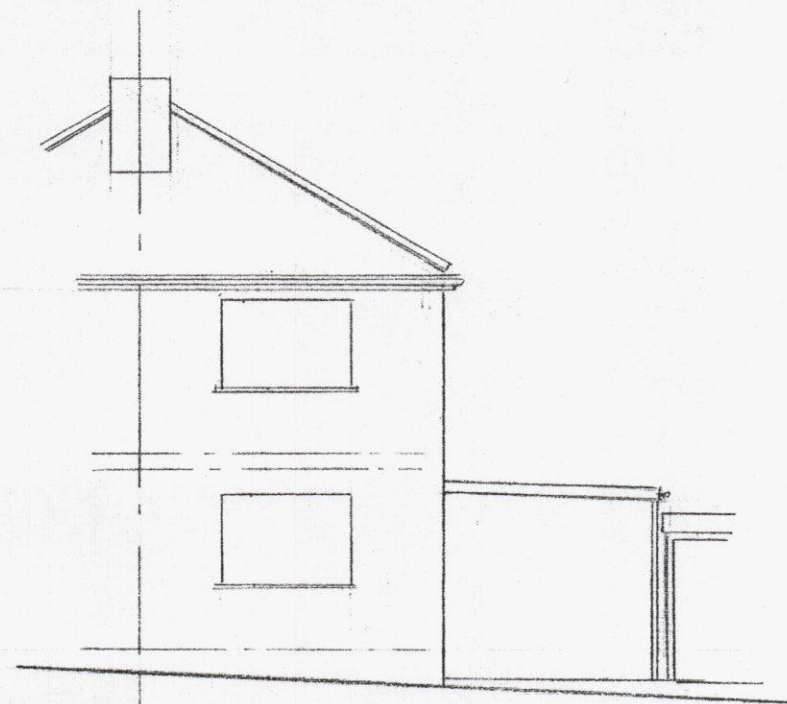


NORTH ELEVATION

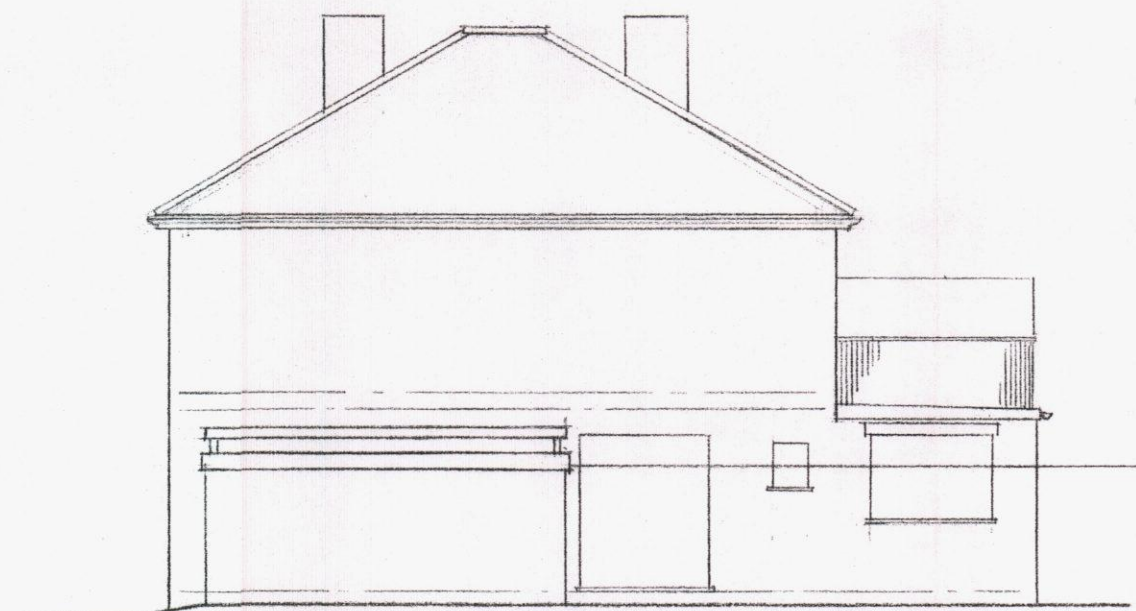


WEST ELEVATION

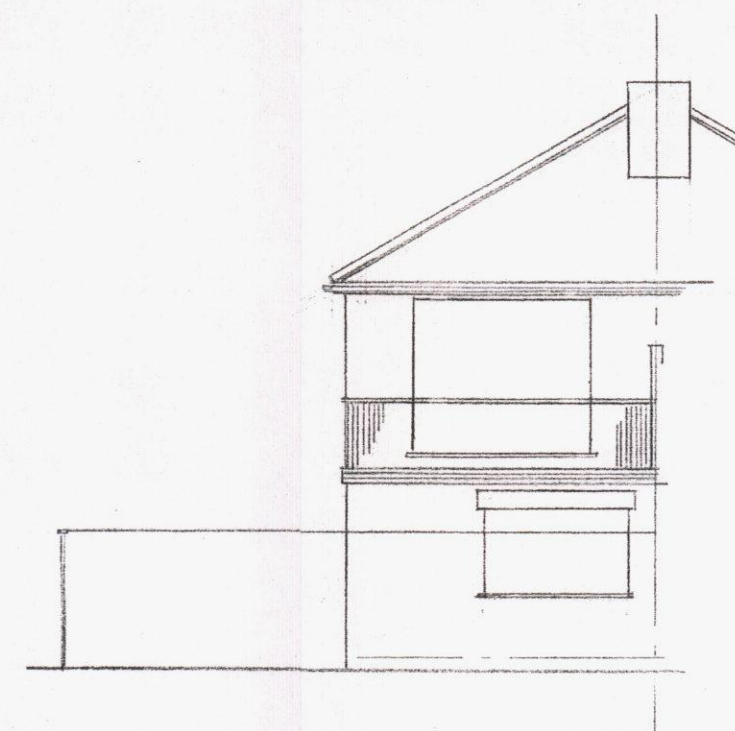

SOUTH ELEVATION

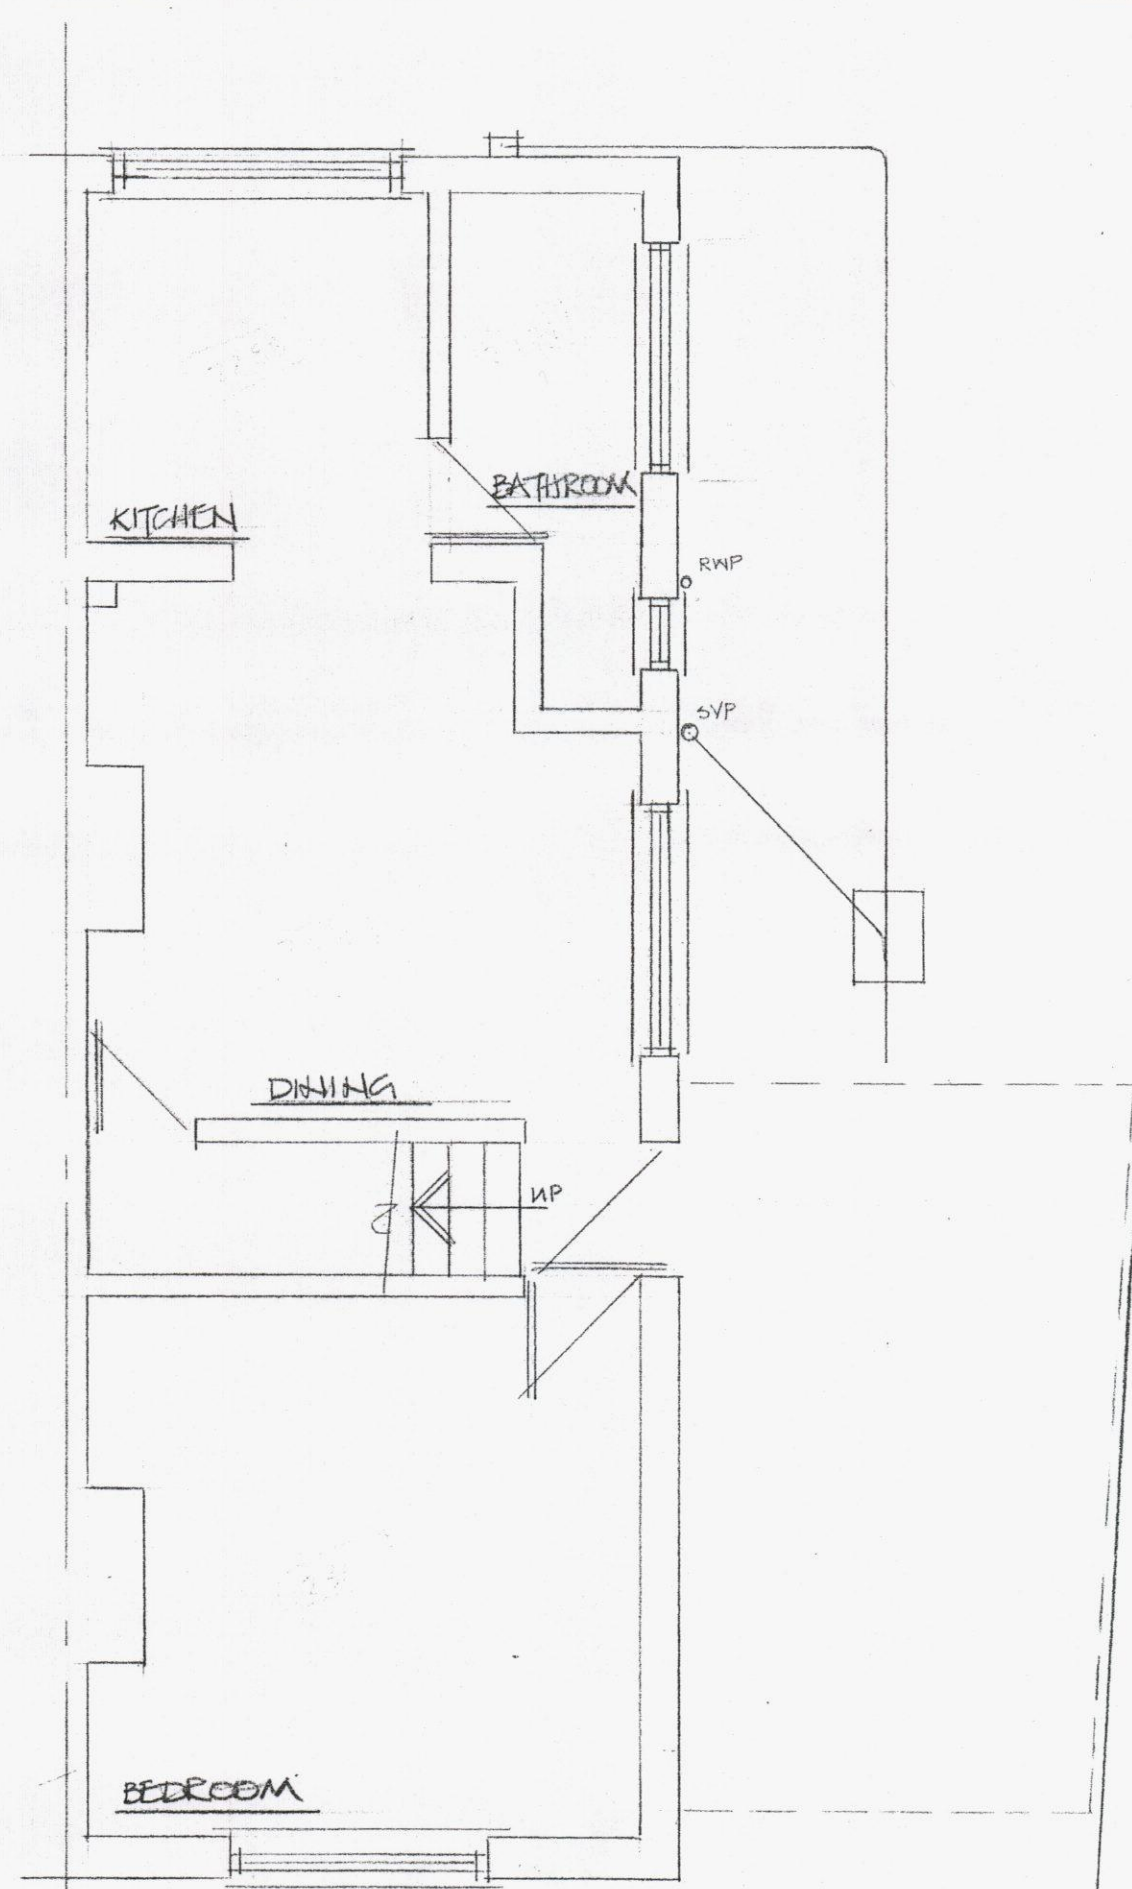

GROUND FLOOR PLAN

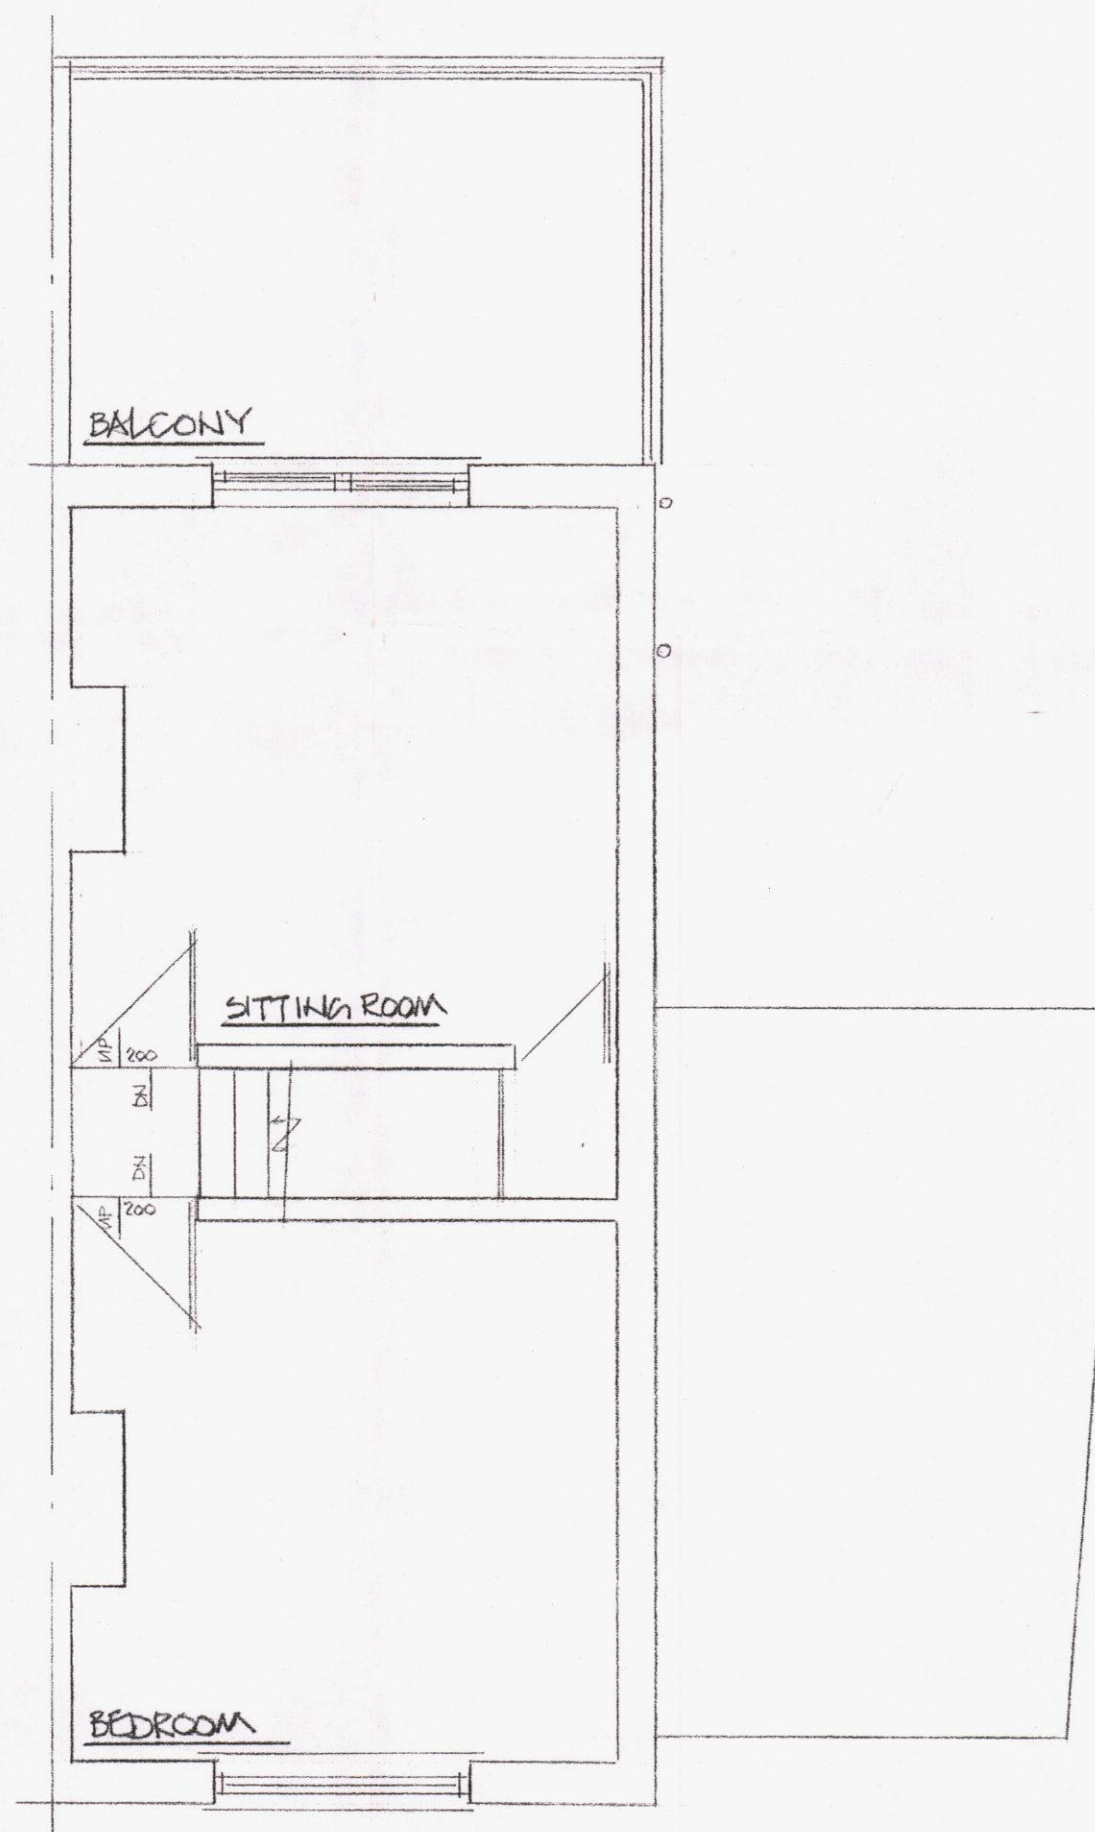

FIRST FLOOR PLAN

HAVANT BOROUGH
COUNCIL
- 4 JUL 2014
RECEIVED

MR & MRS TREAGUST

7 SCHOOL LANE
EASTWORTH
HANTS

AS BUILTS

David Niven Design Ltd

davidnivedesign@gmail.com
07973 342 807 01243 330070
74 Westbourne Avenue,
Emsworth, Hampshire PO10 7QU



Architectural Design & Planning

1:100, 50 JUNE '14 14/1001/1