




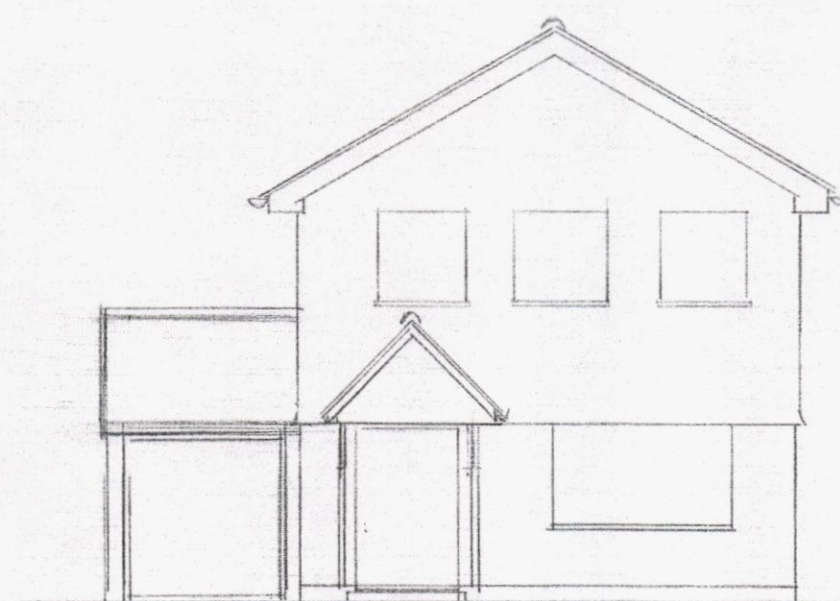


N.W. ELEVATION

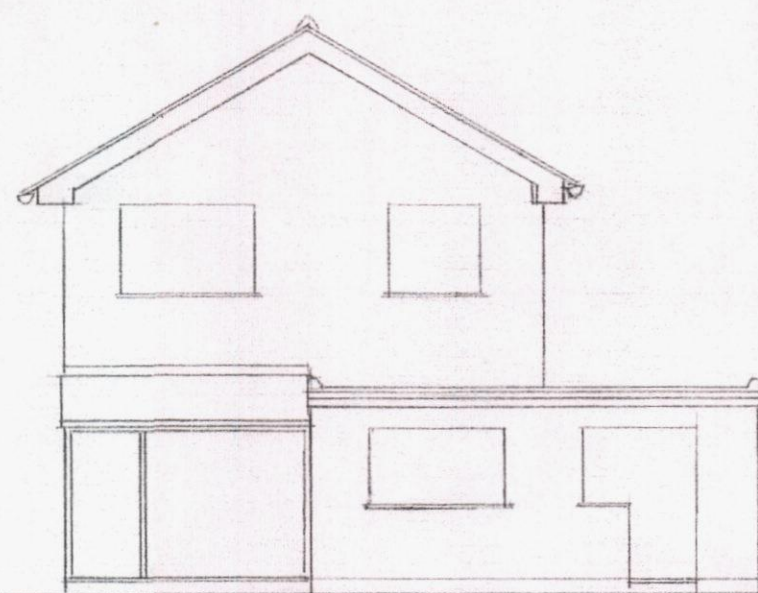


S.E. ELEVATION

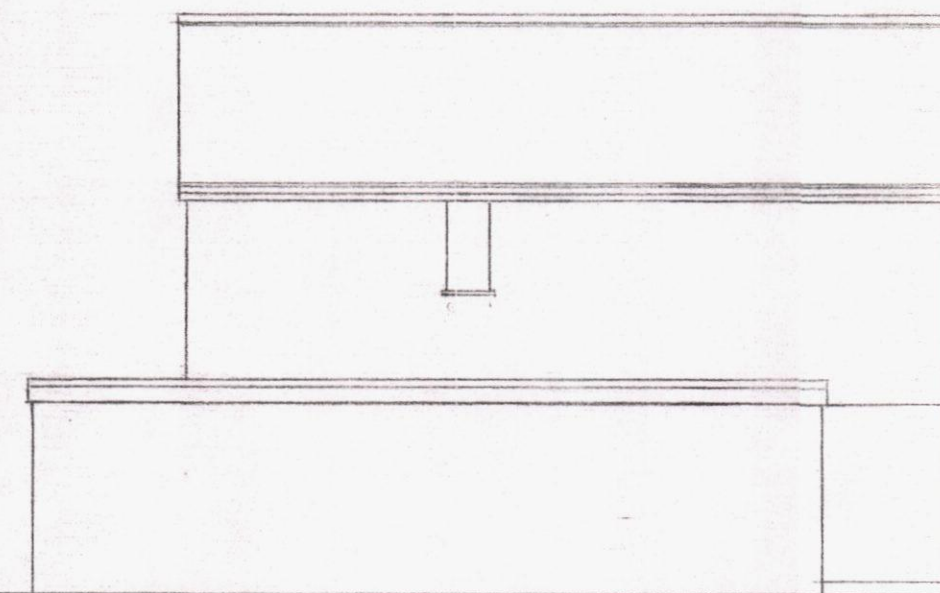


N.E. ELEVATION

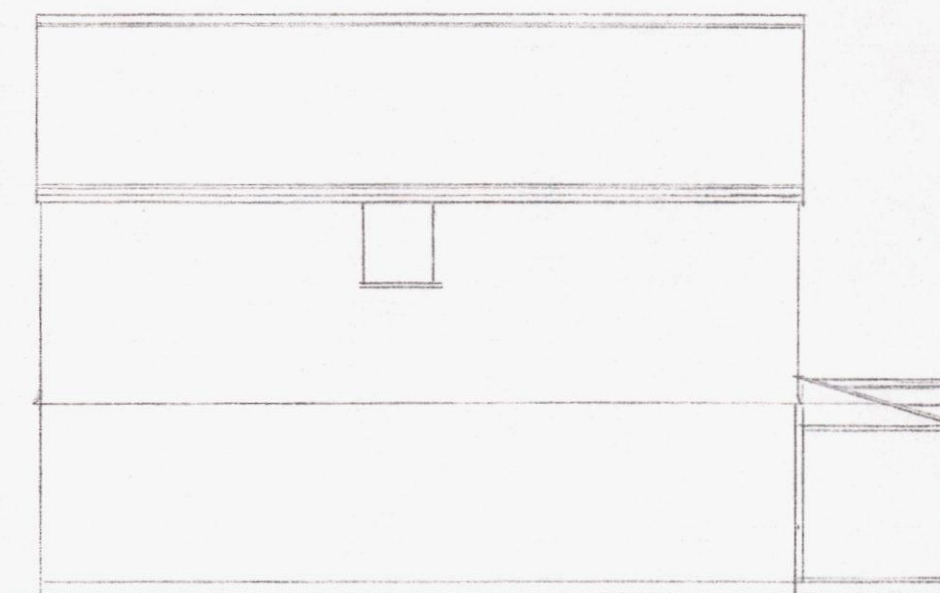

S.W. ELEVATION

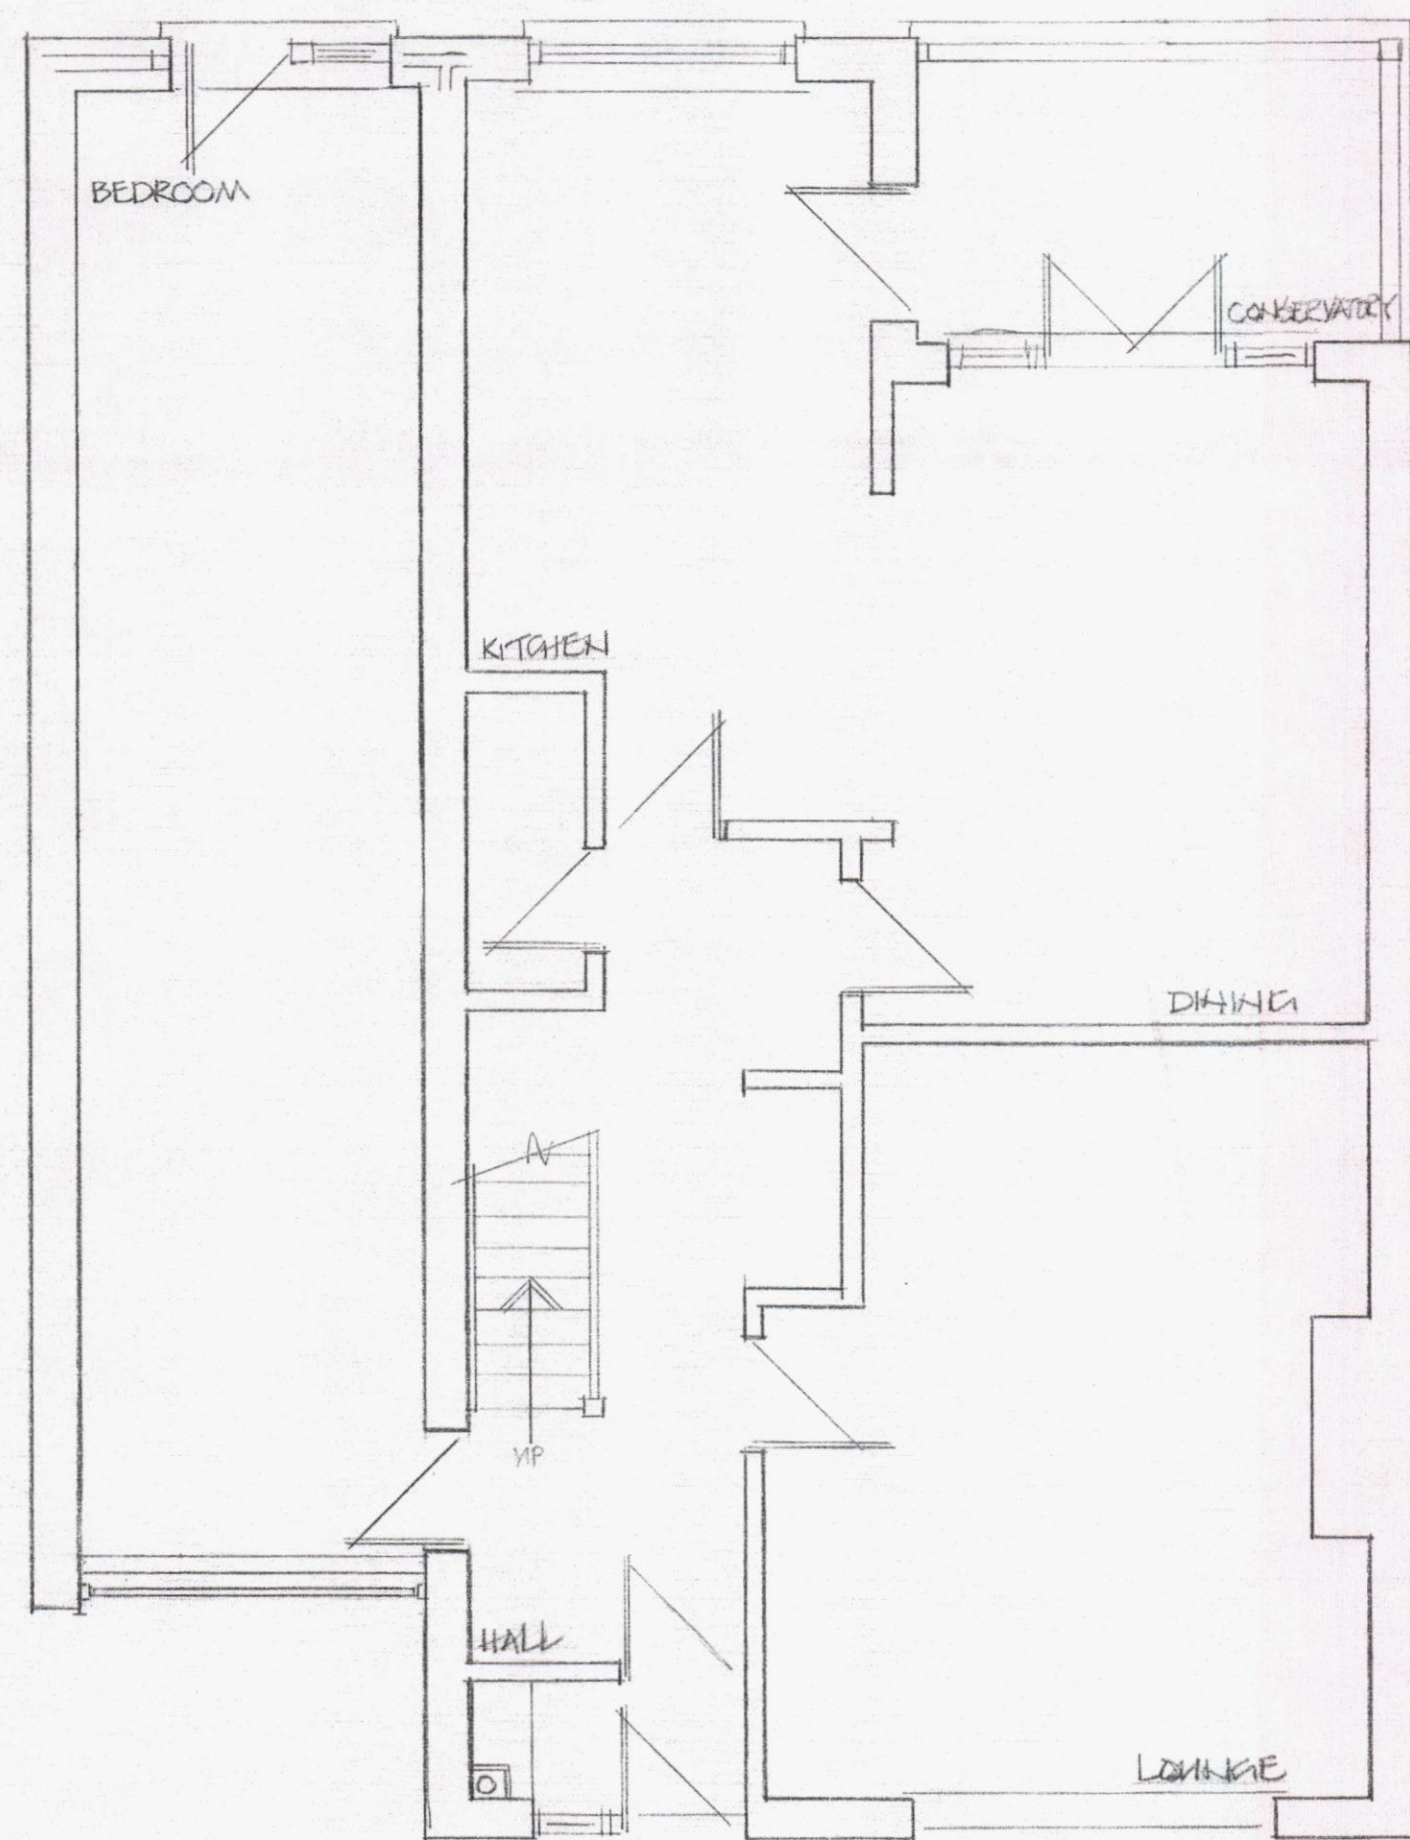

GROUND FLOOR PLAN

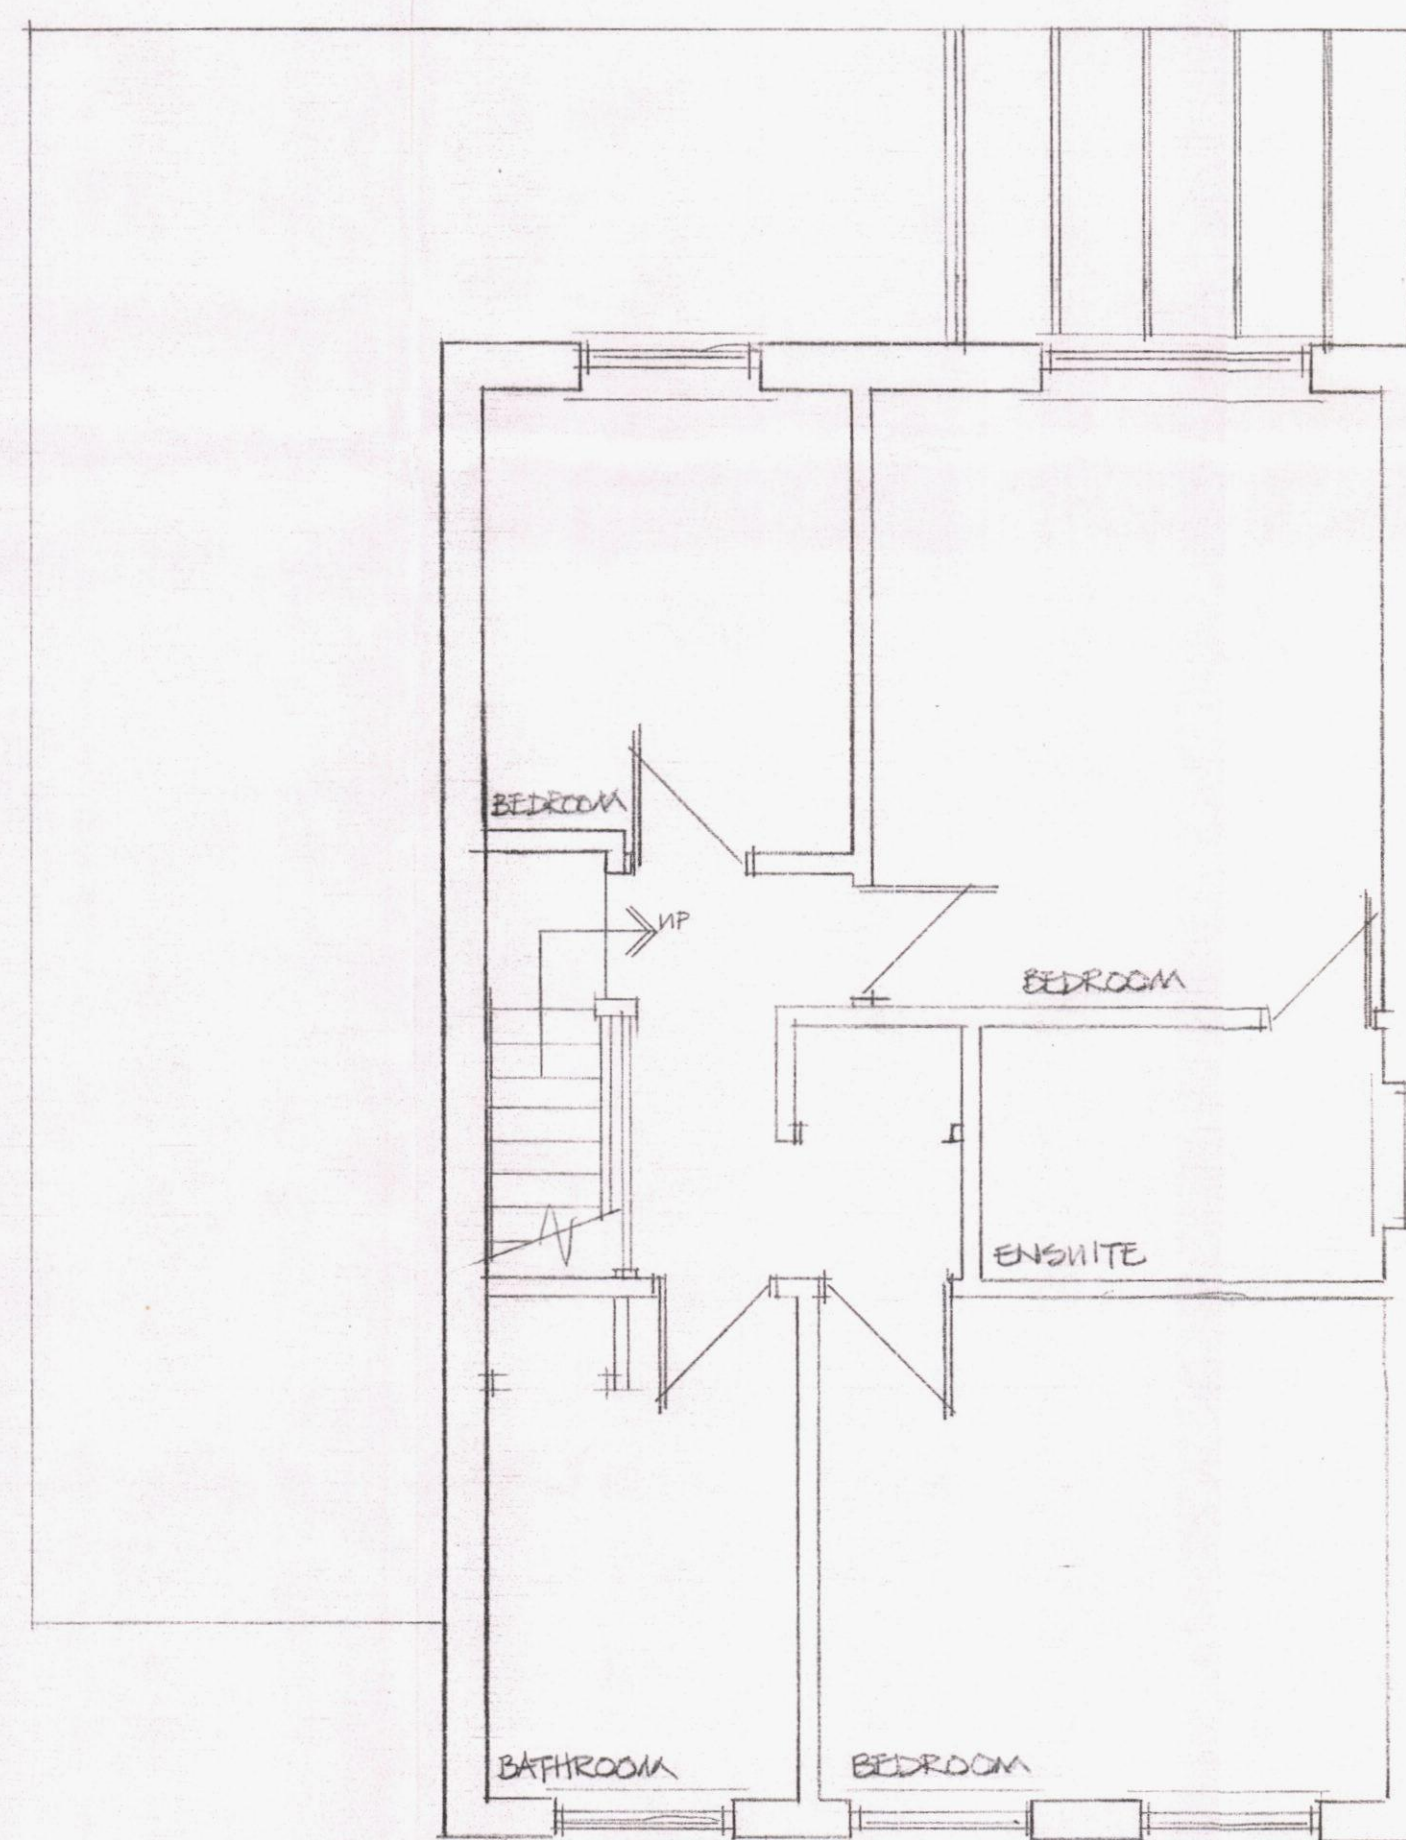

1st FLOOR PLAN

REV A
ORIENTATION OF ELEVS AMENDED
TO CORRESPOND TO SITE PLAN 4/11/2014

MR P. KELLY

18 IDSWORTH RD
COWPLAIN
HANTS

AS BUILT DRAWING

David Niven Design Ltd

davidniven.design@gmail.com
07973 342 807 01243 330070
74 Westbourne Avenue,
Emsworth, Hampshire PO10 7QU



Architectural Design & Planning

HAVANT BOROUGH
COUNCIL
06 NOV 2014
RECEIVED

1:100,50 SEPT '14 14/1036/1^A