




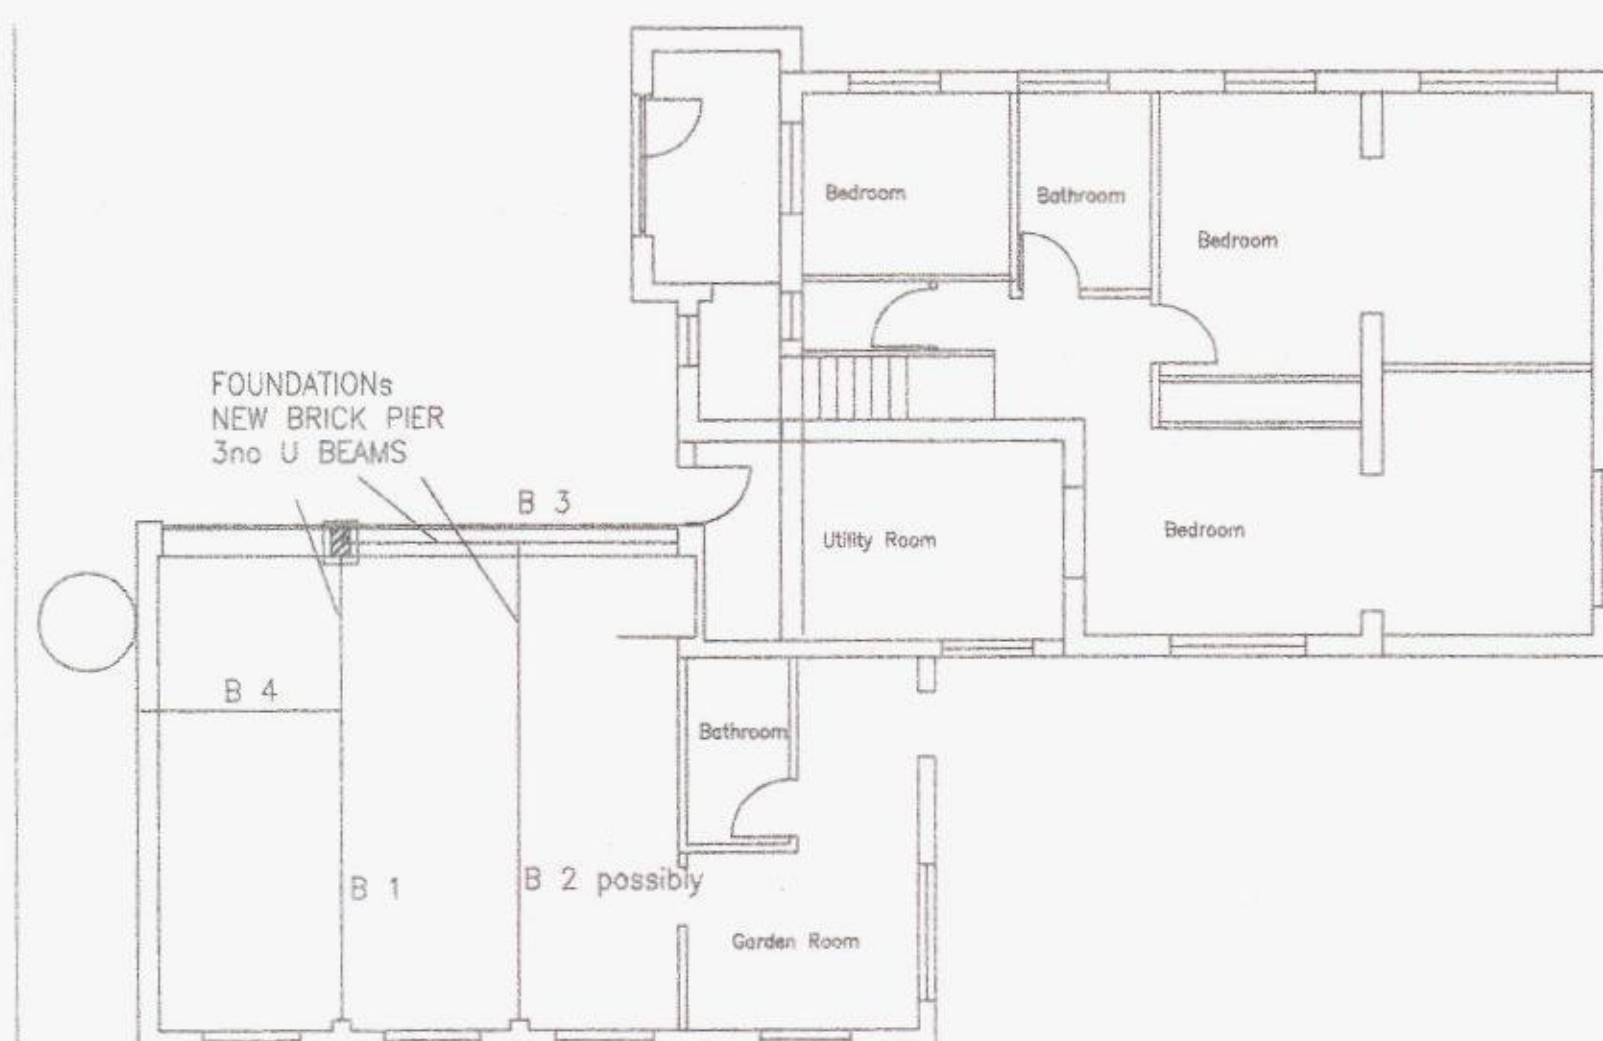


PROPOSED GROUND FLOOR

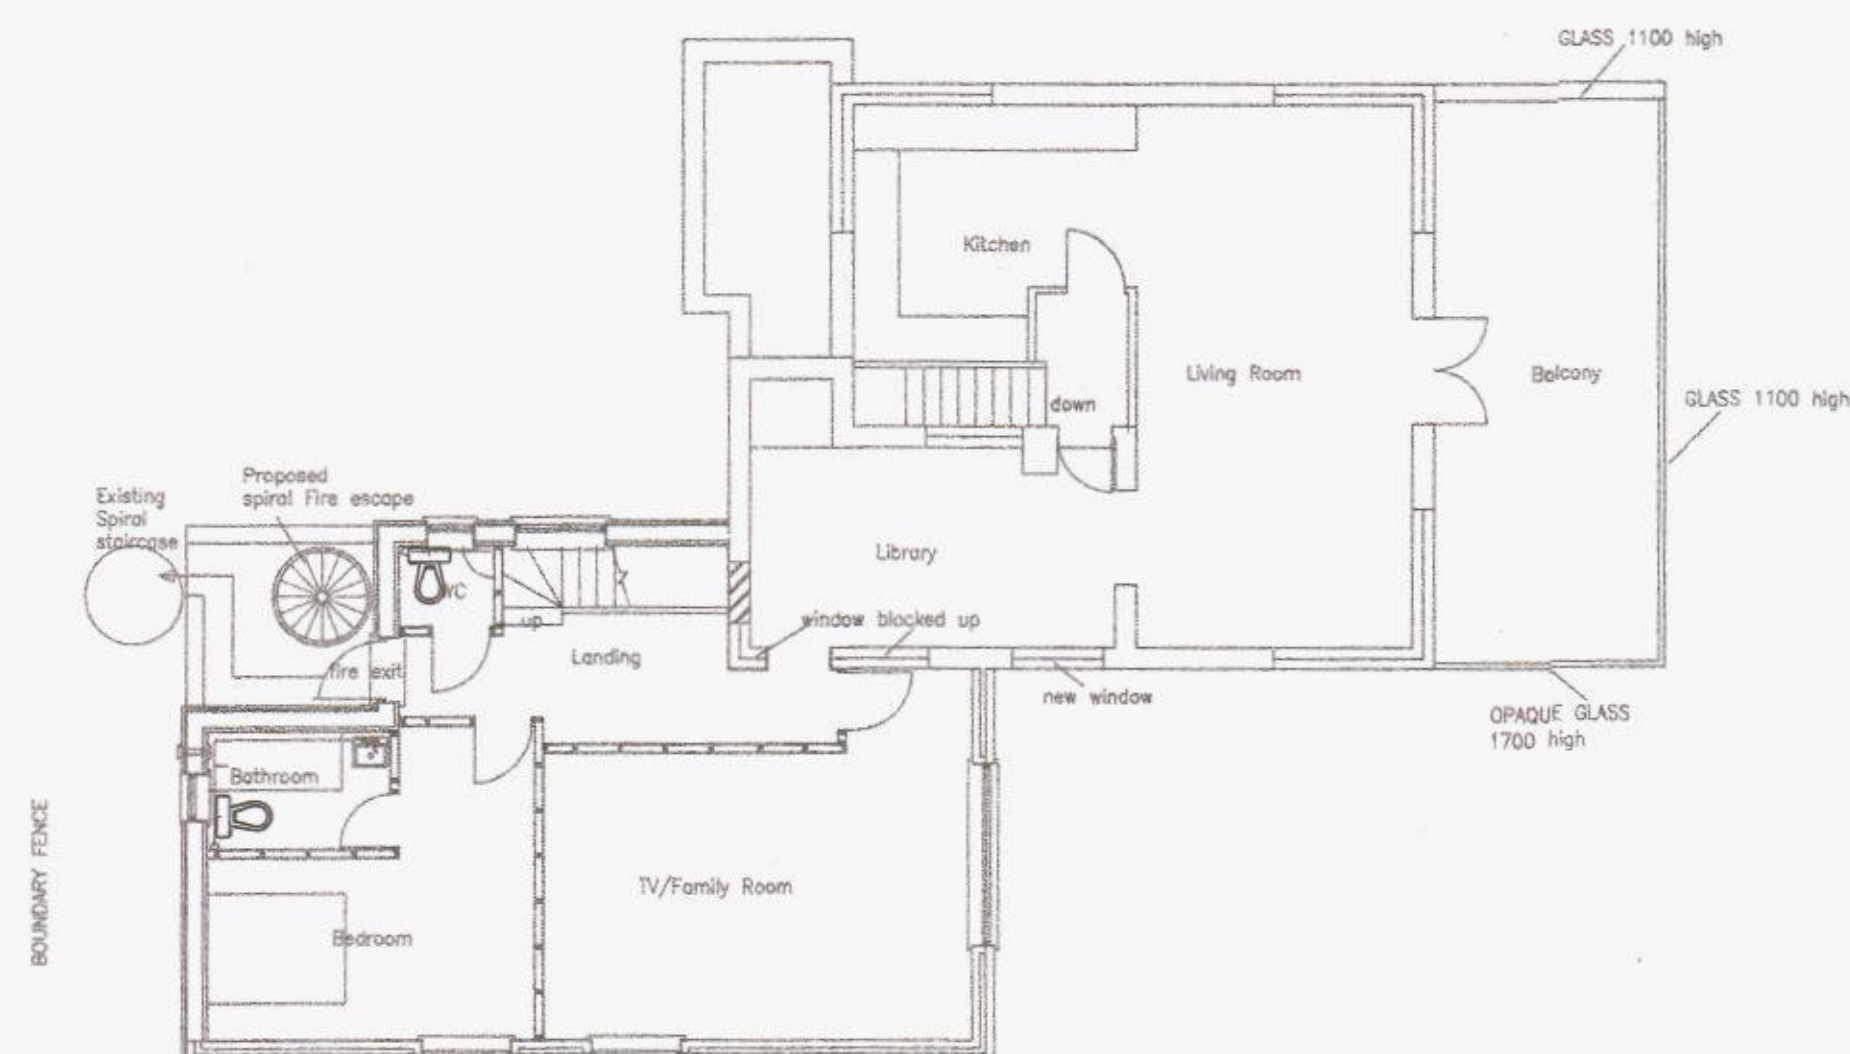

PROPOSED FIRST FLOOR

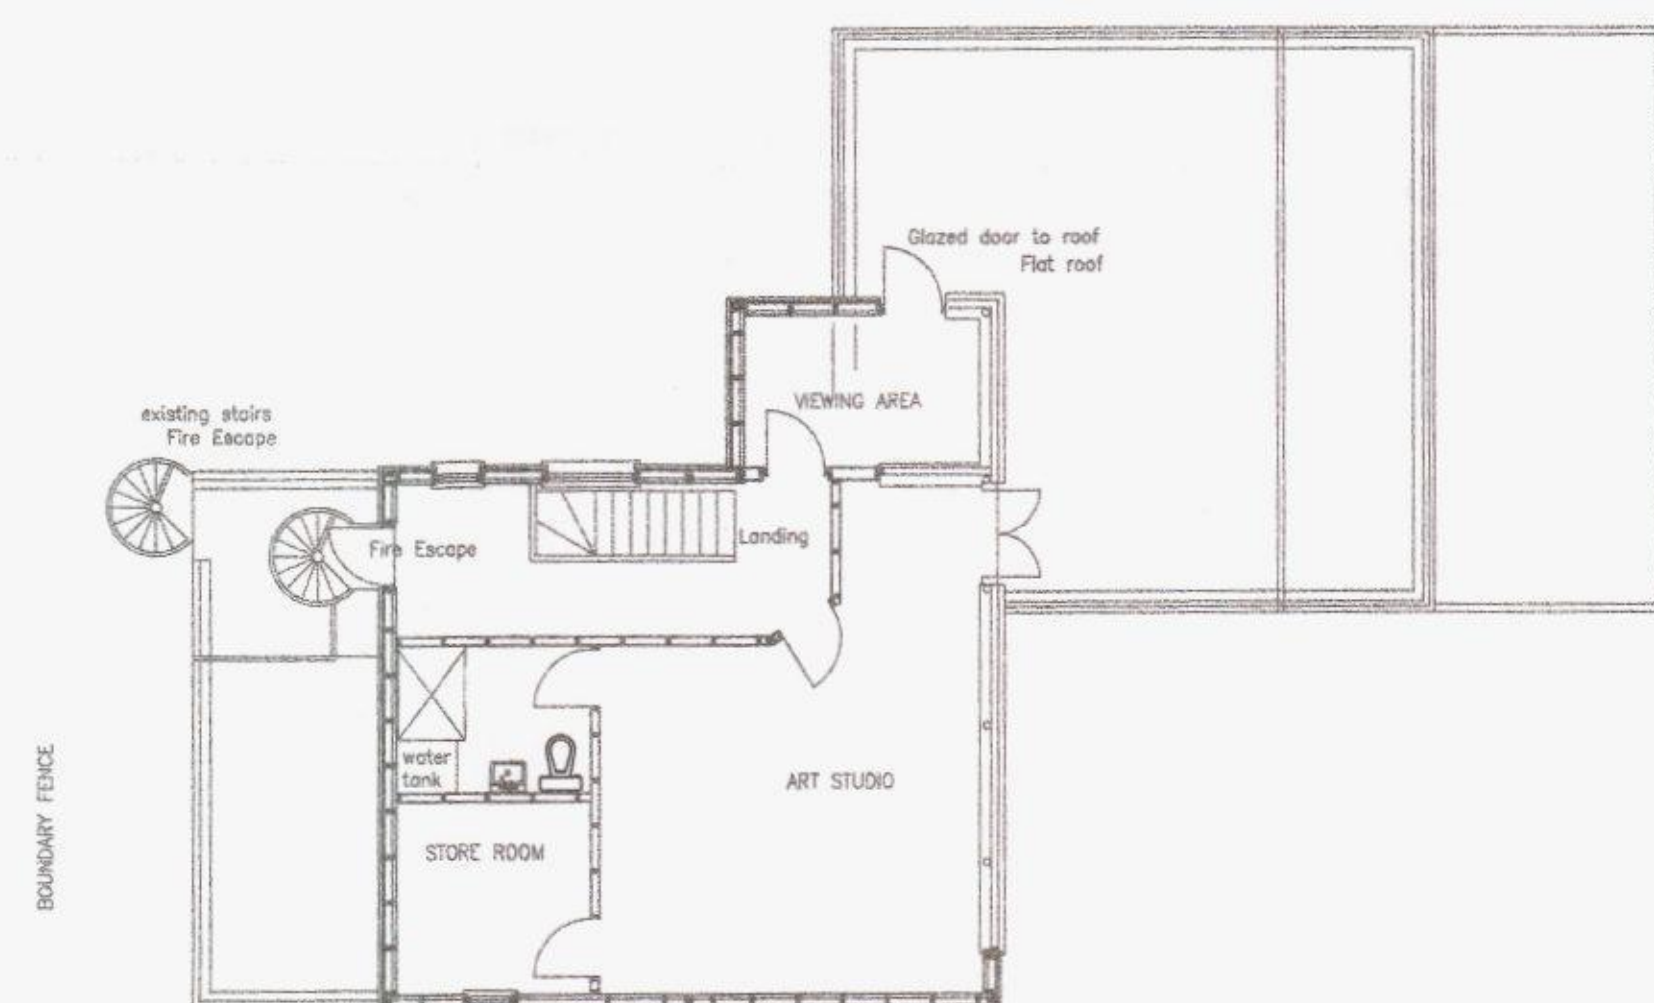


PROPOSED SECOND FLOOR

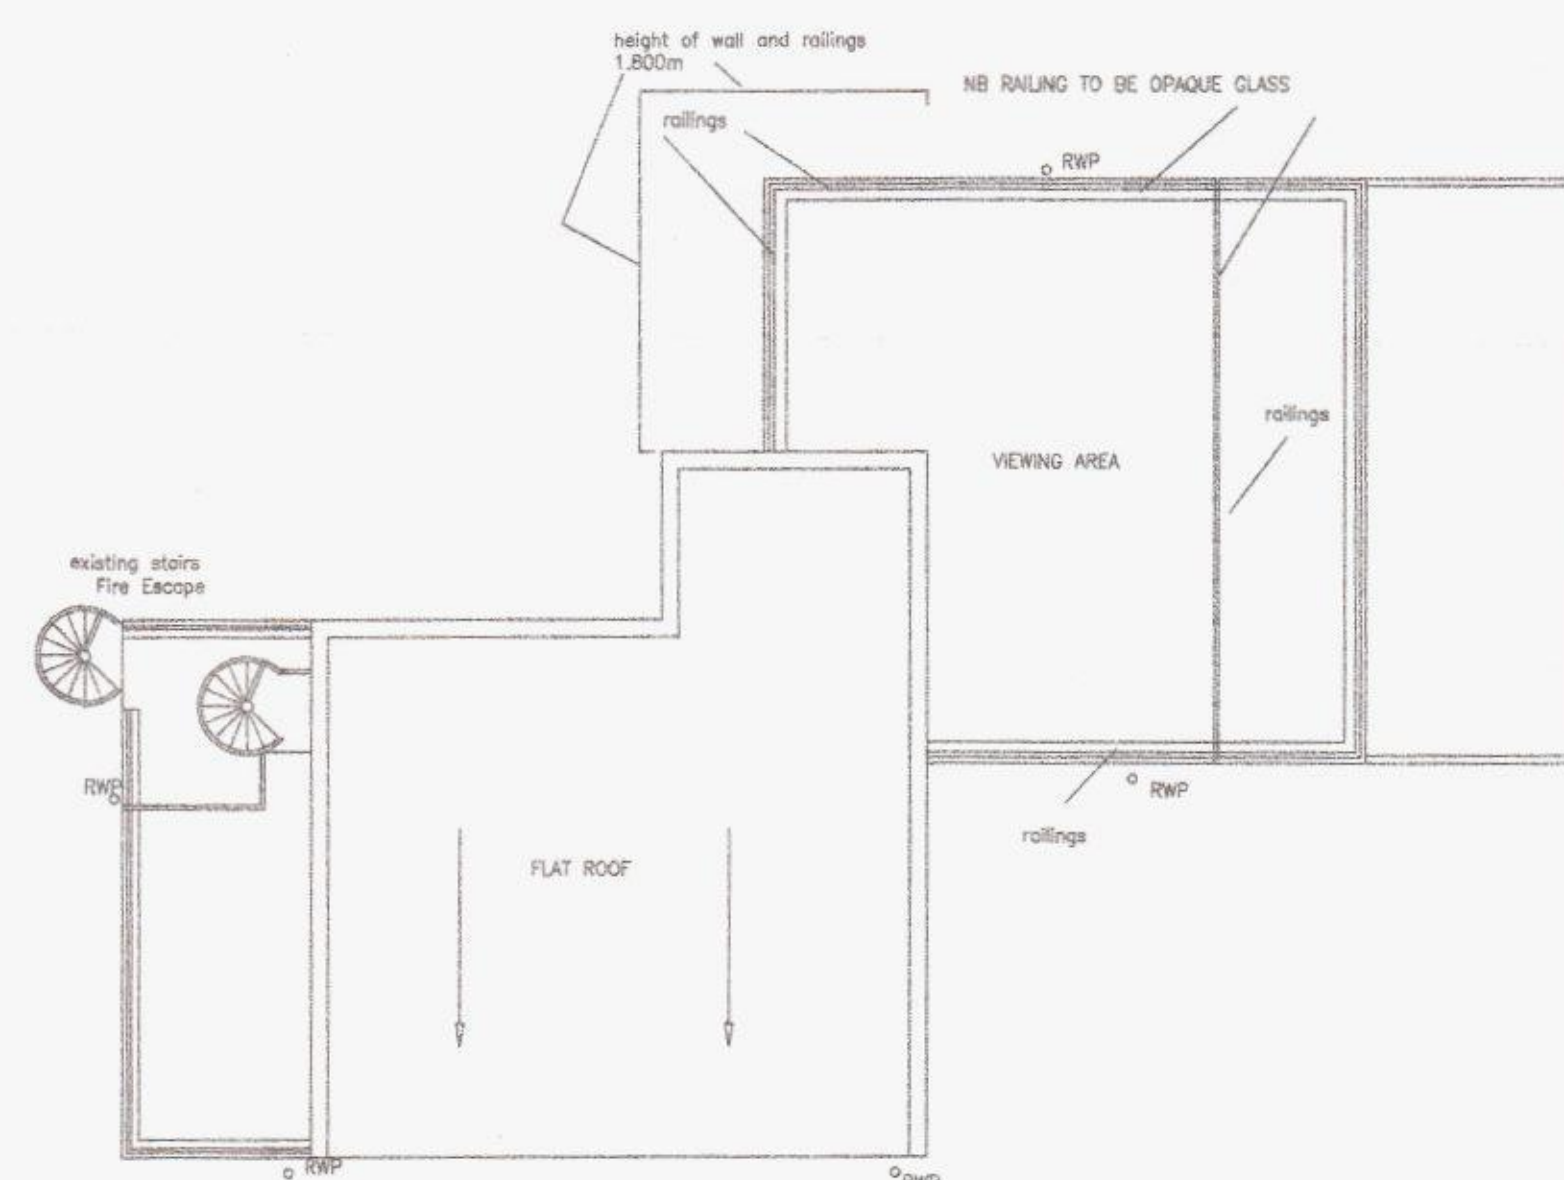


PROPOSED ROOF PLAN



EXISTING GROUND FLOOR

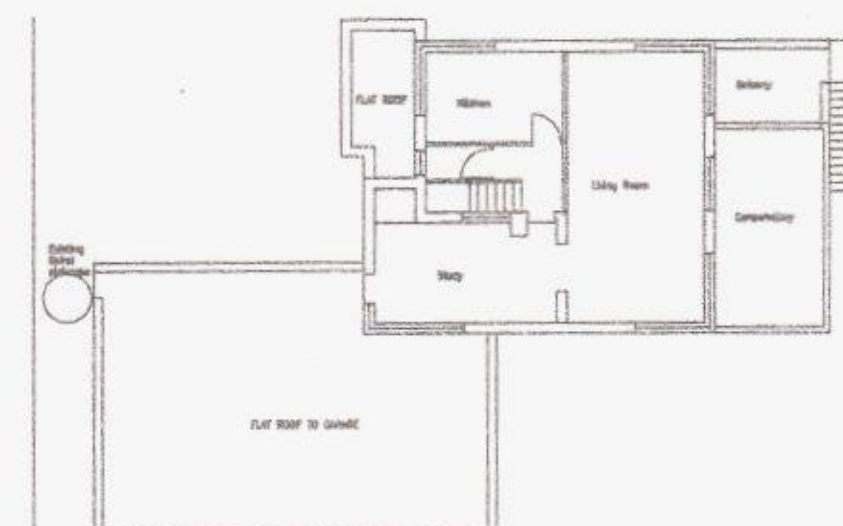

EXISTING FIRST FLOOR

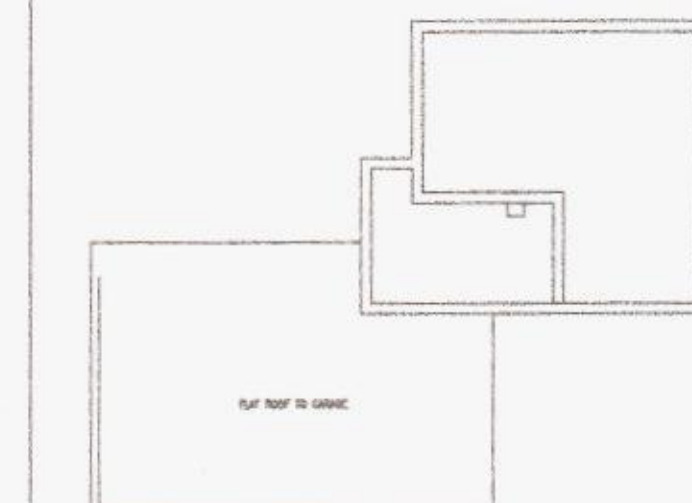

EXISTING ROOF LAYOUT



SURVEYED BY:
VERNON L JENNINGS & Co.
LAND & BUILDING SURVEYORS
COOMBDAL, BARNES GREEN,
WEST SUSSEX,
RH13 0QA
TEL/FAX 01403738754
Email vernonl.jenningsandco@f2s.com

JOB:
CRABBERS NIP
SANDY POINT
HAYLING ISLAND

DRWG.
PROPOSED EXTENSION
AS BUILT & EXISTING FLOOR PLANS

Scale. 1:100 Date May 14

Drawn. V.L.J. Dwg No. SP/5

Revisions. Date.