


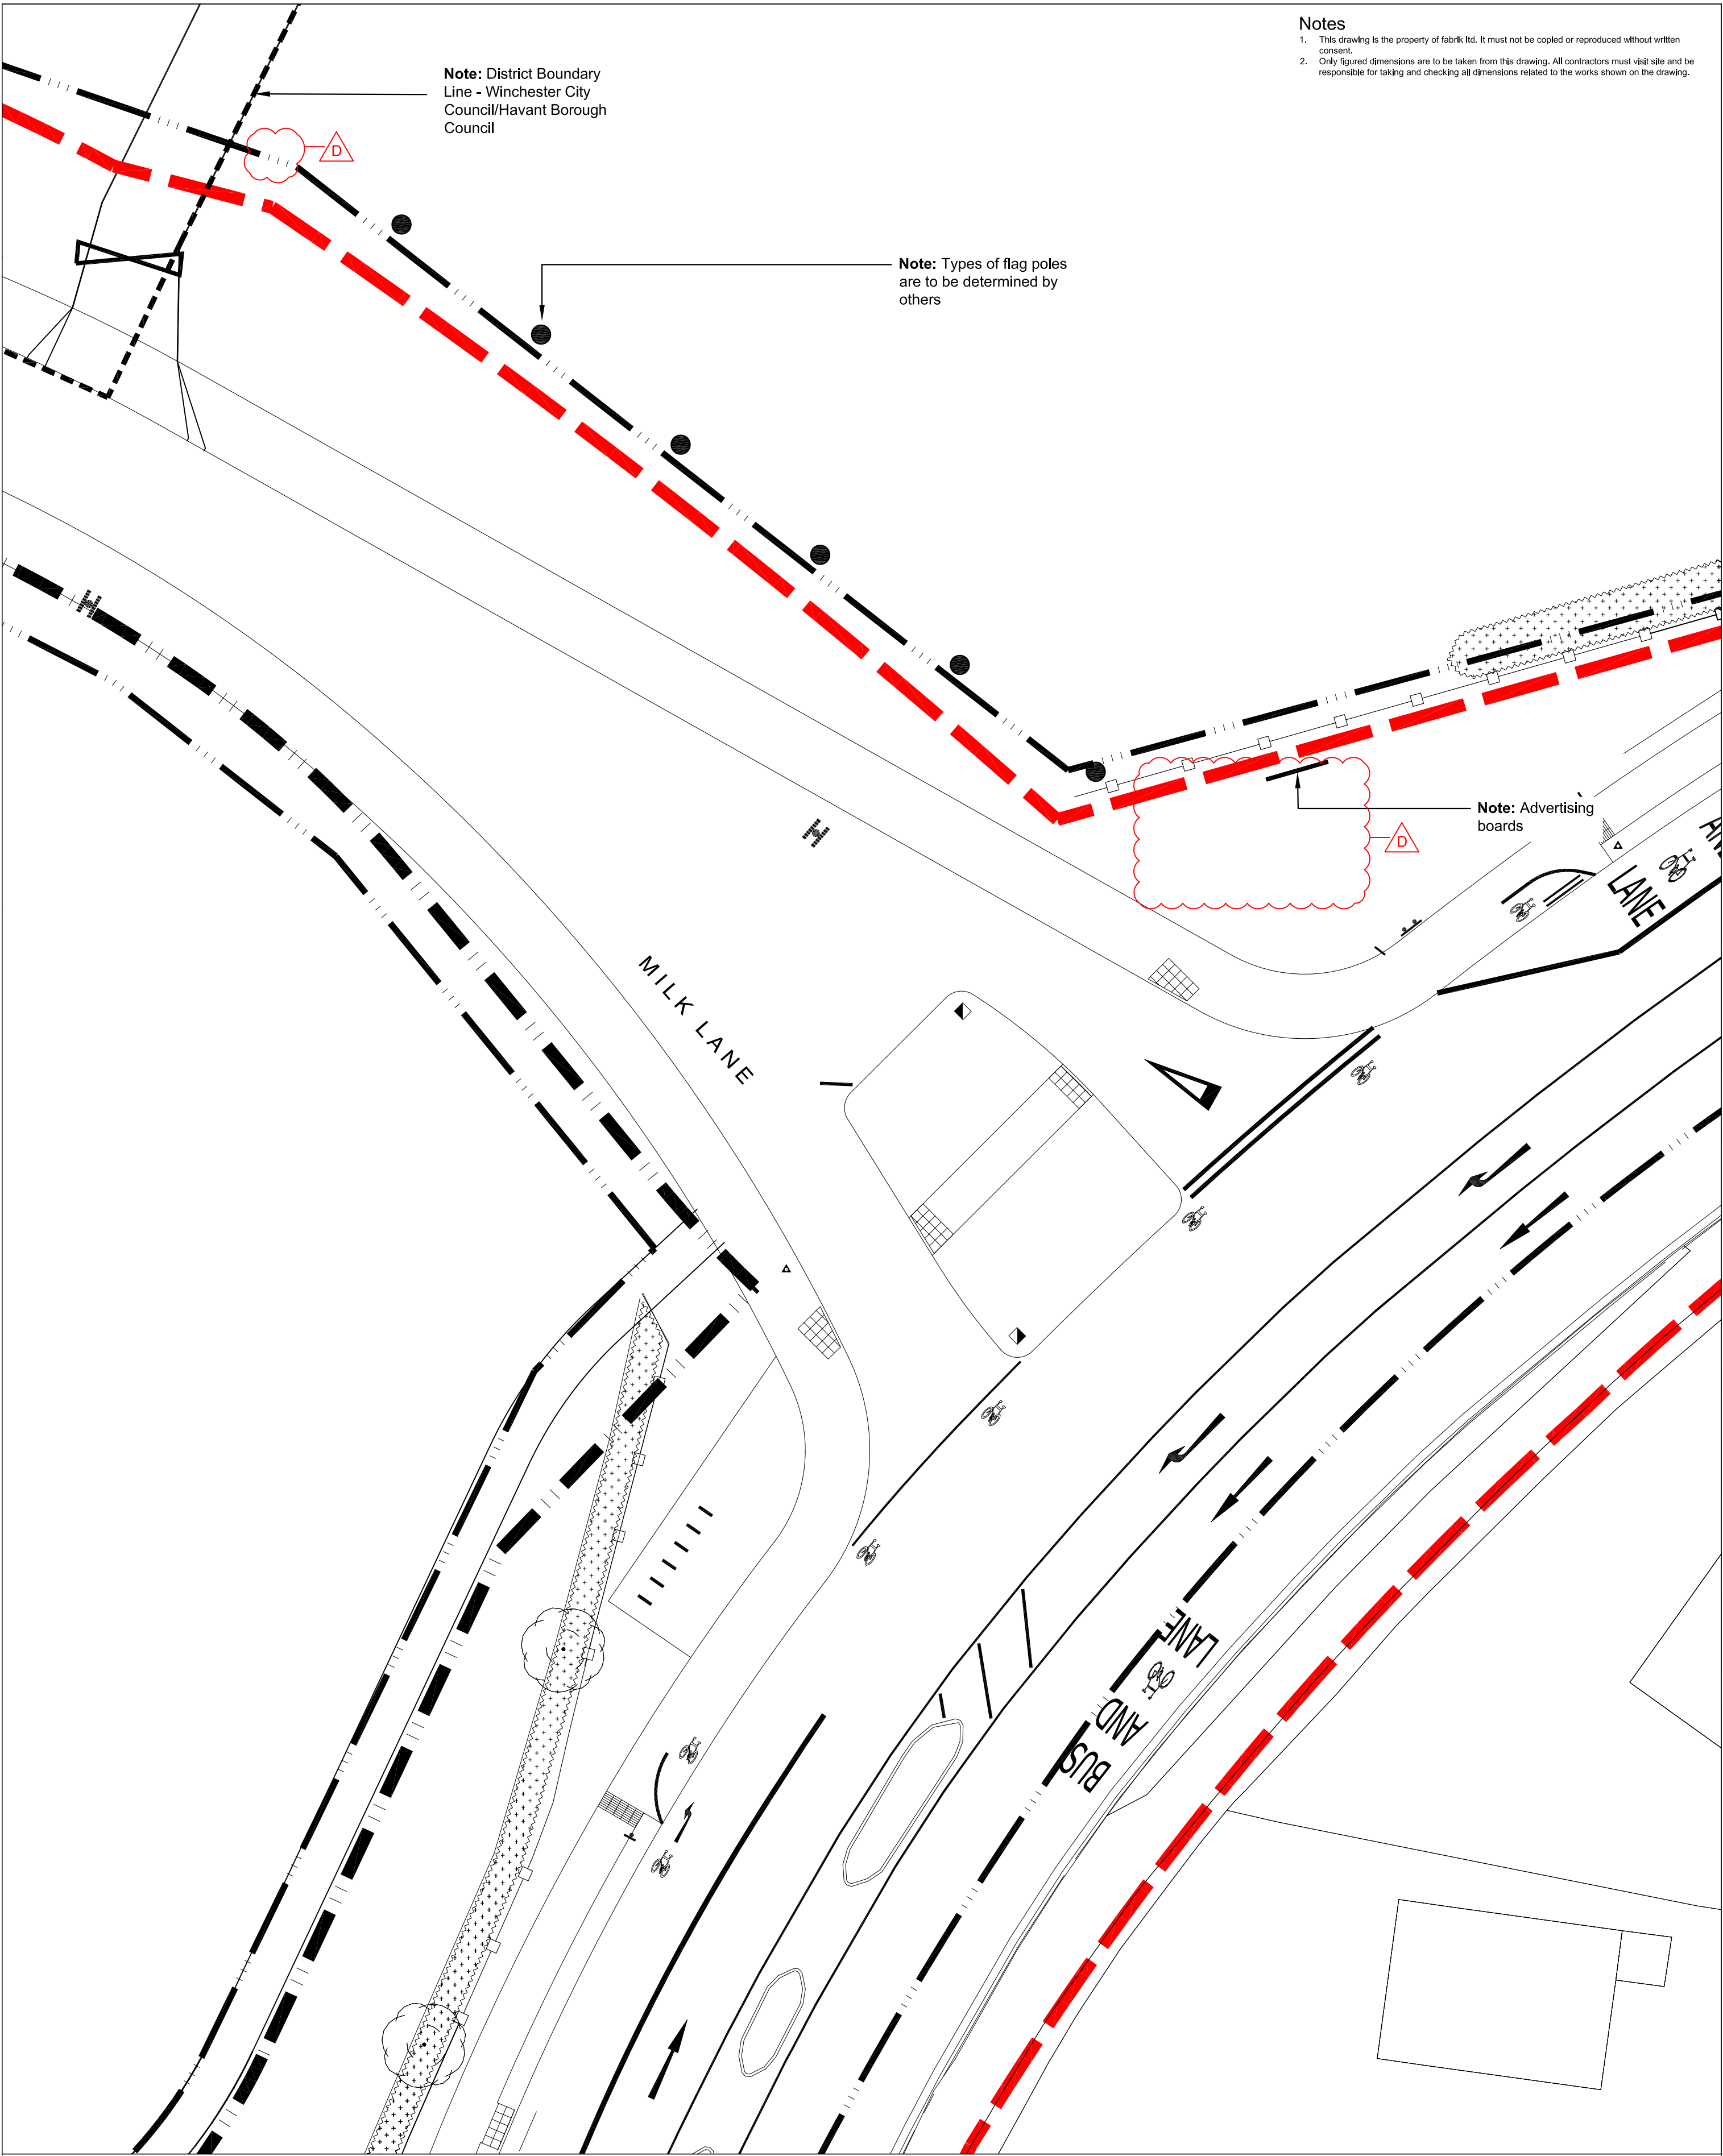


- Notes**
1. This drawing is the property of fabrik ltd. It must not be copied or reproduced without written consent.
 2. Only figured dimensions are to be taken from this drawing. All contractors must visit site and be responsible for taking and checking all dimensions related to the works shown on the drawing.

Note: District Boundary
Line - Winchester City
Council/Havant Borough
Council

Note: Types of flag poles
are to be determined by
others

Note: Advertising
boards

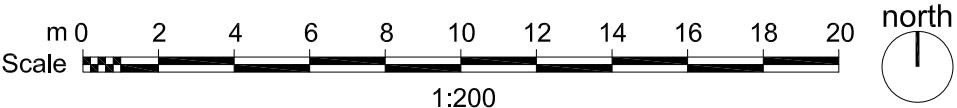

fabrik

38a High Street
Alton
Hampshire
GU34 1BD

T : 01420 593250
F : 01420 544243
E : alton@fabrikuk.com
W : www.fabrikuk.com

D	14/11/14	Sign postion adjusted and flag removed
C	28/08/14	Amendments to annotation following client comments
B	14/08/14	Amendments to entrance annotation following client comments
A	11/08/14	Amendments to entrance alignment following client comments
No.	Date	Reason
Revisions		

External References:

- D2085 Berewood, HampshireDrawingsTree Survey/Recvd-12-10-04/1784 treefabrik tree survey & reference plan (bound).dwg
- D1821 Newlands Common, West of WaterlooVleAltonDrawingsSite Survey/Recvd-11-05-20/330_ORDSURV copy.dwg
- D2085 Berewood, HampshireDrawingsEngineer/Recvd-12-12-08/121006_PHASE_2_WORKS_BOUNDARY.dwg
- D2085 Berewood, HampshireDrawingsEngineer/Recvd-13-08-29/100_P01_ROAD_LAYOUT - Copy.dwg
- D2085 Berewood, HampshireDrawingsSite Survey/Recvd-13-02-08/617WVW6.21.dwg
- D2085 Berewood, HampshireDrawingsEngineer/Recvd-12-12-05/100_P01_UTILITIES.dwg
- D2085 Berewood, HampshireDrawingsEngineer/Recvd-13-01-31/100_STREET LIGHTING.dwg

jc
trb
sm
Name

Project
**Phase 2 Infrastructure
Berewood, Waterlooville**

Drawing
Advertising Signage Locations

Scale
1:200 @ A2

Date
Aug '14

Checked
as

Drawn
trb

Drawing No.
D2085 L.220

Revision
D

☐ Preliminary	☐ Issued for Design/Information
☐ Issued for Planning Approval	☐ Issued for Tender
☒ Issued for Construction	☐ As Built

Drawing sheet size - A2

Copyright Reserved©