




LINEAR SCALE 1:100

A3 @ 1:100

PROPOSED PLANS

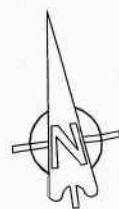

Indicative



ADP ARCHITECTS LTD

Richmond Court, 94 Botley Road, Park Gate,
Southampton, Hampshire SO31 1BA

Telephone / Fax Number: 0845 365 1475


Email: mail@adp-ltd.co.uk

Copyright of ADP Architects Ltd

C 17.10.12 7th flat


B 23.04.12 6 unit scheme

A 4.02.12 Non-mat applic update

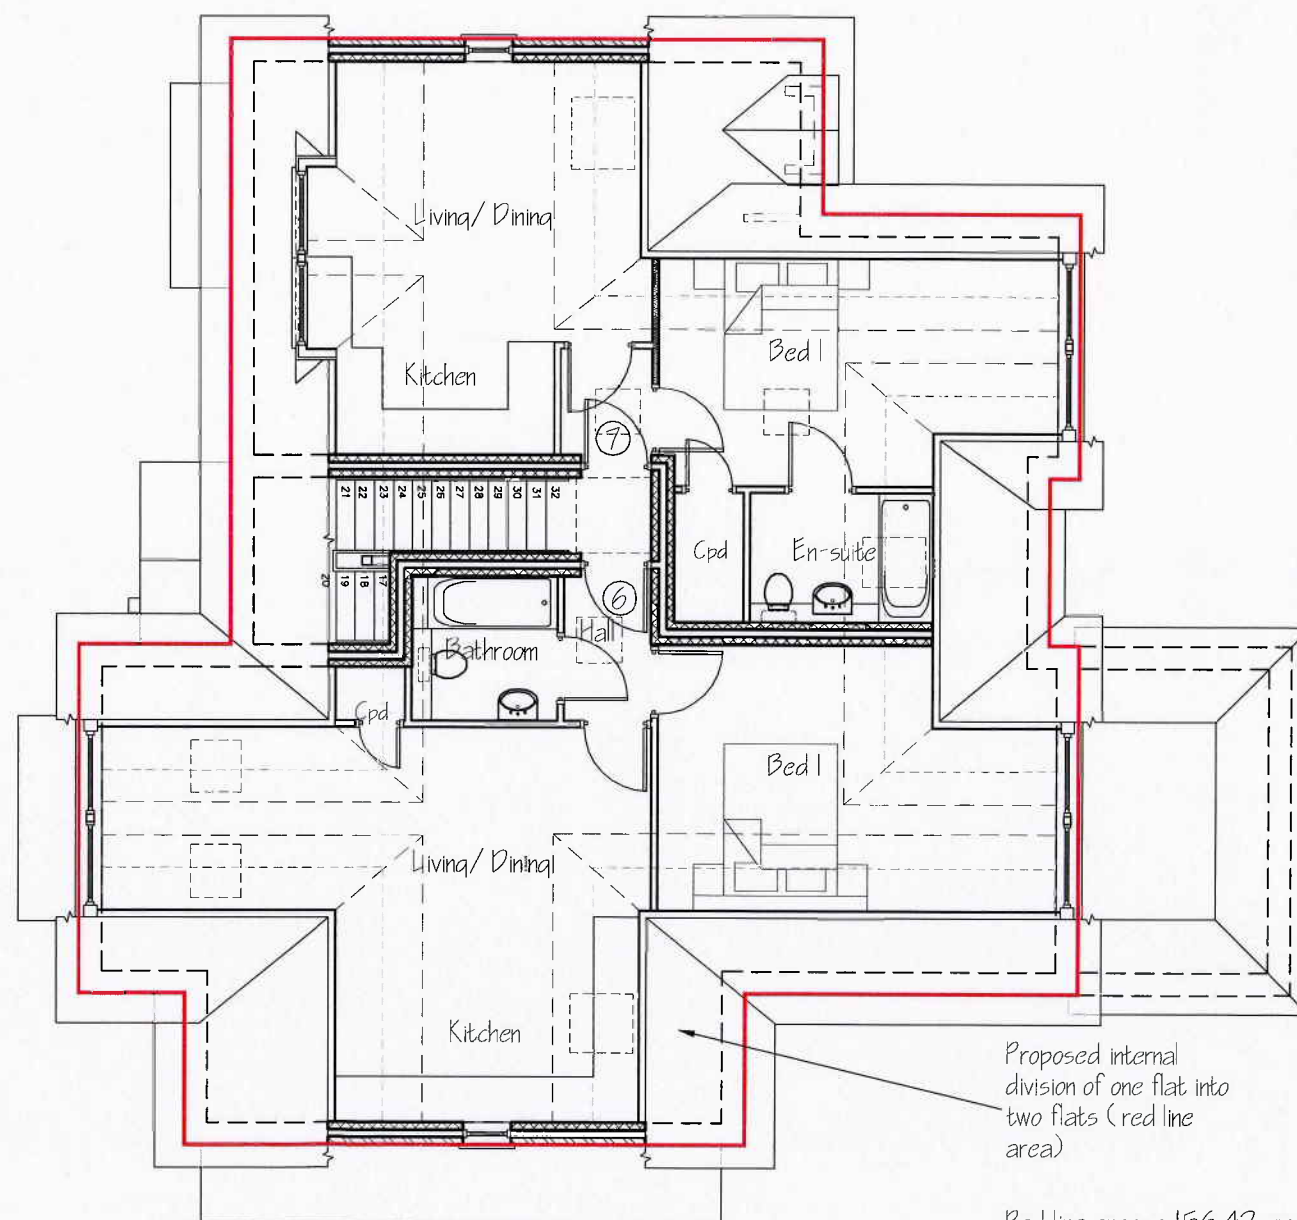

Second Floor Plan 1:100

Red line area = 156.42sqm

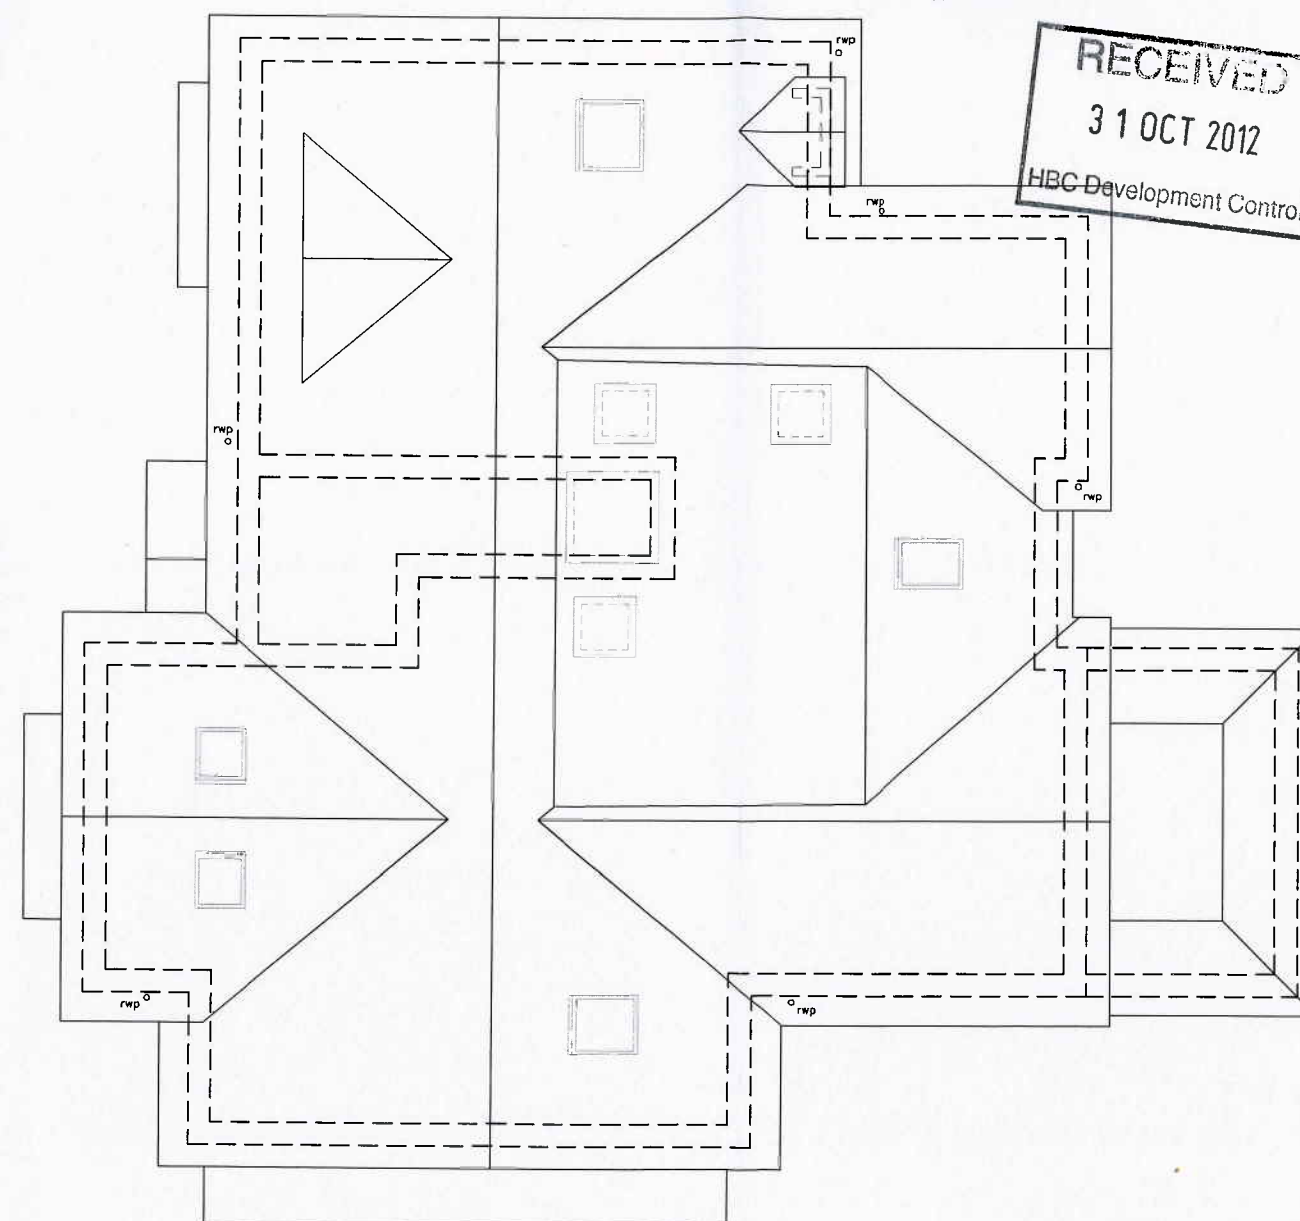

Roof Plan

7 Flats ■ 136 London Road ■ Waterlooville ■ G Rice ■ 1344/12c