


PROPOSED STORE AT NORFOLK MEWS, SEAFRONT, HAYLING ISLAND, HANTS.
 FOR MR C. SANDS. MINOR AS BUILT REVISIONS TO APPROVED PLAN APP/11/01463

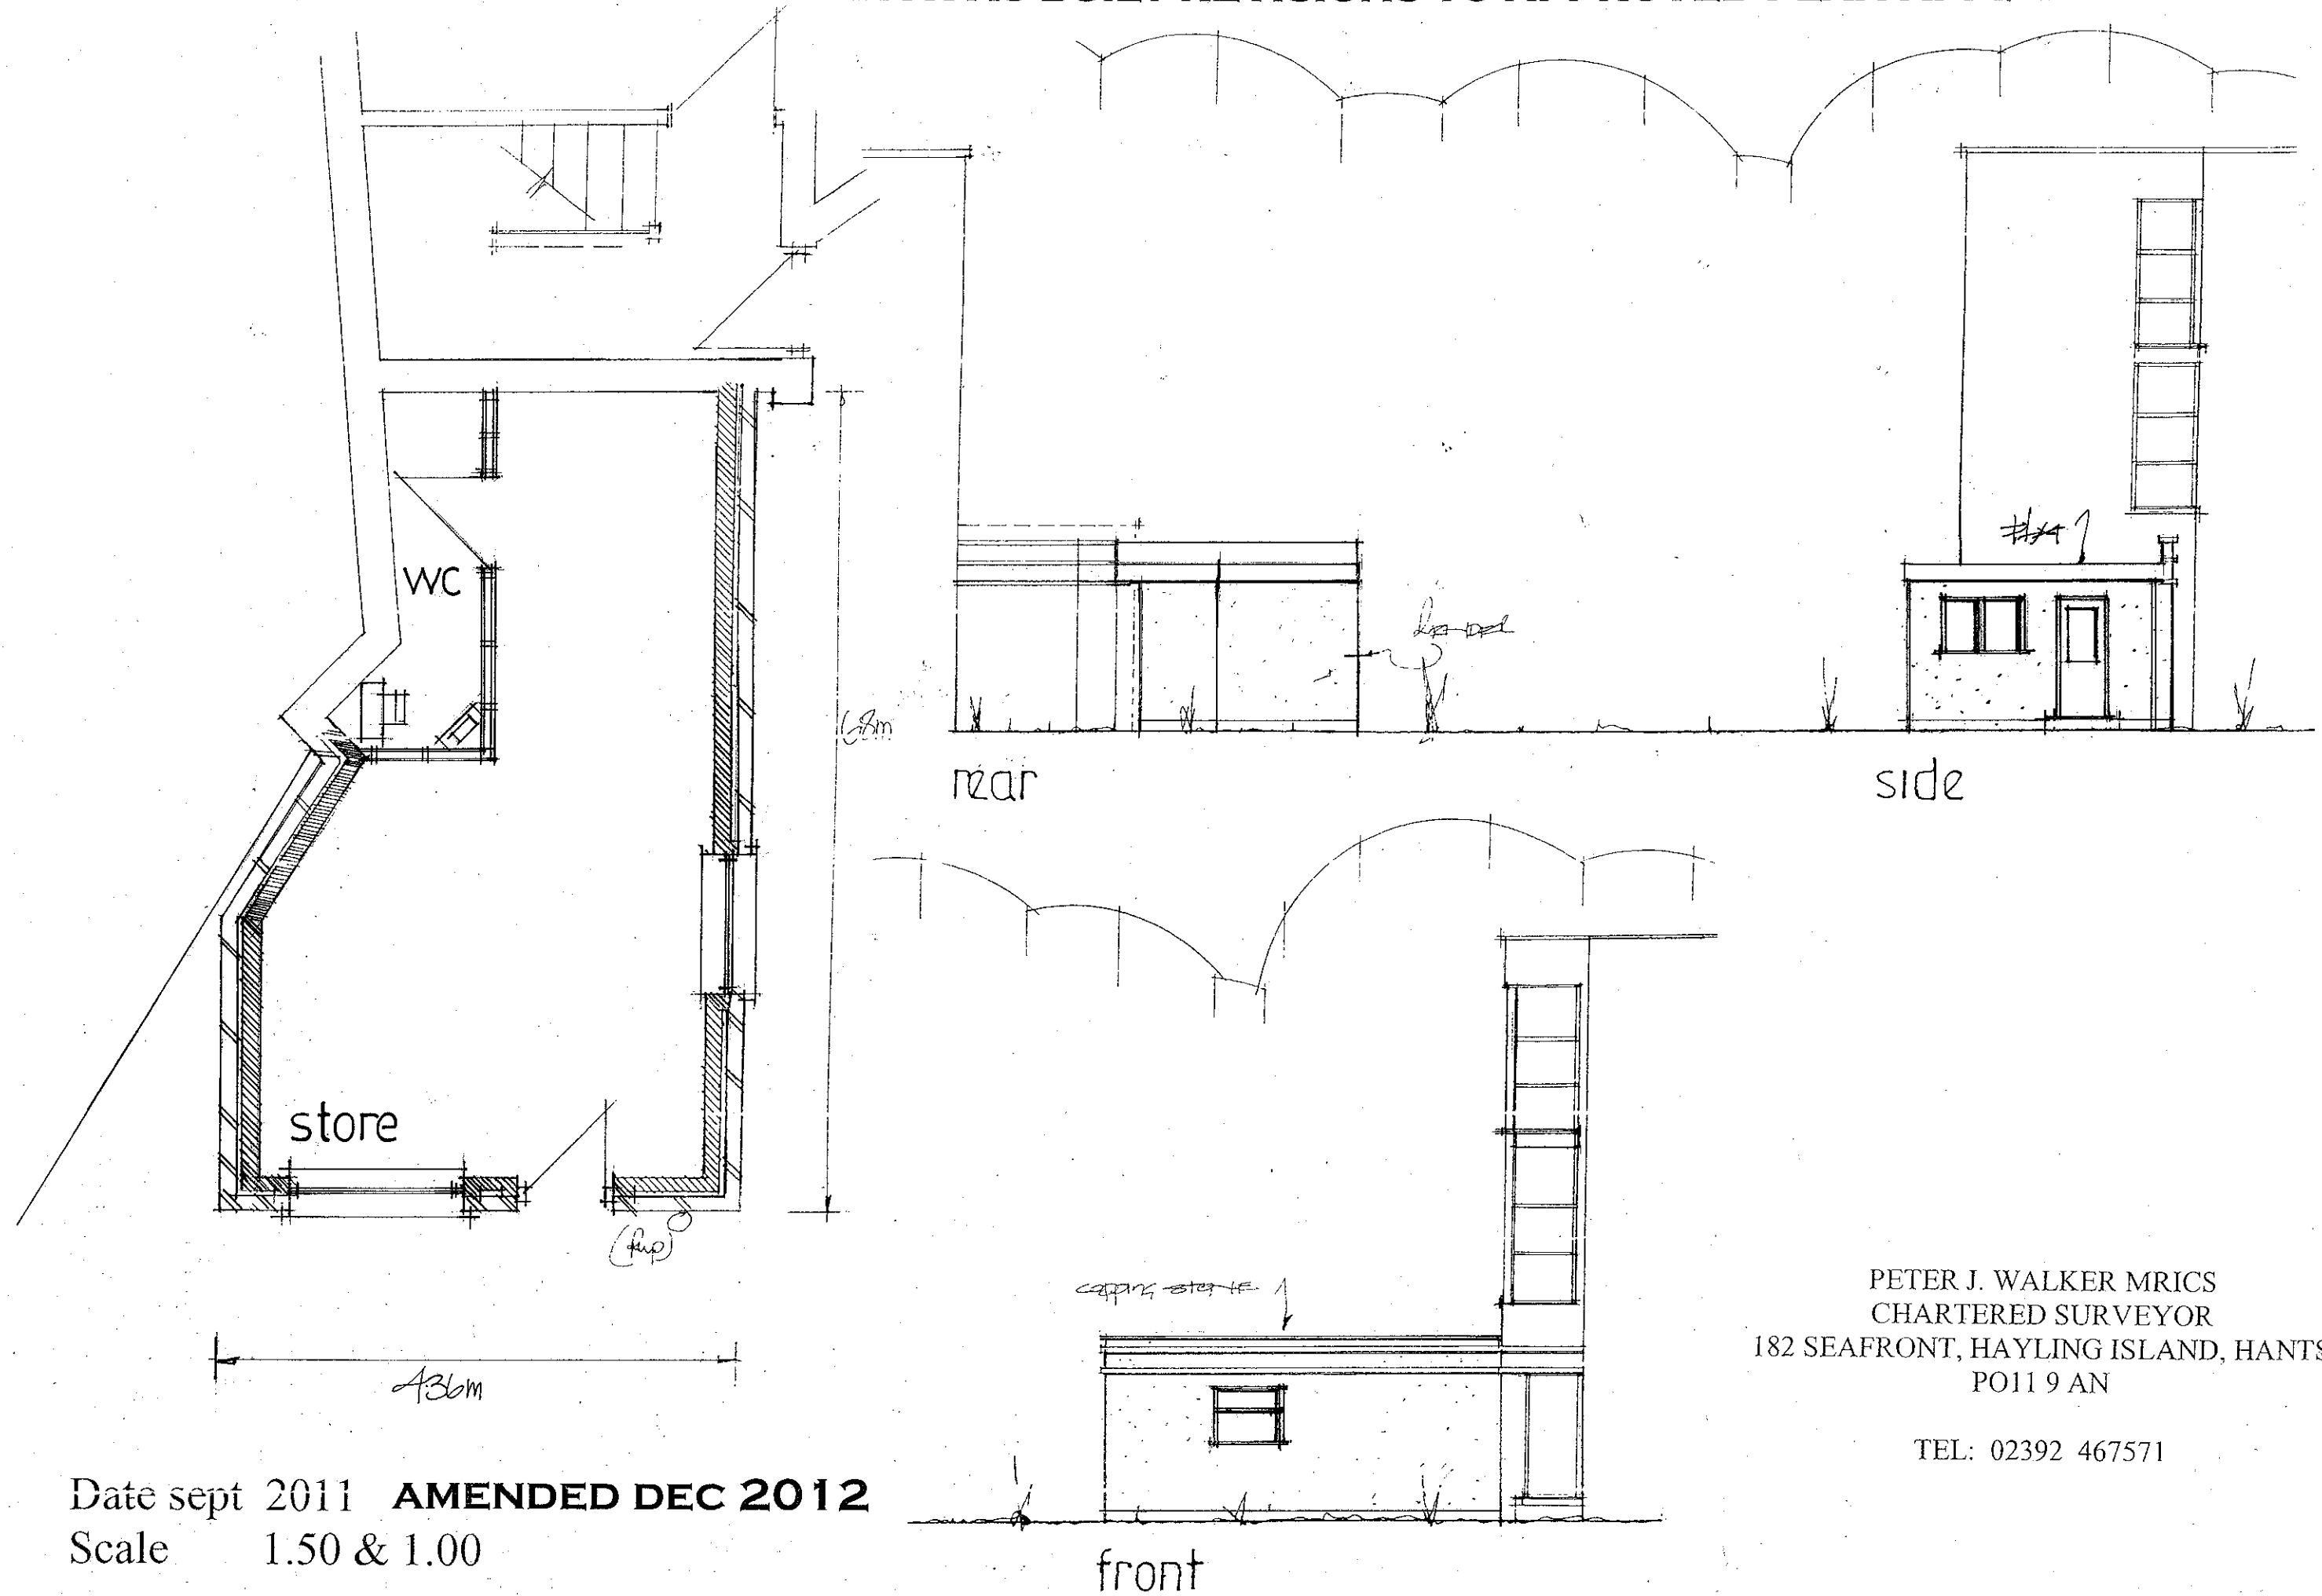

PETER J. WALKER MRICS
 CHARTERED SURVEYOR
 182 SEAFRONT, HAYLING ISLAND, HANTS.
 PO11 9 AN

TEL: 02392 467571

Date sept 2011 **AMENDED DEC 2012**
 Scale 1.50 & 1.00