



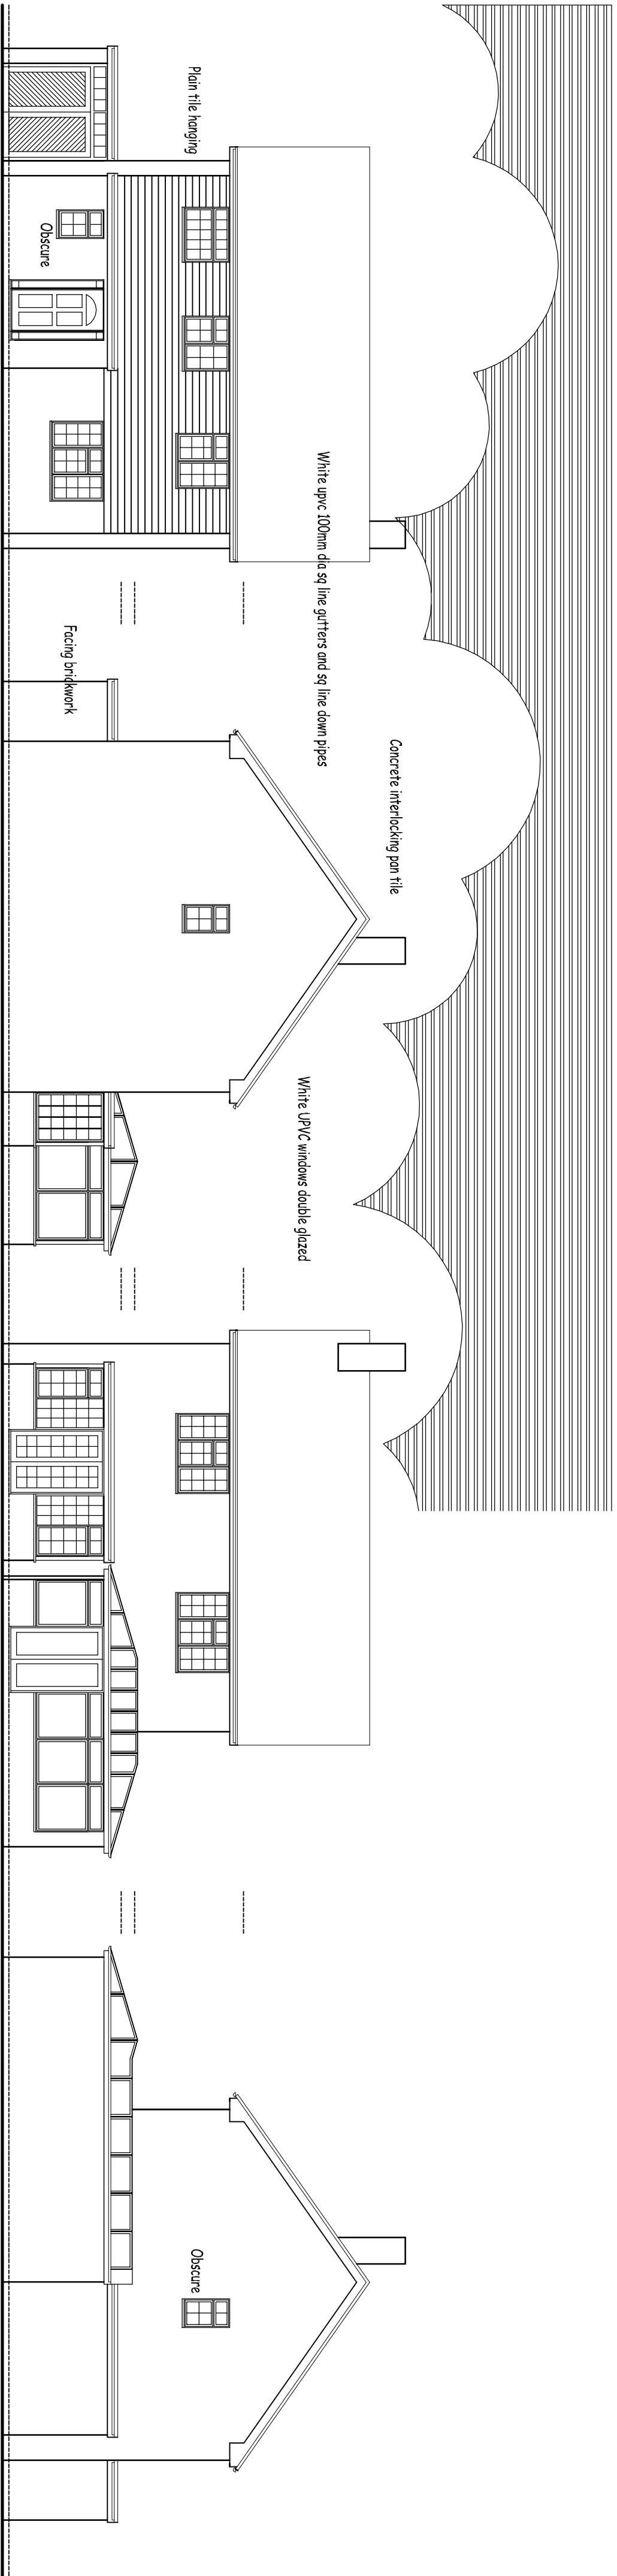


Billet Avenue

Waterlooville, Hampshire

0 1M 10M

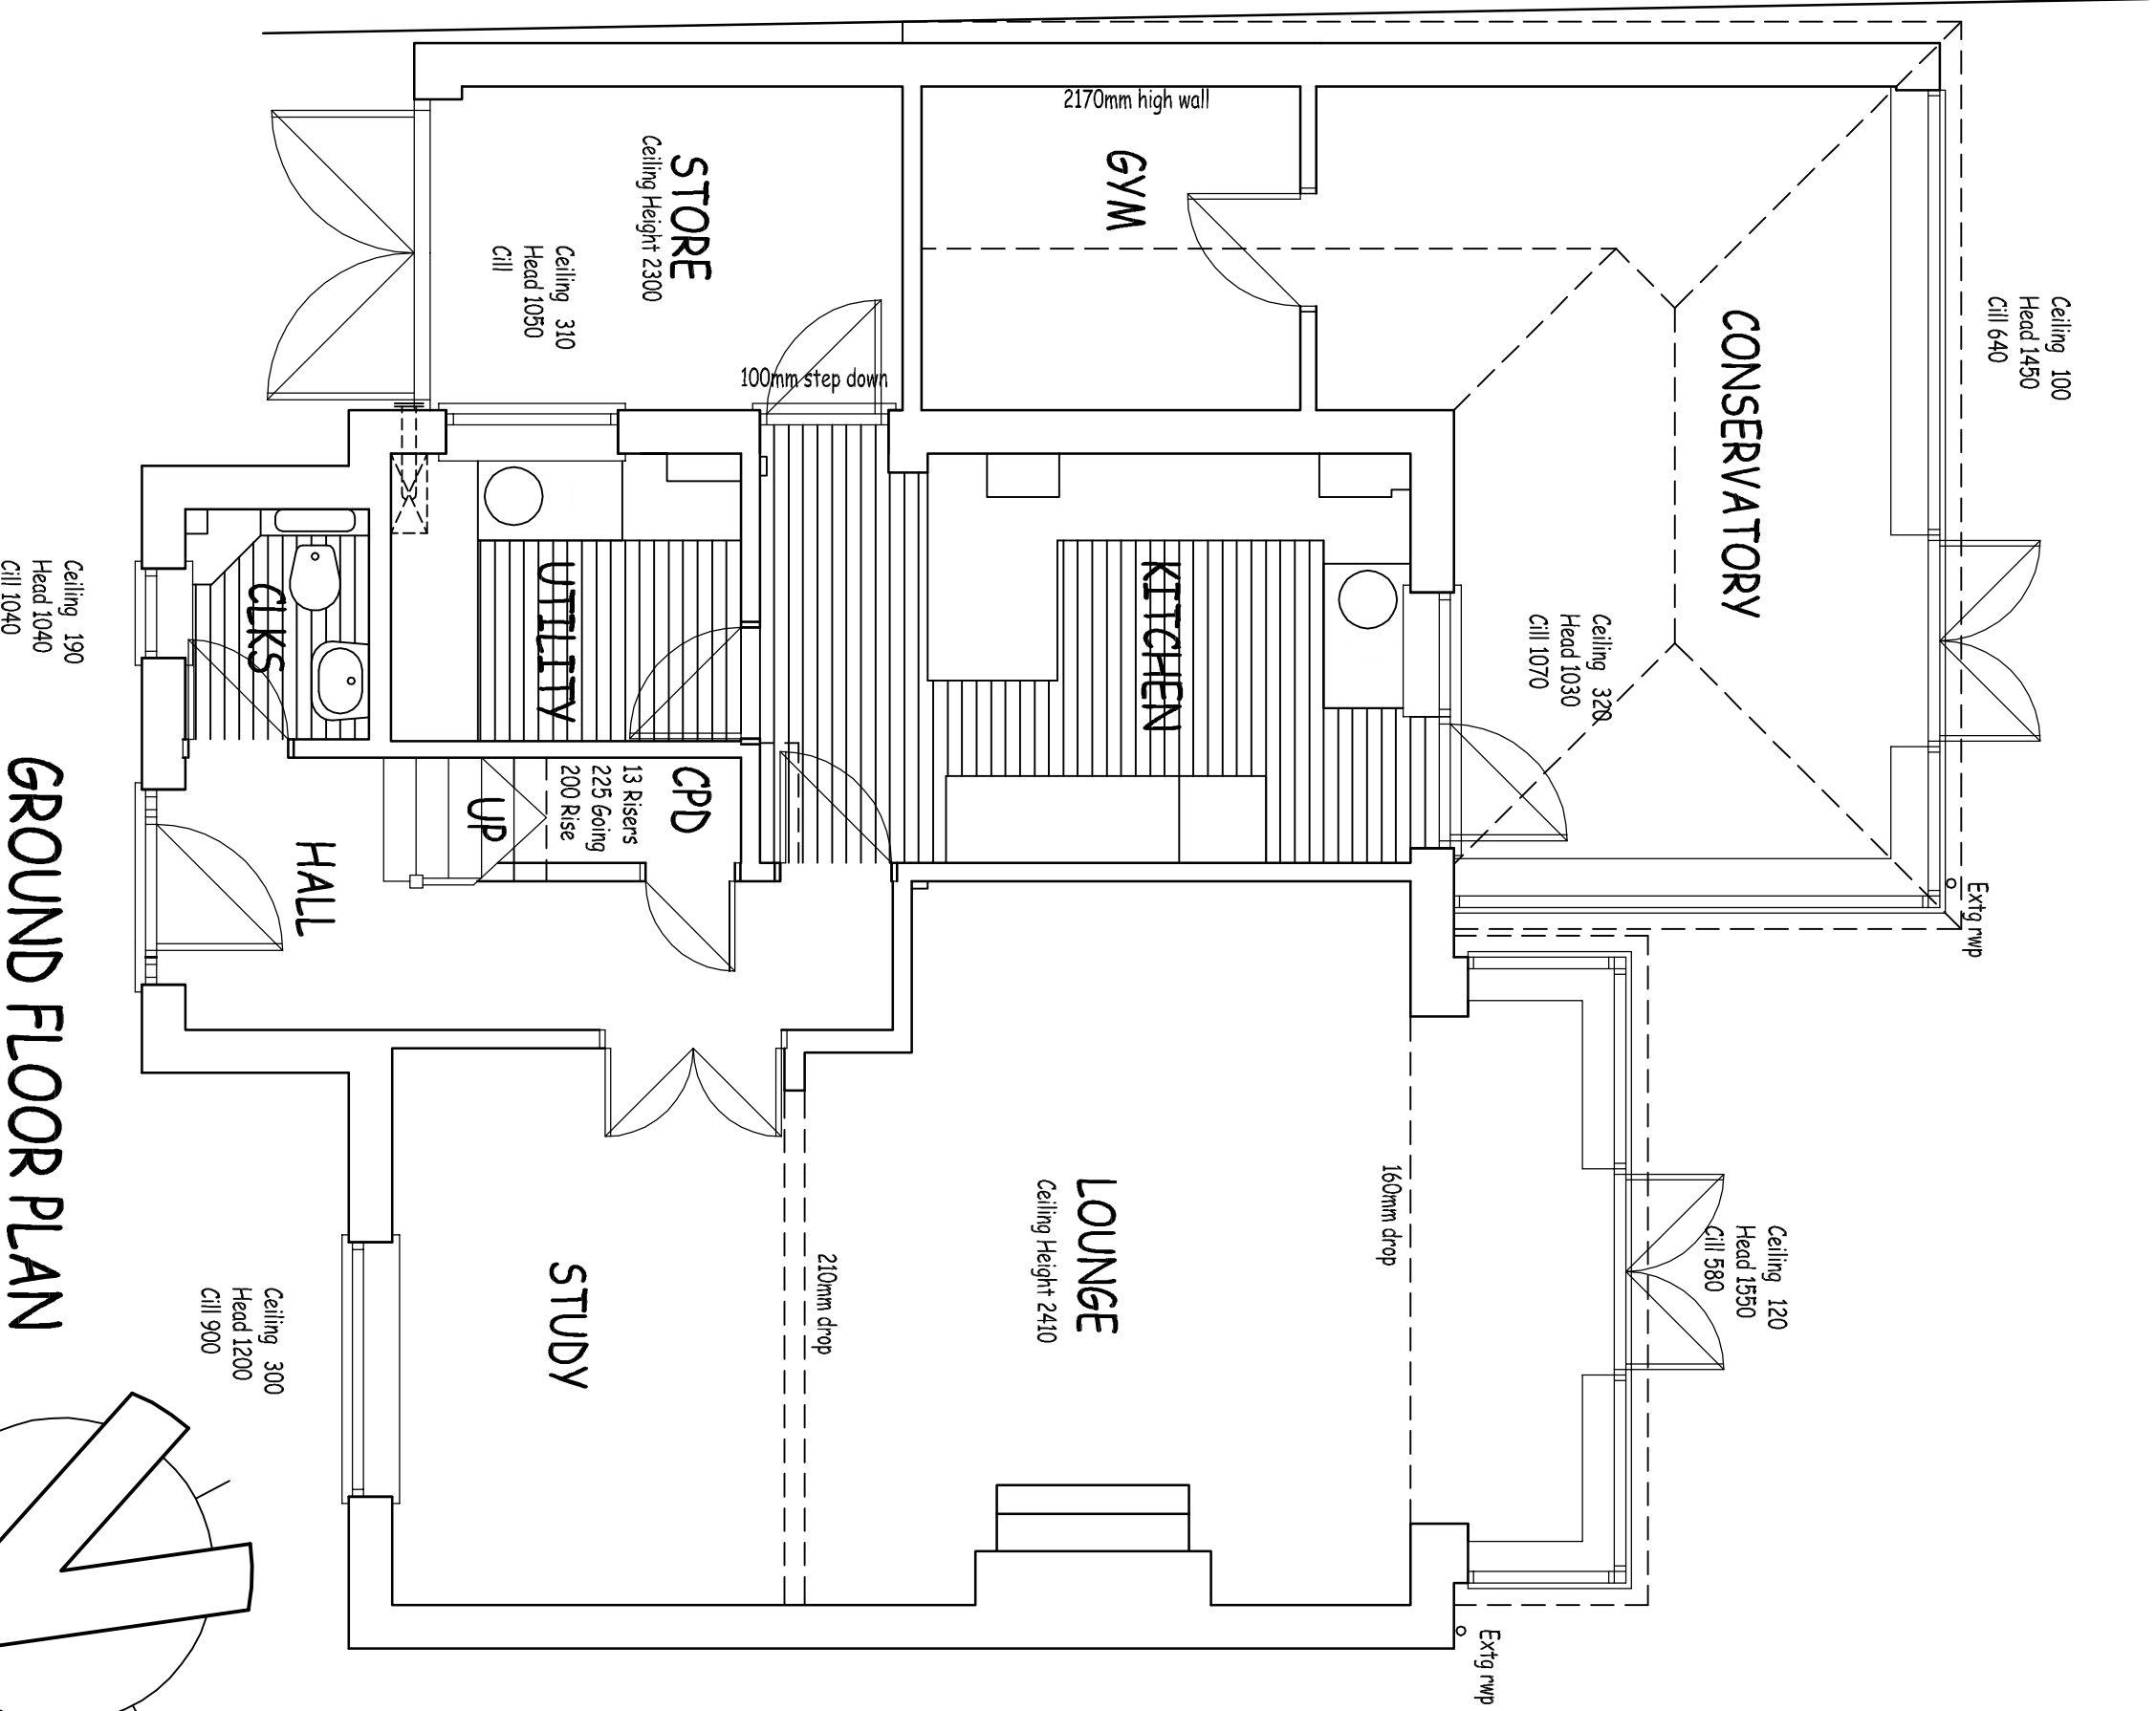

FIRST FLOOR PLAN

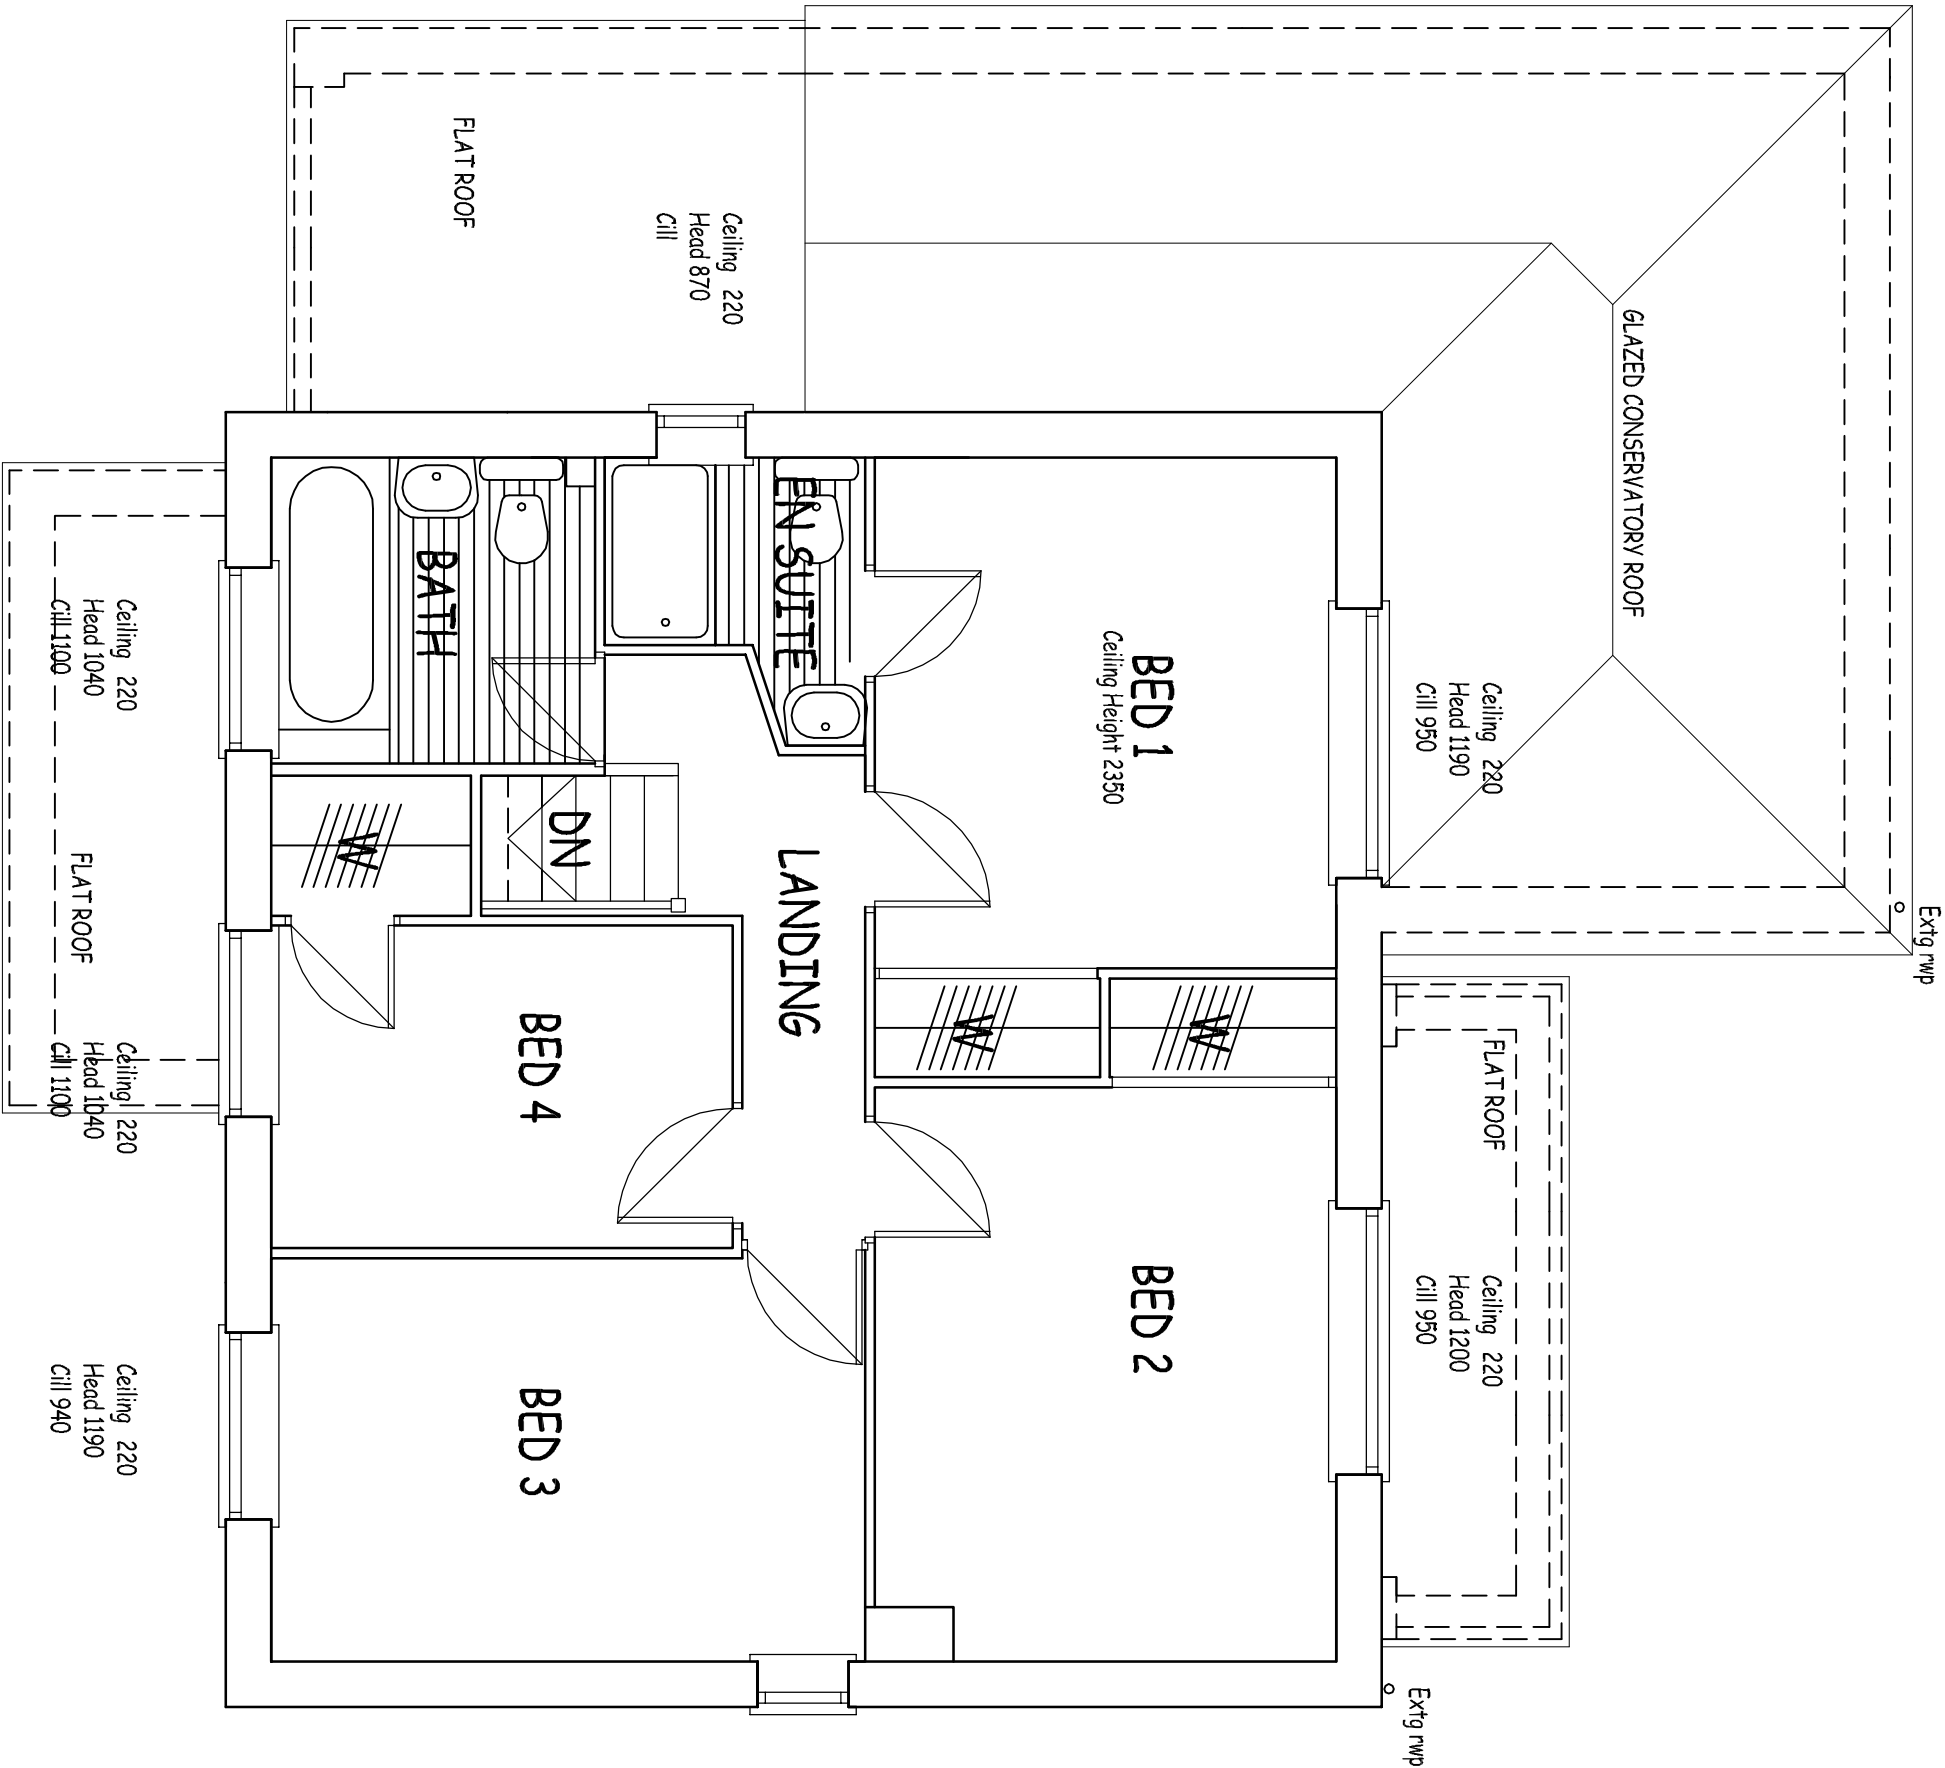

The drawings are produced by copyright and may not be copied or distributed to third parties without the expressed permission of Town & Country Architecture.
Professional should be given to within 5 years of completion of the project.
Discrepancies of any kind must be reported to Town & Country Architecture.

TOWN & COUNTRY
ARCHITECTURAL TECHNOLOGISTS
PLANNING CONSULTANTS
4 FLOORS
1000000
HAMPSHIRE ROAD
WATERLOOVILLE
HAMPSHIRE
PO12 1JG
TEL: 01703 254000
FAX: 01703 254001

PROJECT
AS BUILT PLAN
2A Billet Avenue
Waterlooville
Hampshire
CLIENT
Mr & Mrs A. Nottter

SCALE
1:50 1:100
DATE

DRAWN
P.T.E. MCAT ACT08 -
CHECKED

DATE
12/24/01

REVISION
000000

ARCHITECTURE