

UNIT 9A WELLINGTON RETAIL PARK, WATERLOOVILLE

Project No.	12/734	Drawg. No.	111	Revision	D
-------------	--------	------------	-----	----------	---


Issued for:
AS BUILT

This drawing remains the COPYRIGHT of Chartwell Project Management and must not be used for any other purpose without permission.

Do not scale from this drawing. All dimensions to be checked by site measurement and discrepancies reported immediately.


This drawing must be read in conjunction with all Architects, Consultants, Subcontractors and Specialists drawings, together with Contract Administrators' drawings, specification and other contract documents.

The Contractor is to provide a Method Statement prior to undertaking any demolition works, creation of openings and opening up works.

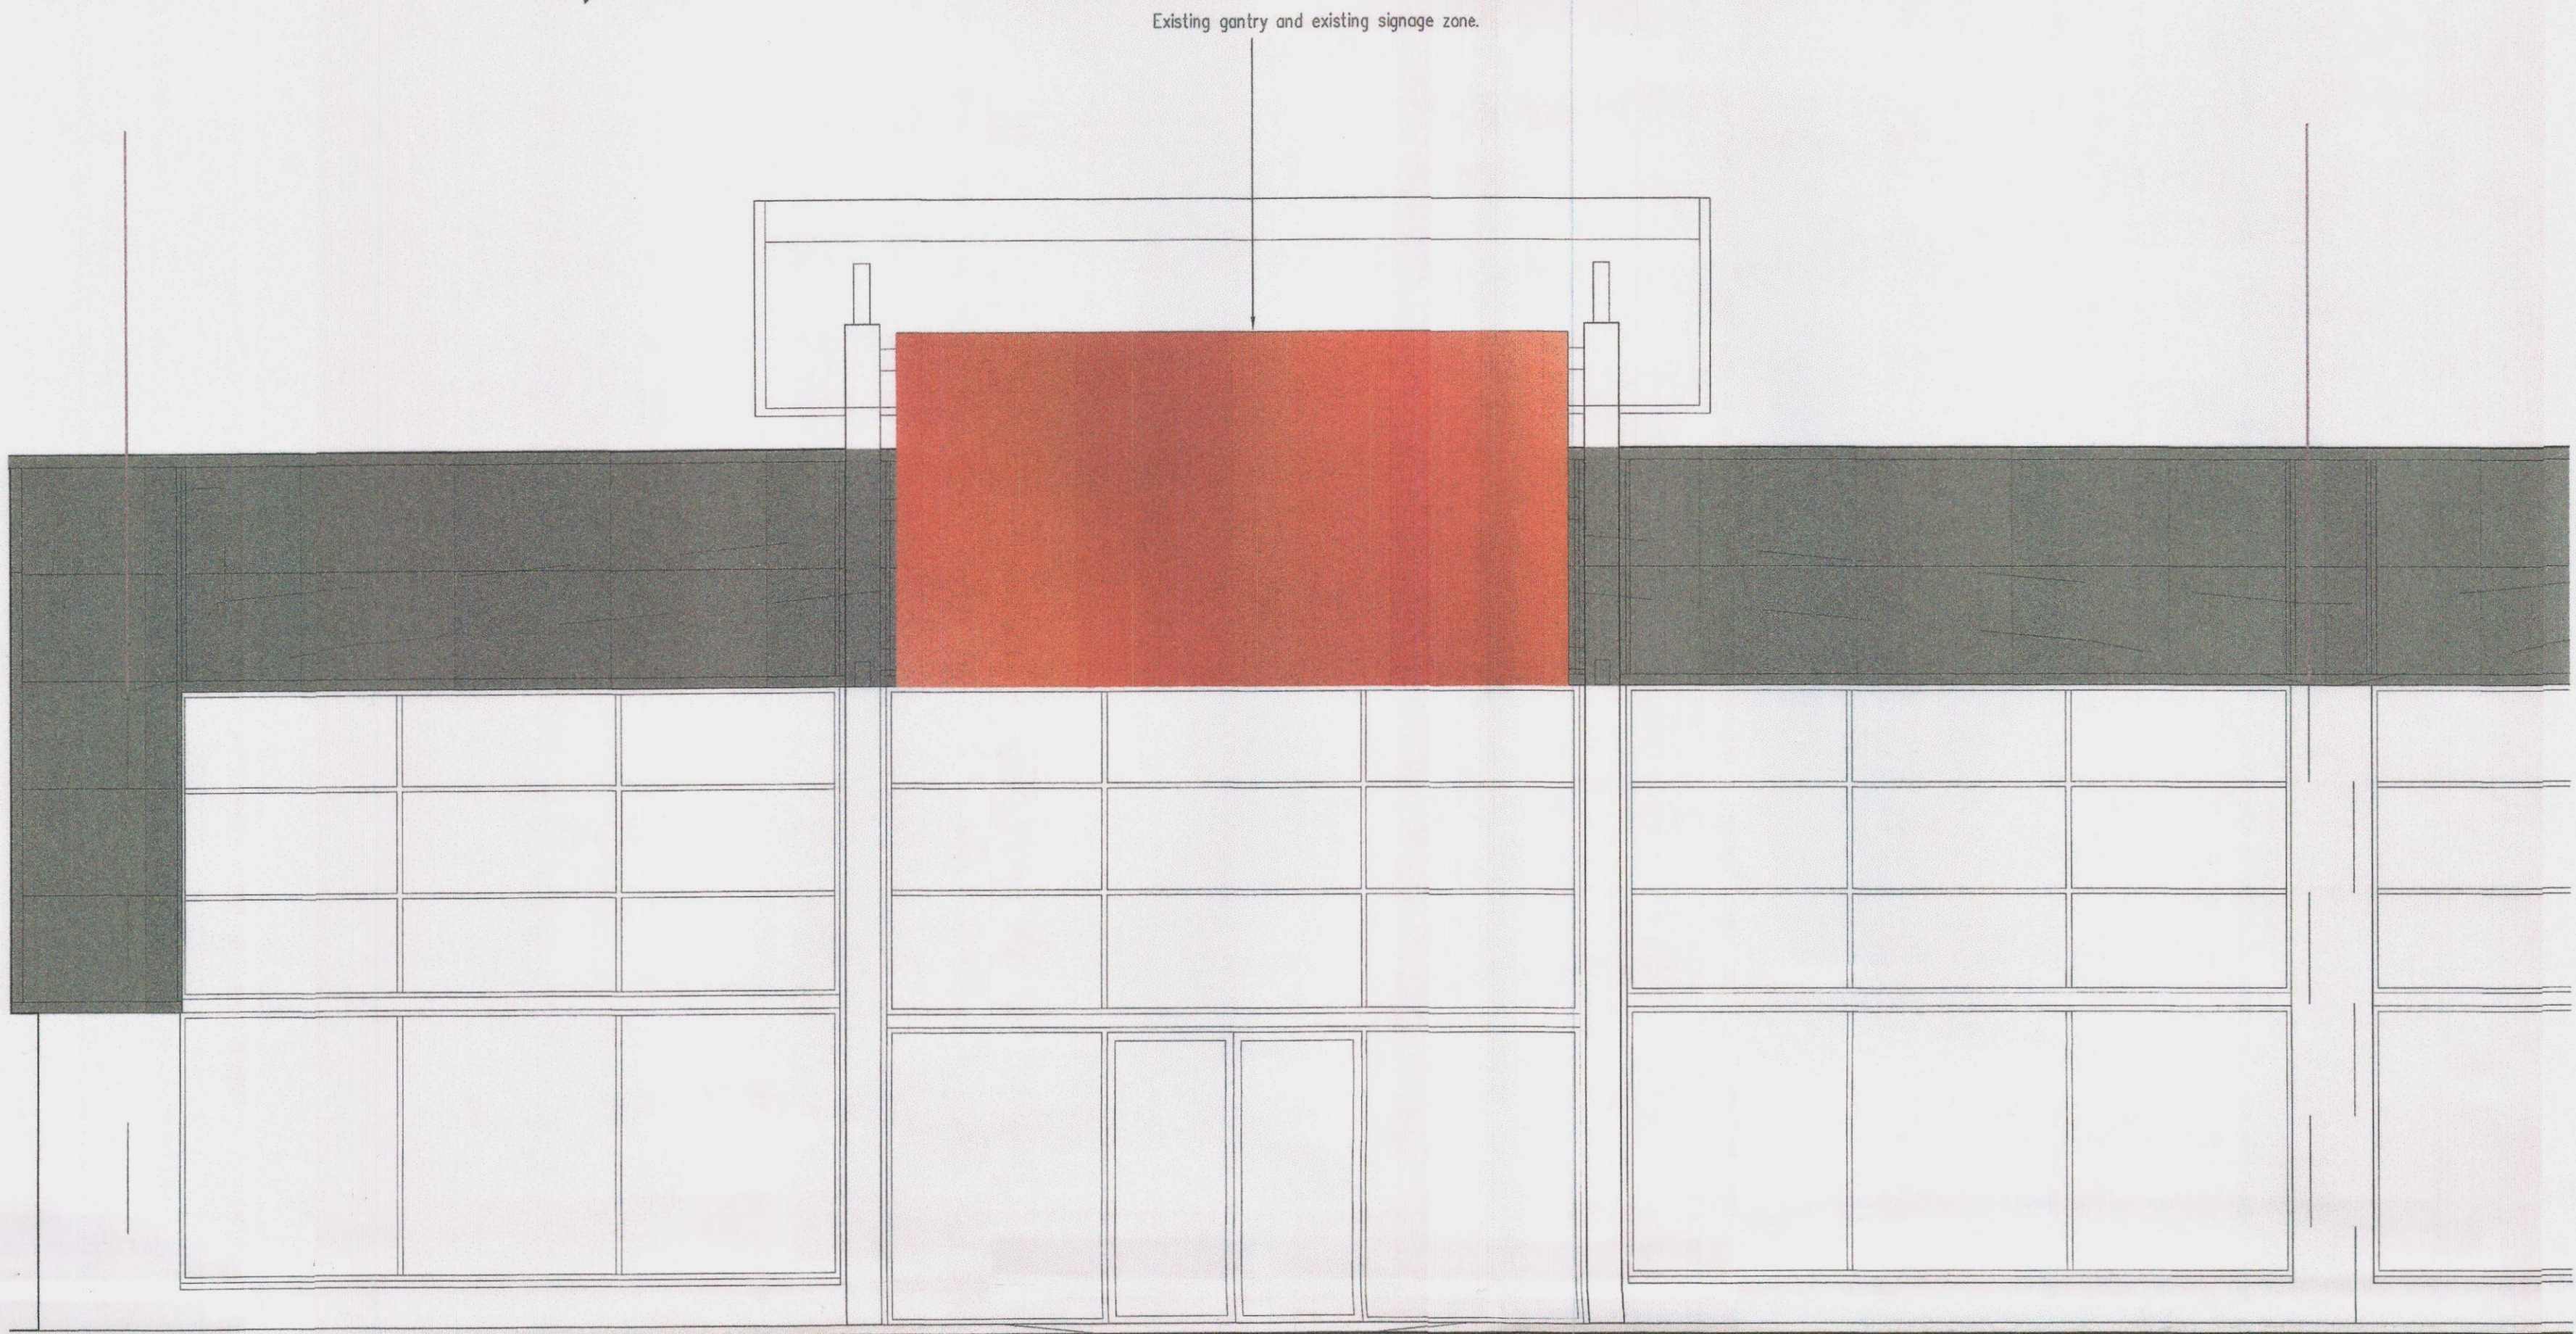

EXISTING FRONT ELEVATION

New shopfront Flexi face sign fixed to existing gantry within existing signage zone. Sign boxes to have powder coated aluminium frame and flexi front face panel with lettering (internally-illuminated - Static).

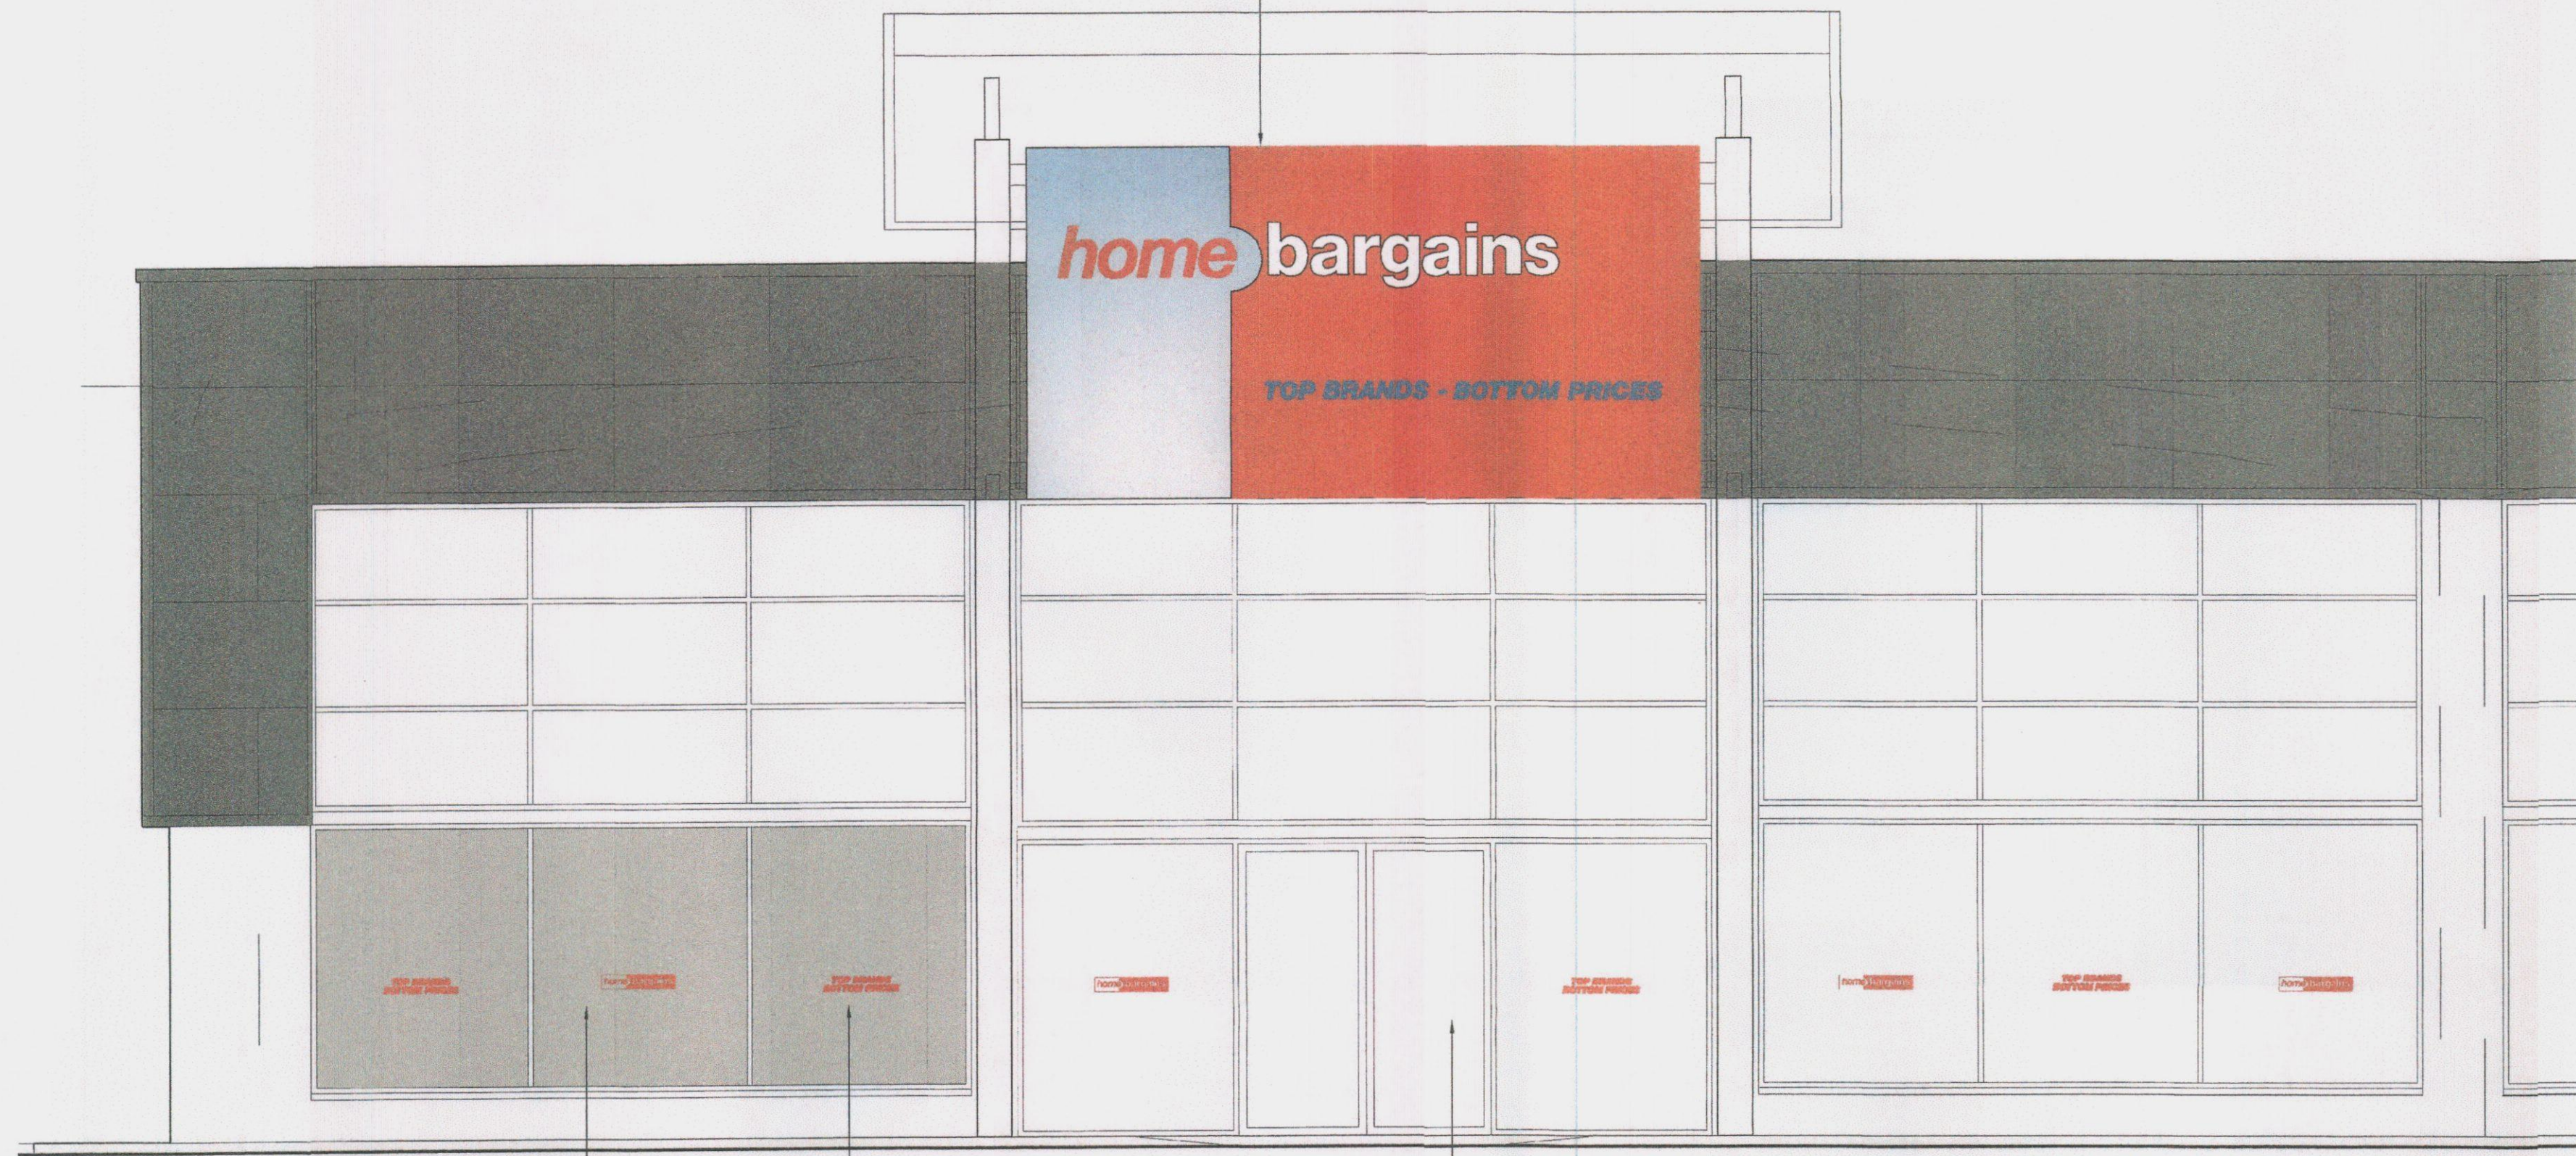


PROPOSED FRONT ELEVATION

Hatching indicates Opaque Film applied to internal face of glazing

Window graphics sand etched to new shopfront windows.

Replace existing Sliding doors with new with reduced hieght to accommodate New Terrazzo Floor Finish of 75mm. Existing Black Paving to be raised to also accommodate difference in level. Colour of doors to Match existing shopfront

SIGNAGE DETAILS

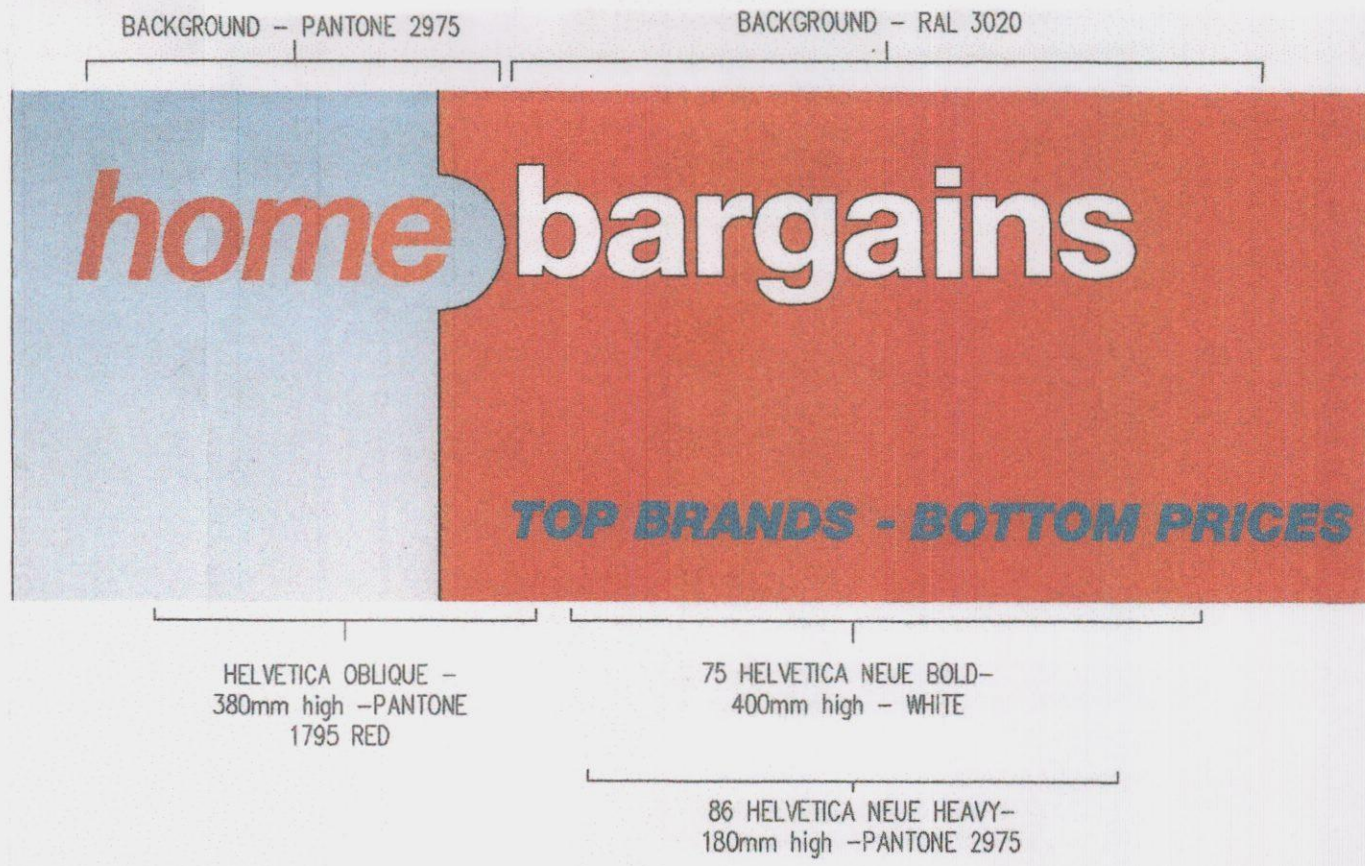

D	PW	Issue title amended to AS BUILT	20.05.2013
C	PW	Opaque film applied to glass	28.01.2013
B	PW	Issue title amended CONSTRUCTION	13.03.2012
A	PW	Issue title amended to TENDER	28.01.2013
Rev	Int.	Description	Date



Chartwell Project Management - Company Reg No. 5296100
Unit 15, Meridian Business Village, Hartsby Drive, Hurts cross,
Liverpool, L24 9LG Tel: 0151 728 4200 - Fax: 0151 728 4202
E-mail: all@chartwell-pm.co.uk

Client T.J. MORRIS LTD
HOMEBARGAINS

Project UNIT 9A WELLINGTON RETAIL PARK
WATERLOOVILLE

Title PLANS AS PROPOSED
ELEVATIONS

Date DEC 2012 Scale 1:50 Sheet Size A1

Drawn P WILKINSON

Issued for:
AS-BUILT

Project No.	12/734	Drawg. No.	111	Revision	D
-------------	--------	------------	-----	----------	---

RECEIVED
18 JAN 2013
PLANNING
CONTROL