



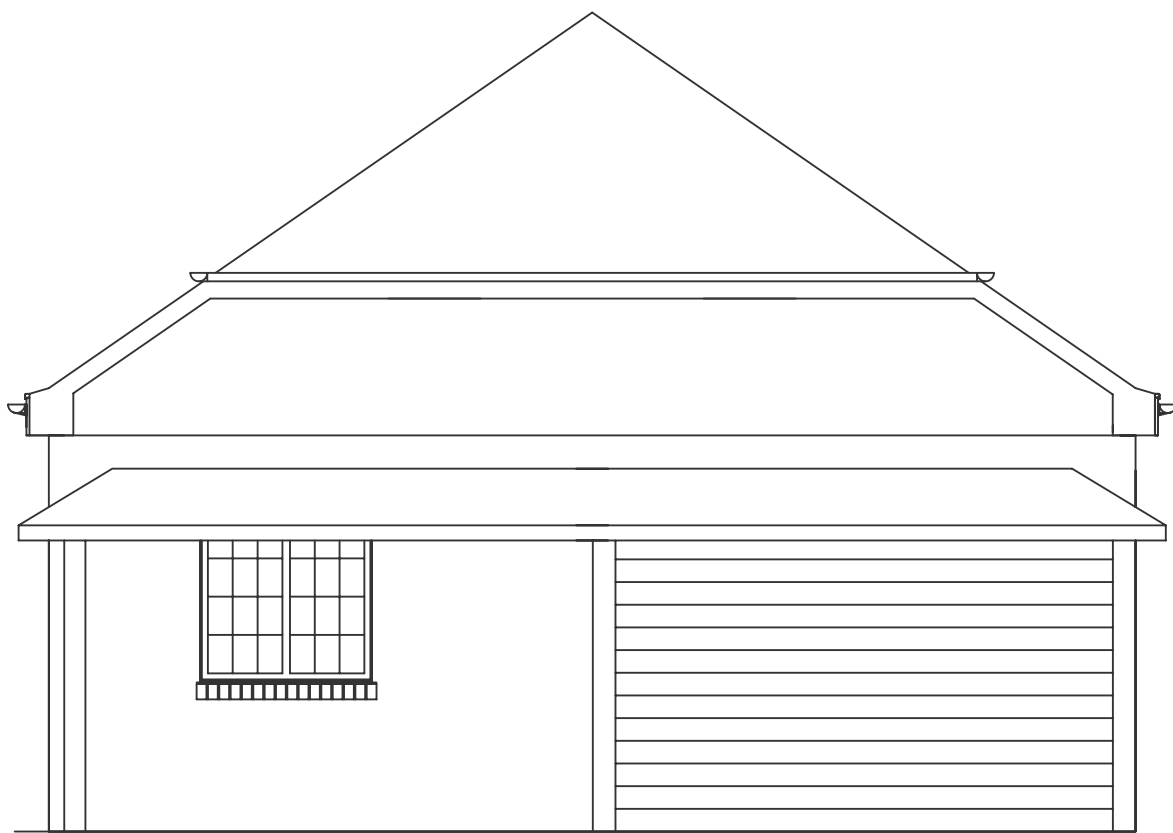


EXISTING/PROPOSED
GARAGE
NORTH ELEVATION

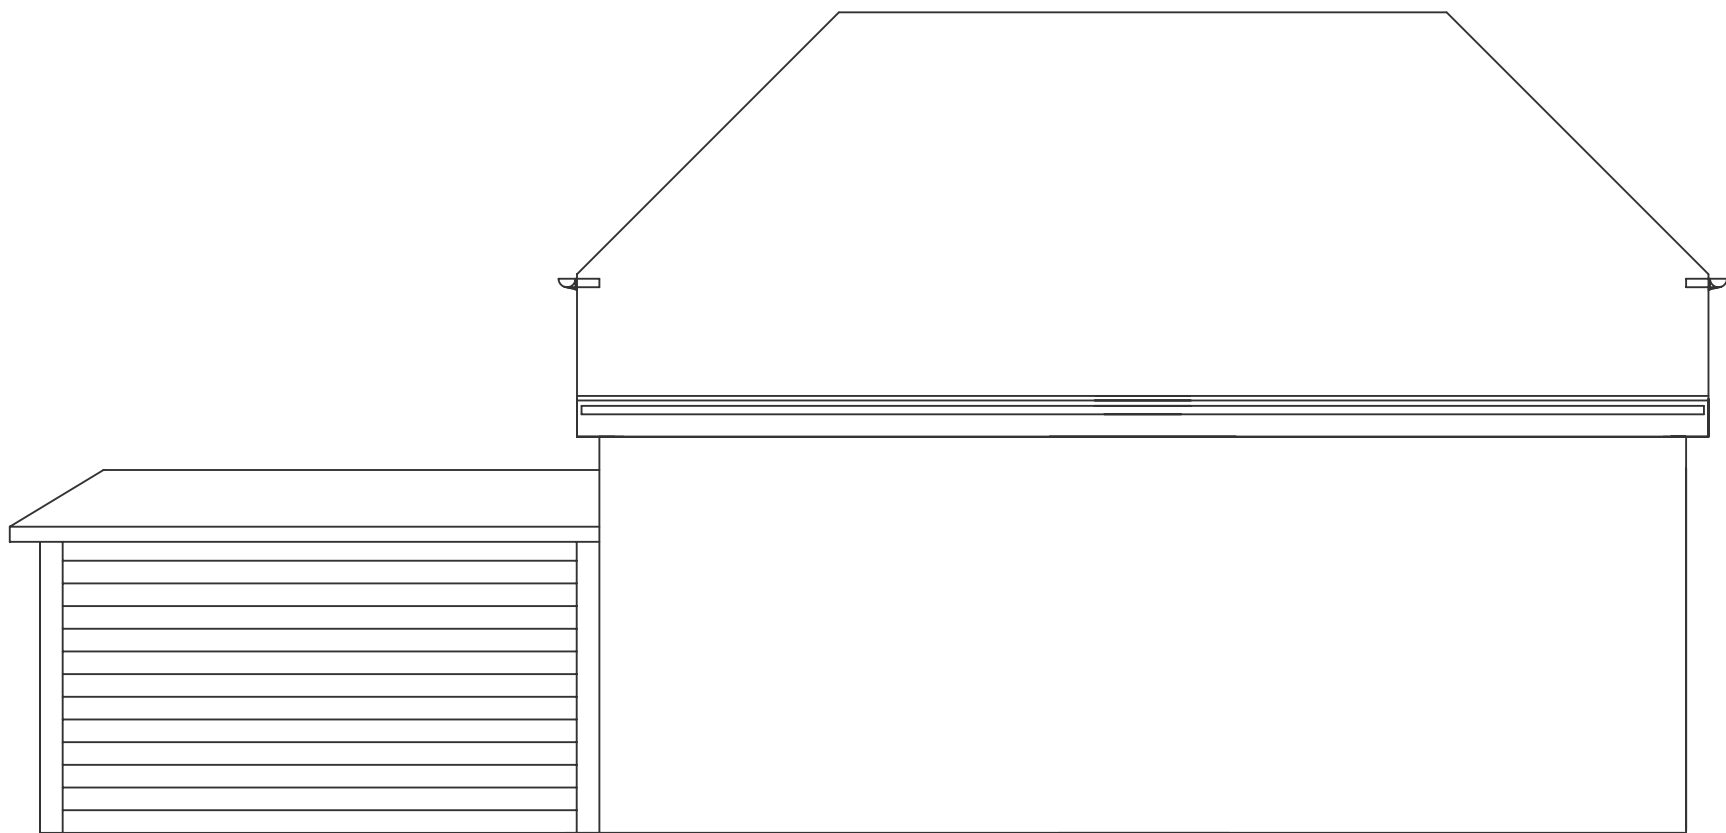


EXISTING/PROPOSED
GARAGE
WEST ELEVATION

Date 24/10/2011	Drawn EM	checked by	date checked	Client MERCO PLACE LTD	 8 New Brighton Road Emsworth, Hampshire, P010 7PS TEL: 08450 450 862 www.erconstructions.co.uk
Scale 1/50	Drawing title garage elevation B			Project EASTERN BARN	
Drawing No 105/71				Address 8 New Brighton Road Emsworth, Hampshire P010 7PS	

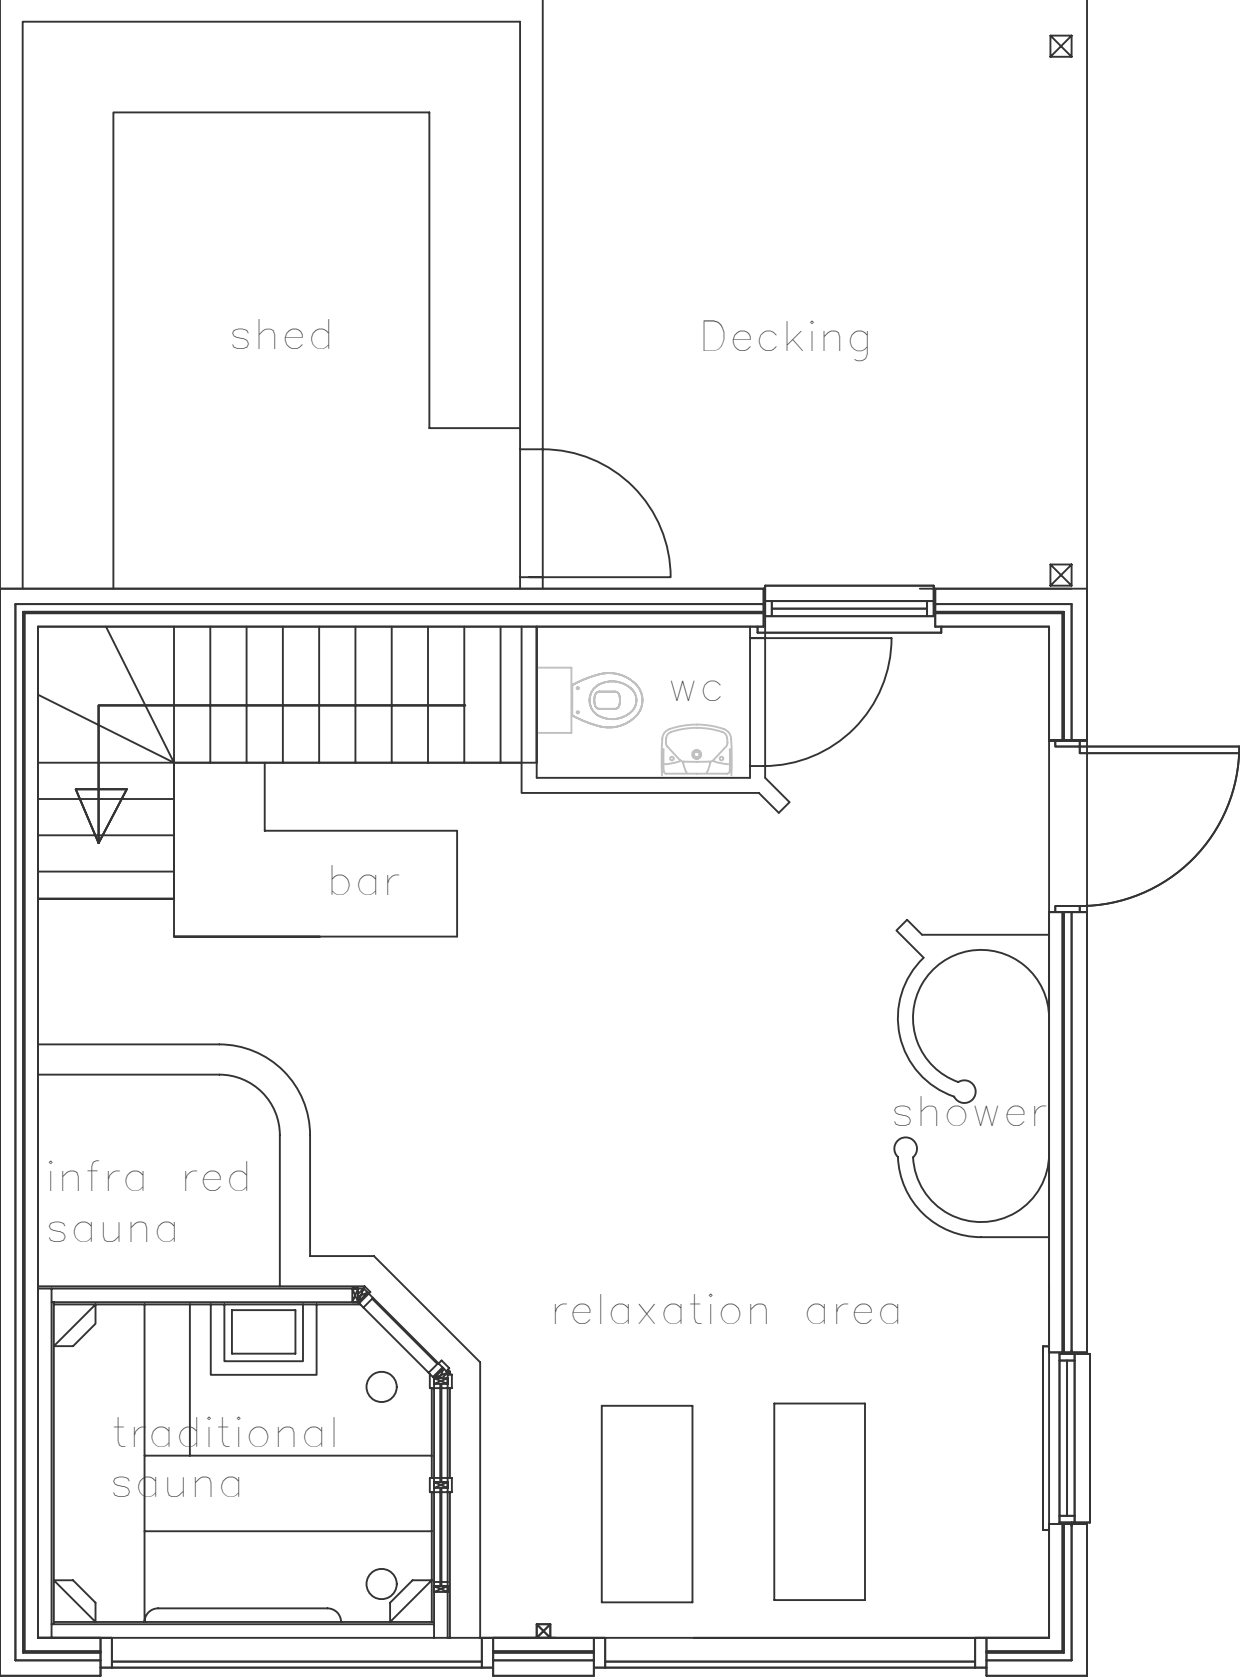


EXISTING GF GARAGE LAYOUT PLAN

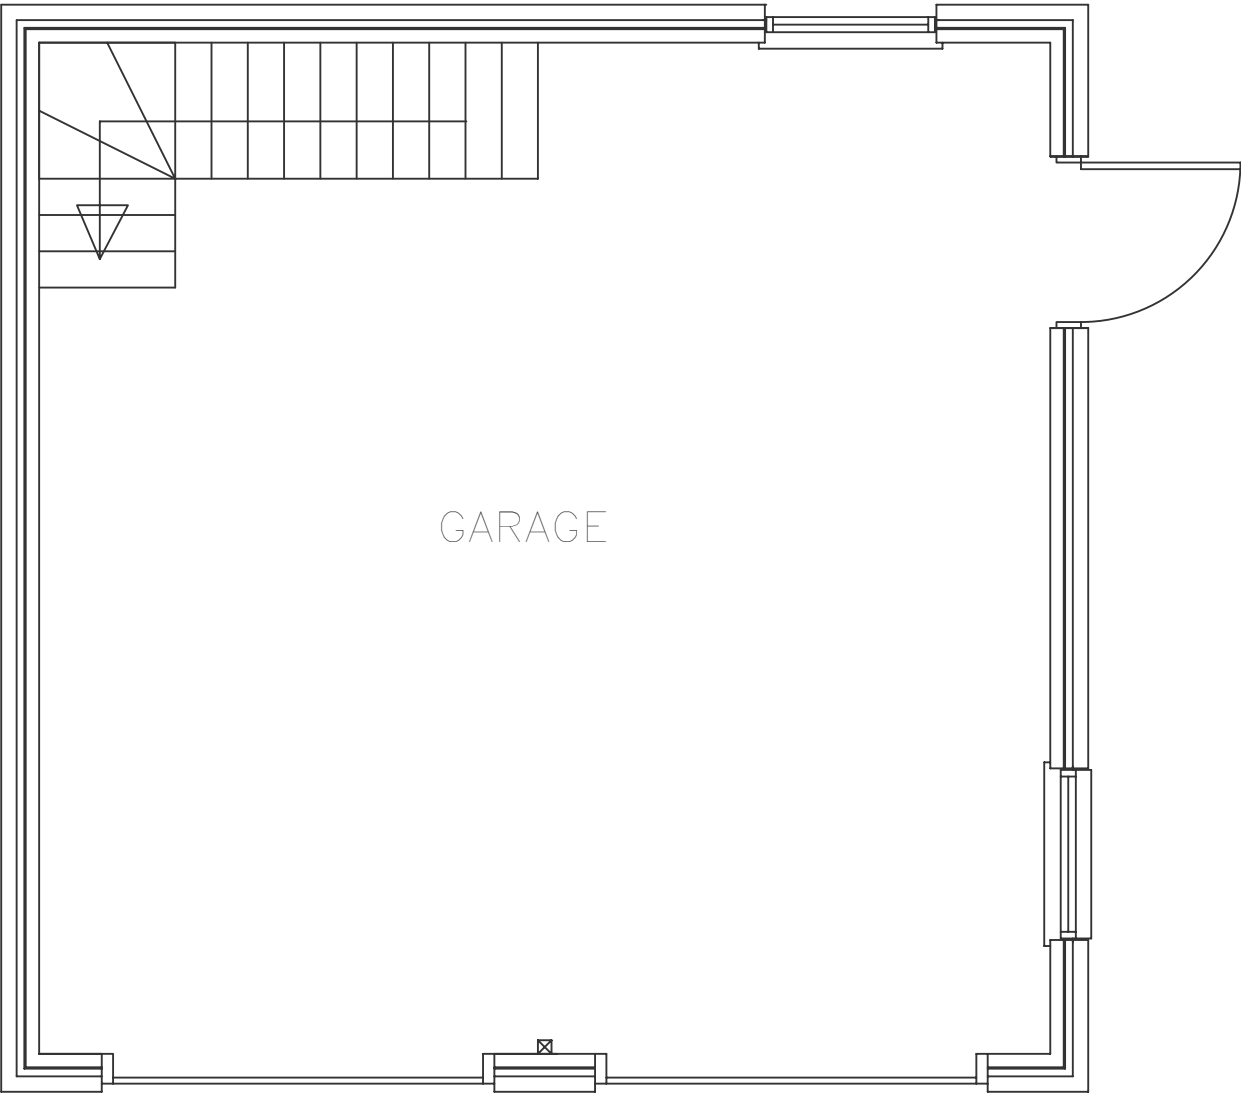


ORIGINAL (as built) GF GARAGE LAYOUT PLAN

Date 24/10/2011	Drawn EM	checked by	date checked	Client MERCO PLACE LTD	 8 New Brighton Road Emsworth, Hampshire, PO10 7PS TEL: 08450 450 862 www.erconstructions.co.uk
Scale 1/50	Drawing title Garage GF layout plan			Project EASTERN BARN	
Drawing No 105/72				Address 8 New Brighton Road Emsworth, Hampshire PO10 7PS	

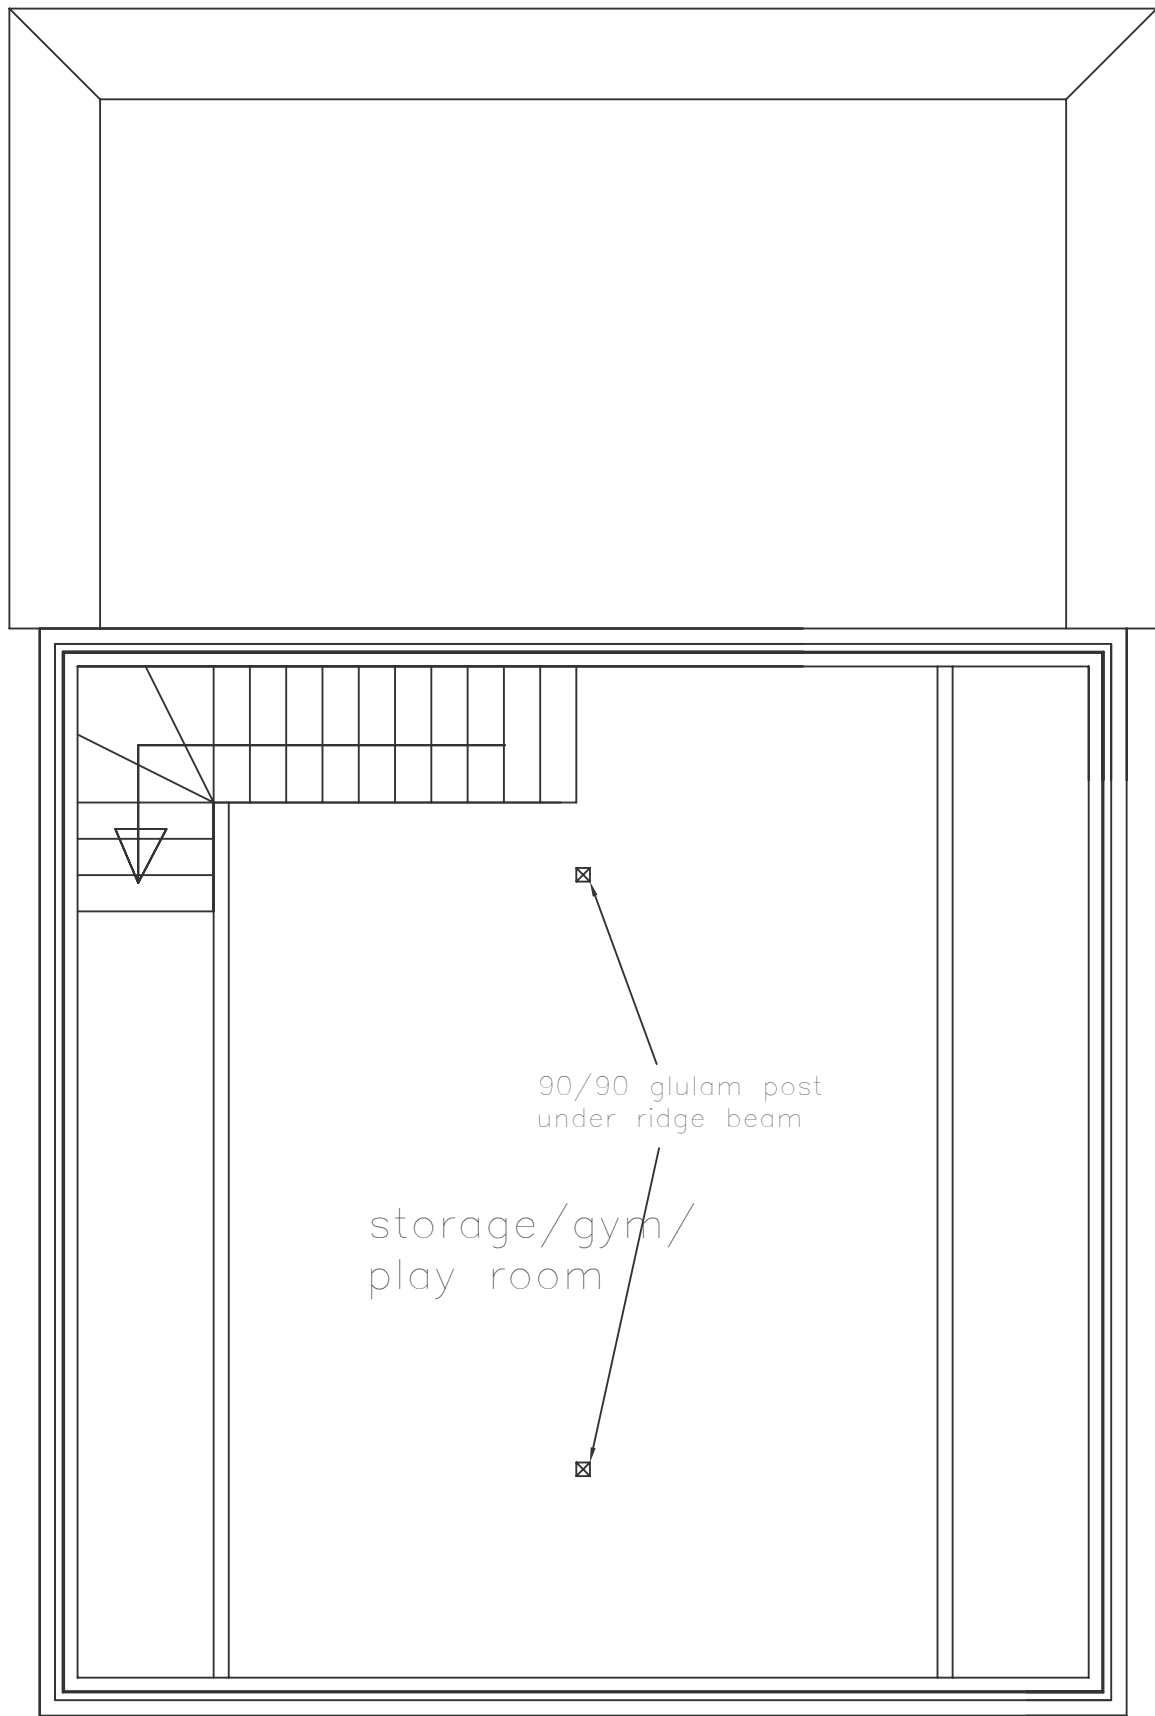


EXISTING FF GARAGE LAYOUT PLAN

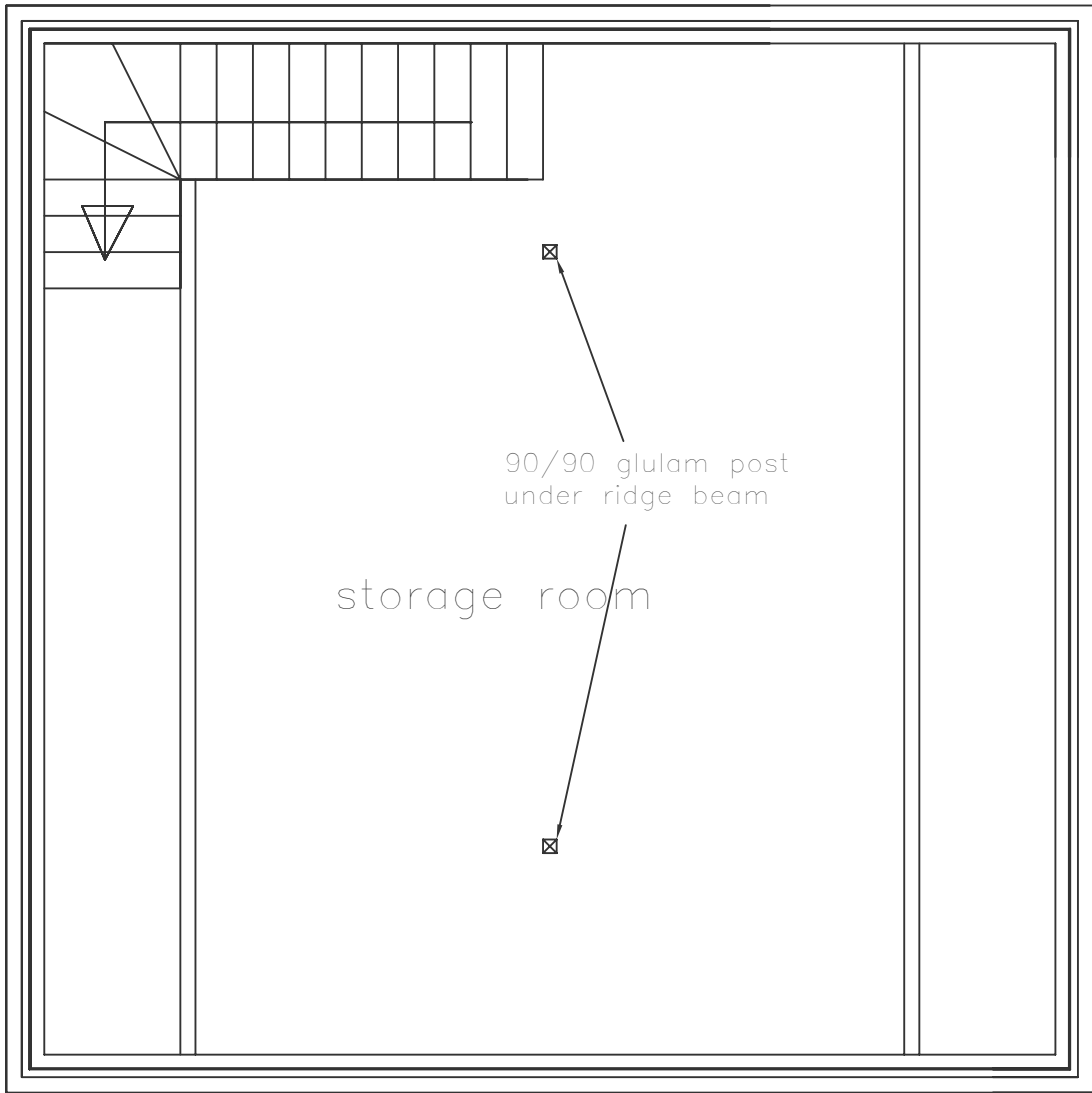


ORIGINAL (as built) FF GARAGE LAYOUT PLAN

Date 24/10/2011	Drawn EM	checked by	date checked	Client MERCO PLACE LTD	 8 New Brighton Road Emsworth, Hampshire, PO10 7PS TEL: 08450 450 862 www.erconstructions.co.uk
Scale 1/50	Drawing title Garage FF layout plan			Project EASTERN BARN	
Drawing No 105/73				Address 8 New Brighton Road Emsworth, Hampshire PO10 7PS	

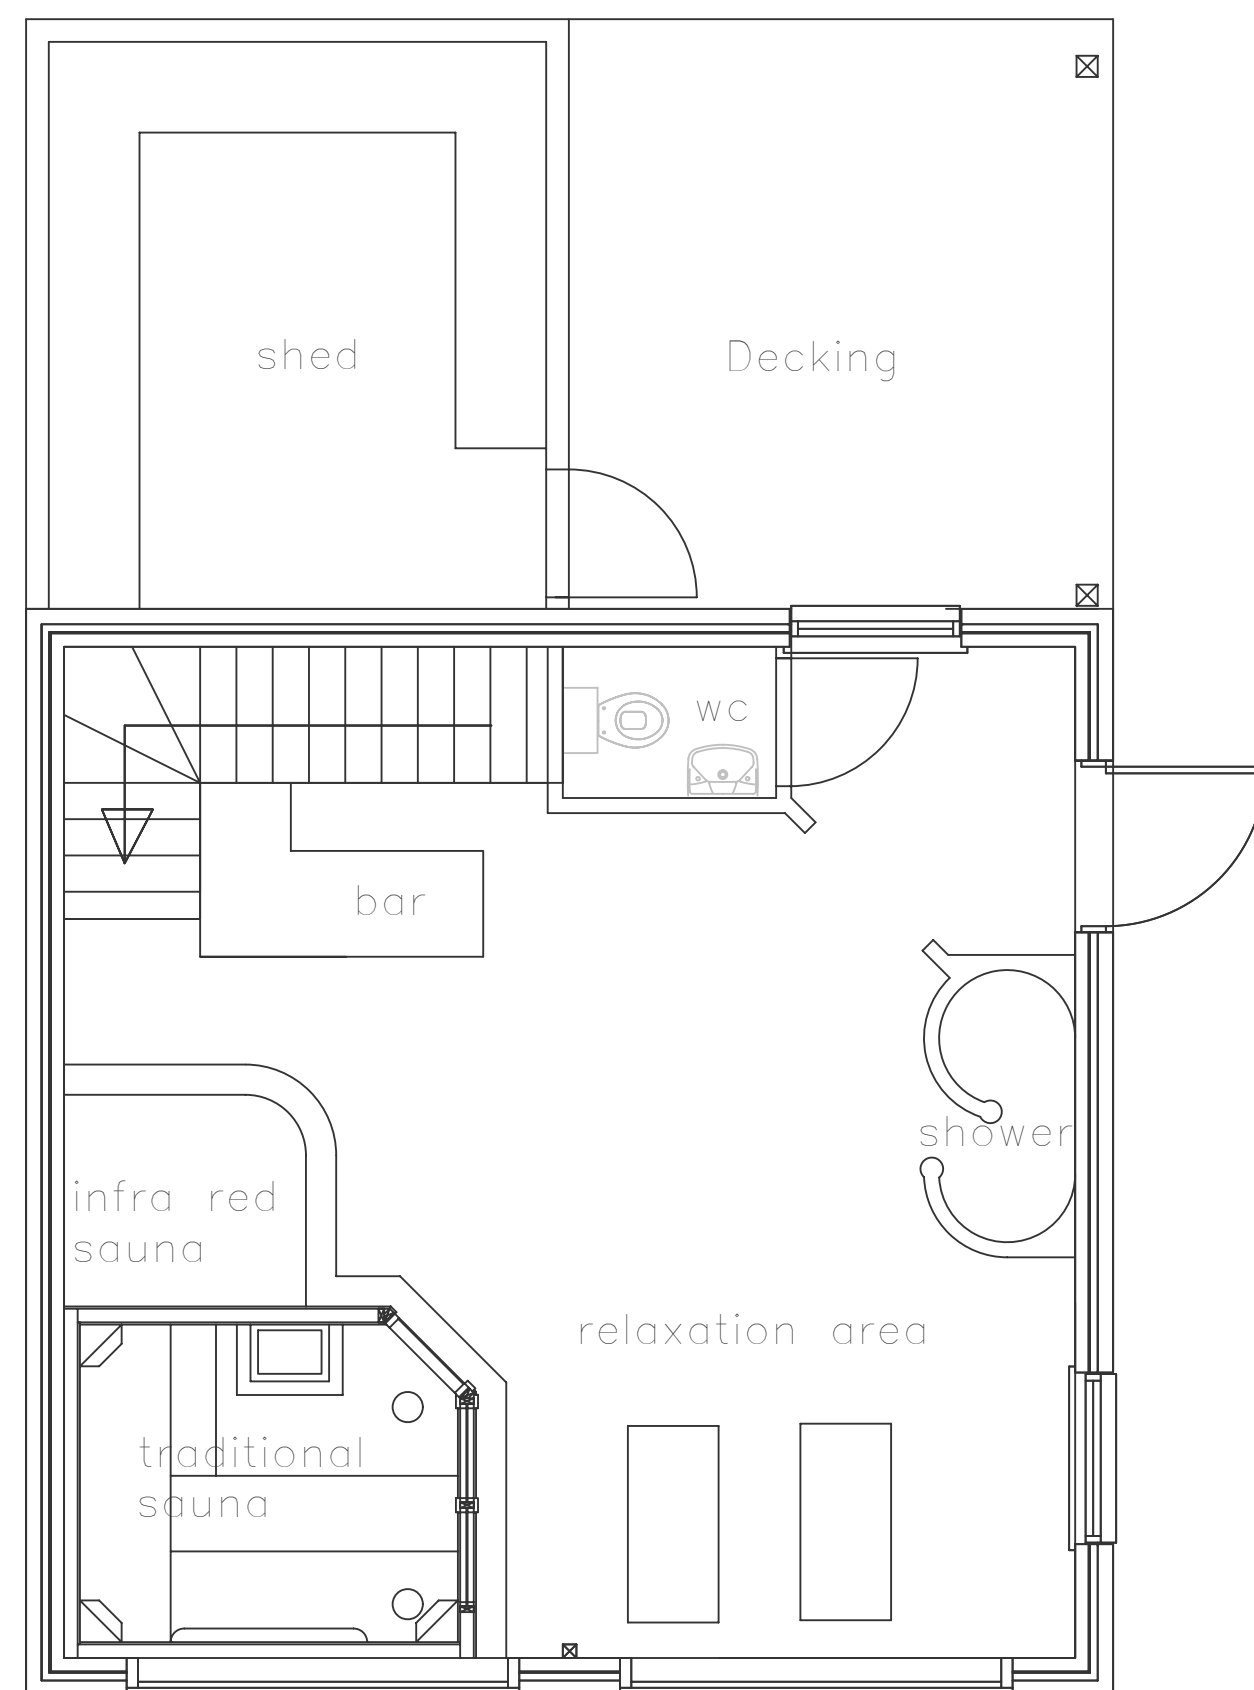

EXISTING/PROPOSED GF GARAGE
LAYOUT PLAN

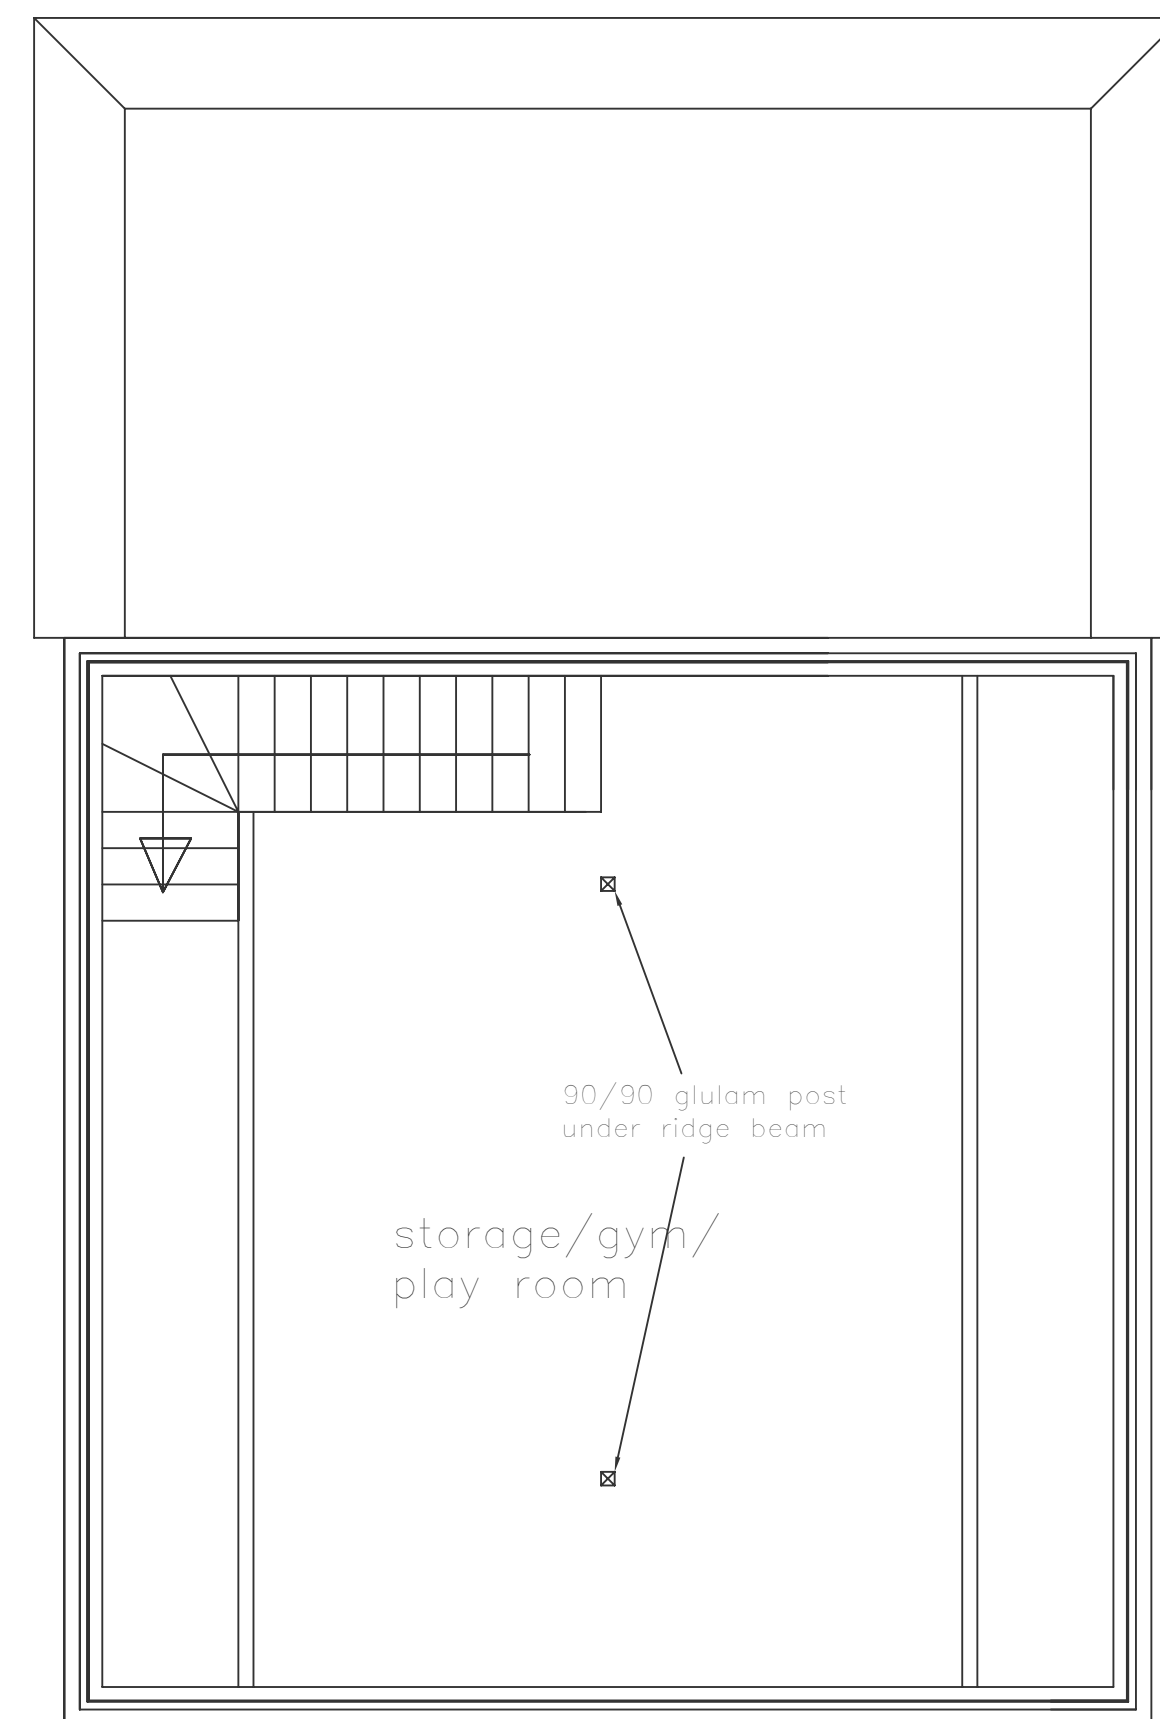

EXISTING/PROPOSED FF GARAGE
LAYOUT PLAN

Date 13/11/2012	Drawn EM	checked by	date checked	Client MERCO PLACE LTD	 8 New Brighton Road Emsworth, Hampshire, P010 7PS TEL: 08450 450 862 www.erconstructions.co.uk
Scale 1/50	Drawing title Garage GF/FF layout plan			Project EASTERN BARN	
Drawing No 105/75				Address 8 New Brighton Road Emsworth, Hampshire P010 7PS	